PUNE

Venkataramanan Associates
ARCHITECTURE · URBAN DESIGN

RECEIVED ON 23.09.19 RETURNED ON 25.09.19


REVIEWED BY Pritam SIGN PW.


COMMENTS, CORRECTIONS AND APPROVAL MADE ON THE SHOP DRAWING BY THE ARCHITECT DO NOT RELIEVE THE CONTRACTOR OF HIS CONTRACTUAL AND OTHER RESPONSIBILITIES WHER EXPRESSLY REQUESTED ALSO CHECKS ONLY FOR REVIEW OF GENERAL COMPLIANCE WITH THE DESIGN CONCEPT OF THE PROJECT AND GENERAL COMPLIANCE WITH DESIGN INTENT OF THE SPECIFICATIONS AND DRAWING. NO CLAIMS BY THE CONTRACTOR FOR EXTRA PAYMENT BASED ON THE SHOP DRAWING SHALL BE CONSIDERED.


APPROVED ☐ REVISE & RESUBMIT ☐


APPROVED WITH COMMENTS NOTED

REVISE AND RESUBMIT ✓ revise & resubmit

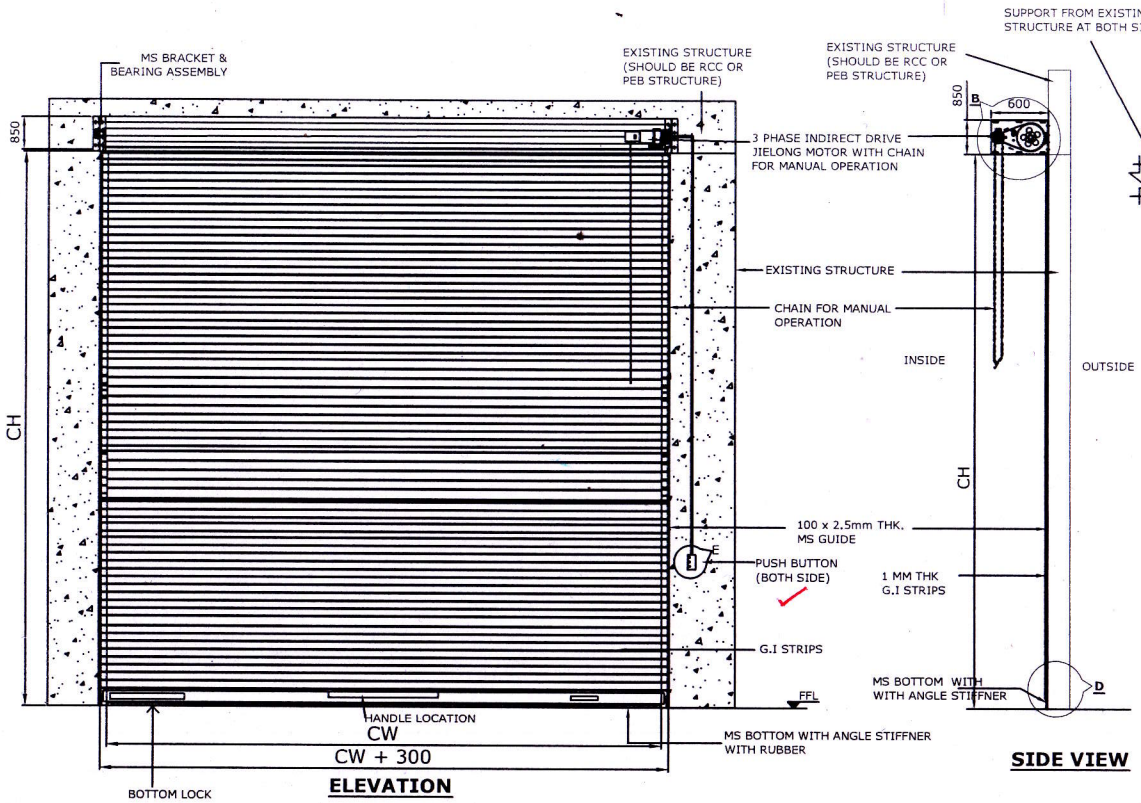

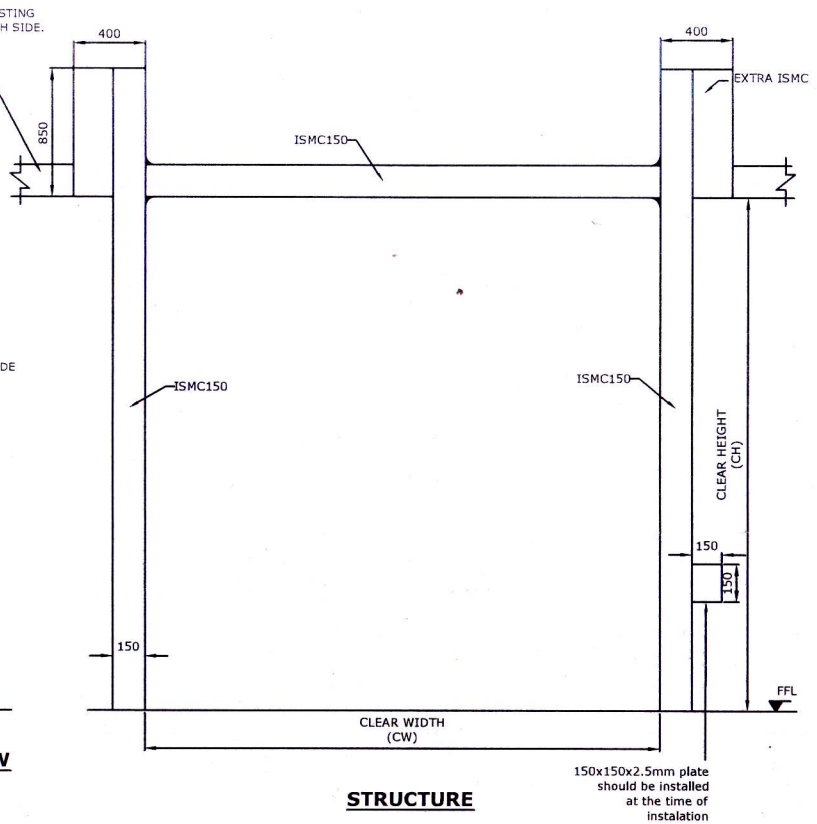

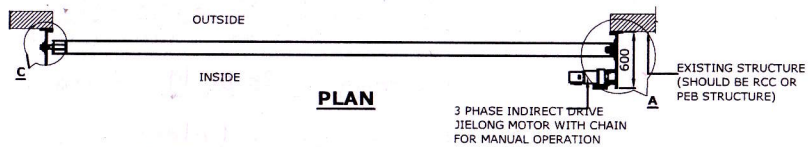

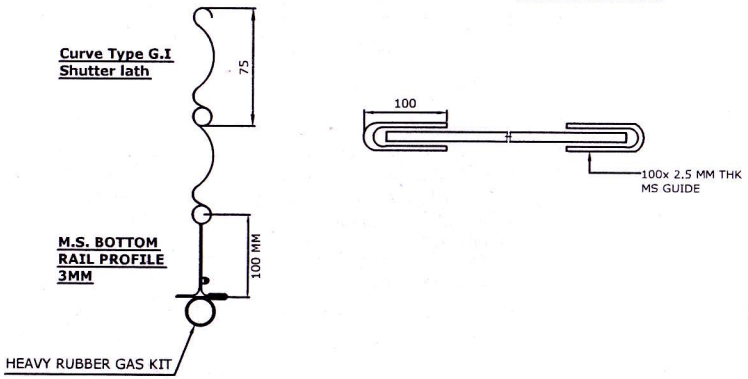

NOT REQ.

TO BE CONFIRMED BY TCL

CLEAR WIDTH (CW)	CLEAR HEIGHT (CH)	QUANTITY	RAL COLOR	LOCATION
4000	5000	5	PO RED	HSP ??
✓4000	✓5000	✓ 4	RAL - 9002	TCL - HHG ??
✓3000	✓5000	✓ 7	RAL - 9002	TCL - 3

RS1

RS2

Details marked @ A, B, C, D, E missing.

(NOTE: REQUIRED TECHANICAL STRUCTURE FOR SHUTTER IN CLIENT SCOPE)

This drawing & design is the property of NIHVA TECHNOLOGIES. Not to be sold or copied to any other concern.

TITLE	MOTORIZED ROLLING SHUTTER		
	NAME	SIGN	DATE
DRAWN	P.V.A		10.09.2019
CHECK	V.M.T		10.09.2019
APPRD.			

NIHVA TECHNOLOGIES PVT. LTD.
NIHVA TECHNOLOGIES PVT. LTD. PUNE
Tel : 020 66304033
Email:- info@nihva.com
Website:- www.nihva.com

CLIENT - M/S.RELIABLE CONSTROTECH ENT.

PROJECT -M/S.TATA CUMMINS PRIVATE LTD

SITE LOCATION - PHALTAN

If any queries contact : design@nihva.com

DWG. NO. : NIHVA/19-20/0087 REV- 0

ALL DIMENSION ARE IN mm

SCALE: NTS WT: SHEET: