
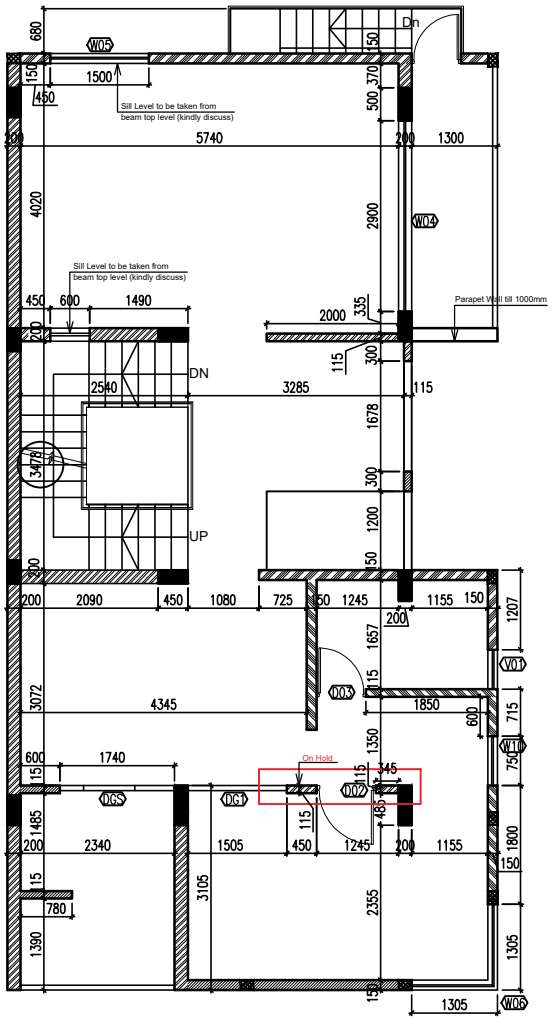


2 General Arrangement- First Floor

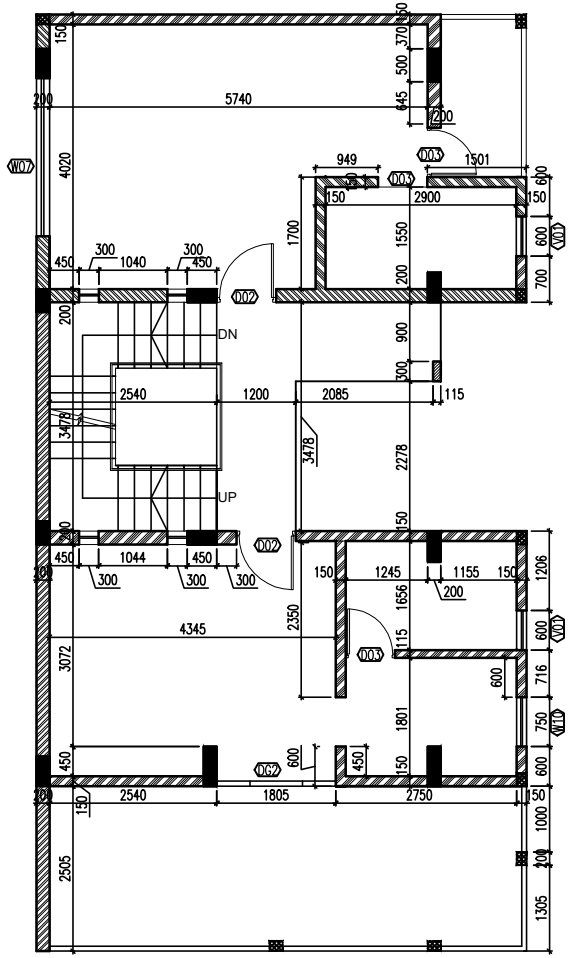

3 General Arrangement- Second Floor

SCHEDULE OF D/W/V OPENINGS

S.N.	TYPE	WIDTH	SILL	LINTEL	Ht.	Nos.	REMARK
01	D01	1200	000	2400	2400	01	Entrance Door
02	D02	900	000	2400	2400	01	Internal Door
03	D03	750	000	2400	2400	1+1+2	Toilet Door
04	D04	750	000	2100	2100	01	Ser. Rm. Door
05	D05	675	000	2100	2100	01	Ser Rm. Room
06	D06	850	000	2400	2400	01	Bed Room Door
01	W01	1200	600	2400	1800	01	External Win.
02	W02	2800	600	2400	1350	01	External Win.
~~03~~	~~W03~~	~~2090~~				~~2+1+0~~	~~Stair side Wall~~
04	W04	2900	600	2400	600	1+1	External Win.
05	W05	1500	1050	2400		01	Kitchen FF
06	W06	1305 each side	600	2400	1800	01	Corner FF
07	W07	2400	600	2400	1800	01	Rear Ext. SF
~~08~~	~~W08~~	~~900~~	~~600~~	~~2400~~	~~1800~~	~~01~~	~~Rear Ext. SF~~
09	W09	1200	900	2400	1500	01	Mumty Stairs
10	W10	750	900	2400	1500	0+1+1	External Win.
01	DGS	1890	000	2400	2400	01	First Floor
02	DG1	1500	000	2400	2400	01	First Floor
03	DG2	1800	000	2400	2400	01	Second Floor
01	V01	600	1500	2400	900	1+1+1	External Vent.
02	V02	450	1500	2100	600	1+0+0	Ser Rm. Toliet

Project Name

Mr. Bhandarkar Residence.

Client

Mr. Jajwalya Bhandarkar

Moulding Future Architects
Architectural Planning | Interior Design | BIM Consultants
www.mouldingfuture.com
info@mouldingfuture.com +91 87 99 88 0910

Notes

- Dimensions are in millimeter unless stated otherwise.
- Dimensions should be read and not measured.
- The current version shall supersede previous drawings or revision of respective area.
- Drawing can not be used for construction or any other purpose unless stamped as Good for construction (GFC).
- Site engineer must correlate architectural drawings and engineering drawings at site. Should a mis-match /discrepancy be found, same shall be notified immediately to the architect in writing.
- This drawing shall serve only for coordination for engineering / services discipline. Details and technical specifications must be referred from engineering/ vendor drawings for which technical ownership and responsibilities rests with relevant discipline expert.
- Intellectual copyright of the drawing shall remain with Moulding Future Architects. No content wholly or partially should be used for any other purpose without written consent from the firm.

References
AR: Architecture
AV: Audio vedio
EL: Electrical
FR: Fire
HV: HVAC
IT: Information technology
MG: Medical gas
PL: plumbing
STR: Structure
Ven: Vendor

Stage

Geolocation

Project Number: 2205
Scale:
Sheet Size:

Drawing Title
Brick Work Drawing

First & second Floor

Drawing Number: A 102
Revision: R1
Date: 11/05/2022

Rivision	Date Issued

Issue stamp

© Moulding Futures Architects