DWG. NO. B016-RUF-LT-504-CV-DW-0601

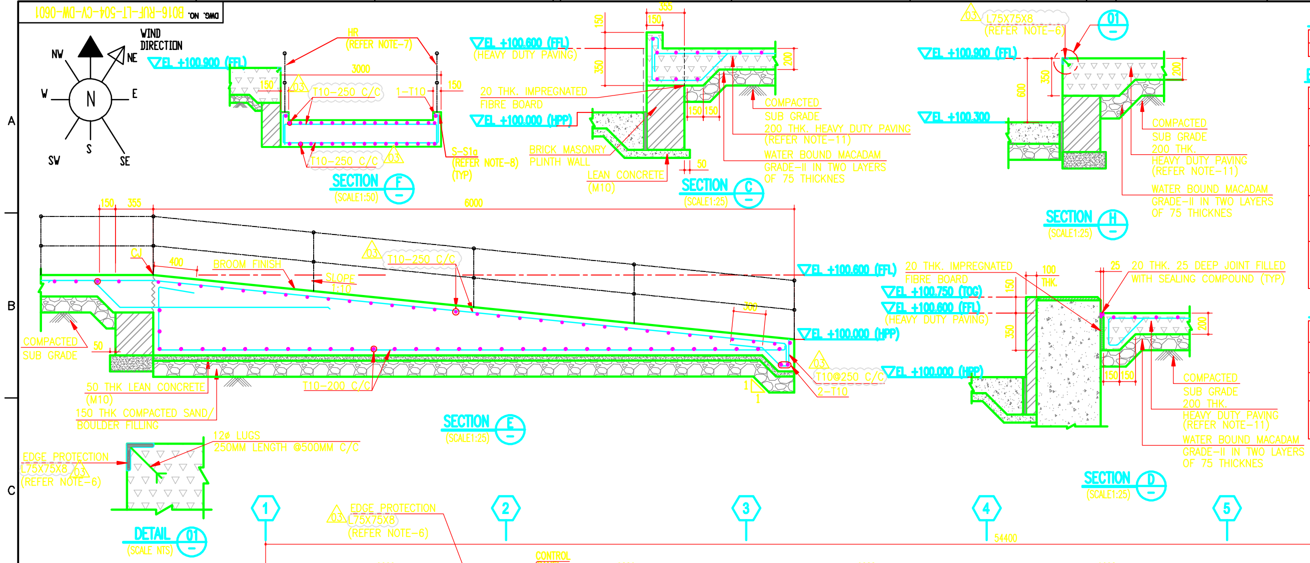
WIND DIRECTION
N
NE
E
SE
S
SW
W
NW
EL +100.900 (FFL)
HR (REFER NOTE-7)
3000
150
T10-250 C/C
1-T10
150
T10-250 C/C
03
S-S1a (REFER NOTE-8) (TYP)
SECTION F (SCALE1:50)
EL +100.600 (FFL) (HEAVY DUTY PAVING)
20 THK. IMPREGNATED FIBRE BOARD
EL +100.000 (HPP)
BRICK MASONRY PLINTH WALL
LEAN CONCRETE (M10)
355
150
350
200
150 150
50
COMPACTED SUB GRADE
200 THK. HEAVY DUTY PAVING (REFER NOTE-11)
WATER BOUND MACADAM GRADE-II IN TWO LAYERS OF 75 THICKNES
SECTION C (SCALE1:25)
L75X75X8 (REFER NOTE-6)
01
EL +100.900 (FFL)
EL +100.300
600
350
200
COMPACTED SUB GRADE
200 THK. HEAVY DUTY PAVING (REFER NOTE-11)
WATER BOUND MACADAM GRADE-II IN TWO LAYERS OF 75 THICKNES
SECTION H (SCALE1:25)
150 355
6000
CJ
400
BROOM FINISH
SLOPE 1:10
T10-250 C/C
300
COMPACTED SUB GRADE
50
50 THK LEAN CONCRETE (M10)
150 THK COMPACTED SAND/ BOULDER FILLING
T10-200 C/C
T10@250 C/C
2-T10
1
1
SECTION E (SCALE1:25)
EL +100.600 (FFL)
20 THK. IMPREGNATED FIBRE BOARD
EL +100.750 (TOC)
EL +100.600 (FFL) (HEAVY DUTY PAVING)
EL +100.000 (HPP)
EL +100.000 (HPP)
100 THK.
150
350
25
20 THK. 25 DEEP JOINT FILLED WITH SEALING COMPOUND (TYP)
200
150 150
COMPACTED SUB GRADE
200 THK. HEAVY DUTY PAVING (REFER NOTE-11)
WATER BOUND MACADAM GRADE-II IN TWO LAYERS OF 75 THICKNES
SECTION D (SCALE1:25)
EDGE PROTECTION L75X75X8 (REFER NOTE-6)
12ø LUGS 250MM LENGTH @500MM C/C
DETAIL 01 (SCALE NTS)
1
2
3
4
5
54400

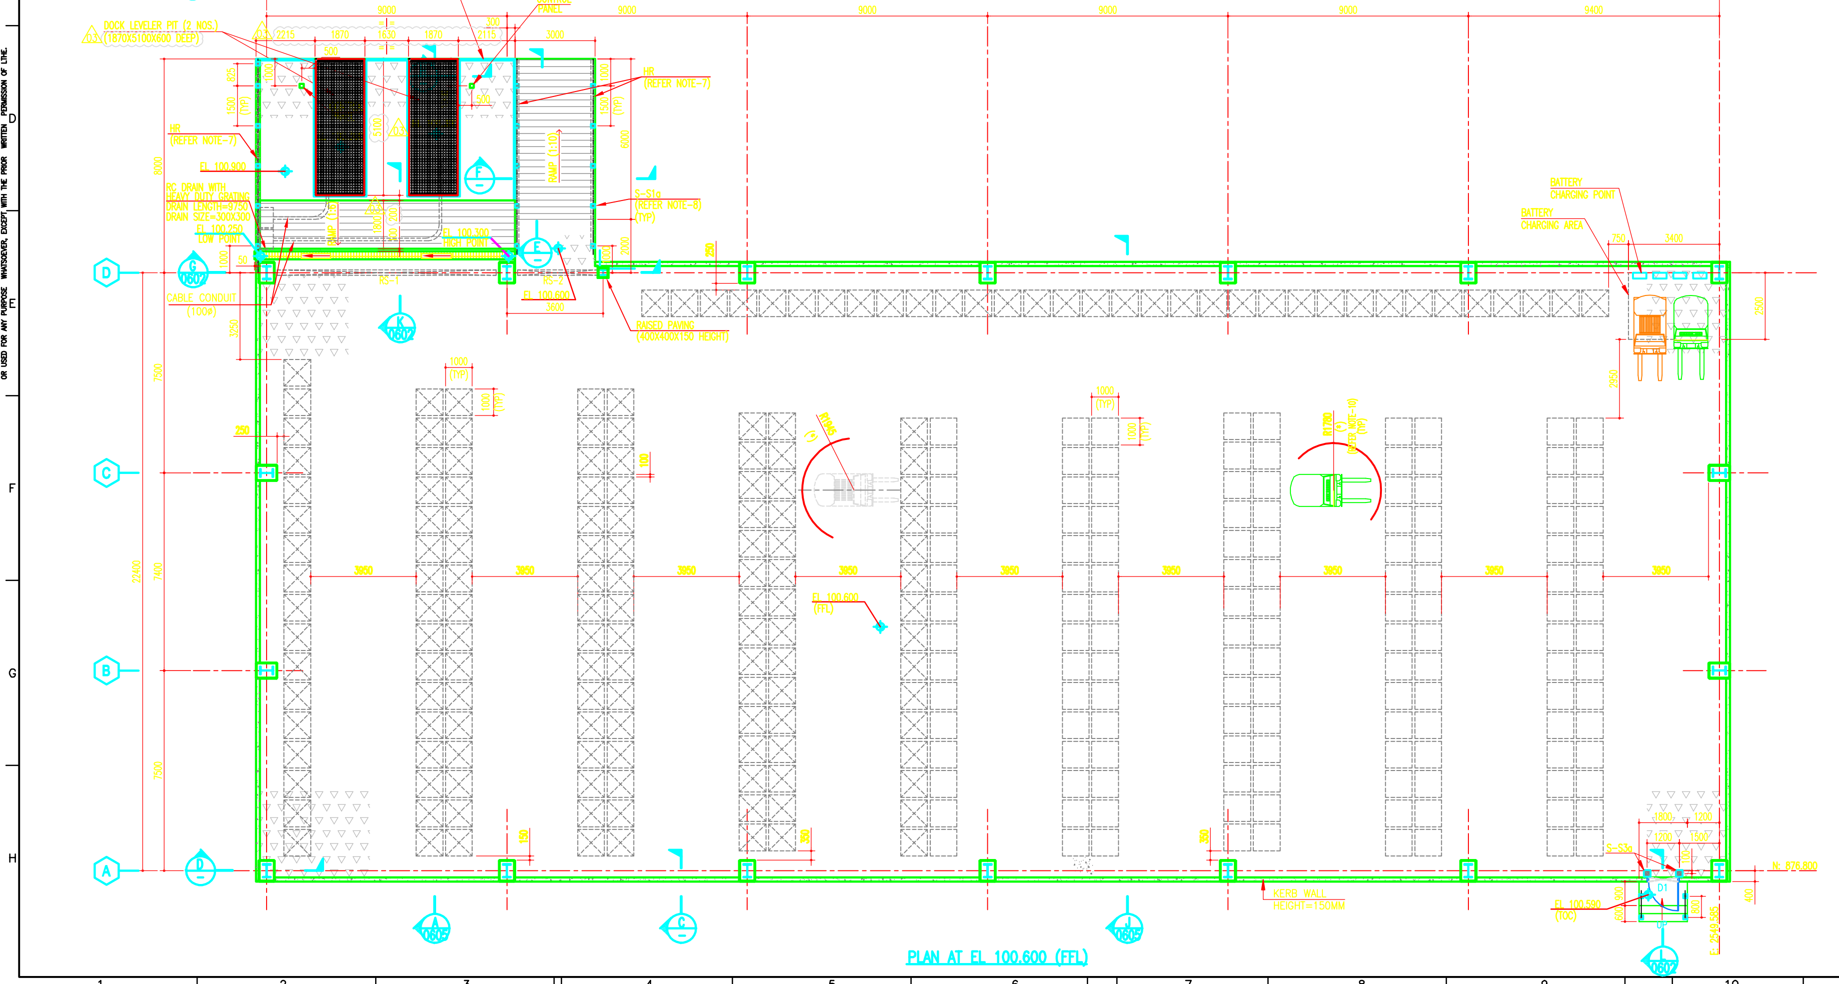

INTERIOR FINISHES SCHEDULE

AREA	FLOORING	REMARKS
CATALYST BAG STORAGE AREA	HEAVY DUTY FLOORING	

EXTERIOR FINISHES SCHEDULE

AREA	BASE MATERIAL	FINISH	REMARKS
KERB WALL	CONCRETE	ALL EXTERNAL WALL SURFACES SHALL BE FINISHED WITH 12MM THK. PLAIN CEMENT PLASTER (1:4) & FINISHED WITH OIL BOUND DISTEMPER	
ALL SIDES	CLADDING	MIN. 0.52 THK. PROFILED, PRECOATED, GALVALUME/ZINCALUME STEEL SHEETING	COMPLYING TO TECHNICAL SPECIFICATION DOC. NO. B016-504-81-41-SP-9509. SHALL BE PROVIDED WITH CLIP LOCK ARRANGEMENT.
ROOF	SHEETING	MIN. 0.52 THK. PROFILED, PRECOATED, GALVALUME/ZINCALUME STEEL SHEETING	COMPLYING TO TECHNICAL SPECIFICATION DOC. NO. B016-504-81-41-SP-9509. SHALL BE PROVIDED WITH CLIP LOCK ARRANGEMENT.
SKYLIGHT	POLYCARBONATE SHEET	2mm THK. CLEAR EMBOSSED POLYCARBONATE PROFILE SHEET, WITH BOTH SIDE UV STABILIZER,HAVING 60~80% TRANSPERANCY, TO MATCH METAL SHEETING WITH PROPER SIDE LAPS.	ALL LAPS SHALL BE FILLED WITH SILICON/BUTYL/SEALENT FOR PROPER LEAK PROOF LAPS.

SCHEDULE OF ROLLING SHUTTER & DOOR

MARK	SIZE	NOS	DESCRIPTION	REMARKS
RS-1	8200 X 5500	01	ROLLING SHUTTER - EXTERNAL	COMPLYING TECHNICAL SPECIFICATION DOC NO. B016-504-81-41-SP-9509
RS-2	3000 X 5500	01	ROLLING SHUTTER - EXTERNAL	
D1	1200 X 2100	01	PRESSED STEEL FRAME WITH SINGLE LEAF PRESSED STEEL DOUBLE SKIN SHUTTER WITH VISION PANEL	AS PER SPECIFICATION

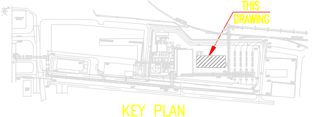

KEY PLAN

LEGENDS FOR FRESH CATALYST STORAGE

RACKS :

1) TYPE-1 : GR-823 G ☒
NO. OF STORAGE BAG - 636

2) TYPE-2 : GR-LS10 ☐
NO. OF STORAGE BAG - 540

TOTAL NO. OF STORAGE BAGS - 1176

NOTES :

1. ALL DIMENSIONS ARE IN MILLIMETERS AND LEVELS ARE IN METERS UNLESS NOTED OTHERWISE.
2. HIGH POINT OF PAVING (HPP) ELEVATION +100.000 CORRESPONDS TO REDUCED LEVEL(RL) 4.300 ABOVE MEAN SEA LEVEL (MSL)
3. ONLY FIGURED DIMENSIONS SHALL BE FOLLOWED. DIMENSIONS SHALL NOT BE SCALED.
4. INTERNAL ARRANGEMENT OF FRESH CATALYST STORAGE BAGS SHOWN HERE ARE INDICATIVE ONLY.
5. THIS DRAWING SHALL BE READ IN CONJUNCTION WITH ALL ARCHITECTURAL & STRUCTURAL DRAWINGS OF THIS SHED.
6. EDGE PROTECTION ANGLE TO BE PROVIDED ALL AROUND DOCK LEVELER PIT.
7. FOR HAND RAIL DETAILS, REFER EIL STANDARD DRAWING NO. 7-68-0501.
8. FOR DETAILS OF INSERT PLATES, REFER TO STD DWG. NO. B016-RUF-LT-504-CV-DW-0009.
9. INFORMATION OF INSERT PLATES SHALL BE EXPRESSED AS FOLLOWS:
   9.1 IDENTIFICATION MARKS
   S - IP1
   - TYPE OF INSERT PLATE
   - FOR PIPING - P
   - FOR ELECTRICAL - E
   - FOR EQUIPMENT - M
   - FOR STRUCTURE - S
   - FOR INSTRUMENT - I
   9.2 CENTER OF INSERT PLATE SHALL BE THE REFERENCE FOR ITS LOCATION UNO.
   CENTER (TYP)
10. FOR FORKLIFT AND REACH TRUCK DIMENSION REFER DWG NO. B016-RUF-LT-504-CV-DW-0605
11. FOR RCC PAVING REFER TO EIL STANDARD DWG NO. 7-65-0404.

03

LEGEND :

▤ : FRESH AIR LOUVERS
▨ : BRICK MASONRY WALL
▽ : HEAVY DUTY PAVING
▥ : SHEETING
▦ : HEAVY DUTY GRATING
▩ : SKYLIGHT TRANSLUSION SHEETING POLYCARBONATE SHEET
TOC : TOP OF CONCRETE
HP : HIGH POINT
LP : LOW POINT
RWP : RAIN WATER PIPE
RS : ROLLING SHUTTER
HR : HANDRAIL

DRAWING NO.	DRAWING TITLE	REV
B016-RUF-LT-504-CV-DW-0614	FRAMING ELEVATION-2 SHED FOR FRESH CATALYST STORAGE	
B016-RUF-LT-504-CV-DW-0613	FRAMING ELEVATION-1 SHED FOR FRESH CATALYST STORAGE	
B016-RUF-LT-504-CV-DW-0611	FRAMING PLAN ROOF LEVEL SHED FOR FRESH CATALYST STORAGE	
B016-RUF-LT-504-CV-DW-0610	FRAMING PLAN -1 SHED FOR FRESH CATALYST STORAGE	
B016-RUF-LT-504-CV-DW-0605	ARCHITECTURAL SECTION SHED FOR CATALYST STORAGE	
B016-RUF-LT-504-CV-DW-0604	ARCHITECTURAL ELEVATION -2 SHED FOR CATALYST STORAGE	
B016-RUF-LT-504-CV-DW-0603	ARCHITECTURAL ELEVATION -1 SHED FOR CATALYST STORAGE	
B016-RUF-LT-504-CV-DW-0602	ARCHITECTURAL PLAN -2 SHED FOR CATALYST STORAGE	

REFERENCE DOCUMENTS / DRAWINGS

DRG. CATEGORY: (USE TICK MARK) R [✓ I]
SCH. DATE OF SUBMISSION
EIL REVIEW/APPROVAL CODE:
VPTL NO.:

DOCUMENT STATUS
STATEMENT OF SUB: 1st 2nd 3rd
☐ FINAL FOR CODE-1 ☐ AS BUILT

ISSUED FOR
☐ AS BUILT ☑ INFORMATION
☐ CONSTRUCTION ☐ REVIEW

SIGN: DATE:

☐ REVIEW CODE 1 - NO COMMENTS PROCEED WITH MANUFACTURE / FABRICATION/ CONSTRUCTION AS PER THE DOCUMENT.
☐ REVIEW CODE 2 - PROCEED WITH MANUFACTURE / FABRICATION / CONSTRUCTION AS PER THE COMMENTED DOCUMENT. REVISED DOCUMENT REQUIRED.
☐ REVIEW CODE 3 - DOCUMENT DOES NOT CONFORM TO BASIC REQUIREMENTS AS MARKED. RESUBMIT FOR REVIEW.
☐ R - DOCUMENT IS RETAINED FOR RECORDS. PROCEED WITH MANUFACTURE / FABRICATION
☐ V-VOID
NAME DICIPLINE SIGN. DATE

REV.	DESCRIPTION	DRN	CHECKED	APPROVED	REVIEWED	APPROVED	DATE
03	ISSUED FOR INFORMATION	VBP	NKP	CAM/JAJ	KDS	BDT	09.06.21
02	ISSUED FOR INFORMATION	VBP	NKP	CAM/JAJ	KDS	BDT	15.03.21
01	ISSUED FOR INFORMATION	VBP	NKP	CAM/JAJ	KDS	BDT	04.12.20
00	ISSUED FOR INFORMATION	VBP	NKP	CAM/JAJ	KDS	BDT	22.09.20

OWNER HINDUSTAN PETROLEUM CORPORATION LIMITED
VISAKH REFINERY MODERNIZATION PROJECT
EPCC-03 PACKAGE FOR RESIDUE UP-GRADATION FACILITY (RUF)

PMC : ENGINEERS INDIA LIMITED (A Govt. of India Undertaking)

LSTK CONTRACTOR: L&T Hydrocarbon Engineering

DETAILED ENGINEERING CENTER: L&T - CHIYODA LIMITED

DATE: 09.06.21
SCALE: 1:100
TITLE: ARCHITECTURAL PLAN-1 SHED FOR FRESH CATALYST STORAGE
DEPT: CV
DRN BY: VBP
CHK BY: NKP
APP BY: CAM/JAJ
PROJECT: RUF
PWO NO.: B016
DRG. NO.: B016-RUF-LT-504-CV-DW-0601
SH. 1 OF 1
REV. 03
CAD REVISE THIS DRG. USING CAD SYSTEM ONLY FILE: B016-RUF-LT-504-CV-DW-0601

ALL RIGHTS RESERVED
THIS DOCUMENT AND ANY DATA AND INFORMATION CONTAINED THEREIN ARE CONFIDENTIAL AND THE PROPERTY OF L&T HYDROCARBON ENGINEERING (LTHE) AND THE COPYRIGHT THEREIN IS VESTED IN LTHE NO PART OF THIS DOCUMENT, DATA, OR INFORMATION SHALL BE DISCLOSED TO OTHERS OR REPRODUCED IN ANY MANNER OR USED FOR ANY PURPOSE WHATSOEVER, EXCEPT WITH THE PRIOR WRITTEN PERMISSION OF LTHE.

A1