




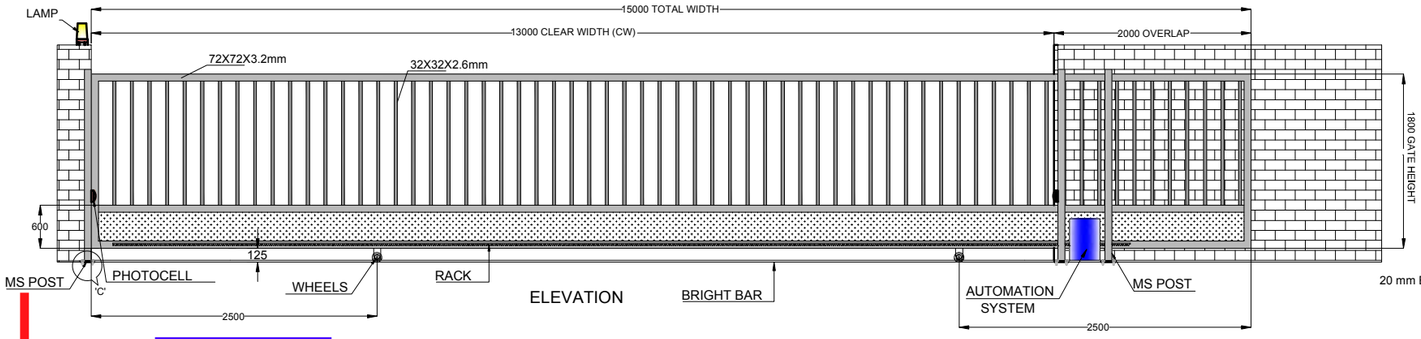


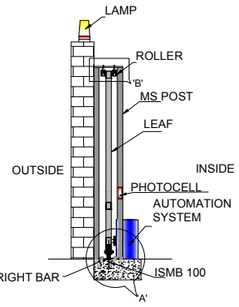

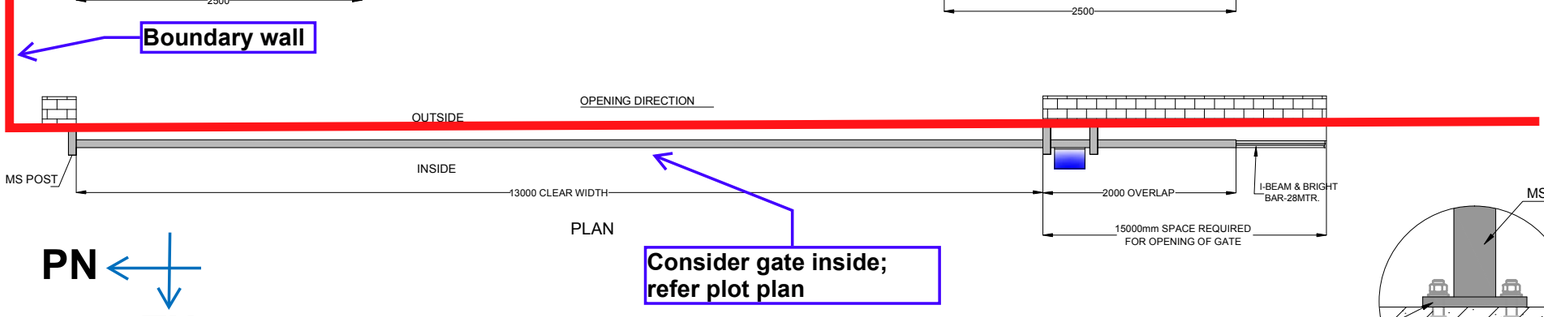

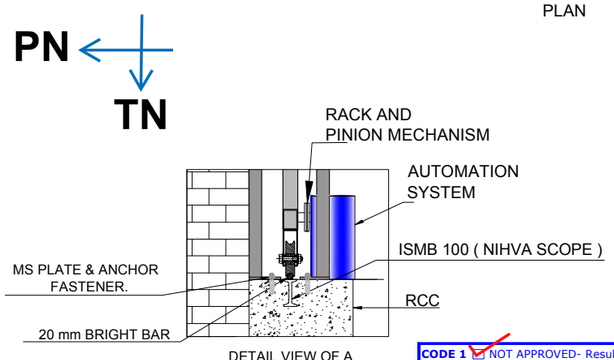

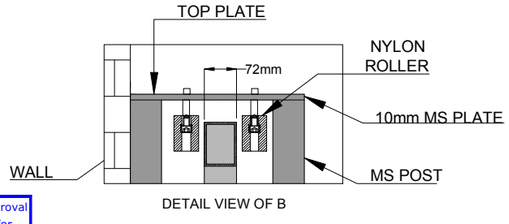

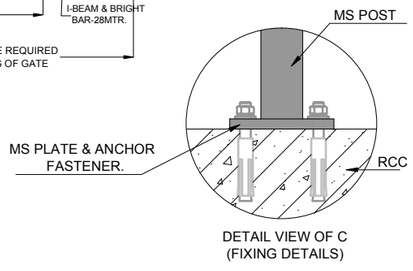

SR NO	TUBE SPECIFICATION	
1	72X72X3.2mm MS TUBE	OUTER FRAME
2	32X32X2mm MS TUBE	INNER PATTERN
3	GAP BETWEEN TUBES	150mm
4	MS SHEET	MS SHEET
5	72X72X3.2mm MS TUBE	FOR POST

04	RAL 7035	LIGHT GREY	TOLERANCE:- ± 10mm
03	RAL 5002	ULTRAMARINE BLUE	
02	RAL 9002	GREY WHITE	
01	RAL 1004	GOLDEN YELLOW	
SR.NO	RAL CODE	RAL COLOR	

CLEAR WIDTH (CW)	CLEAR HEIGHT (CH)	QUANTITY
13000mm	1800mm	1 NOS

REV. NO	NAME	DATE	DESCRIPTION
R01	SURAJ	13-11-18	1.CHANGE FOR SPACE REQUIRED FOR OPENING OF GATE. 2.BEAM & BRIGHT BAR SIZE DETAILS CHANGED.

CODE 1 ☑ NOT APPROVED- Resubmit for Approval
CODE 2 ☐ APPROVED AS NOTED - Released for Fabrication/Construction. Resubmit for Approval- Did NOT meet requirements.
CODE 3 ☐ APPROVED AS NOTED - Released for Fabrication/Construction. Submit Certified drawing for Final Approval
CODE 4 ☐ APPROVED- No further submittal required, unless dwg./Doc. is revised.
☐ ACCEPTED FOR INFORMATION ONLY
Vendor is not relieved of responsibility for accuracy of dimensions, performance, design, design of details or any code requirements.
INOX AIR PRODUCTS ENGINEERING DIVISION, PUNE, INDIA
DATE:
SIGN:

REVIEWED
arif , 15:02:05, 20/11/2018

DIMENSION :

CLEAR WIDTH	CLEAR HEIGHT	QUANTITY
13000mm	1800mm	1 NOS

MATERIAL: MS

THICKNESS :

NOTE-
1. ALL REQUIRED CIVIL WORK WILL BE IN CLIENTS SCOPE.
2.ONE COAT OF RED OXIDE & TWO COAT OF APPROVED RAL SHADE WILL BW GIVEN TO THE GATE
3.IN NECESSARY GATE LEAF WILL BE IN TWO PARTS FOR TRANSPORTATION AND ILL BE WELDED TOGETHER ON SITE

NIHVA TECHNOLOGIES PVT. LTD.
NIHVA TECHNOLOGIES PVT. LTD. PUNE
Website:- www.nihva.com
Email:- info@nihva.com
TEL :020 66304033

TITLE:
AUTOMATIC SINGLE LEAF SLIDING GATE

CLIENT'S APPROVAL :

CLIENT - INOX
PROJECT -
SITE LOCATION -CHAKAN
DWG. NO. : NIHVA/18-19/0166 /R01 | REV. : 01
SCALE: NTS | WT: | SHEET:1 OF 1

DRAWN	SURAJ		DATE: 03-11-18
CHECK	PRADEEP		DATE: 03-11-18
APPROVED	R.D		DATE: 03-11-18

IF ANY QUERIES CONTACT:- design@nihva.com
NOTE: ALL DIMENSIONS ARE IN mm

THIS DRAWING & DESIGN IS THE PROPERTY OF NIHVA TECHNOLOGIES. NOT TO BE SOLD OR COPIED TO ANY OTHER CONCERN.