
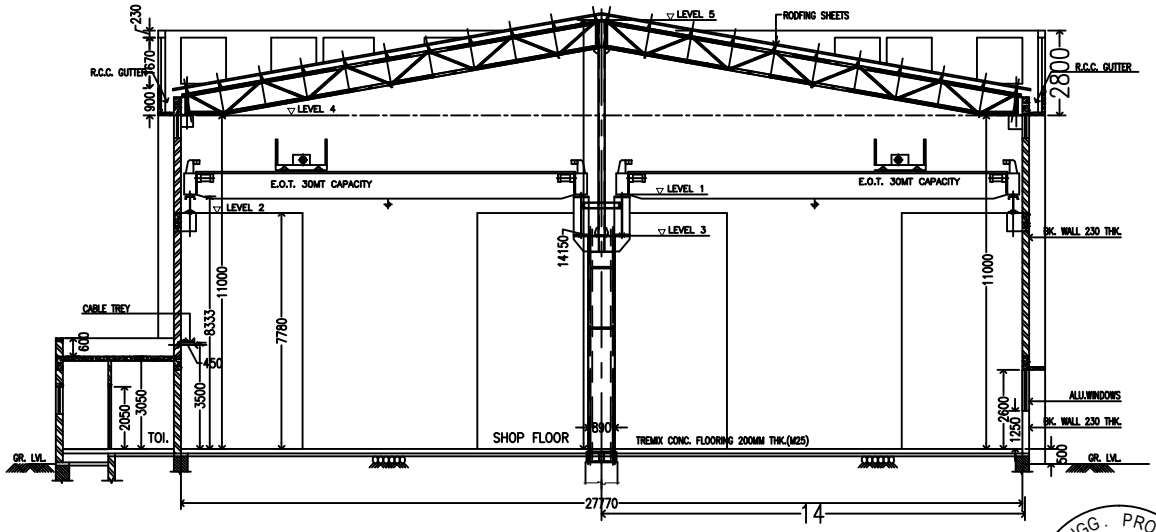



SECTION C-C'

LEVEL 1 – TOP OF CRANE RAIL +8.333 (RAIL SIZE 63mm Sq. BAR)
LEVEL 2 – R.C.C. BRACKET LEVEL +7.717
LEVEL 3 – STEEL BRACKET LEVEL +6970
LEVEL 4 – TIE LEVEL +11.000
LEVEL 5 – TRUSS TOP LEVEL +14.150

ARCHIVISTA ENGG. PROJECTS PVT. LTD.
AS BUILT DRAWING

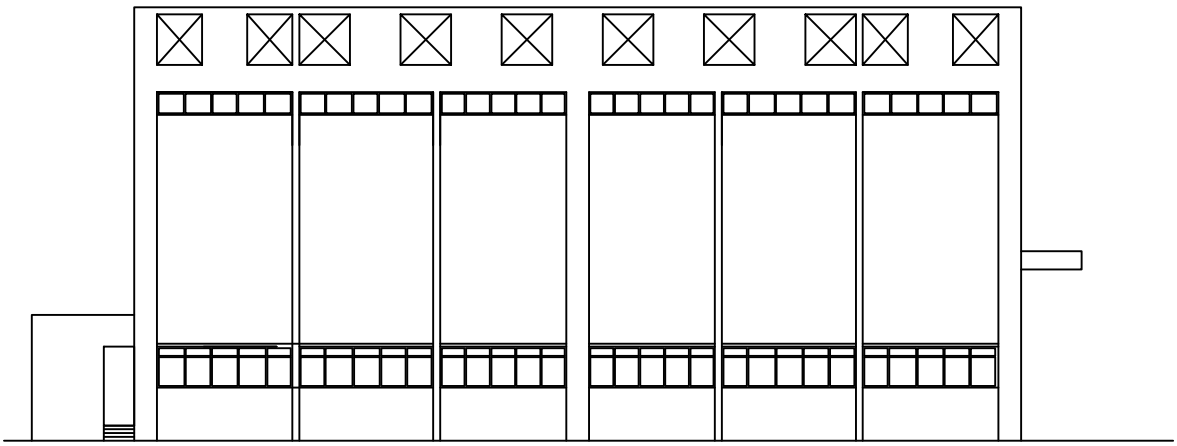

EAST SIDE ELEVATION SMCAC -II

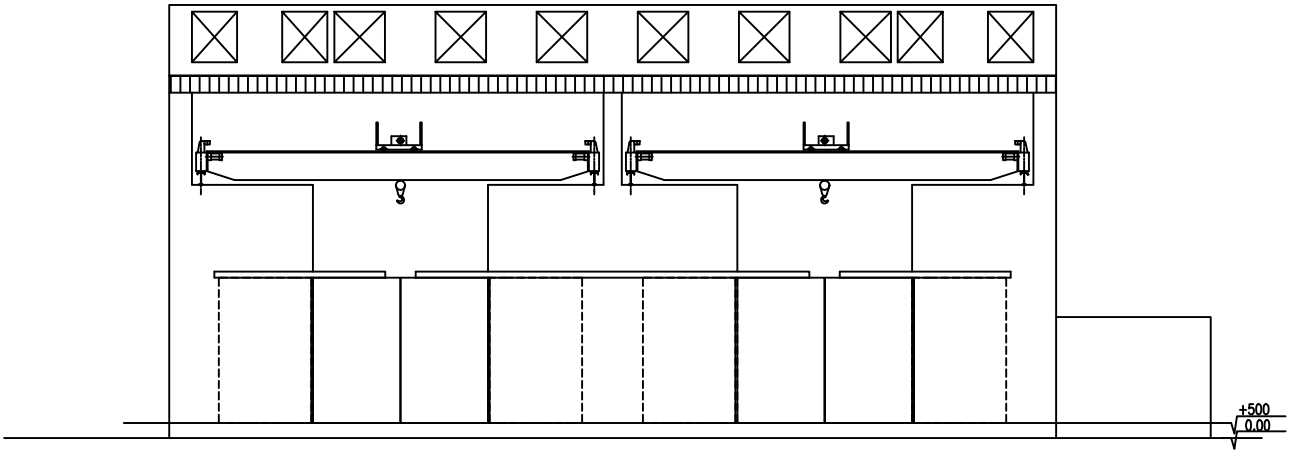

WEST SIDE ELEVATION SMCAC-II