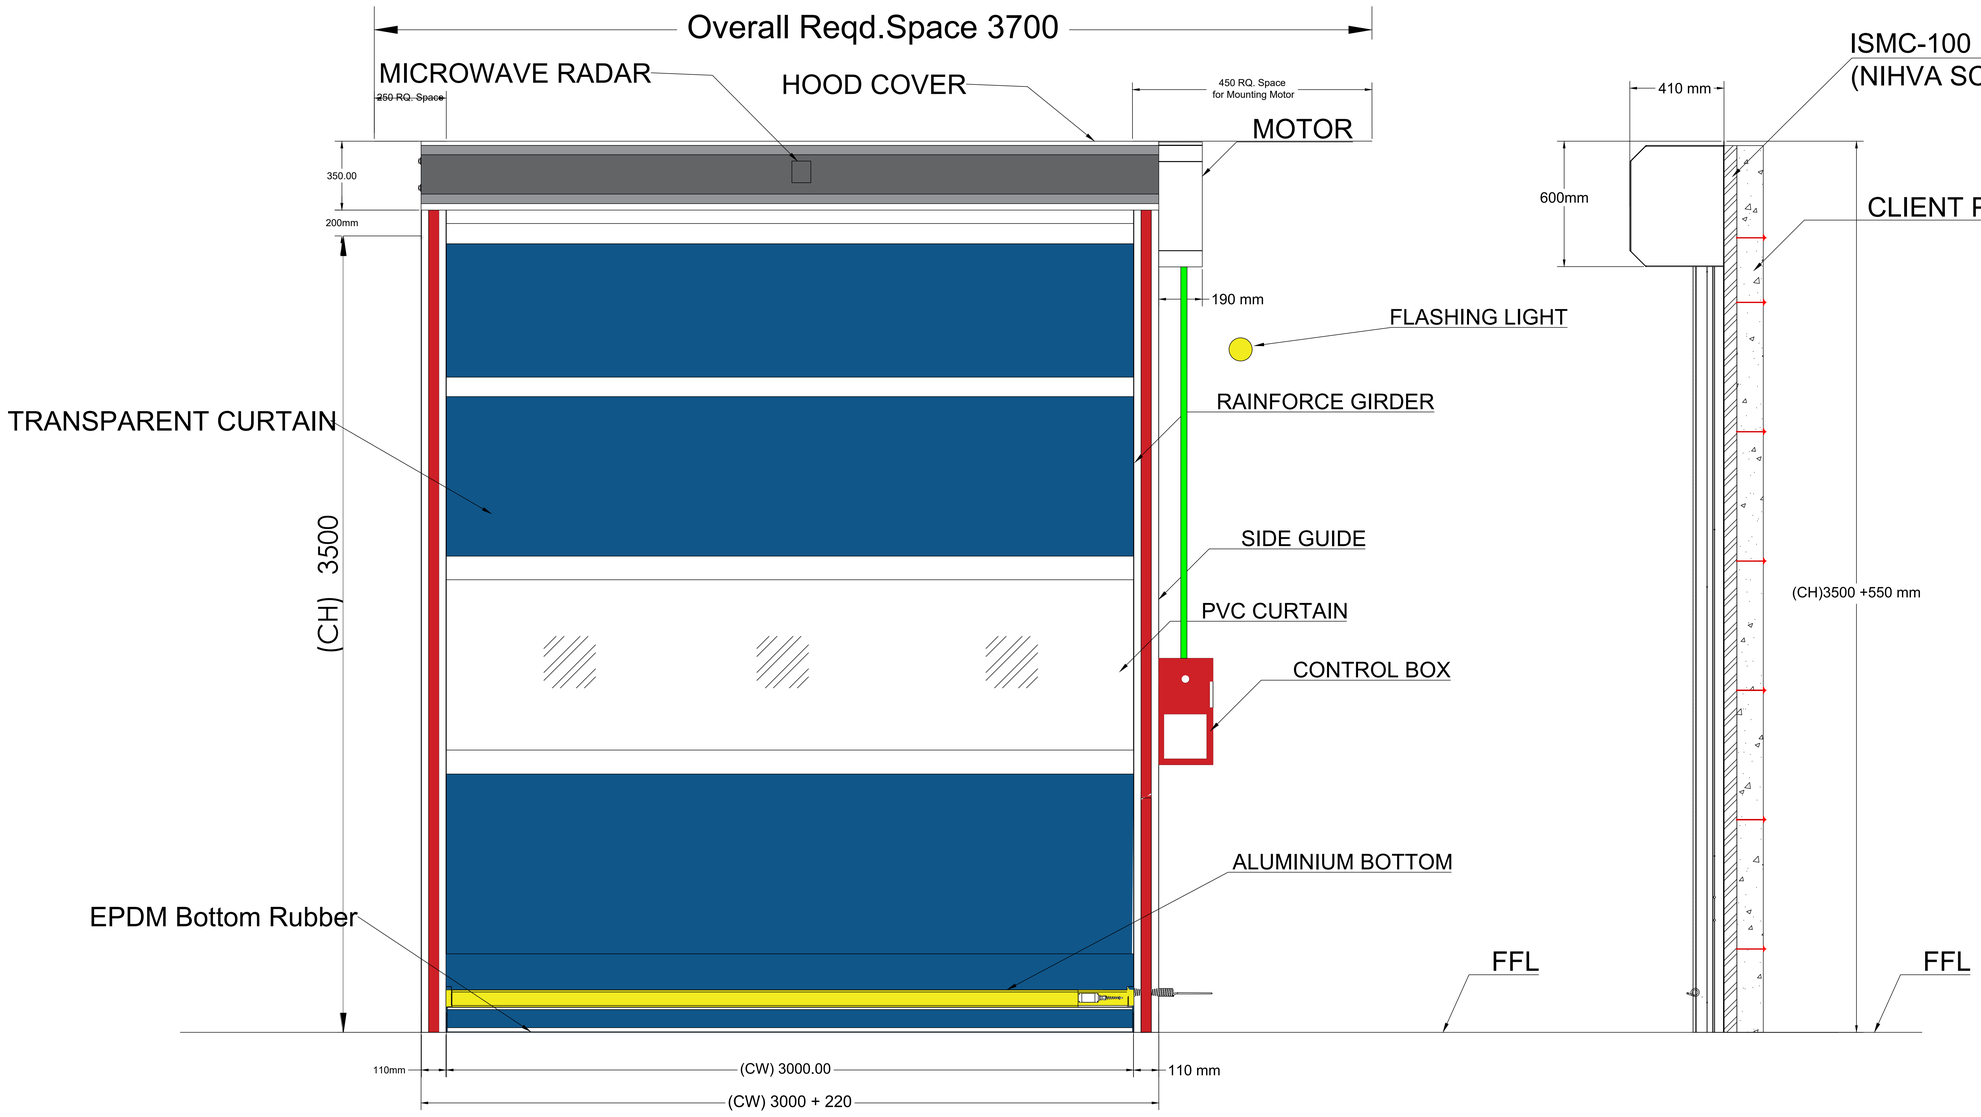


CAT - I	APPROVED - *No Further Comments*	
CAT - II	APPROVED - *Subjected to Incorporation of Comments as Marked.*	
CAT - III	NOT APPROVED *Resubmit with Incorporation of Comments as Marked / Discussed.*	
CAT - IV	INVALID SUBMISSION *Due to Non-Conformity of Tender specifications / drawings*	
(Sign & Date)	(Name & Designation)	(Remarks)

vms

COMMON COMMENTS :
1. CONTRACTOR NEEDS TO VERIFY THE DIMENSION OF THE OPENING ON SITE BEFORE PROCEEDING FOR EXECUTION
2. OPENING CONDITION OF THE ROLLING SHUTTER SHOULD BE AS PER THE PLAN
3. NO DEVIATION FROM TENDER SPECIFICATION WILL BE ALLOWED.
4. COLOR OF CURTAIN, SIDE GUIDES,STEEL CASING FOR TOP ROLLER, STEEL MOTOR GUARD TO BE CONFIRMED BY THE CLIENT.

TECHNICAL SPECIFICATION :

SR.	SPECIFICATIONS	DETAILS
1	**Control Panel**	LED Display Servo Controller : - Operating Speed (Adjustable) : 1.4~2.5 min/ Working Temperature : -35 degree to 65 degree - Water Resistant : IP65 Make IDER, manufactured under European Standards
2	**Drive**	**IDER Make ,CE Certified**
3	**Motor Power ,Torque**	**Power : 1.1 kW Torque : 65 Nm**
4	**Door Travel Speed**	**Opening: 2 m/Sec & Closing:0.9m/Sec**
5	**Safety Device**	**Safety Photocell Pair & Safety Edges**
6	**Surface Finish**	**As Per Client Requirement**
7	**Accessories**	**Radar Sensor ,Magnetic Loop Detector ,Flashing Light Buzzer**

NOTE:

All Cables & Ele.Conduits to be provided by NIHVA
(1) All Civil Work in Client Scope
(2) Required M.S.Structure & Fittings at Nihva Scope

Sr	Clear Width (CW)	Clear Height (CH)	QTY
1	**3000**	**3500**	3


This drawing & design is the property of NIHVA TECHNOLOGIES. Not to be sold or copied to any other concern.


TITLE: HIGH SPEED DOOR WITH SENSOR GA DRAWING


	NAME	SIGN	DATE
DRAWN	S.J		18.01.2024
CHECK	A.K		18.01.2024
APPRD.	V.T		18.01.2024

NIHVA TECHNOLOGIES PVT. LTD.
NIHVA TECHNOLOGIES PVT. PUNE
Tel : 020 66304033
Email:- info@nihva.com
Website:- www.nihva.com

CLIENT - RINAC
PROJECT - HIGH SPEED DOOR
FORMAT NO - NIHVA-DD-F-03
If any queries contact : projectsupport@nihva.com
DWG. NO. : NIHVA/23-24/00XX
REV- R00
ALL DIMENSION ARE IN mm
SCALE: NTS
WT:
SHEET:

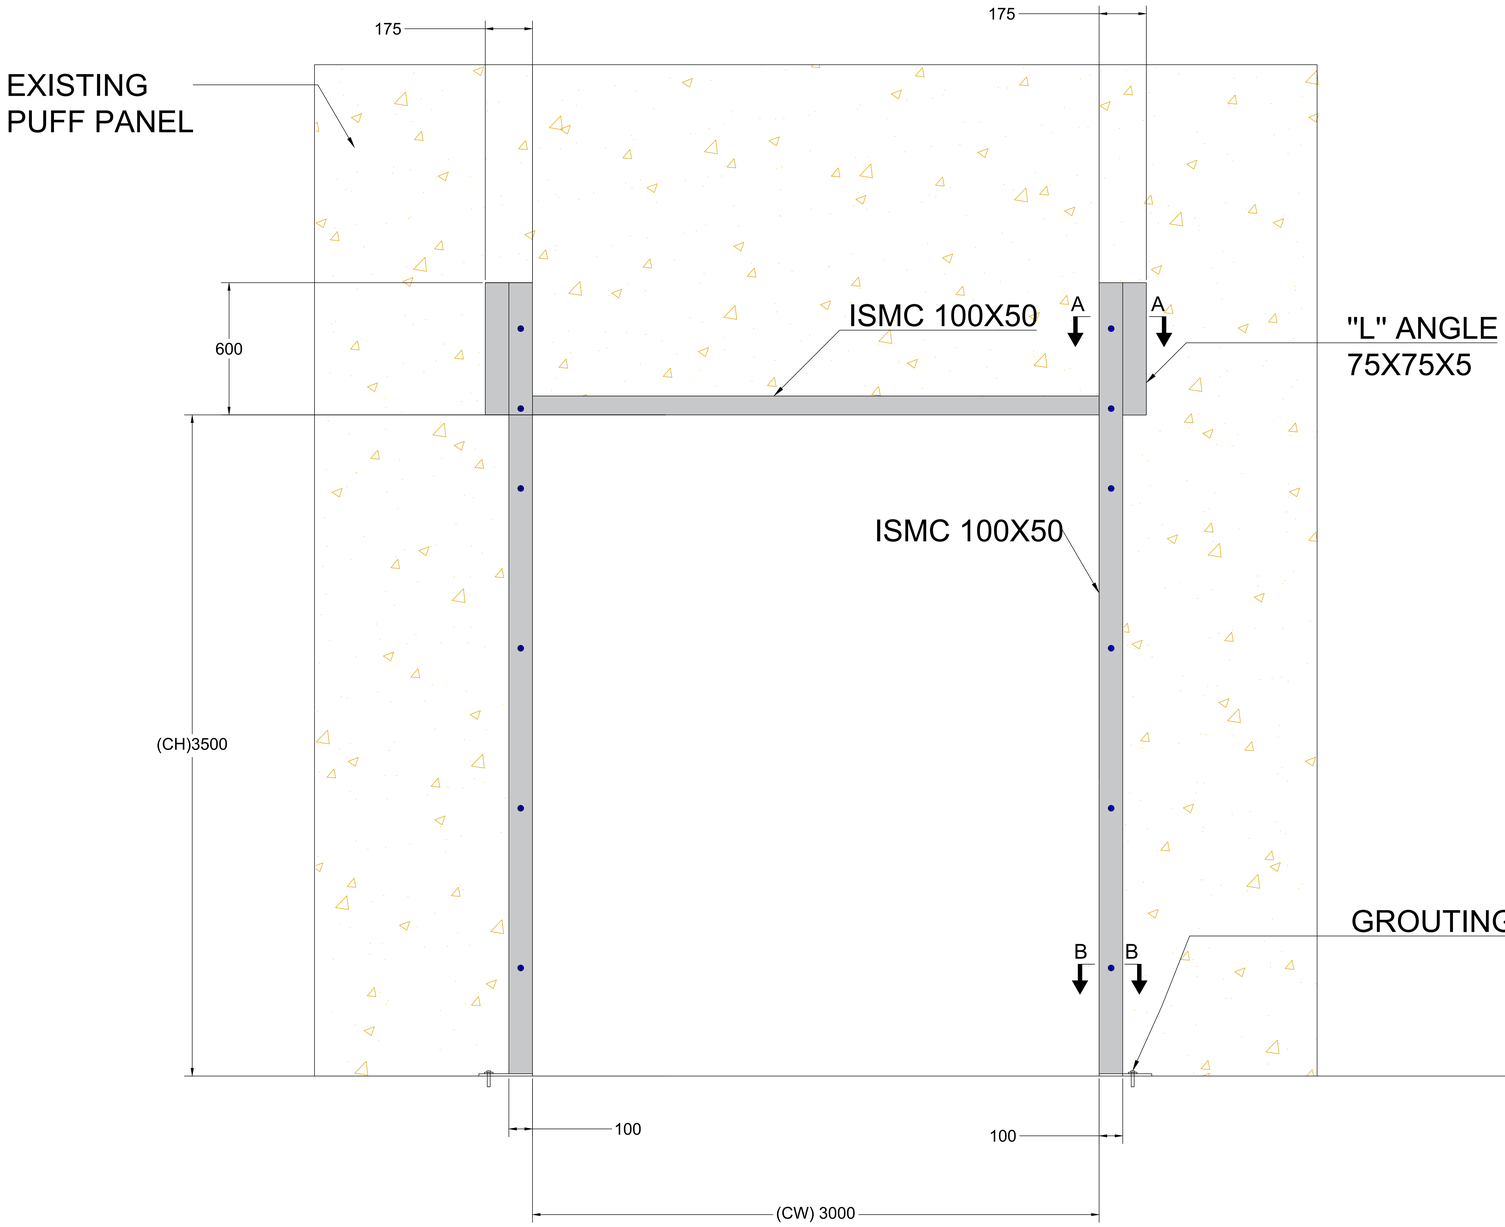

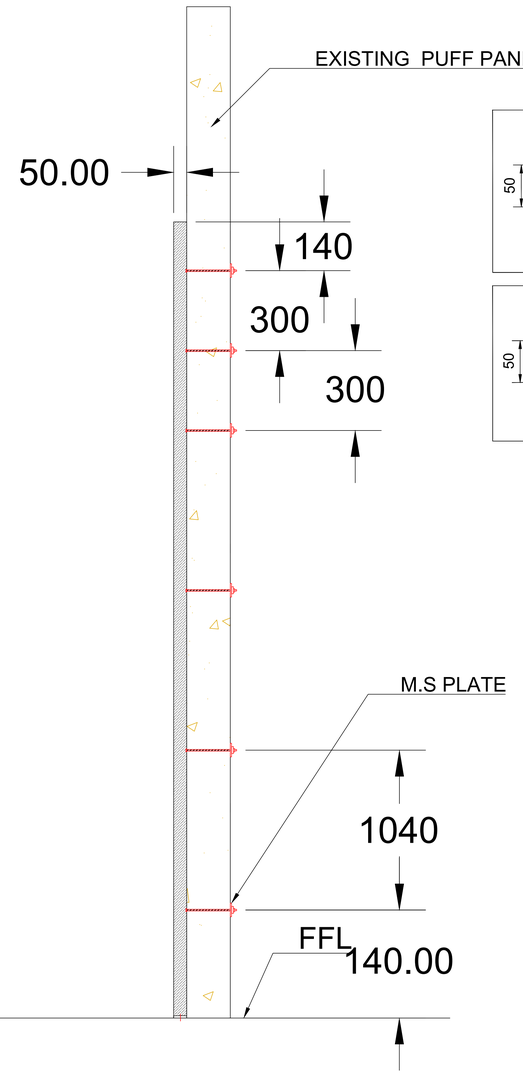

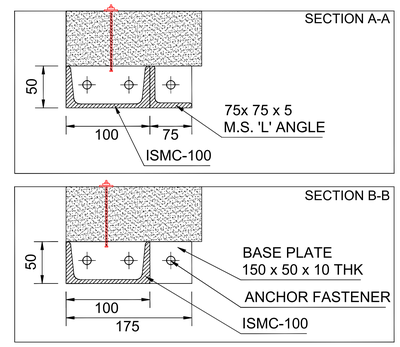


M.S. STRUCTURE DETAILS

Sr	Description	Clear Width (CW)	Clear Height (CH)	QTY
1	HSD With Sensor	**3000**	**3500**	3

This drawing & design is the property of NIHVA TECHNOLOGIES. Not to be sold or copied to any other concern.

TITLE	HIGH SPEED DOOR STRUCTURE DRAWING			NIHVA TECHNOLOGIES PVT. LTD. PUNE Tel : 020 66304033 Email:- info@nihva.com Website:- www.nihva.com	
	NAME	SIGN	DATE		
DRAWN	S.J		18.01.2024	CLIENT - RINAC	
CHECK	A.K		18.01.2024	PROJECT - HIGH SPEED DOOR ST.	
APPRD.	V.T		18.01.2024	FORMAT NO - NIHVA-DD-F-03	
If any queries contact : projectsupport@nihva.com				DWG. NO. : NIHVA/23-24/00XX	REV- R00
ALL DIMENSION ARE IN mm				SCALE: NTS	WT: SHEET:

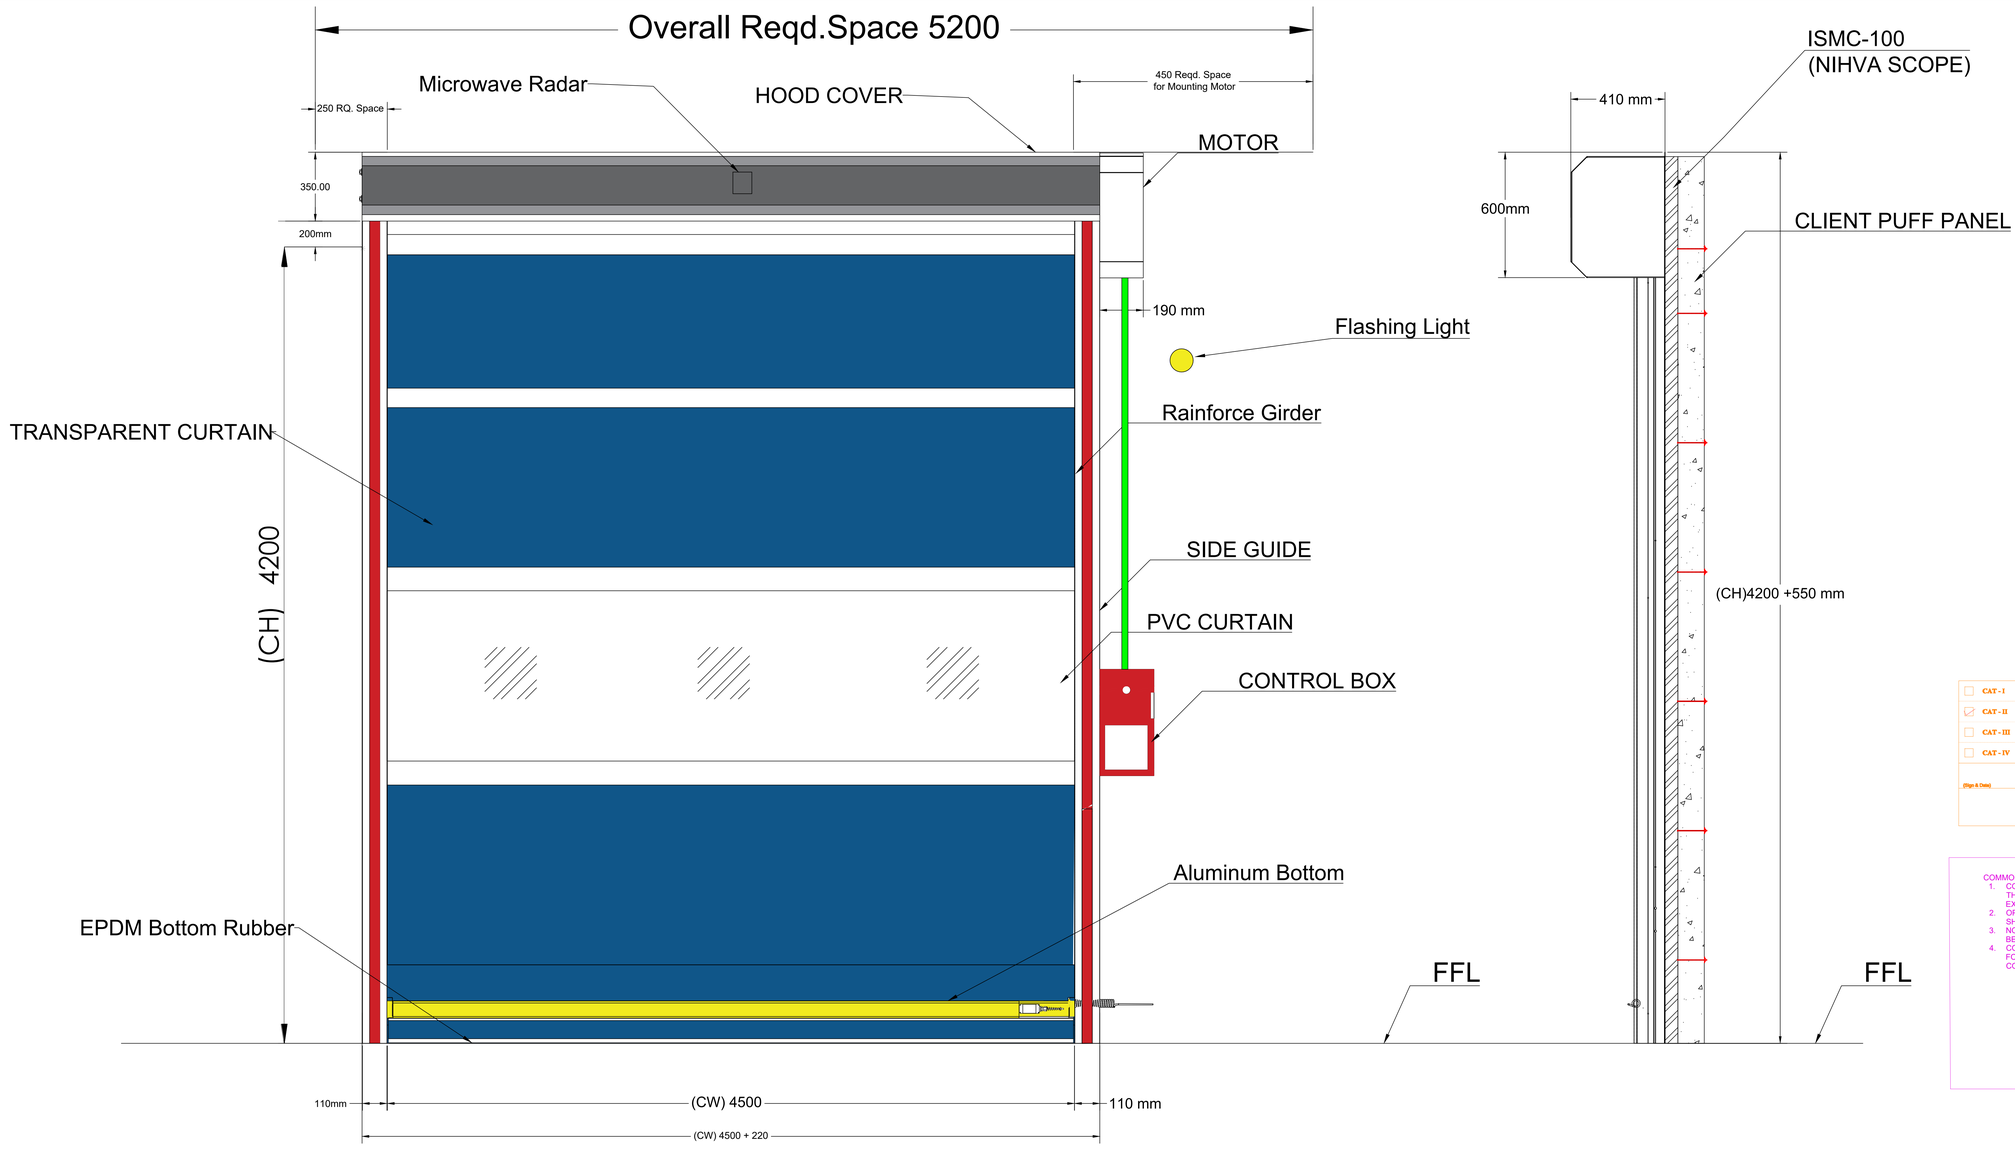

CAT - I	APPROVED - *No Further Comments*	
CAT - II	APPROVED - *Subjected to Incorporation of Comments as Marked.*	
CAT - III	NOT APPROVED *Resubmit with Incorporation of Comments as Marked / Discussed.*	
CAT - IV	INVALID SUBMISSION *Due to Non-Conformity of Tender specifications / drawings*	
(Sign & Date)	(Name & Designation)	(Remarks)

vms

COMMON COMMENTS :
1. CONTRACTOR NEEDS TO VERIFY THE DIMENSION OF THE OPENING ON SITE BEFORE PROCEEDING FOR EXECUTION
2. OPENING CONDITION OF THE ROLLING SHUTTER SHOULD BE AS PER THE PLAN
3. NO DEVIATION FROM TENDER SPECIFICATION WILL BE ALLOWED.
4. COLOR OF CURTAIN, SIDE GUIDES,STEEL CASING FOR TOP ROLLER, STEEL MOTOR GUARD TO BE CONFIRMED BY THE CLIENT.

TECHNICAL SPECIFICATION :

SR.	SPECIFICATIONS	DETAILS
1	**Control Panel**	LED Display Servo Controller : - Operating Speed (Adjustable) : 1.4~2.5 min/ Working Temperature : -35 degree to 65 degree - Water Resistant : IP65 Make IDER, manufactured under European Standards
2	**Drive**	**IDER Make ,CE Certified**
3	**Motor Power ,Torque**	**Power : 1.1 kW Torque : 65 Nm**
4	**Door Travel Speed**	**Opening: 2 m/Sec & Closing:0.9m/Sec**
5	**Safety Device**	**Safety Photocell Pair & Safety Edges**
6	**Surface Finish**	**As Per Client Requirement**
7	**Accessories**	**Radar Sensor ,Magnetic Loop Detector ,Flashing Light**

NOTE:

NIHVA

(1) All Cables & Ele.Conduits to be provided by RINAC
(2) All Civil Work in Client Scope
(3) Required M.S.Structure & Fittings at Nihva Scope

Sr	Clear Width (CW)	Clear Height (CH)	QTY
1	**4500**	**4200**	1

This drawing & design is the property of NIHVA TECHNOLOGIES. Not to be sold or copied to any other concern.


TITLE : HIGH SPEED DOOR WITH SENSOR GA DRAWING


NIHVA TECHNOLOGIES PVT. LTD.


NIHVA TECHNOLOGIES PVT. PUNE
Tel : 020 66304033
Email:- info@nihva.com
Website:- www.nihva.com

	NAME	SIGN	DATE
DRAWN	S.J		18.01.2024
CHECK	A.K		18.01.2024
APPRD.	V.T		18.01.2024

CLIENT - RINAC
PROJECT - HIGH SPEED DOOR
FORMAT NO - NIHVA-DD-F-03
If any queries contact : projectsupport@nihva.com
DWG. NO. : NIHVA/23-24/00XX
REV- R00
ALL DIMENSION ARE IN mm
SCALE: NTS
WT:
SHEET:

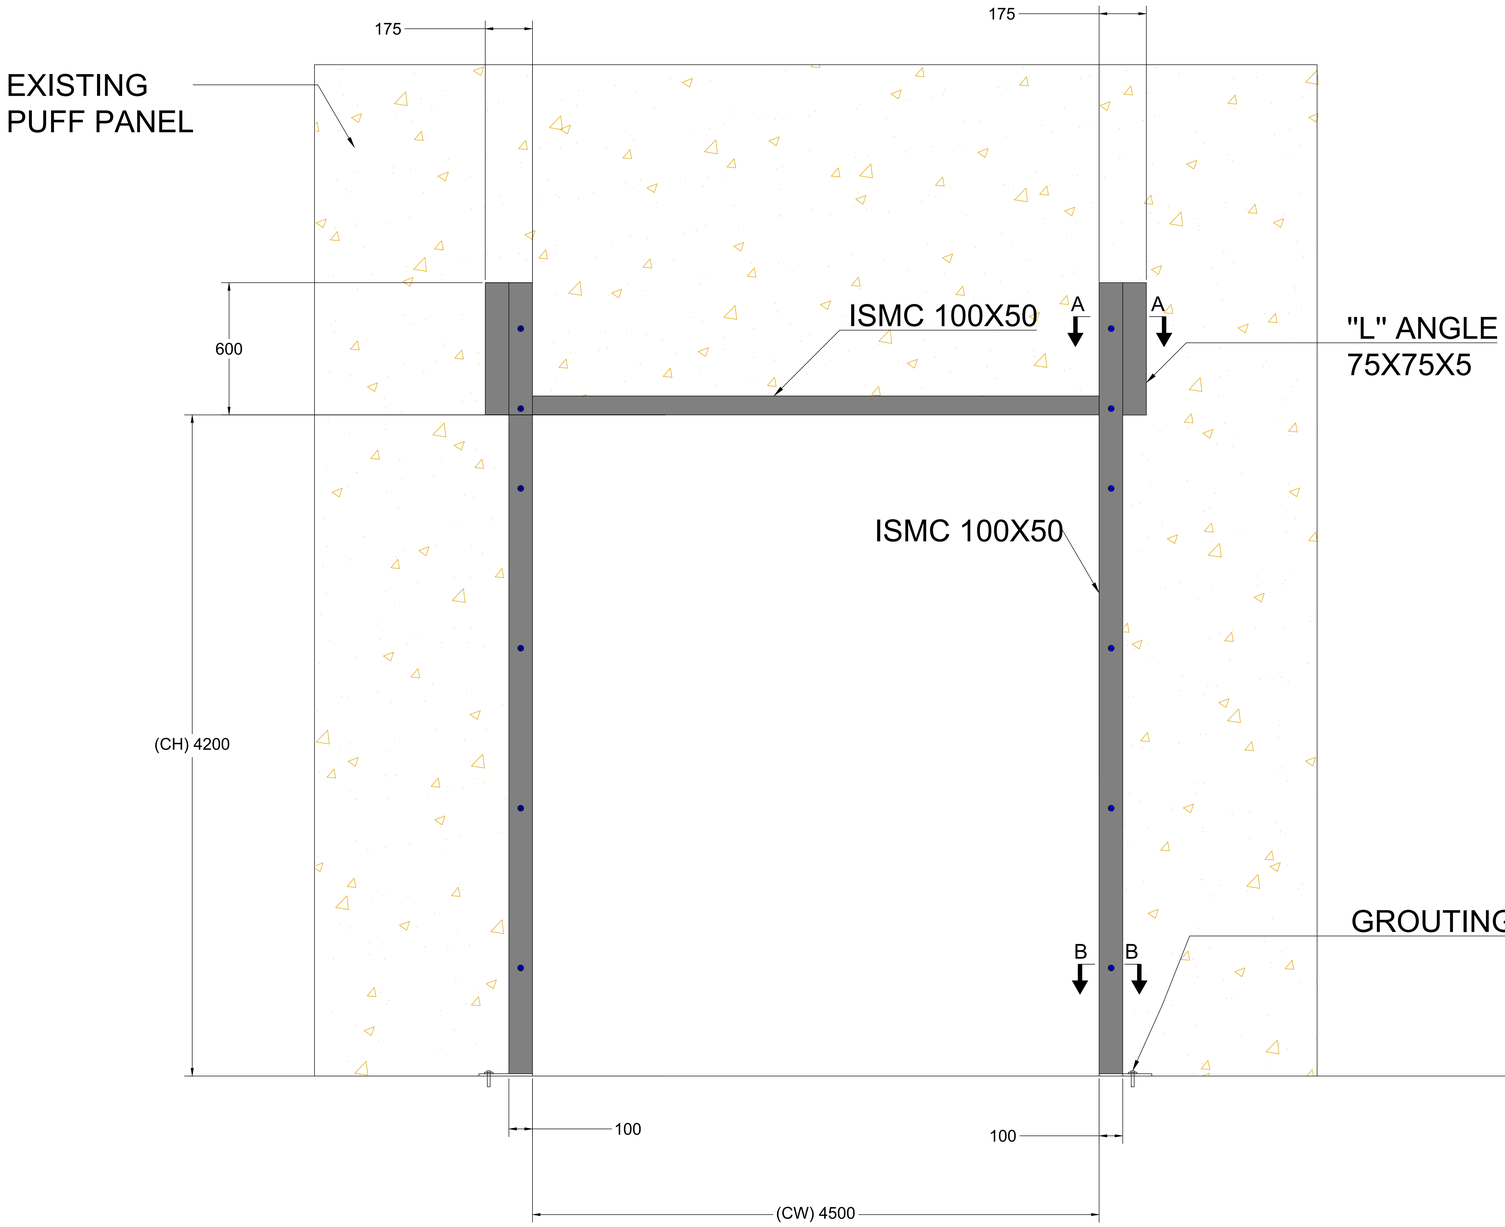

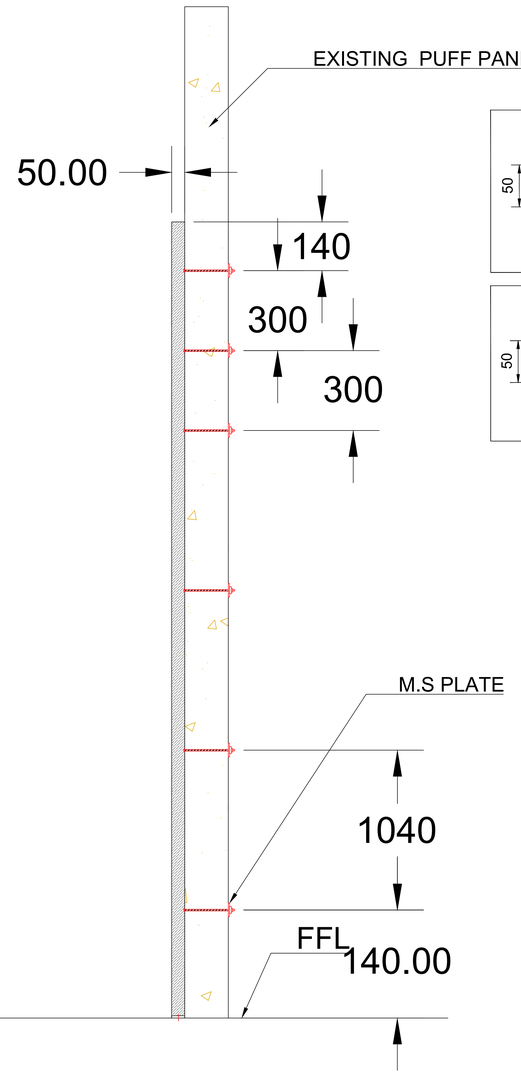

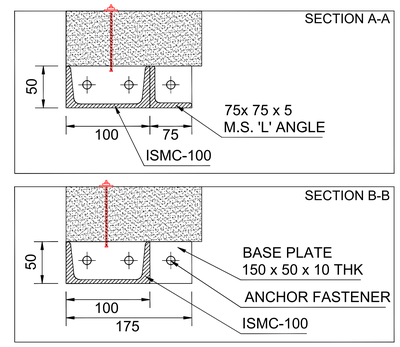


M.S. STRUCTURE DETAILS

Sr	Description	Clear Width (CW)	Clear Height (CH)	QTY
1	HSD With Sensor	**4500**	**4200**	1

This drawing & design is the property of NIHVA TECHNOLOGIES. Not to be sold or copied to any other concern.

TITLE	HIGH SPEED DOOR STRUCTURE DRAWING			NIHVA TECHNOLOGIES PVT. LTD. PUNE Tel : 020 66304033 Email:- info@nihva.com Website:- www.nihva.com	
	NAME	SIGN	DATE		
DRAWN	S.J		18.01.2024	CLIENT - RINAC	
CHECK	A.K		18.01.2024	PROJECT - HIGH SPEED DOOR ST.	
APPRD.	V.T		18.01.2024	FORMAT NO - NIHVA-DD-F-03	
If any queries contact : projectsupport@nihva.com				DWG. NO. : NIHVA/23-24/00XX	REV- R00
ALL DIMENSION ARE IN mm				SCALE: NTS	WT: SHEET:

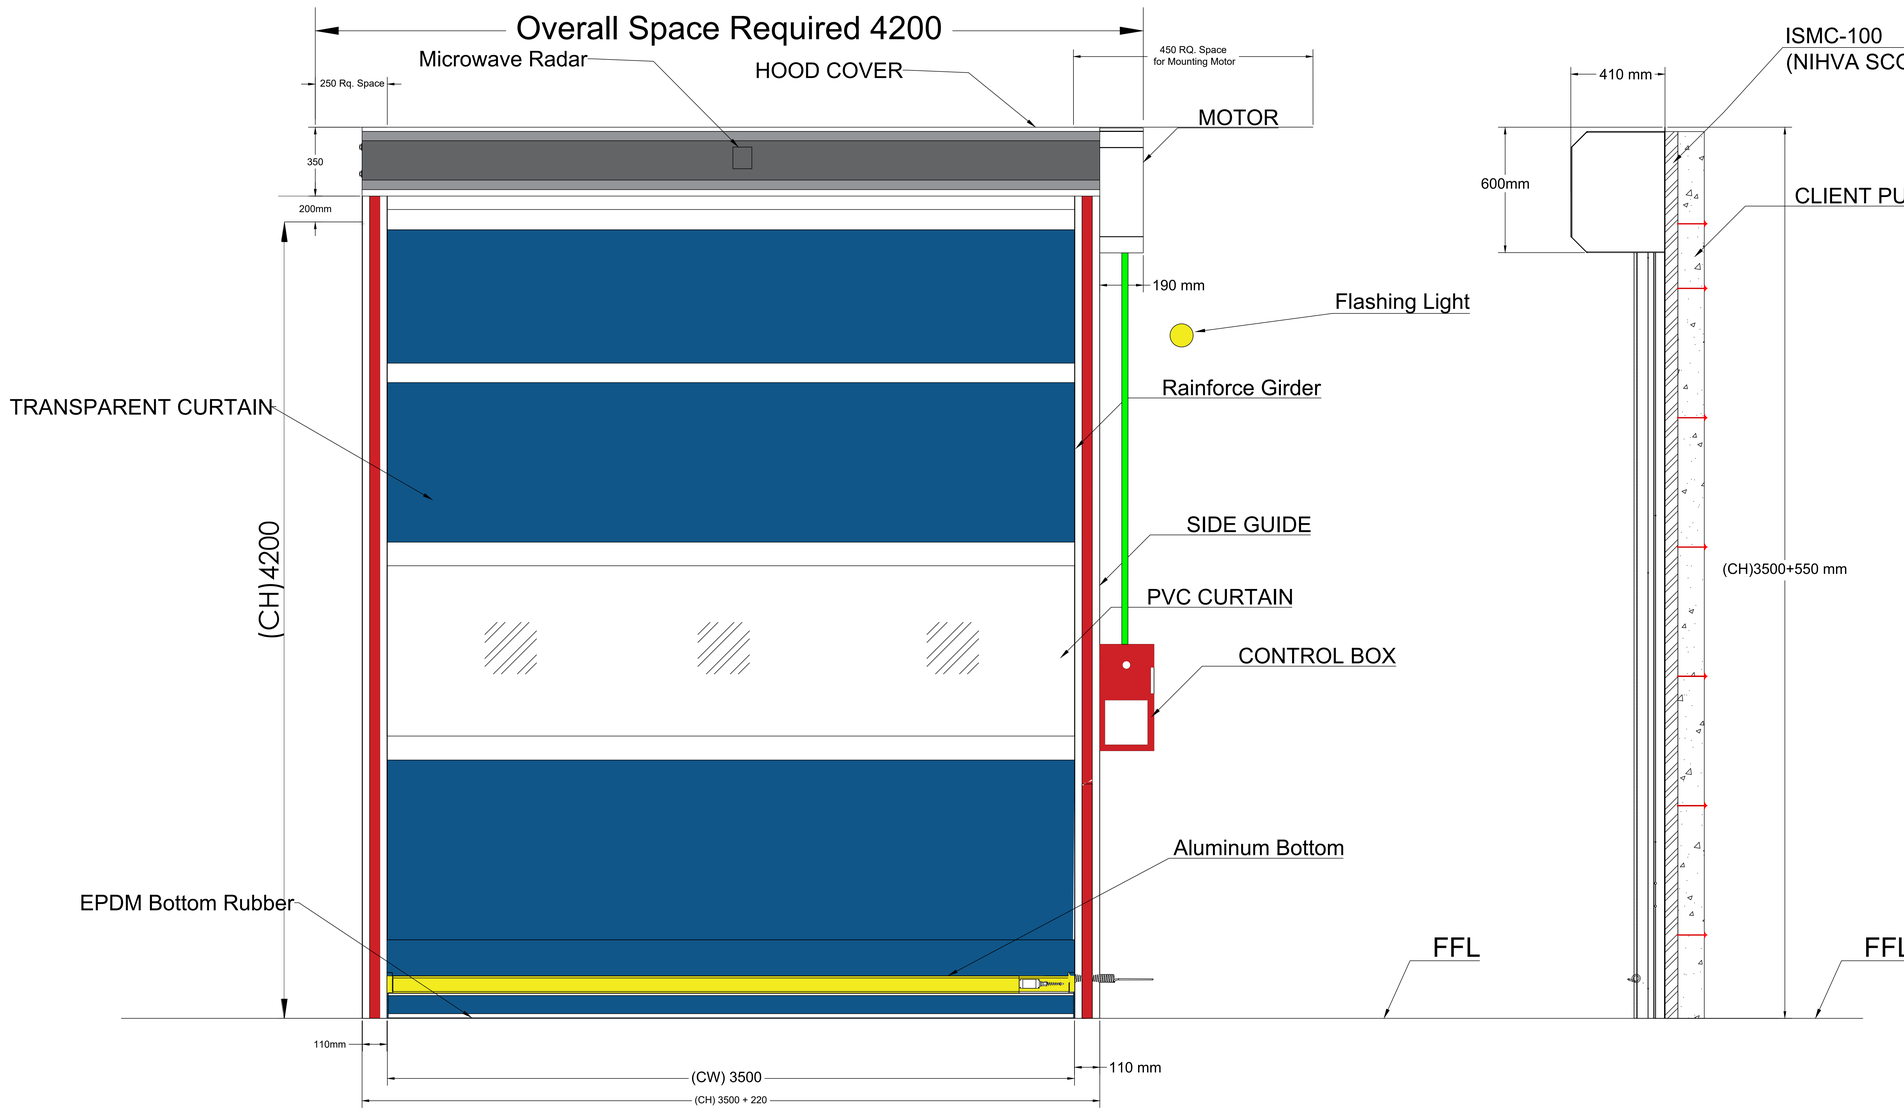

CAT - I	APPROVED - *No Further Comments*	
CAT - II	APPROVED - *Subjected to Incorporation of Comments as Marked.*	
CAT - III	NOT APPROVED *Resubmit with Incorporation of Comments as Marked / Discussed.*	
CAT - IV	INVALID SUBMISSION *Due to Non-Conformity of Tender specifications / drawings*	
(Sign & Date)	(Name & Designation)	(Remarks)

vms

COMMON COMMENTS :
1. CONTRACTOR NEEDS TO VERIFY THE DIMENSION OF THE OPENING ON SITE BEFORE PROCEEDING FOR EXECUTION
2. OPENING CONDITION OF THE ROLLING SHUTTER SHOULD BE AS PER THE PLAN
3. NO DEVIATION FROM TENDER SPECIFICATION WILL BE ALLOWED.
4. COLOR OF CURTAIN, SIDE GUIDES,STEEL CASING FOR TOP ROLLER, STEEL MOTOR GUARD TO BE CONFIRMED BY THE CLIENT.

TECHNICAL SPECIFICATION :

SR.	SPECIFICATIONS	DETAILS
1	**Control Panel**	LED Display Servo Controller : - Operating Speed (Adjustable) : 1.4~2.5 min/ Working Temperature : -35 degree to 65 degree - Water Resistant : IP65 Make IDER, manufactured under European Standards
2	**Drive**	**IDER Make ,CE Certified**
3	**Motor Power ,Torque**	**Power : 1.1 kW Torque : 65 Nm**
4	**Door Travel Speed**	**Opening: 2 m/Sec & Closing:0.9m/Sec**
5	**Safety Device**	**Safety Photocell Pair & Safety Edges**
6	**Surface Finish**	**As Per Client Requirement**
7	**Accessories**	**Radar Sensor ,Magnetic Loop Detector ,Flashing Light Buzzer**

NOTE:

NIHVA

(1) All Cables & Ele.Conduits to be provided by RINAC
(2) All Civil Work in Client Scope
(3) Required M.S.Structure & Fittings at Nihva Scope

Sr	Clear Width (CW)	Clear Height (CH)	QTY
1	**3500**	**4200**	1


This drawing & design is the property of NIHVA TECHNOLOGIES. Not to be sold or copied to any other concern.


TITLE: HIGH SPEED DOOR WITH SENSOR GA DRAWING


	NAME	SIGN	DATE
DRAWN	S.J		18.01.2024
CHECK	A.K		18.01.2024
APPRD.	V.T		18.01.2024

NIHVA TECHNOLOGIES PVT. LTD.
NIHVA TECHNOLOGIES PVT. PUNE
Tel : 020 66304033
Email:- info@nihva.com
Website:- www.nihva.com

CLIENT - RINAC
PROJECT - HIGH SPEED DOOR
FORMAT NO - NIHVA-DD-F-03
If any queries contact : projectsupport@nihva.com
DWG. NO. : NIHVA/23-24/00XX
REV- R00
ALL DIMENSION ARE IN mm
SCALE: NTS
WT:
SHEET:

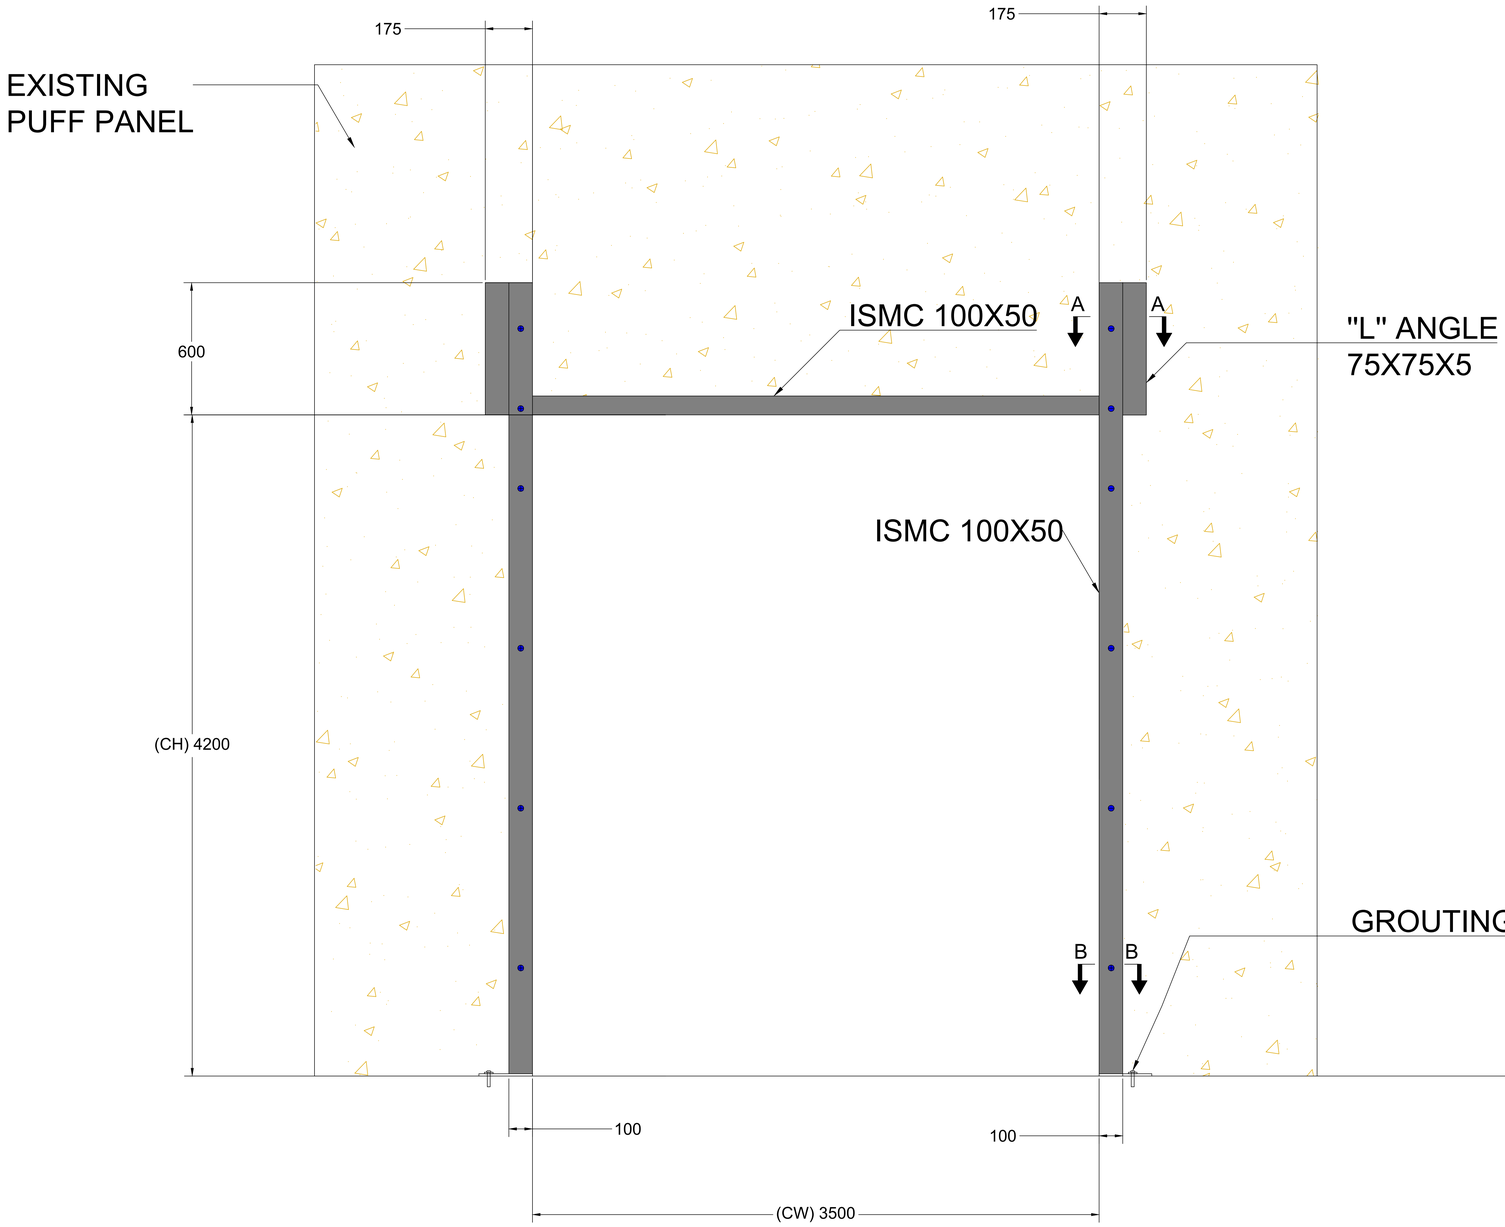

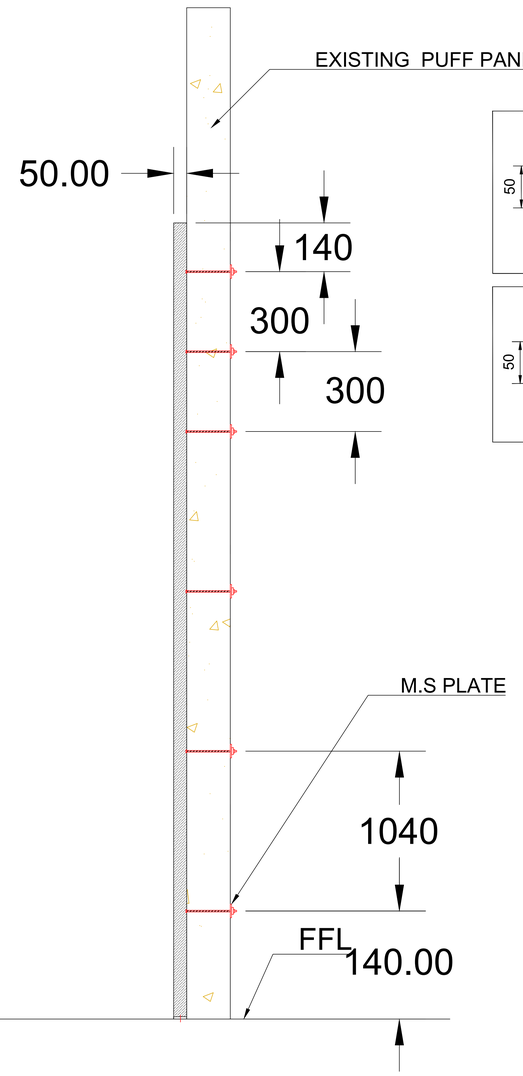

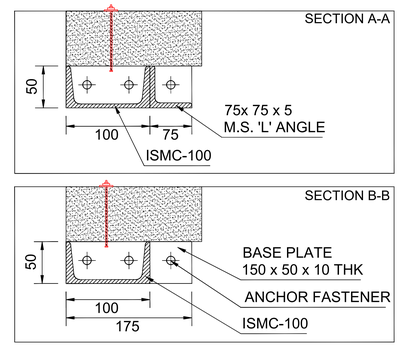


M.S. STRUCTURE DETAILS

Sr	Description	Clear Width (CW)	Clear Height (CH)	QTY
1	HSD With Sensor	**3500**	**4200**	1

This drawing & design is the property of NIHVA TECHNOLOGIES. Not to be sold or copied to any other concern.

TITLE	HIGH SPEED DOOR STRUCTURE DRAWING			NIHVA TECHNOLOGIES PVT. LTD. PUNE Tel : 020 66304033 Email:- info@nihva.com Website:- www.nihva.com	
	NAME	SIGN	DATE		
DRAWN	S.J		18.01.2024	CLIENT - RINAC	
CHECK	A.K		18.01.2024	PROJECT - HIGH SPEED DOOR ST.	
APPRD.	V.T		18.01.2024	FORMAT NO - NIHVA-DD-F-03	
If any queries contact : projectsupport@nihva.com				DWG. NO. : NIHVA/23-24/00XX	REV- R00
ALL DIMENSION ARE IN mm				SCALE: NTS	WT: SHEET:

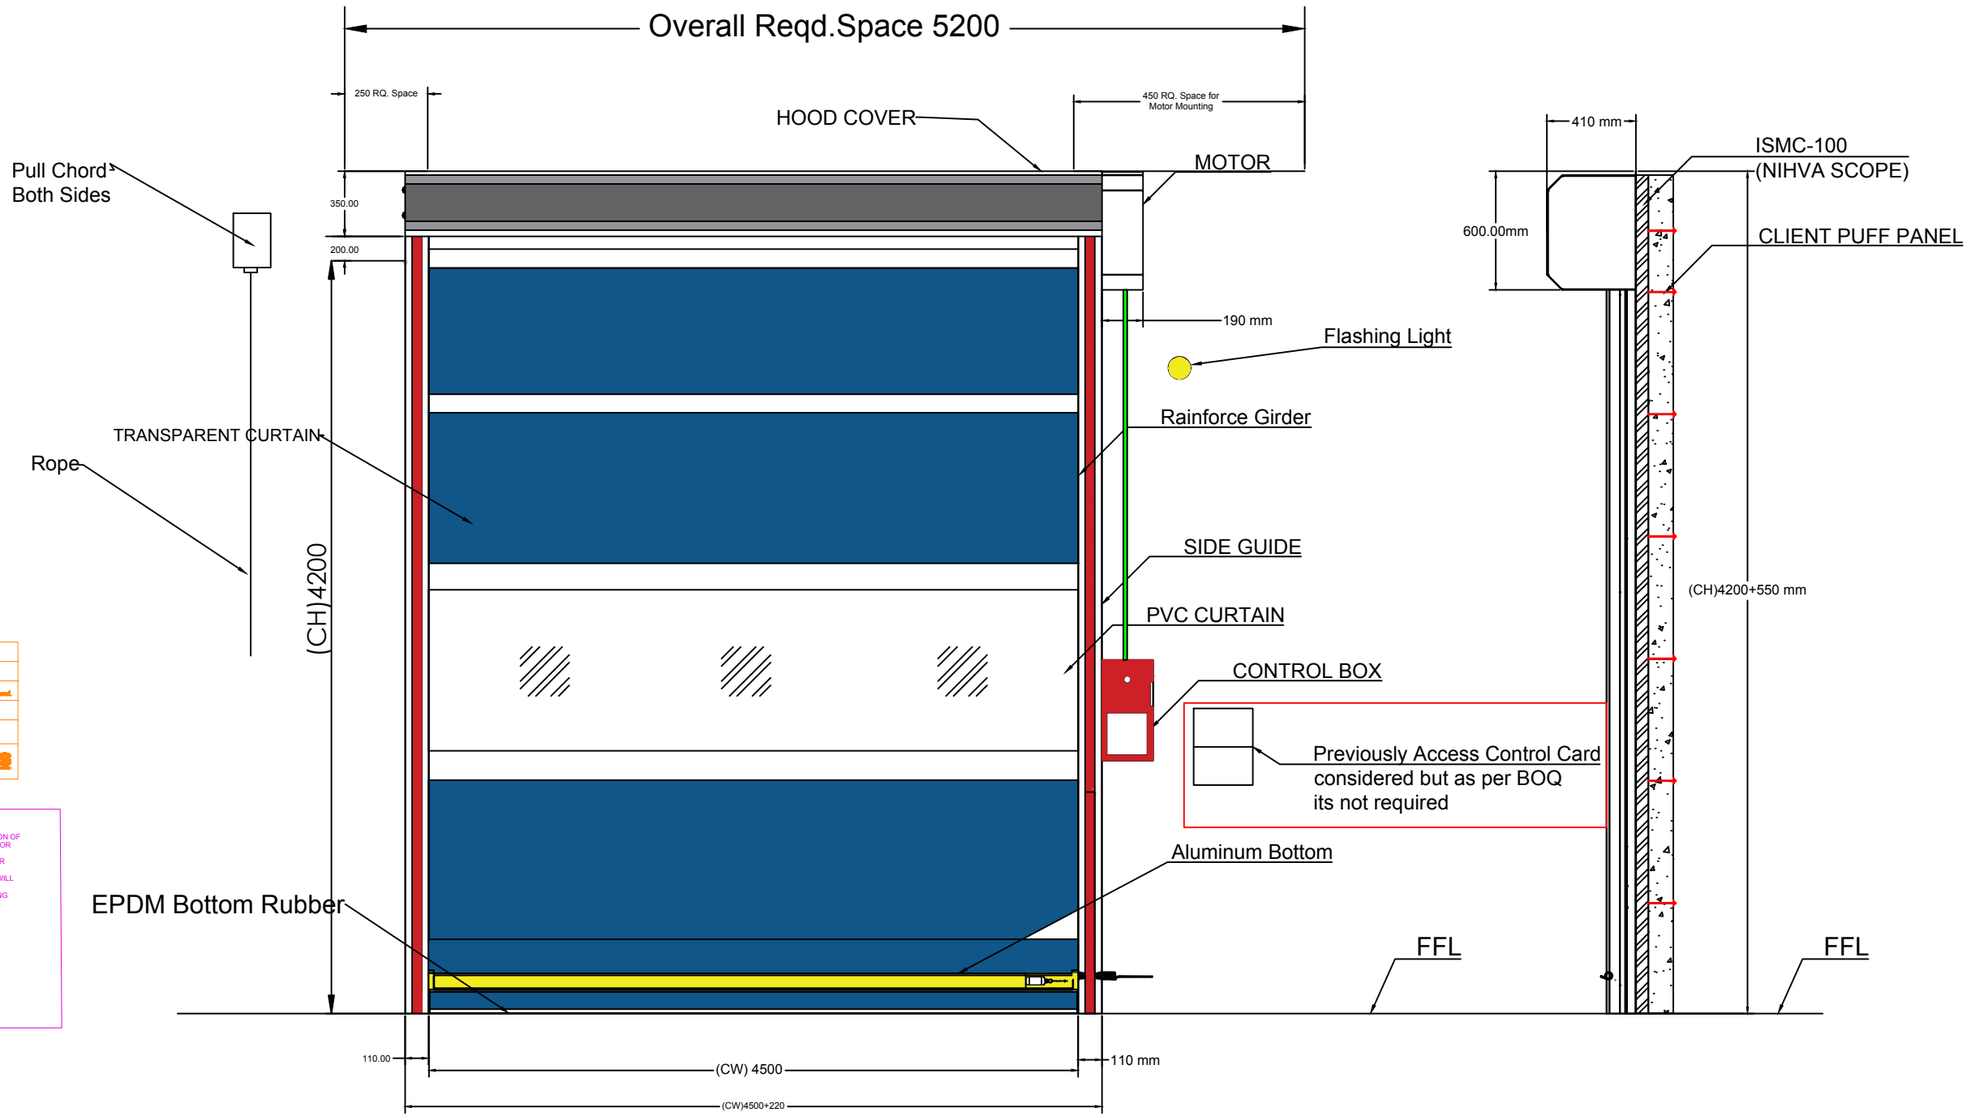

COMMON COMMENTS :

1. CONTRACTOR NEEDS TO VERIFY THE DIMENSION OF THE OPENING ON SITE BEFORE PROCEEDING FOR EXECUTION.
2. OPENING CONDITION OF THE ROLLING SHUTTER SHOULD BE AS PER THE PLAN
3. NO DEVIATION FROM TENDER SPECIFICATION WILL BE ALLOWED.
4. COLOR OF CURTAIN, SIDE GUIDES,STEEL CASING FOR TOP ROLLER, STEEL MOTOR GUARD TO BE CONFIRMED BY THE CLIENT.

TECHNICAL SPECIFICATION :

SR.	SPECIFICATIONS	DETAILS
1	**Control Panel**	LED Display Servo Controller : - Operating Speed (Adjustable) : 1.4~2.5 min/ Working Temperature : -35 degree to 65 degree - Water Resistant : IP65 Make IDER, manufactured under European Standards
2	**Drive**	**IDER Make ,CE Certified**
3	**Motor Power ,Torque**	**Power : 1.1 kW Torque : 65 Nm**
4	**Door Travel Speed**	**Opening: 2 m/Sec & Closing:0.9m/Sec**
5	**Safety Device**	**Safety Photocell Pair & Safety Edges**
6	**Surface Finish**	**As Per Client Requirement**
7	**Accessories**	**Flashing Light with Buzzer , Pull Chord**

NOTE:

(1) All Cables & Ele.Conduits to be provided by ~~RINAC~~ NIHVA
(2) All Civil Work in Client Scope
(3) Required M.S.Structure & Fittings at Nihva Scope

Revision :

Rev	Revision	Date	Revised BY
R01	Removed Access Control System	23-02-2024	Y.K.

Sr	Clear Width (CW)	Clear Height (CH)	QTY
1	**4500**	**4200**	5

This drawing & design is the property of NIHVA TECHNOLOGIES. Not to be sold or copied to any other concern.

TITLE: HIGH SPEED DOOR WITHOUT SENSOR GA DRAWING

	NAME	SIGN	DATE
DRAWN	S.J		19.01.2024
CHECK	A.K		19.01.2024
APPRD.	V.T		19.01.2024

If any queries contact : projectsupport@nihva.com

ALL DIMENSION ARE IN mm

NIHVA TECHNOLOGIES PVT. LTD.
NIHVA TECHNOLOGIES PVT. LTD. PUNE
Tel : 020 66304033
Email:- info@nihva.com
Website:- www.nihva.com


CLIENT - RINAC


PROJECT - HIGH SPEED DOOR


FORMAT NO - NIHVA-DD-F-03


DWG. NO. : NIHVA/23-24/00XX | REV- R01

SCALE: NTS | WT: | SHEET:

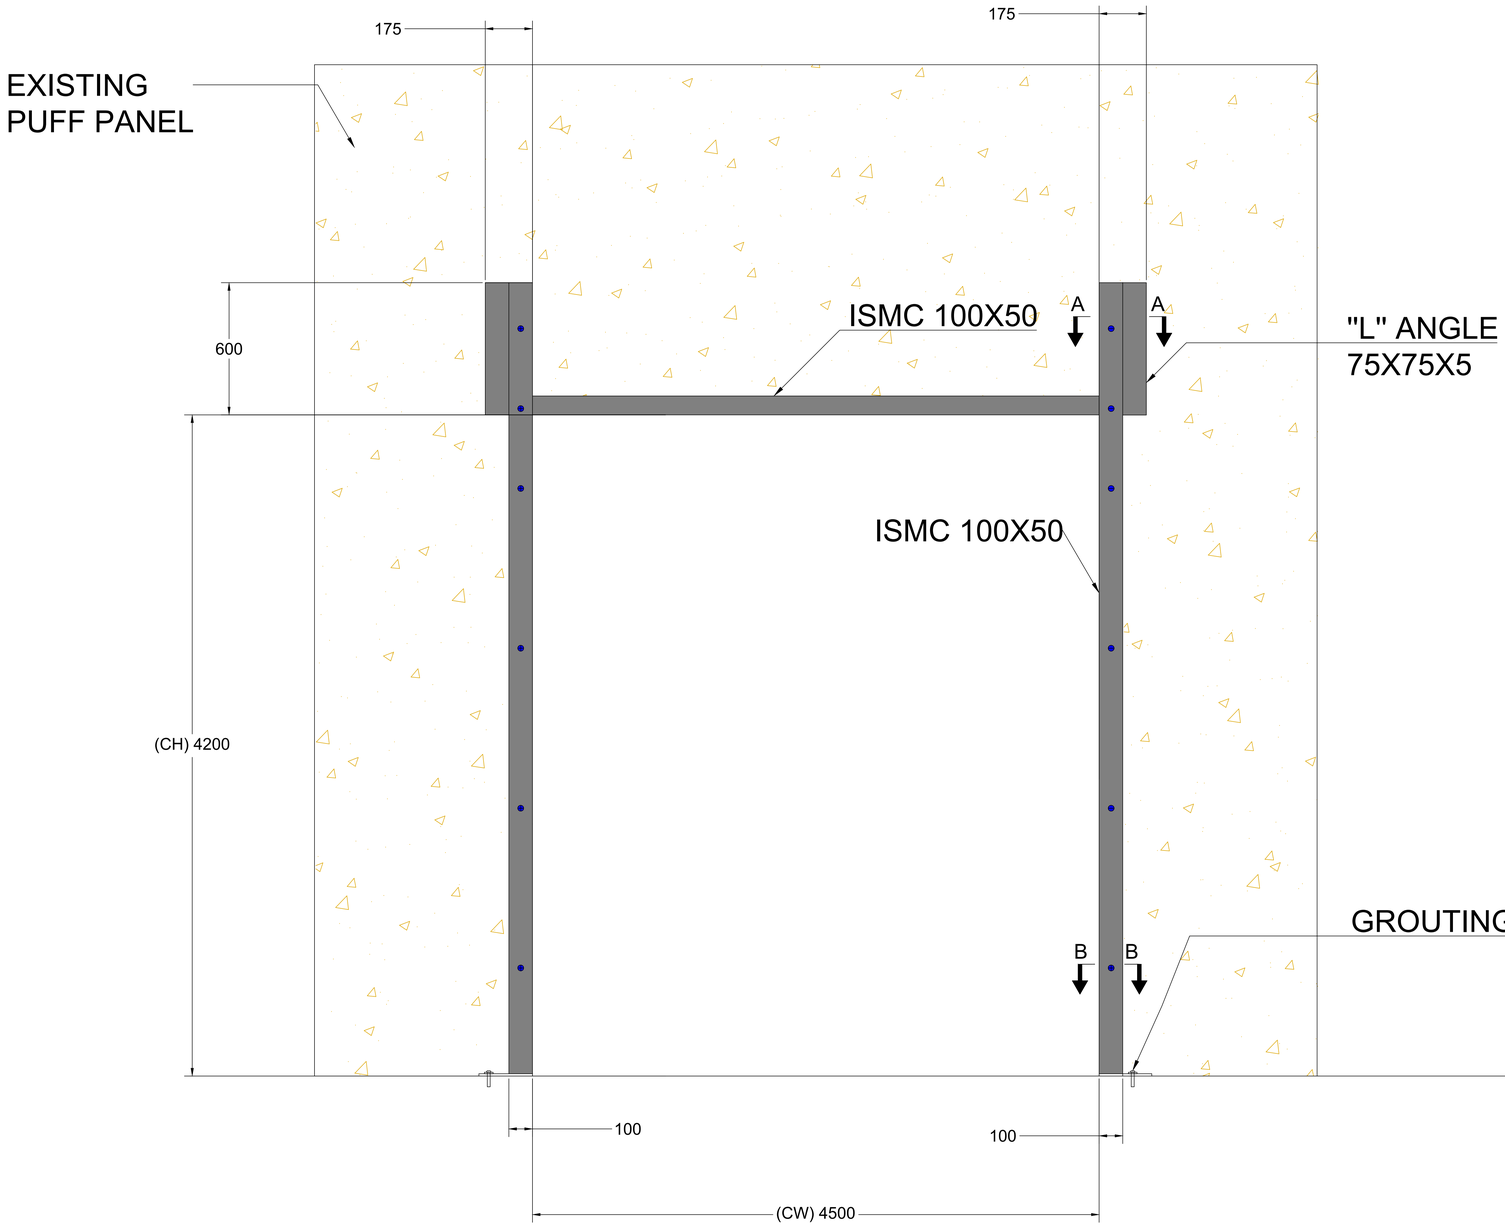

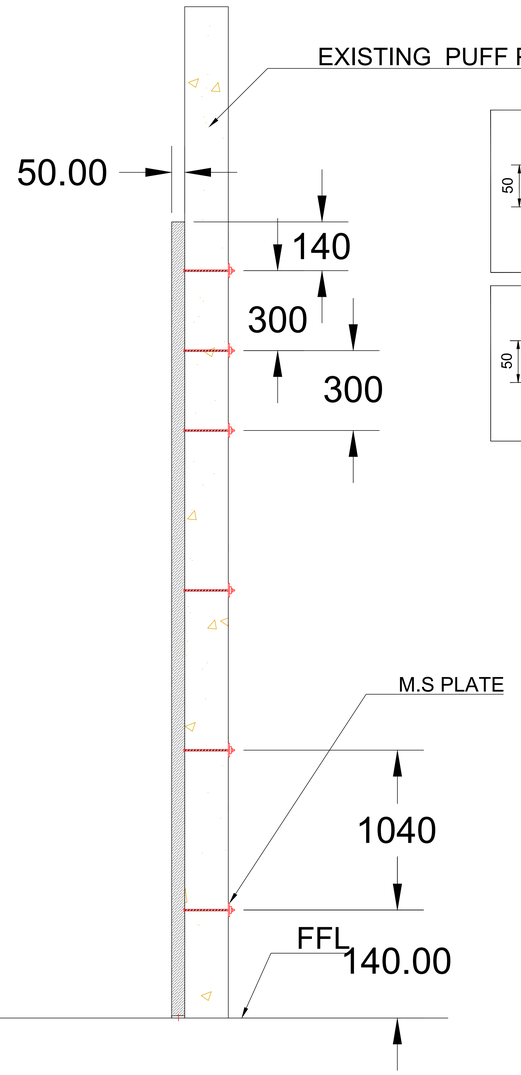

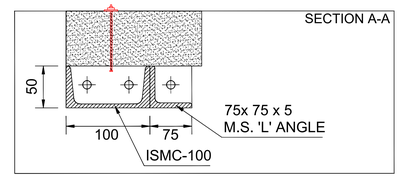

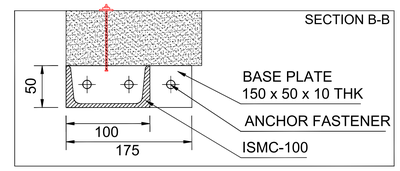


M.S. STRUCTURE DETAILS

Sr	Description	Clear Width (CW)	Clear Height (CH)	QTY
1	HSD Without Sensor	**4500**	**4200**	5

This drawing & design is the property of NIHVA TECHNOLOGIES. Not to be sold or copied to any other concern.

TITLE	HIGH SPEED DOOR STRUCTURE DRAWING			NIHVA TECHNOLOGIES PVT. LTD. PUNE Tel : 020 66304033 Email:- info@nihva.com Website:- www.nihva.com	
	NAME	SIGN	DATE		
DRAWN	S.J		18.01.2024	CLIENT - RINAC	
CHECK	A.K		18.01.2024	PROJECT - HIGH SPEED DOOR ST.	
APPRD.	V.T		18.01.2024	FORMAT NO - NIHVA-DD-F-03	
If any queries contact : projectsupport@nihva.com				DWG. NO. : NIHVA/23-24/00XX	REV- R00
ALL DIMENSION ARE IN mm				SCALE: NTS	WT: SHEET:

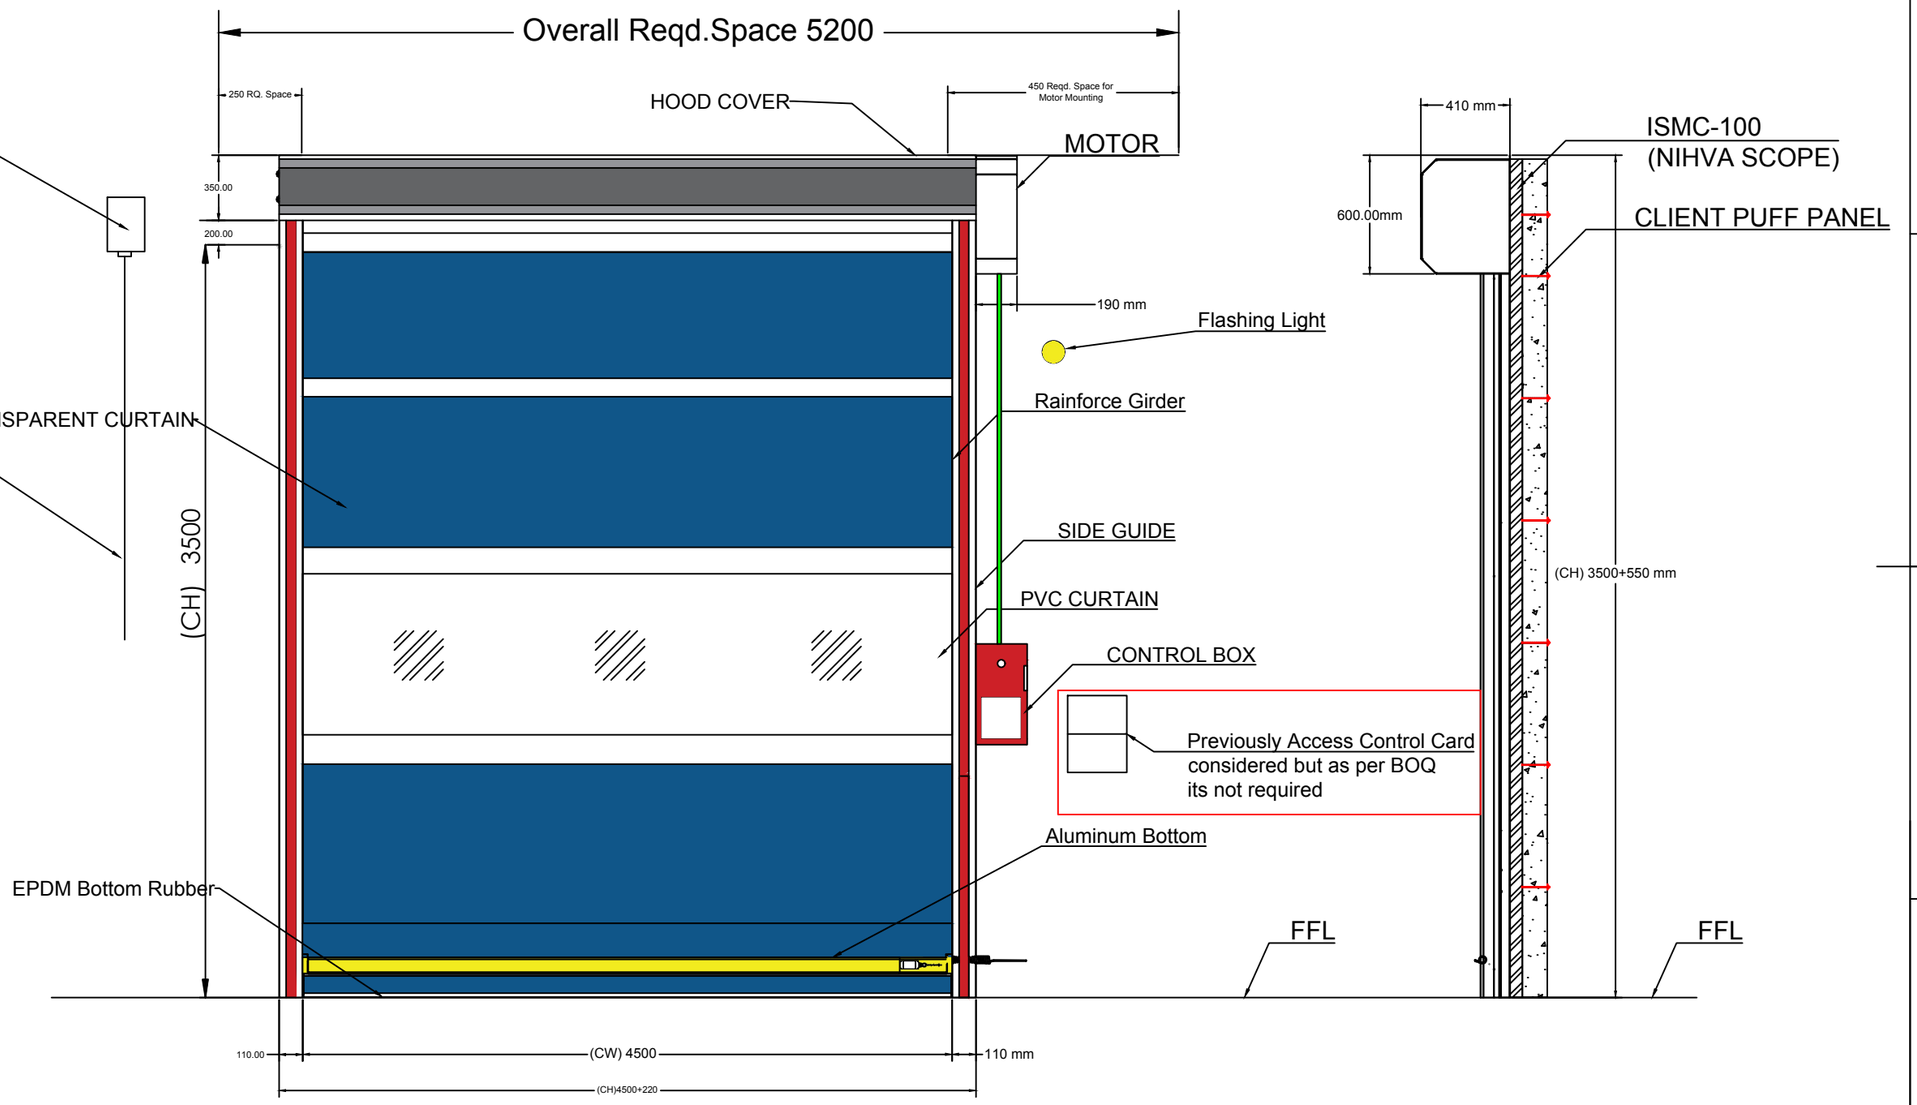

CAT - I	APPROVED - No Further Comments
CAT - II	APPROVED - Subject to Incorporation of Comments as Marked
CAT - III	NOT APPROVED - Resubmit with Incorporation of Comments as Marked / Discussed
CAT - IV	INVALID SUBMISSION - Not in Line With Drawings / Specifications / Drawings
Checked	Signature Contractor	Dated

COMMON COMMENTS :
1. CONTRACTOR NEEDS TO VERIFY THE DIMENSION OF THE OPENING ON SITE BEFORE PROCEEDING FOR EXECUTION
2. OPENING CONDITION OF THE ROLLING SHUTTER SHOULD BE AS PER THE PLAN
3. NO DEVIATION FROM TENDER SPECIFICATION WILL BE ALLOWED.
4. COLOR OF CURTAIN, SIDE GUIDES,STEEL CASING FOR TOP ROLLER, STEEL MOTOR GUARD TO BE CONFIRMED BY THE CLIENT.

TECHNICAL SPECIFICATION :

SR.	SPECIFICATIONS	DETAILS
1	Control Panel	LED Display Servo Controller : - Operating Speed (Adjustable) : 1.4~2.5 min/ Working Temperature : -35 degree to 65 degree - Water Resistant : IP65 Make IDER, manufactured under European Standards
2	Drive	IDER Make ,CE Certified
3	Motor Power ,Torque	Power : 1.1 kW Torque : 65 Nm
4	Door Travel Speed	Opening: 2 m/Sec & Closing:0.9m/Sec
5	Safety Device	Safety Photocell Pair & Safety Edges
6	Surface Finish	As Per Client Requirement
7	Accessories	Flashing Light with Buzzer , Pull Chord

NOTE :

(1) All Cables & Ele.Conduits to be provided by ~~RINAC~~ NIHVA
(2) All Civil Work in Client Scope
(3) Required M.S.Structure & Fittings at Nihva Scope

Revision :

Rev	Revision	Date	Revised BY
R01	Removed Access Control System	23-02-2024	Y.K.

Sr	Clear Width (CW)	Clear Height (CH)	QTY
1	4500	3500	2

This drawing & design is the property of NIHVA TECHNOLOGIES. Not to be sold or copied to any other concern.


TITLE : HIGH SPEED DOOR WITHOUT SENSOR GA DRAWING


NIHVA TECHNOLOGIES PVT. LTD.
NIHVA TECHNOLOGIES PVT. PUNE
Tel : 020 66304033
Email:- info@nihva.com
Website:- www.nihva.com


	NAME	SIGN	DATE
DRAWN	S.J		19.01.2024
CHECK	A.K		19.01.2024
APPRD.	V.T		19.01.2024


If any queries contact : projectsupport@nihva.com

CLIENT - RINAC
PROJECT - HIGH SPEED DOOR
FORMAT NO - NIHVA-DD-F-03
DWG. NO. : NIHVA/23-24/00XX
REV- R01
ALL DIMENSION ARE IN mm
SCALE: NTS
WT:
SHEET:

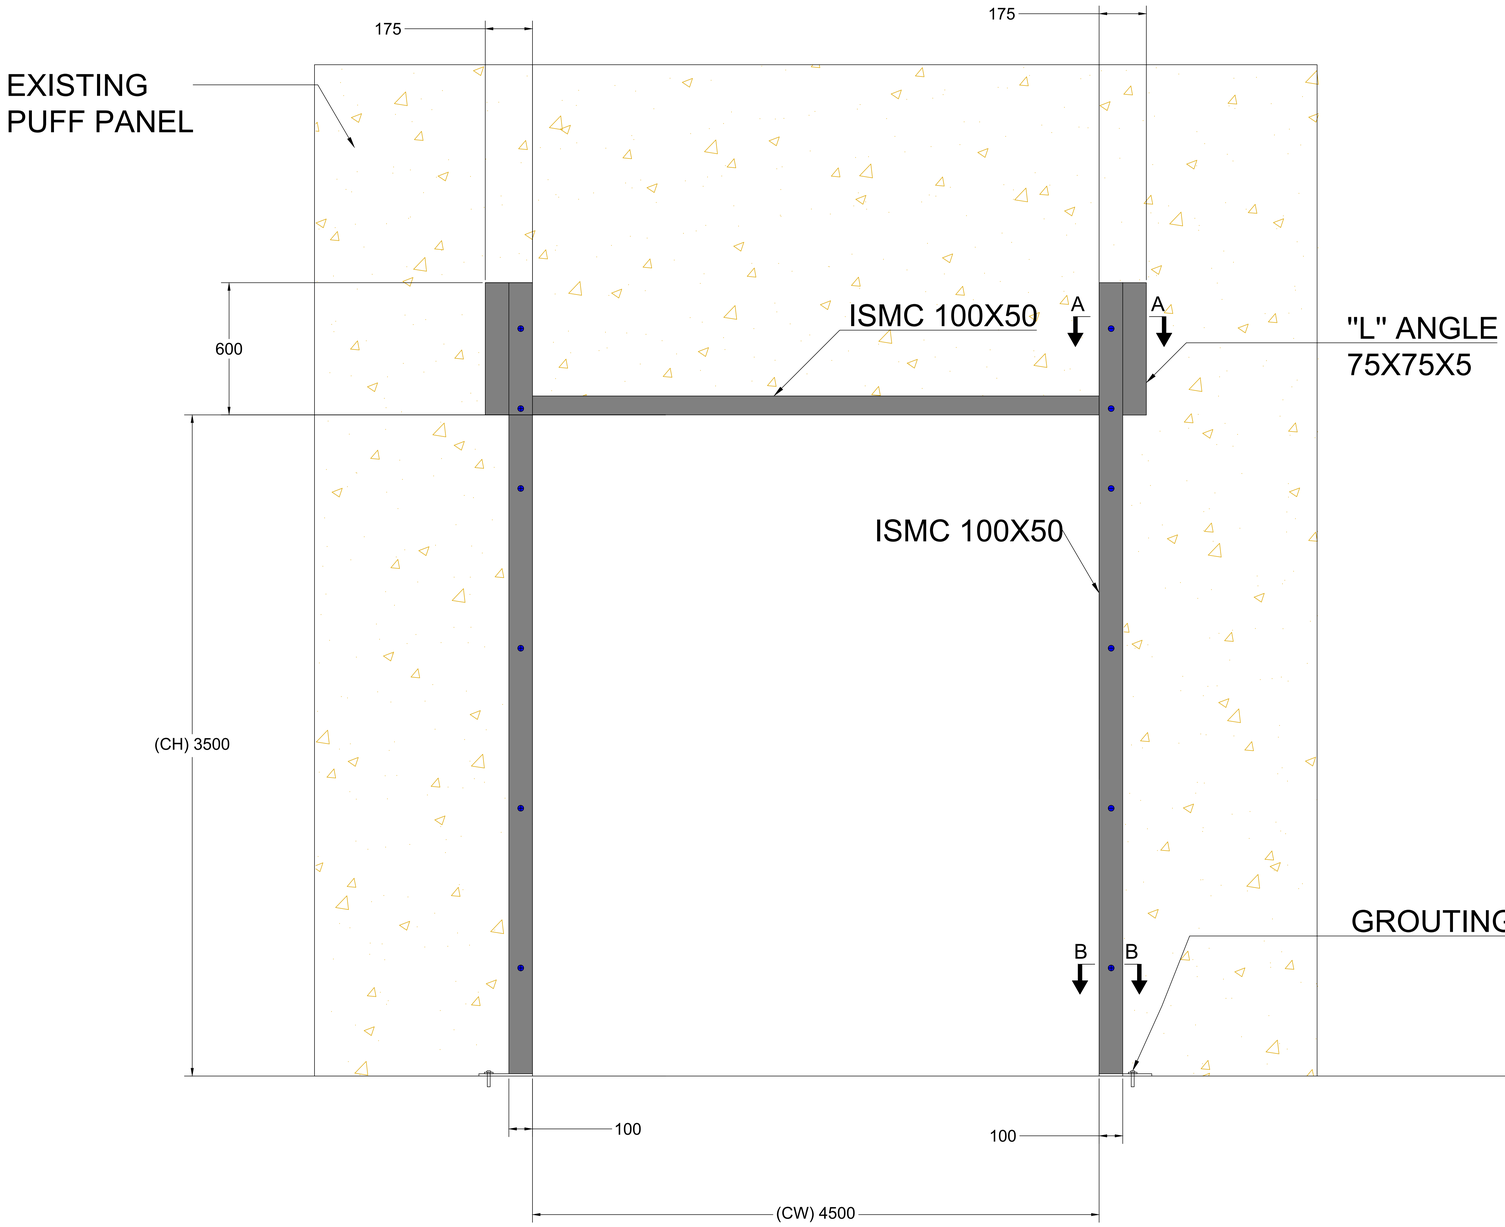

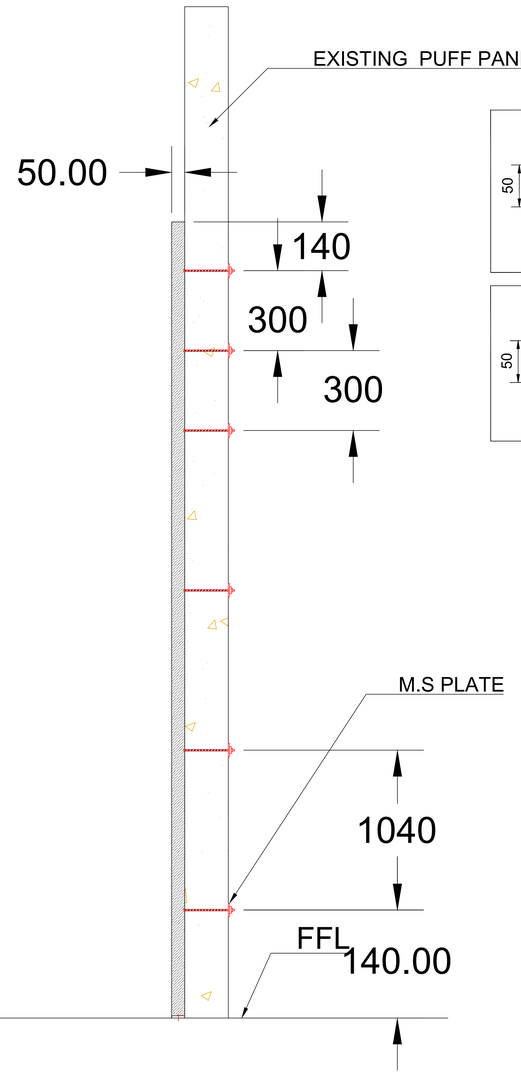

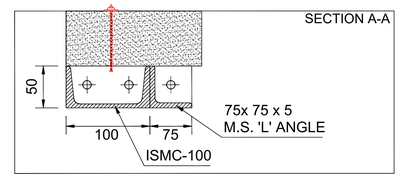

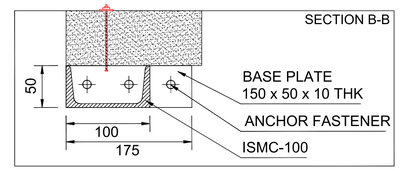


M.S. STRUCTURE DETAILS

Sr	Description	Clear Width (CW)	Clear Height (CH)	QTY
1	HSD Without Sensor	**4500**	**3500**	2

This drawing & design is the property of NIHVA TECHNOLOGIES. Not to be sold or copied to any other concern.

TITLE	HIGH SPEED DOOR STRUCTURE DRAWING			NIHVA TECHNOLOGIES PVT. LTD. PUNE Tel : 020 66304033 Email:- info@nihva.com Website:- www.nihva.com	
	NAME	SIGN	DATE		
DRAWN	S.J		18.01.2024	CLIENT - RINAC	
CHECK	A.K		18.01.2024	PROJECT - HIGH SPEED DOOR ST.	
APPRD.	V.T		18.01.2024	FORMAT NO - NIHVA-DD-F-03	
If any queries contact : projectsupport@nihva.com				DWG. NO. : NIHVA/23-24/00XX	REV- R00
ALL DIMENSION ARE IN mm				SCALE: NTS	WT: / SHEET:

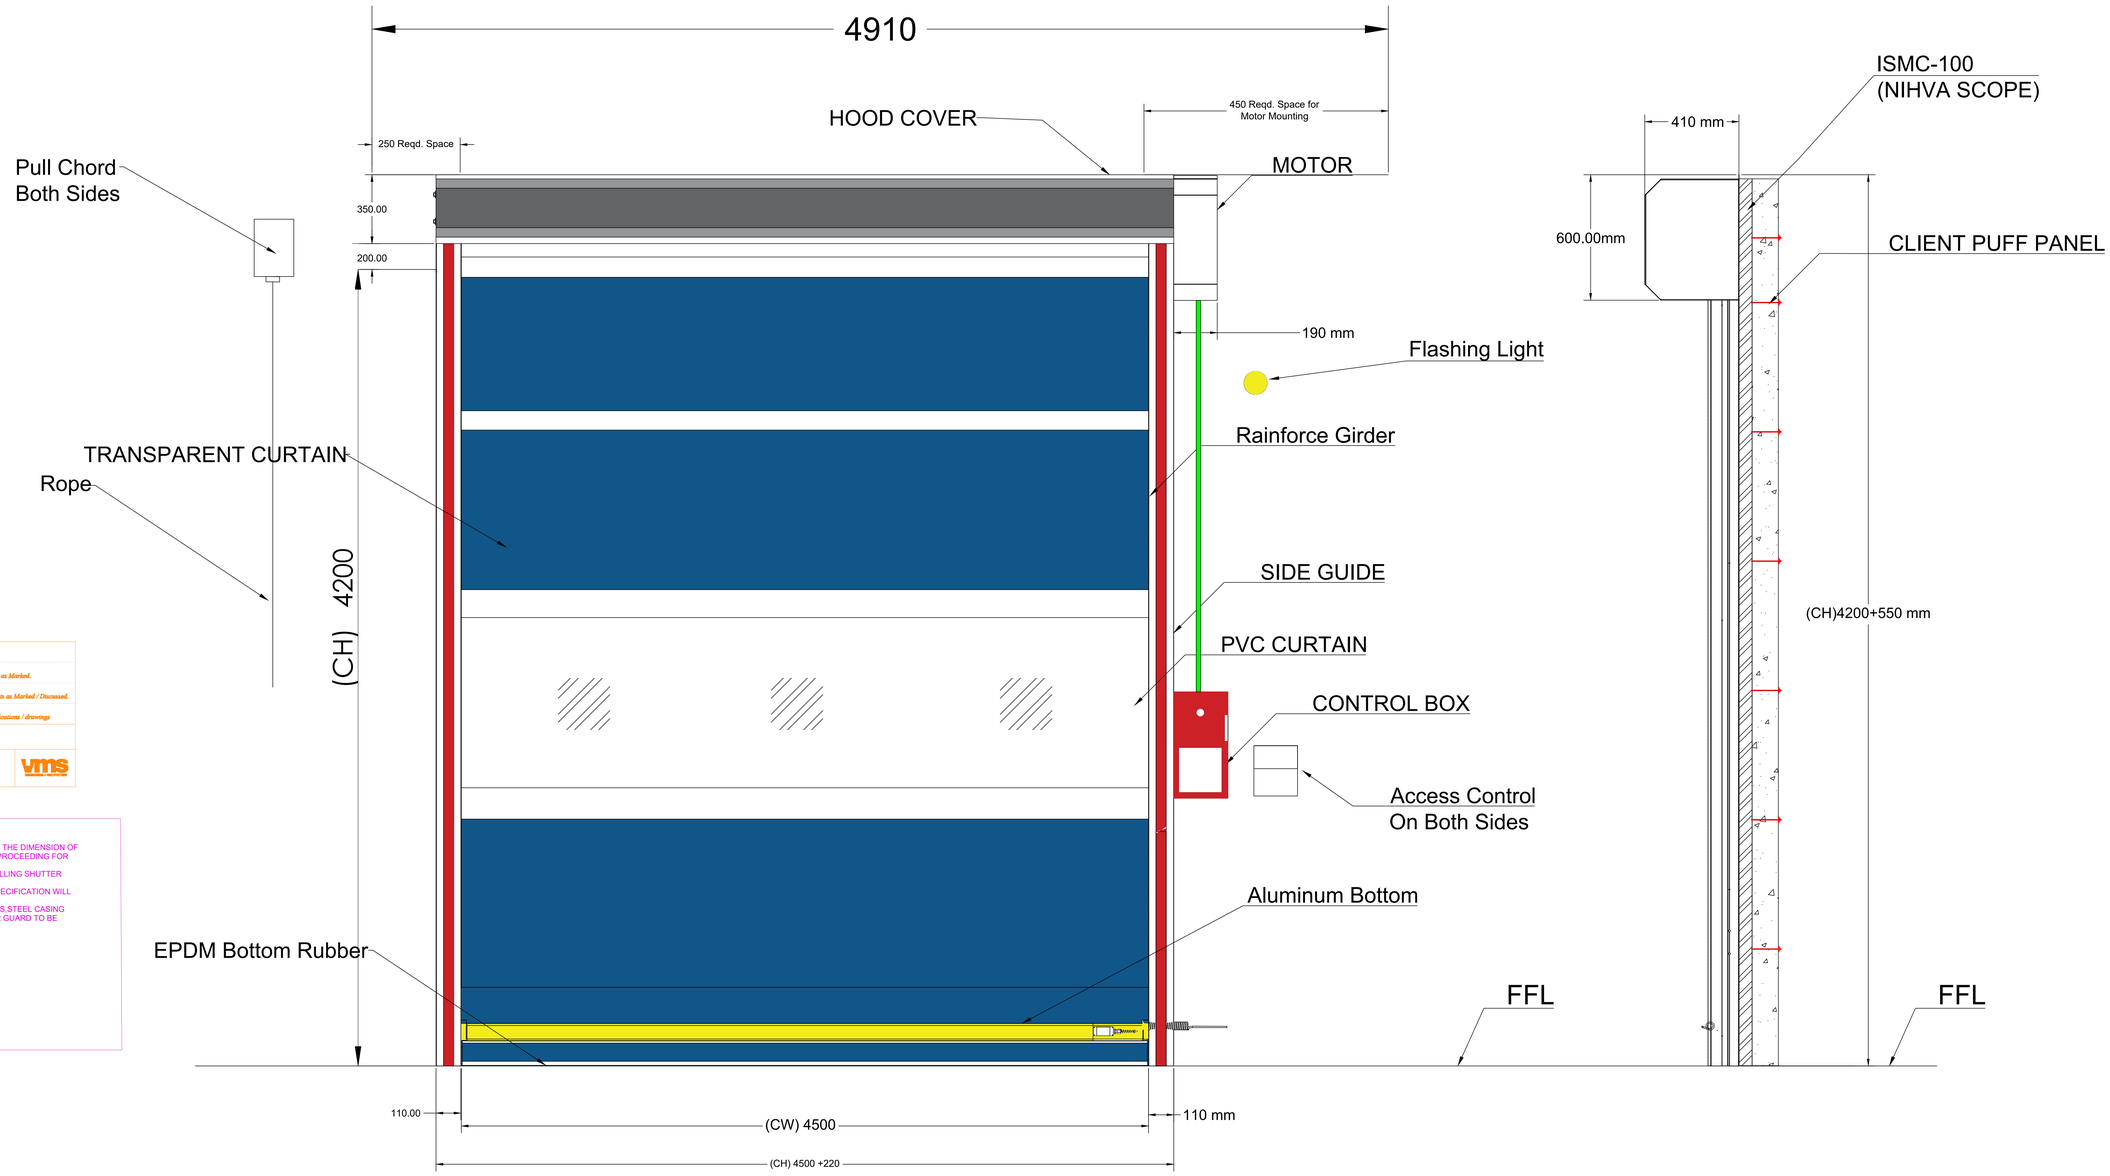

CAT - I	APPROVED - *No Further Comments*	
CAT - II	APPROVED - *Subjected to Incorporation of Comments as Marked.*	
CAT - III	NOT APPROVED *Resubmit with Incorporation of Comments as Marked / Discussed.*	
CAT - IV	INVALID SUBMISSION *Due to Non-Conformity of Tender specifications / drawings*	
(Sign & Date)	(Name & Designation)	(Remarks)

COMMON COMMENTS :
1. CONTRACTOR NEEDS TO VERIFY THE DIMENSION OF THE OPENING ON SITE BEFORE PROCEEDING FOR EXECUTION
2. OPENING CONDITION OF THE ROLLING SHUTTER SHOULD BE AS PER THE PLAN
3. NO DEVIATION FROM TENDER SPECIFICATION WILL BE ALLOWED
4. COLOR OF CURTAIN, SIDE GUIDES,STEEL CASING FOR TOP ROLLER, STEEL MOTOR GUARD TO BE CONFIRMED BY THE CLIENT.

TECHNICAL SPECIFICATION :

SR.	SPECIFICATIONS	DETAILS
1	Control Panel	LED Display Servo Controller : - Operating Speed (Adjustable) : 1.4~2.5 min/ Working Temperature : -35 degree to 65 degree - Water Resistant : IP65 Make IDER, manufactured under European Standards
2	Drive	IDER Make ,CE Certified
3	Motor Power ,Torque	Power : 1.1 kW Torque : 65 Nm
4	Door Travel Speed	Opening: 2 m/Sec & Closing:0.9m/Sec
5	Safety Device	Safety Photocell Pair & Safety Edges
6	Surface Finish	As Per Client Requirement
7	Accessories	Flashing Light with Buzzer , Pull Chord

NOTE:

NIHVA

(1) All Cables & Ele.Conduits to be provided by RINAC
(2) All Civil Work in Client Scope
(3) Required M.S.Structure & Fittings at Nihva Scope

Sr	Clear Width (CW)	Clear Height (CH)	QTY
1	4500	4200	3

This drawing & design is the property of NIHVA TECHNOLOGIES. Not to be sold or copied to any other concern.

	NAME	SIGN	DATE
DRAWN	S.J		19.01.2024
CHECK	A.K		19.01.2024
APPRD.	V.T		19.01.2024

TITLE HIGH SPEED DOOR WITH ACCESS CONTROL GA DRAWING

If any queries contact : projectsupport@nihva.com

ALL DIMENSION ARE IN mm

NIHVA TECHNOLOGIES PVT. LTD.
NIHVA TECHNOLOGIES PVT. LTD. PUNE
Tel : 020 66304033
Email:- info@nihva.com
Website:- www.nihva.com


CLIENT - RINAC


PROJECT - HIGH SPEED DOOR


FORMAT NO - NIHVA-DD-F-03


DWG. NO. : NIHVA/23-24/00XX | REV- R00

SCALE: NTS | WT: | SHEET:

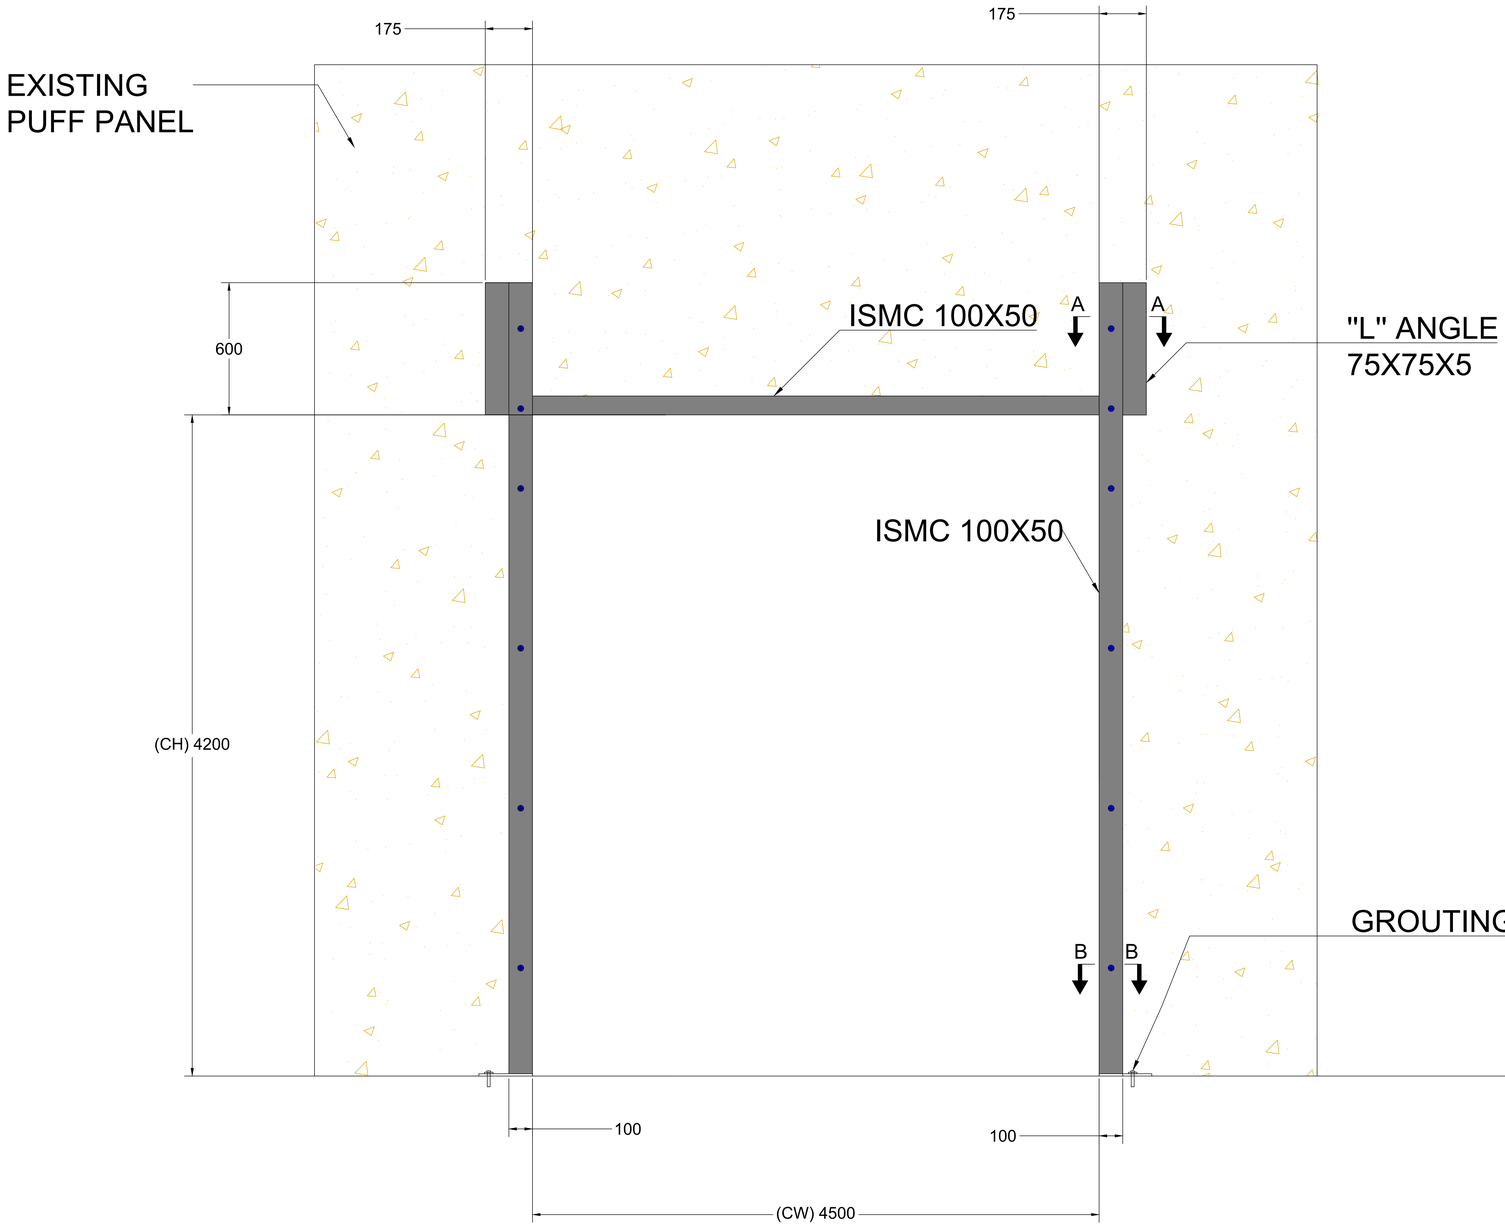

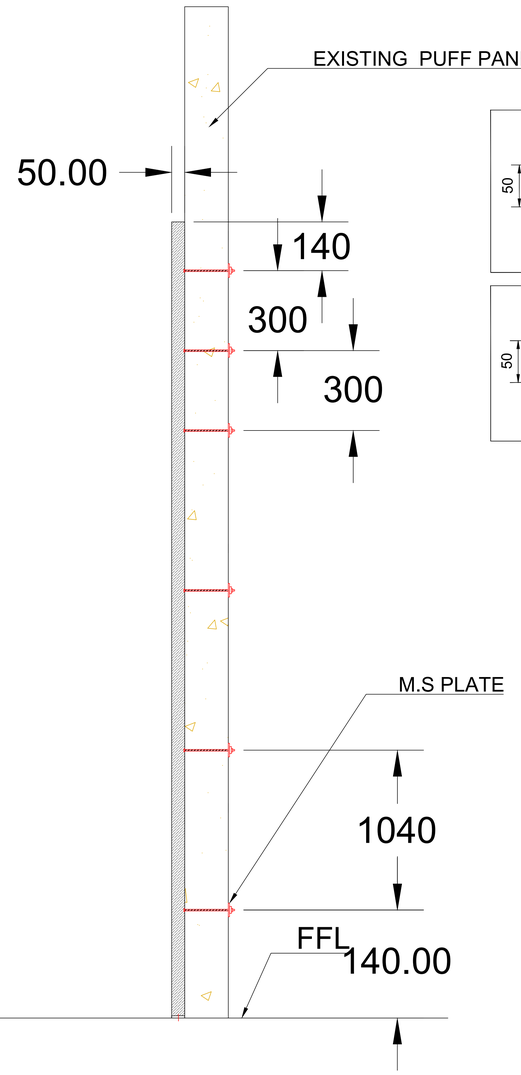

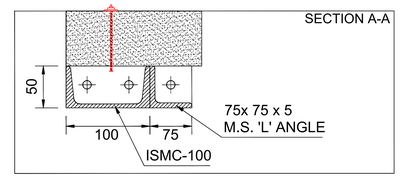

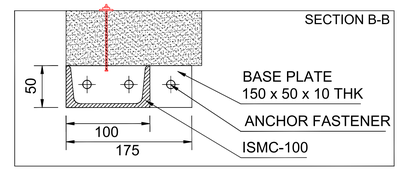

M.S. STRUCTURE DETAILS

Sr	Description	Clear Width (CW)	Clear Height (CH)	QTY
1	HSD Without Sensor With Access Control	**4500**	**4200**	3

This drawing & design is the property of NIHVA TECHNOLOGIES. Not to be sold or copied to any other concern.

TITLE	HIGH SPEED DOOR STRUCTURE DRAWING			NIHVA TECHNOLOGIES PVT. LTD. PUNE Tel : 020 66304033 Email:- info@nihva.com Website:- www.nihva.com	
	NAME	SIGN	DATE		
DRAWN	S.J		18.01.2024	CLIENT - RINAC	
CHECK	A.K		18.01.2024	PROJECT - HIGH SPEED DOOR ST.	
APPRD.	V.T		18.01.2024	FORMAT NO - NIHVA-DD-F-03	
If any queries contact : projectsupport@nihva.com				DWG. NO. : NIHVA/23-24/00XX	REV- R00
ALL DIMENSION ARE IN mm				SCALE: NTS	WT: SHEET: