

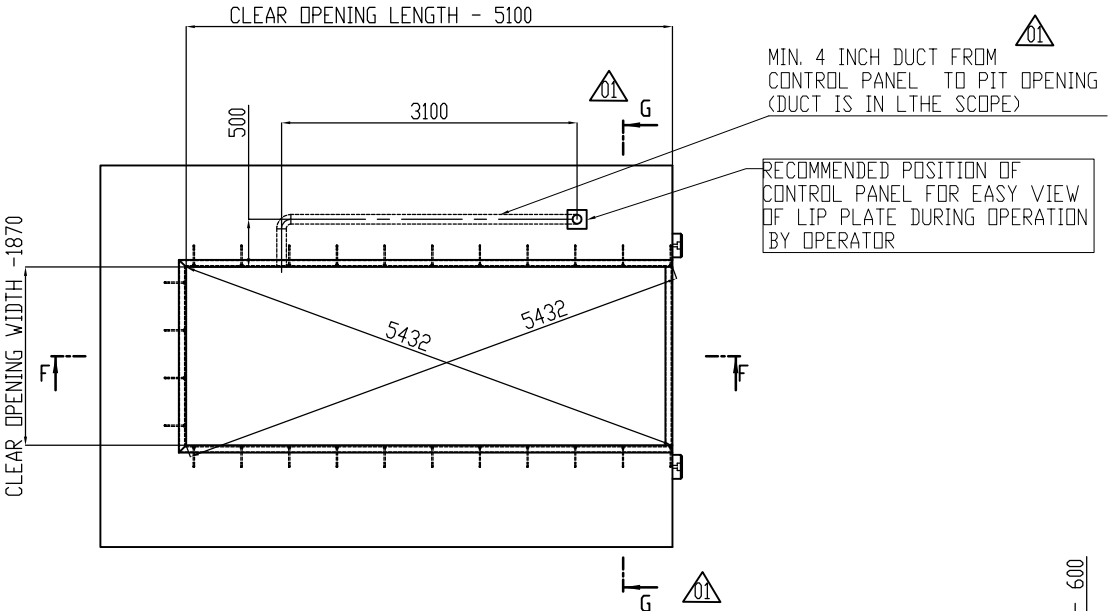



TOP VIEW OF DOCK PIT

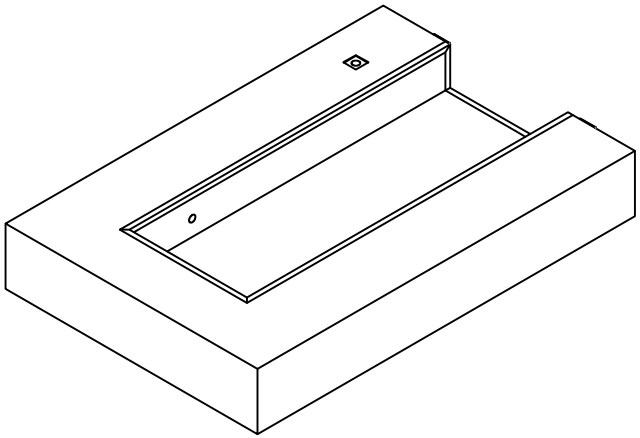


ISOMETRIC VIEW OF DOCK LEVELER PIT

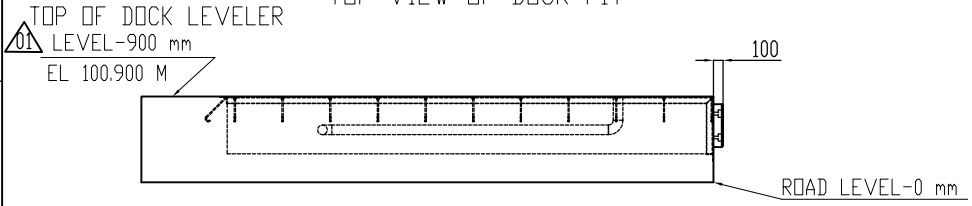


FRONT VIEW OF DOCK PIT

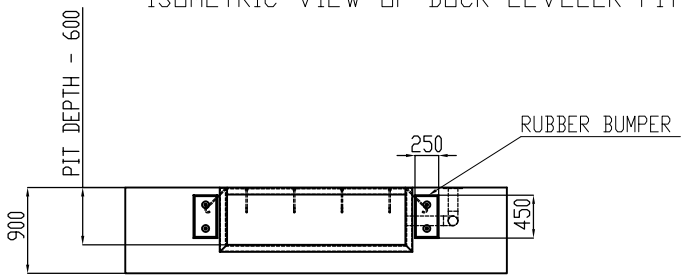


SIDE VIEW OF DOCK PIT

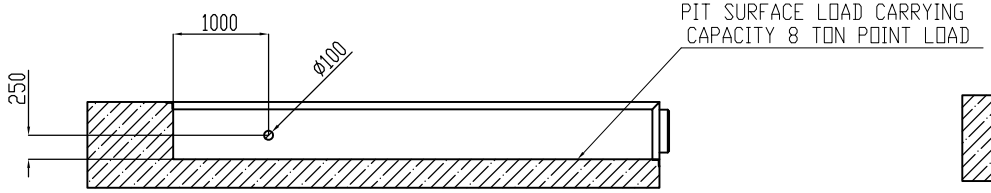

SECTION F-F
SCALE 1 : 28

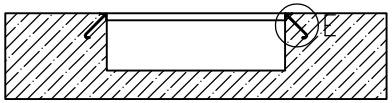

SECTION G-G 01
SCALE 1 : 28

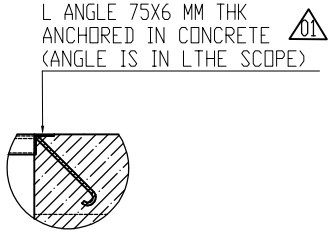

DETAIL E
SCALE 1 : 10

NOTES - 01

1. PIT & ALL CIVIL WORK IS IN LTHE SCOPE .
2. AT ALL EDGES OF PIT ANGLE 75X6 MM THK(ANGLE IN LTHE SCOPE) TO BE ANCHORED IN CONCRETE .
3. PIT SURFACE SHOULD BE PLAIN & LOAD CARRYING CAPACITY FOR PIT SURFACE SHOULB OF 8 TON POINT LOAD .
4. MINIMUM 4 INCH DUCT TO BE PROVIDED FROM CONTROL PANEL TO PIT OPENING BY LTHE FOR ELECTRICAL CABLE ROUTING . REQUIRED DUCT IS IN LTHE SCOPE.
5. CONTROL PANEL IS PROVIDED WITH ELECTRICAL CABLE. CONTROL PANEL SHOULD BE LOCATED NEAR DOCK LEVELER FOR EASY VIEW OF LIP RESTING ON VEHICLE .

DRAWING NO.	DRAWING TITLE	REV
504-LZ-930A/B	GAD OF DOCK LEVELER 01	01

REFERENCE DOCUMENTS / DRAWINGS

DRG. CATEGORY: (USE TICK MARK) [R] [I]
SOIL DATE OF SUBMISSION
EIL REVIEW/APPROVAL CODE:
VPTL NO.:

DOCUMENT STATUS
STATEMENT OF SUB: [1st] [2nd] [3rd]
☐ FINAL FOR CODE-1 ☐ AS BUILT

ISSUED FOR
☐ AS BUILT ☐ INFORMATION
☐ CONSTRUCTION ☐ REVIEW

☐ REVIEW CODE 1 - NO COMMENTS PROCEED WITH MANUFACTURE / FABRICATION/ CONSTRUCTION AS PER THE DOCUMENT.
☐ REVIEW CODE 2 - PROCEED WITH MANUFACTURE / FABRICATION / CONSTRUCTION AS PER THE COMMENTED DOCUMENT. REVISED DOCUMENT REQUIRED.
☐ REVIEW CODE 3 - DOCUMENT DOES NOT CONFORM TO BASIC REQUIREMENTS AS MARKED. RESUBMIT FOR REVIEW.
☐ R - DOCUMENT IS RETAINED FOR RECORDS. PROCEED WITH MANUFACTURE / FABRICATION
☐ V-VOID

SIGN: DATE:

	NAME	DISCIPLINE	SIGN.	DATE

REV.	DESCRIPTION	DRN	CHECKED	APPROVED	REVIEWED	APPROVED	DATE
01	ISSUED FOR APPROVAL	SMS	VJ	AK			

OWNER: HPCL
HINDUSTAN PETROLEUM CORPORATION LIMITED
VISAKH REFINERY MODERNIZATION PROJECT
EPCC-03 PACKAGE FOR RESIDUE UP-GRADATION FACILITY (RUF)

PMC : Bharat Petroleum Engineers India Limited (A Govt. of India Undertaking)

LSTK CONTRACTOR: L&T Hydrocarbon Engineering

DETAILED ENGINEERING CENTER: L&T - CHIYODA LIMITED

L&T - CHIYODA LIMITED

☐ REVIEW CODE 1 - NO COMMENTS PROCEED WITH MANUFACTURE / FABRICATION/ CONSTRUCTION AS PER THE DOCUMENT.
☐ REVIEW CODE 2 - PROCEED WITH MANUFACTURE/ FABRICATION /CONSTRUCTION AS PER THE COMMENTED DOCUMENT. REVISED DOCUMENT REQUIRED.
☐ REVIEW CODE 3 - DOCUMENT DOES NOT CONFORM TO BASIC REQUIREMENTS AS MARKED. RESUBMIT FOR REVIEW.
☐ R - DOCUMENT IS RETAINED FOR RECORDS. PROCEED WITH MANUFACTURE / FABRICATION
☐ V-VOID

COMMENTED BY	REVIEWED BY	APPROVED BY	DATE

THIS REVIEW / APPROVAL DOES NOT RELIEVE THE VENDOR / MANUFACTURER OF THE FULL RESPONSIBILITY AS TO DESIGN CORRECTNESS OF DIMENSIONS & COMPLIANCE WITHALL APPLICABLE REGULATIONS AND WITH THE REQUIREMENTS MADE IN PURCHASER SPECIFICATIONS.

VENDOR : NDVA TECHNOLOGIES PVT LTD
VENDOR PO NO: REFINARY/75000-82256/VMM
VENDOR DWG. NO: NDVA_20-21_0158

DATE: 23.3.21 | SCALE: 1:6
DEPT: DESIGN
DRN BY: SMS
CHK BY: VJ
APP BY: AK

TITLE: CIVIL DRAWING FOR DOCK LEVELER (504-LZ-930A/B) 01
PROJECT: L&T-RUF
PWO NO.:
DRG. NO.: 3656-RUF-LT-504-HP-SV-NTPLCD-13605
SH. 4 OF 4
REV. 01

CAD FILE:

THIS DOCUMENT AND ANY DATA AND APPENDICES CONTAINED HEREIN ARE CONFIDENTIAL AND THE PROPERTY OF L&T HYDROCARBON ENGINEERING (LHE) AND THE COPYRIGHT THEREIN IS VESTED IN LHE. NO PART OF IT SHALL BE REPRODUCED, STORED IN A RETRIEVAL SYSTEM OR TRANSMITTED IN ANY FORM OR BY ANY MEANS (ELECTRONIC, MECHANICAL, PHOTOCOPYING, RECORDING OR OTHERWISE) WITHOUT THE PRIOR WRITTEN PERMISSION OF LHE. THIS DOCUMENT AND ANY DATA AND APPENDICES CONTAINED HEREIN MUST BE RETURNED TO LHE OR DESTROYED IMMEDIATELY ON REQUEST AND IN ANY EVENT UPON COMPLETION OF THE TASK FOR WHICH IT HAS BEEN SUPPLIED. IT MUST NOT BE USED FOR ANY PURPOSE NOT AGREED TO BY LHE IN WRITING.
ALL RIGHTS RESERVED