DRAWING No.


AS BUILT

DO NOT SCALE


NOTES:-

1. ALL DIMENSIONS ARE IN 'mm' & LEVELS ARE IN 'm'.
2. STRUCTECTURAL DETAILS SHOWN ARE INDICATIVE REFER STRUCTECTURAL DRG. FOR THESE DETAILS.

SIZES.-
W = 850 X 1500 mm WINDOW
W1 =1000 X 1500 mm WINDOW
O =700 X 700 mm OPENING
W3 =2000 X 1200 mm WINDOW
W5 =1000 X 1200 mm WINDOW

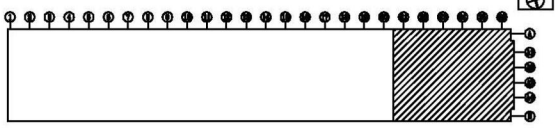

KEY PLAN

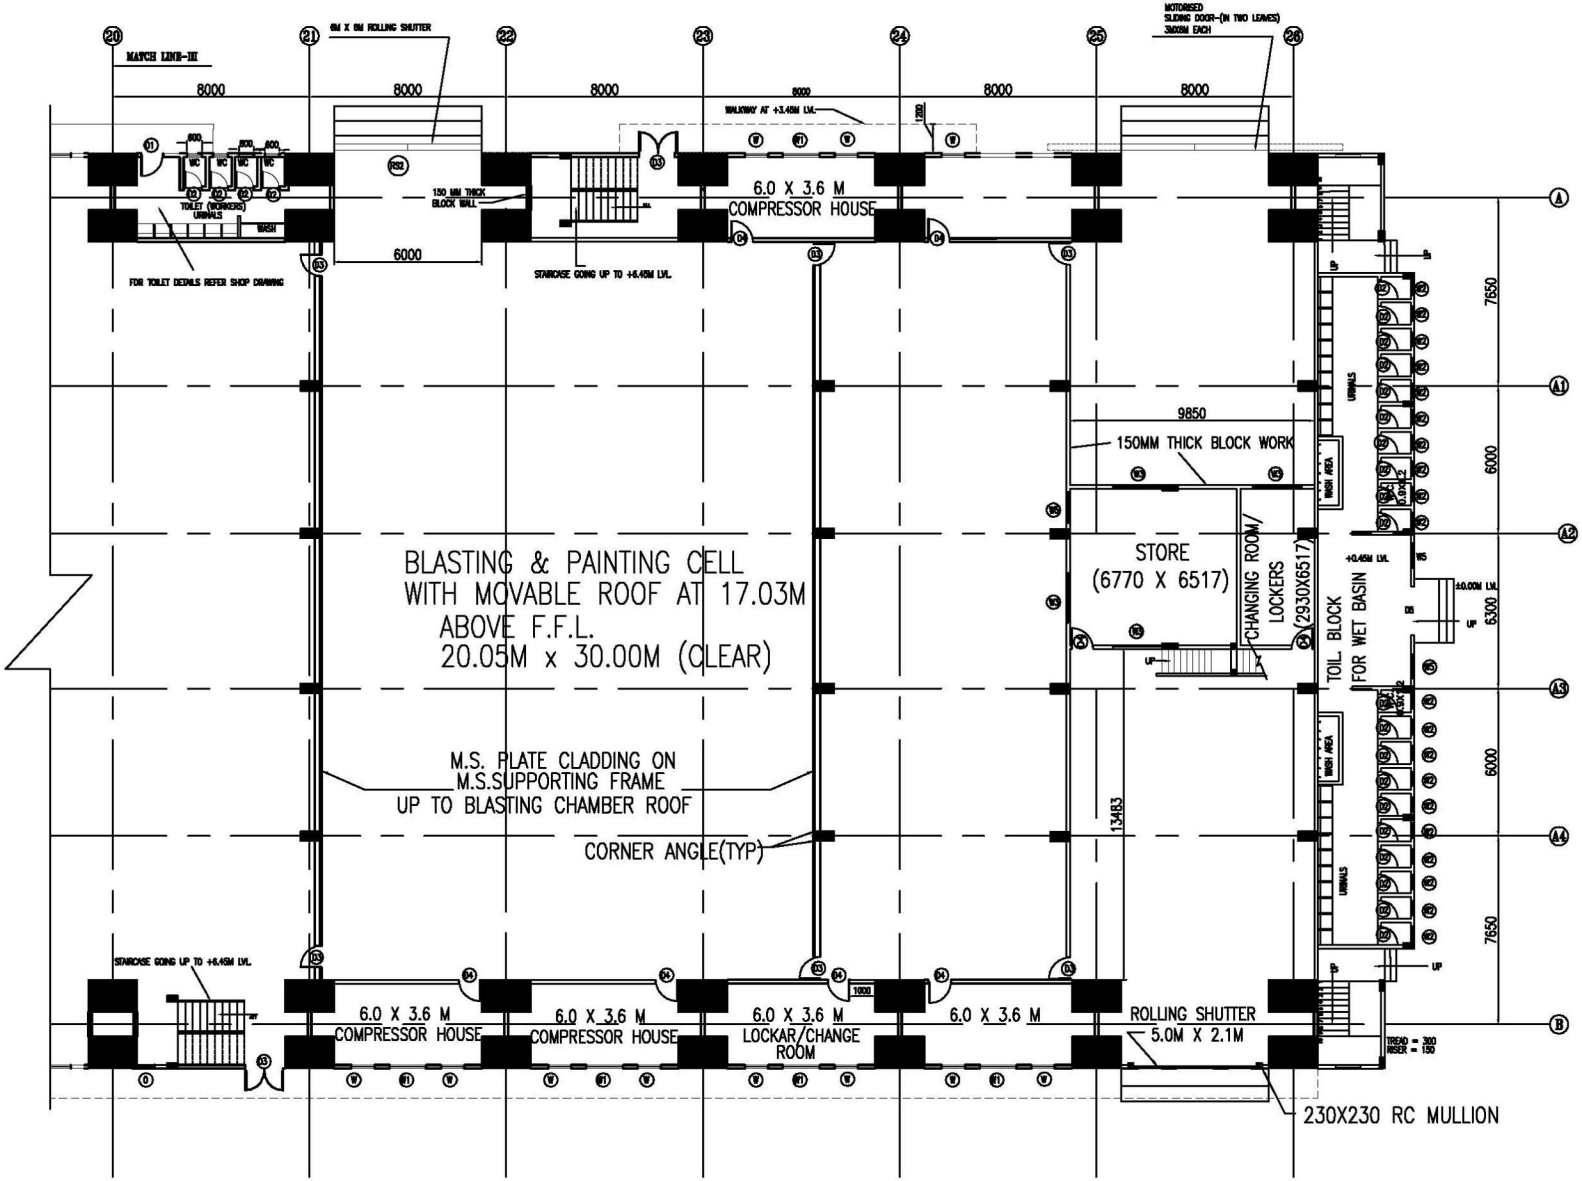

PART GROUND FLOOR PLAN (+0.45M)
(LAND TIES NOT SHOWN FOR CLARITY)

AS BUILT