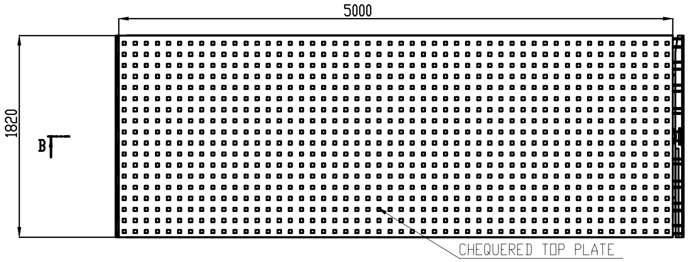
5000
1820
B
B
CHEQUERED TOP PLATE

DOCK LEVELER TOP VIEW

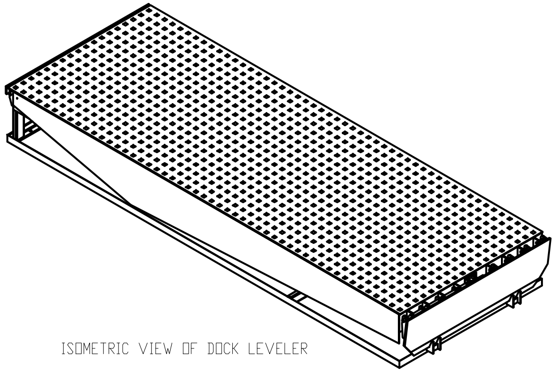

ISOMETRIC VIEW OF DOCK LEVELER

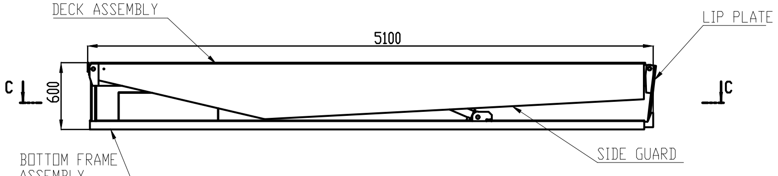
DECK ASSEMBLY
5100
LIP PLATE
C
C
600
BOTTOM FRAME ASSEMBLY
SIDE GUARD

DOCK LEVELER SIDE VIEW

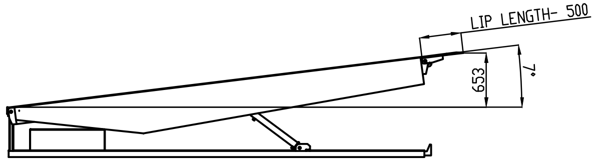
LIP LENGTH- 500
653
7°

DECK UP HEIGHT - 600 MM

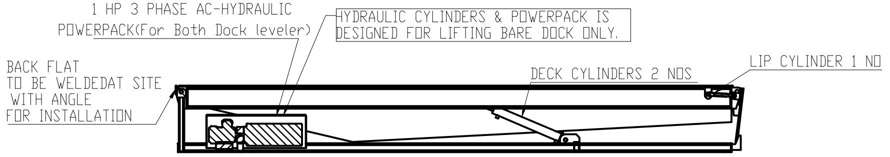
1 HP 3 PHASE AC-HYDRAULIC POWERPACK(For Both Dock leveler)
HYDRAULIC CYLINDERS & POWERPACK IS DESIGNED FOR LIFTING BARE DOCK ONLY.
BACK FLAT TO BE WELDEDAT SITE WITH ANGLE FOR INSTALLATION
DECK CYLINDERS 2 NOS
LIP CYLINDER 1 NO

SECTION B-B
SCALE 1 : 15

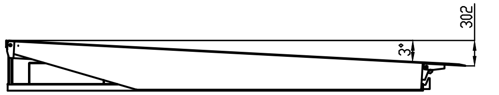

DECK DOWN HEIGHT - 300 MM

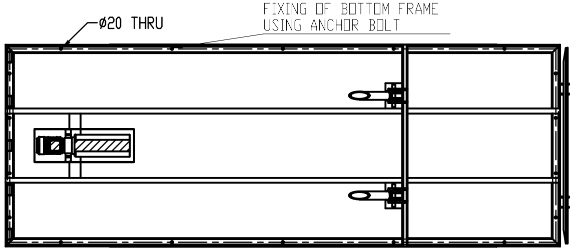
ø20 THRU
FIXING OF BOTTOM FRAME USING ANCHOR BOLT

SECTION C-C
SCALE 1 : 15

TECHNICAL SPECIFICATIONS OF PIT MOUNTED ELECRO-HYDRAULIC DOCK LEVELER -

1. SIZE OF DOCK LEVELER = 1820mm(W) X 5000mm(L)
2. OVERALL SIZE OF PRODUCT = 1820mm(W)X5100mm(L)X600mm(D)
3. CAPACITY = 6 TON POINT LOAD
4. LIP PLATE SIZE = 500mm(L)X1820mm(W)
5. DECK PLATE = CHEQUERED SHEET 1820mm(W)x5000mm(L)
6. DECK & LIP UP=DOWN OPERATION BY HYDRAULIC CYLINDER
7. DECK UP HEIGHT= (+)600 MM
8. DECK DOWN HEIGHT= (-)300MM
9. HEIGHT OF DOCK LEVELER FROM ROAD LEVEL= 900 mm,
10. OPERATION CONTROL BY PUSH BUTTONS ON CONTROL PANEL MOUNTED ON STAND NEAR DOCK LEVELER
11. ELECTRICAL SUPPLY OF EQUIPMENT= 415 VOLT 3 PHASE AC , 50HZ
12. PAINT = FIROZI BLUE
13. MATERIAL OF CONSTRUCTION = MILD STEEL AS PER IS STANDARD
14. MANUFACTURING STANDARD OF DOCK LEVELER =EN1398
15. ELECRICAL MOTOR COMPLIANCE ZONE 1-IIC-T3 HAZARDOUS AREA . FOR OTHER EQUIPMENT=PESO CERTIFICATION
16. PIT SIZE = 1870 mm(W)X5100mm(L)x600 mm(D)
17. DOCK LEVELER FIXING IN PIT BY ANCHOR BOLT .
18. REQUIRED PIT & ALL CIVIL WORK FOR MOUNTING OD DOCK LEVELER IS IN LTHE SCOPE .
    REFER PIT DRAWING FOR CONSTRUCTION OF PIT B016-RUF-LT-504-MP-DW-NTPL(1)-13005

	504-LZ-930A/B	
DRAWING NO.	DRAWING TITLE	REV

REFERENCE DOCUMENTS / DRAWINGS

DRG. CATEGORY: (USE TICK MARK) R I
SCH. DATE OF SUBMISSION
EIL REVIEW/APPROVAL CODE:
VPTL NO.:

DOCUMENT STATUS
STATEMENT OF SUB: 1st 2nd 3rd
☐ FINAL FOR CODE-1 ☑ AS BUILT

ISSUED FOR
☐ AS BUILT ☐ INFORMATION
☐ CONSTRUCTION ☐ REVIEW

SIGN: DATE:

☐ REVIEW CODE 1 – NO COMMENTS PROCEED WITH MANUFACTURE / FABRICATION/ CONSTRUCTION AS PER THE DOCUMENT.
☐ REVIEW CODE 2 – PROCEED WITH MANUFACTURE / FABRICATION / CONSTRUCTION AS PER THE COMMENTED DOCUMENT. REVISED DOCUMENT REQUIRED
☐ REVIEW CODE 3 – DOCUMENT DOES NOT CONFORM TO BASIC REQUIREMENTS AS MARKED. RESUBMIT FOR REVIEW.
☐ R – DOCUMENT IS RETAINED FOR RECORDS. PROCEED WITH MANUFACTURE / FABRICATION
☐ V-VOID

NAME	DICIPLINE	SIGN.	DATE

REV.	DESCRIPTION	DRN	CHECKED	APPROVED	REVIEWED	APPROVED	DATE
00	ISSUED FOR APPROVAL	SNS	VJ	AK			

OWNER: HINDUSTAN PETROLEUM CORPORATION LIMITED
VISAKH REFINERY MODERNIZATION PROJECT
EPCC-03 PACKAGE FOR RESIDUE UP-GRADATION FACILITY (RUF)

PMC : ENGINEERS INDIA LIMITED
(A Govt. of India Undertaking)

LSTK CONTRACTOR: L&T Hydrocarbon Engineering

DETAILED ENGINEERING CENTER: L&T - CHIYODA LIMITED

L&T - CHIYODA LIMITED
☐ REVIEW CODE 1 – NO COMMENTS PROCEED WITH MANUFACTURE / FABRICATION/ CONSTRUCTION AS PER THE DOCUMENT.
☐ REVIEW CODE 2 – PROCEED WITH MANUFACTURE/ FABRICATION /CONSTRUCTION AS PER THE COMMENTED DOCUMENT. REVISED DOCUMENT REQUIRED.
☐ REVIEW CODE 3 – DOCUMENT DOES NOT CONFORM TO BASIC REQUIREMENTS AS MARKED. RESUBMIT FOR REVIEW.
☐ R – DOCUMENT IS RETAINED FOR RECORDS. PROCEED WITH MANUFACTURE / FABRICATION
☐ V-VOID

COMMENTED BY	REVIEWED BY	APPROVED BY	DATE

THIS REVIEW / APPROVAL DOES NOT RELIEVE THE VENDOR / MANUFACTURER OF THE FULL RESPONSIBILITY AS TO DESIGN CORRECTNESS OF ENGINEERING & COMPLIANCE WITH ALL APPLICABLE REGULATIONS AND WITH THE REQUIREMENTS MADE IN PURCHASER SPECIFICATIONS.

VENDOR : NIHVA TECHNOLOGIES PVT LTD
VENDOR PO NO: REFINARY/75000-02256/VHN
VENDOR DWG. NO: NIHVA_20-21_0157
DATE: 31.05.21
SCALE: 1:1
TITLE: 504-LZ-930A/B GAD FOR DOCK LEVELER
DEPT: DESIGN
DRN BY: SNS
CHK BY: VJ
APP BY: AK
PROJECT: L&T-RUF
PWO NO.:
DRG. NO.: [illegible]
SH.1 OF 1
REV. 00
CAD [illegible] FILE: