

TITLE: SSD-02 PLANT 02 BUILDING DOOR WINDOW DETAILS

DWG NO TCE.7594A-450-AC-5345

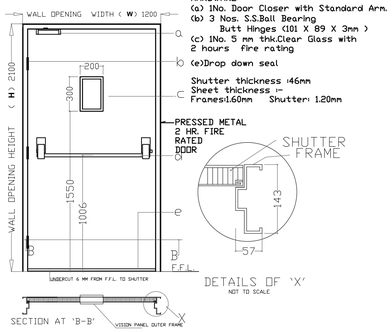

FIRE DOOR - FD1


MASONARY OPENING - 1200 X 2150MM
TWO HOURS FIRE RATED SINGLE LEAF OPENABLE DOOR OF 'SHAKTI' OR EQUIVALENT OF ZINC COATED STEEL FRAME

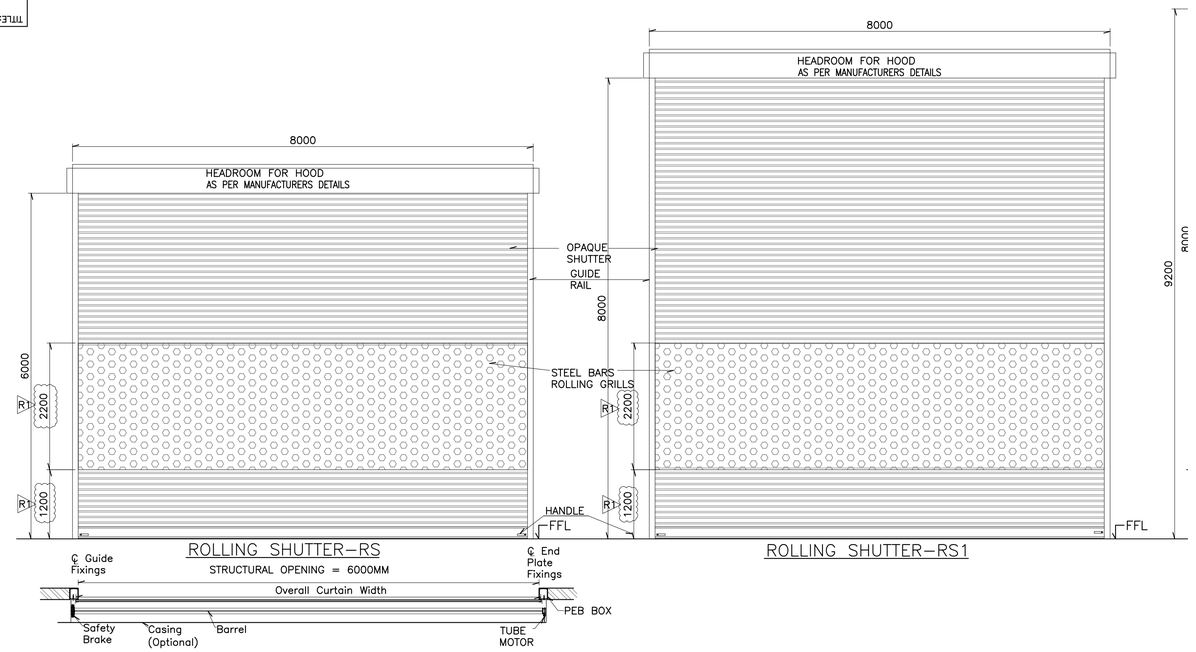


PROPER HARDWARE AND LOCKING ARRANGEMENT TO BE PROVIDED BY VENDOR.

VENDOR TO FURNISH PROPER FABRICATION DRAWING BASED ON THIS DRAWING AND OBTAIN APPROVAL FROM ENGINEER ON SITE.

FOLLOW SPECIFICATIONS CONFORMING TO THE TENDER DOCUMENT.

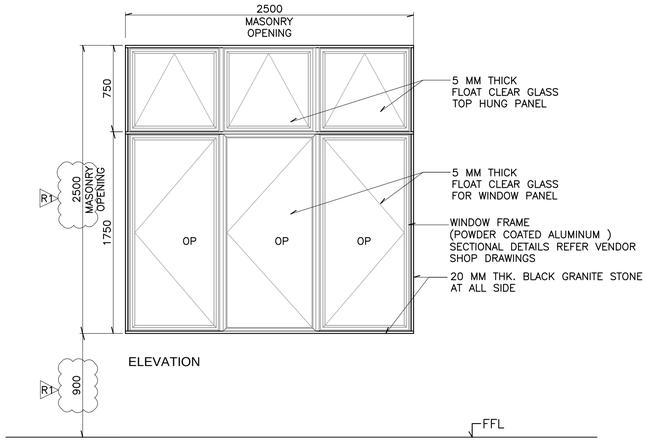

ELEVATION

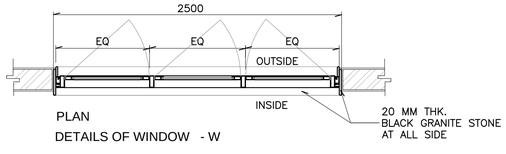

PLAN

DETAILS OF WINDOW - W

SCHEDULE OF DOORS

DOOR TYPE	MASONRY OPENING Width X Height	FRAME	SHUTTER DETAILS	LOCATIONS
FED	1200X2100	PRESSED STEEL DOOR FRAME SHEET THICKNESS 1.60 MM	SHUTTER THICKNESS 46 MM SHEET THICKNESS 1.20 MM (SINGLE LEAF)	AROUND PERIPHERY OF PLANT BUILDING
RS	8000X6000	M.S. GUIDES	ROLLING SHUTTER WITH GRILLS AS PER DESIGN	AROUND PERIPHERY OF PLANT BUILDING
RS1	8000X 8000	M.S. GUIDES	ROLLING SHUTTER WITH GRILLS AS PER DESIGN	AROUND PERIPHERY OF PLANT BUILDING

SCHEDULE OF WINDOWS

DOOR TYPE	MASONRY OPENING Width X Height	CILL	DOOR / WINDOW FRAME	SHUTTER DETAILS
W	2500X2500	900	POWDER COATED ALUMINUM SECTION	5 MM THK FLOAT CLEAR GLASS WITH POWDER COATED ALUMINUM PANEL, ALL OPENABLE SHUTTERS.

LEGEND

● – INDICATES THAT ITEM TO BE PROVIDED.
VP – VISION PANEL
SPECS. – SPECIFICATIONS

NOTES

1. ALL DIMENSION IN MILLIMETERS.
2. ALL DOORS SHALL BE FABRICATED/MANUFACTURED AS PER RELEVANT I.S. CODES AND/OR AS SPECIFIED.
3. ALL FITTINGS/ FIXTURES SHALL BE OF HEAVY DUTY TYPE.
4. ROLLING SHUTTERS SHALL BE OPERABLE FROM BOTH INSIDE AS WELL AS OUTSIDE.
5. FIRE PROOF DOORS/ ROLLING SHUTTERS TO CONFIRM TO SPECIFICATIONS.
6. SHUTTERS AND AIR LOCK DOORS SHALL BE AS REQUIRED BY THE DOOR MANUFACTURERS.
7. ALL DOORS TO BE MANUFACTURED AFTER VERIFYING ACTUAL OPENING DIMENSIONS AS CONSTRUCTED AT SITE.
8. THE DIMENSIONS OF OPENINGS SHOWN IN ELEVATIONS ARE FOR MASONRY/STRUCTURAL OPENINGS.
9. DOOR FRAME FOR STEEL, WOOD WOULD BE FIXED IN WALL BY M.S. HOLD FAST.
10. ALL FIRE RATED DOORS SHALL FULFILL I.S. REQUIREMENTS.
11. ALL DOORS SHALL BE SEALED PROPERLY TO AVOID INGRESS OF DUST.
12. THE LOCKS SHALL BE FIRE RESISTANT AND FIXED IN AN INSULATED LOCK POCKET FOR FR DOORS.
13. PANIC BOLT DEVICE SHALL BE ABLE TO OVER RIDE LOCKS FOR LOCKED DOORS.
14. VISION PANEL SIZE 300 X 300 OR AS DIRECTED.
15. ALUMINUM DOOR SECTIONS TO BE OF STANDARD MAKE AS PER SPECIFICATIONS.
16. ROLLING SHUTTERS HAVING WIDTH MORE THAN 5M TO HAVE GUIDE RAIL MORE THAN 100MM & CERTIFIED BY ARCHITECT / ENGINEER.

ENGINEERING REFERENCE DRAWINGS

TCE.7594A-450-AC-5000 -- MASTER PLAN

CONSTRUCTION REFERENCE DRAWINGS

1.TCE.7594A-450-AC-5340 ---SSD-02 GROUND FLOOR PLAN
2.TCE.7594A-450-AC-5342 ---SSD- 02 ELEVATIONS
3.TCE.7594A-450-AC-5343 ---SSD-02 SECTIONS

HOLD

---NIL---

DO NOT SCALE | GOOD FOR CONSTRUCTION

Godrej & BOYCE MFG. CO. LTD.

PROPOSED INDUSTRIAL EXPANSION AT VILLAGE VADVAL AND TAMBATI, TAL. KHALAPUR, DIST. RAIGAD

SSD-02 PLANT 02 BUILDING DOOR WINDOW DETAILS

TATA CONSULTING ENGINEERS LIMITED
MUMBAI

FOR R0 ISSUE ONLY			ISSUE	REVISIONS	DRN	CLEARED					APPD	DATE
CLEARED						CIVIL	ELEC	I&C	MECH			
DISC.	SIGNATURE	DATE	R1	WINDOW HEIGHT AND SILL LEVEL REVISED; ROLLING STEEL BAR GRILLS ADDED TO ROLLING SHUTTERS	PPS							
CIVIL												
ELEC												
I&C												
MECH												

ISSUE	REVISIONS	DRN	CLEARED					APPD	DATE
			CIVIL	ELEC	I&C	MECH			

FILE NAME : 7594A-AC-5345-R0

"P" (PRELIMINARY) ISSUES ARE NOT TO BE USED FOR CONSTRUCTION / FABRICATION BUT ARE ISSUED FOR LIMITED PURPOSES ONLY AS INDICATED IN THE SMALL BLOCK AT THE TOP RIGHT HAND CORNER OF THE TITLE BLOCK.

CONSTRUCTION / FABRICATION WORK IS PERMITTED ON "R" (RELEASED) ISSUES ONLY.

INFORMATION CONTAINED WITHIN 'HOLD' IS NOT RELEASED FOR CONSTRUCTION/ FABRICATION. FIELD MUST GET DESIGN OFFICE TO CLEAR "HOLDS" IN TIME BEFORE PROCEEDING WITH ANY CONSTRUCTION/FABRICATION WORK RELATED TO 'HOLDS'.

SCALE: 1:25	APPROVED	DATE (R0 ISSUE) 11-03-2016
DEL.CENTRE-DISC: PUN.AC	DISCIPLINE HEAD	DATE (CURRENT ISSUE) 07-07-2016
DRN: SPP		
CHD:	DWG NO TCE.7594A-450-AC-5345	ISSUE R1

SIZE-A1

FILE NAME: F-041-Rev-R5.dwg

TCE FORM NO. 041 R5