SL.NO	BOM(For Single Dock leveler) DESCRIPTON	QTY
1	Dock Leveler (1820 mm x 5000 mm)	1No
2	Lip (1820 x 250 mm)	1No
3	Deck Cylinder	2Nos
4	Lip Cylinder	1No
5	Power Pack(1HP,3Phase)	1No
6	Control Panel	1No

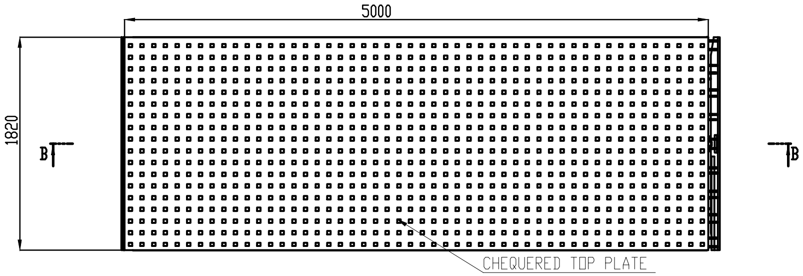

DOCK LEVELER TOP VIEW

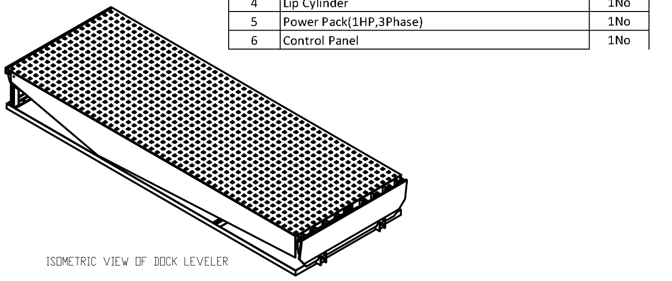
ISOMETRIC VIEW OF DOCK LEVELER

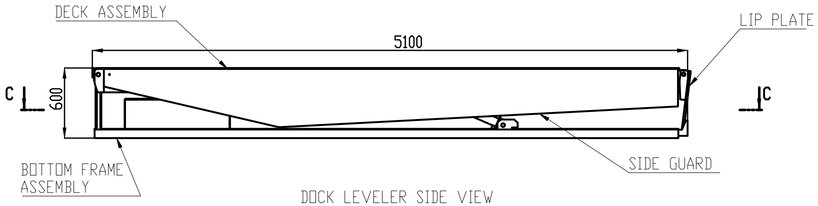

DOCK LEVELER SIDE VIEW

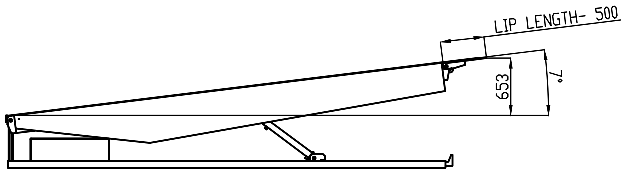

DECK UP HEIGHT - 600 MM

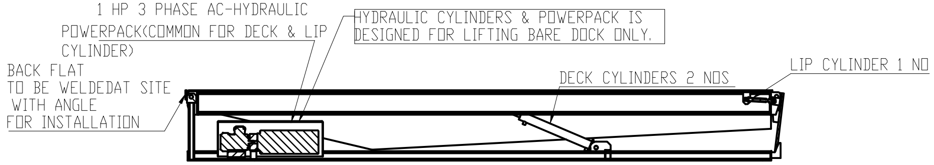
1 HP 3 PHASE AC-HYDRAULIC POWERPACK(COMMON FOR DECK & LIP CYLINDER)
HYDRAULIC CYLINDERS & POWERPACK IS DESIGNED FOR LIFTING BARE DOCK ONLY.
BACK FLAT TO BE WELDEDAT SITE WITH ANGLE FOR INSTALLATION
DECK CYLINDERS 2 NOS
LIP CYLINDER 1 NO

SECTION B-B
SCALE 1 : 15

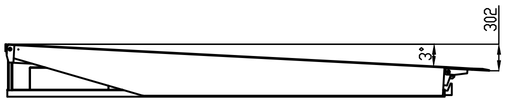

DECK DOWN HEIGHT - 300 MM

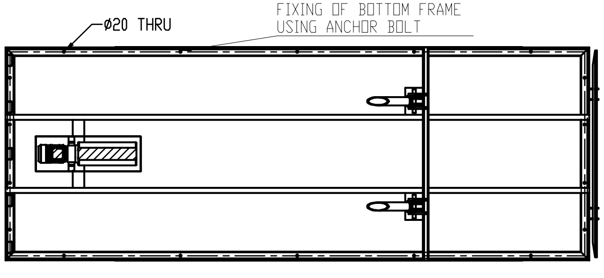

SECTION C-C
SCALE 1 : 15

TECHNICAL SPECIFICATIONS OF PIT MOUNTED ELECRO-HYDRAULIC DOCK LEVELER -

1. SIZE OF DOCK LEVELER = 1820mm(W) X 5000mm(L)
2. OVERALL SIZE OF PRODUCT = 1820mm(W)X5100mm(L)X600mm(D)
3. CAPACITY = 6 TON POINT LOAD
4. LIP PLATE SIZE = 500mm(L)X1820mm(W)
5. DECK PLATE = CHEQUERED SHEET 1820mm(W)x5000mm(L)
6. DECK & LIP UP=DOWN OPERATION BY HYDRAULIC CYLINDER
7. DECK UP HEIGHT= (+)600 MM
8. DECK DOWN HEIGHT= (-)300MM
9. HEIGHT OF DOCK LEVELER FROM ROAD LEVEL= 900 mm,
10. OPERATION CONTROL BY PUSH BUTTONS ON CONTROL PANEL MOUNTED ON STAND NEAR DOCK LEVELER
11. ELECTRICAL SUPPLY OF EQUIPMENT= 415 VOLT 3 PHASE AC , 50HZ
12. PAINT = FIROZI BLUE
13. MATERIAL OF CONSTRUCTION = MILD STEEL AS PER IS STANDARD
14. MANUFACTURING STANDARD OF DOCK LEVELER =EN1398
15. ELECRICAL MOTOR COMPLIANCE ZONE 1-IIC-T3 HAZARDOUS AREA .
16. PIT SIZE = 1870 mm(W)X5100mm(L)x600 mm(D)
17. DOCK LEVELER FIXING IN PIT BY ANCHOR BOLT .
18. REQUIRED PIT & ALL CIVIL WORK FOR MOUNTING OD DOCK LEVELER IS IN LTHE SCOPE .
REFER PIT DRAWING FOR CONSTRUCTION OF PIT B016-RUF-LT-504-MP-DW-NTPL(1)-13005

ALL RIGHTS RESERVED
THIS DOCUMENT AND ANY DATA AND INFORMATION CONTAINED THEREIN ARE CONFIDENTIAL AND THE PROPERTY OF L&T HYDROCARBON ENGINEERING (LTHE) AND THE COPYRIGHT THEREIN IS VESTED IN LTHE NO PART OF THIS DOCUMENT, DATA, OR INFORMATION SHALL BE DISCLOSED TO OTHERS OR REPRODUCED IN ANY MANNER OR USED FOR ANY PURPOSE WHATSOEVER, EXCEPT WITH THE PRIOR WRITTEN PERMISSION OF LTHE.

DRAWING NO.	DRAWING TITLE	REV
504-LZ-930A/B	CIVIL DRAWING OF DOCK LEVELER	

REFERENCE DOCUMENTS / DRAWINGS

DRG. CATEGORY: (USE TICK MARK) R I
SCH. DATE OF SUBMISSION
EIL REVIEW/APPROVAL CODE:
VPIL NO.:

DOCUMENT STATUS
STATEMENT OF SUB: 1st 2nd 3rd
☐ FINAL FOR CODE-1 ☑ AS BUILT
ISSUED FOR
☐ AS BUILT ☐ INFORMATION
☐ CONSTRUCTION ☐ REVIEW
SIGN: DATE:

☐ REVIEW CODE 1 - NO COMMENTS PROCEED WITH MANUFACTURE / FABRICATION/ CONSTRUCTION AS PER THE DOCUMENT.
☐ REVIEW CODE 2 - PROCEED WITH MANUFACTURE / FABRICATION / CONSTRUCTION AS PER THE COMMENTED DOCUMENT. REVISED DOCUMENT REQUIRED
☐ REVIEW CODE 3 - DOCUMENT DOES NOT CONFORM TO BASIC REQUIREMENTS AS MARKED. RESUBMIT FOR REVIEW.
☐ R - DOCUMENT IS RETAINED FOR RECORDS. PROCEED WITH MANUFACTURE / FABRICATION
☐ V-VOID
NAME DICIPLINE SIGN. DATE

REV.	DESCRIPTION	DRN	CHECKED	APPROVED	REVIEWED	APPROVED	DATE
00	ISSUED FOR APPROVAL	SMS	VJ	AK			

OWNER: HINDUSTAN PETROLEUM CORPORATION LIMITED
VISAKH REFINERY MODERNIZATION PROJECT
EPCC-03 PACKAGE FOR RESIDUE UP-GRADATION FACILITY (RUF)

PMC : इंजीनियर्स इंडिया लिमिटेड ENGINEERS INDIA LIMITED (A Govt. of India Undertaking)

LSTK CONTRACTOR: L&T Hydrocarbon Engineering

DETAILED ENGINEERING CENTER: L&T - CHIYODA LIMITED

L&T - CHIYODA LIMITED
☐ REVIEW CODE 1 - NO COMMENTS PROCEED WITH MANUFACTURE / FABRICATION/ CONSTRUCTION AS PER THE DOCUMENT.
☐ REVIEW CODE 2 - PROCEED WITH MANUFACTURE/ FABRICATION /CONSTRUCTION AS PER THE COMMENTED DOCUMENT. REVISED DOCUMENT REQUIRED.
☐ REVIEW CODE 3 - DOCUMENT DOES NOT CONFORM TO BASIC REQUIREMENTS AS MARKED. RESUBMIT FOR REVIEW.
☐ R - DOCUMENT IS RETAINED FOR RECORDS. PROCEED WITH MANUFACTURE / FABRICATION
☐ V-VOID

COMMENTED BY	REVIEWED BY	APPROVED BY	DATE

THIS REVIEW / APPROVAL DOES NOT RELIEVE THE VENDOR / MANUFACTURER OF THE FULL RESPONSIBILITY AS TO DESIGN CORRECTNESS OF DIMENSIONS & COMPLIANCE WITHALL APPLICABLE REGULATIONS AND WITH THE REQUIREMENTS MADE IN PURCHASER SPECIFICATIONS.

VENDOR : NIHVA TECHNOLOGIES PVT LTD
VENDOR PO NO: REFINARY/75000-82256/VHM
VENDOR DWG. NO: NIHVA_20-21_0157
DATE: 31.05.21
SCALE: 1:1
TITLE: 504-LZ-930A/B GAD FOR DOCK LEVELER
DEPT: DESIGN
DRN BY: SMS
CHK BY: VJ
APP BY: AK
PROJECT: L&T-RUF
PWO NO.:
DRG. NO.: [illegible]
SH.1 OF 1
REV. 00
CAD [illegible] FILE: