


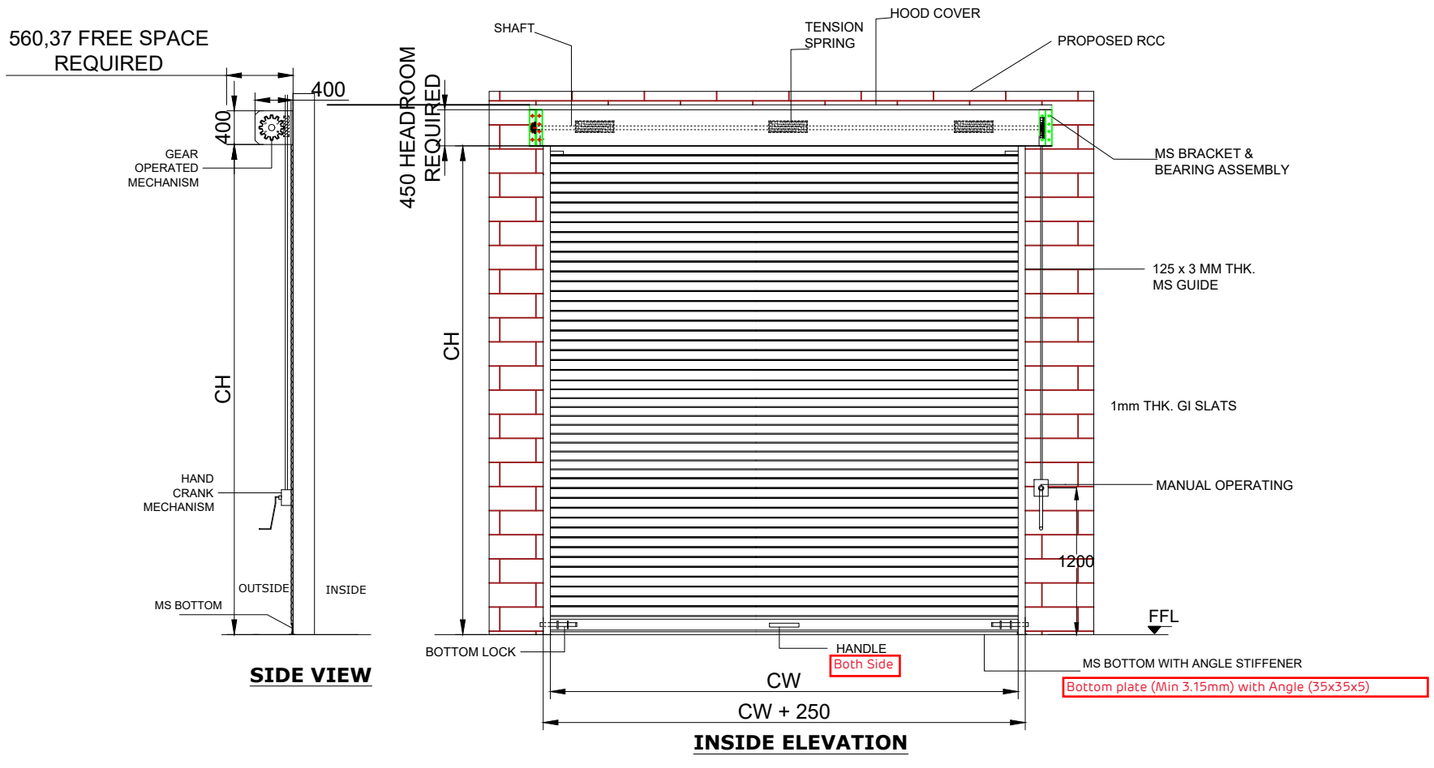


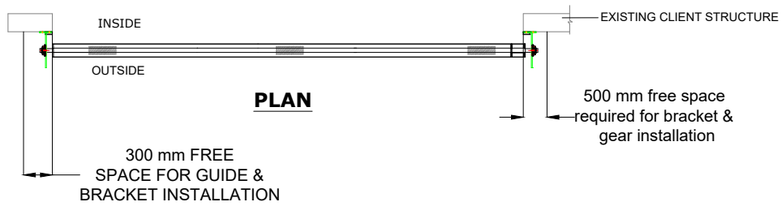

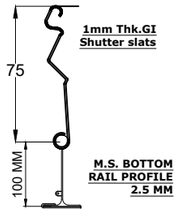

M.S. BOTTOM RAIL PROFILE 2.5MM

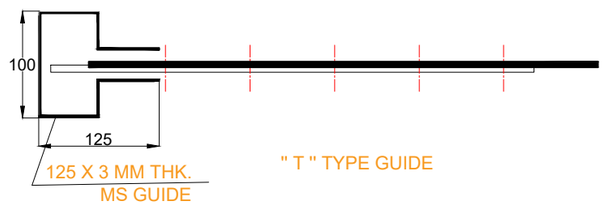

NOTE-
1. ALL CIVIL WORK WILL BE CLIENT'S SCOPE.
2.IF STRUCTURE REQUIRED FOR SHUTTER IS IN CLIENT'S SCOPE.

TECHNICAL SPECIFICATION:-

SR.	SPECIFICATION	DETAILS
1.	DESCRIPTION & DRIVE	GEAR OPERATED SHUTTER
2.	LOCATION AREA	INSIDE AREA / OUTSIDE AREA
3.	MOUNTING SURFACE	SIDE BRACKETS: ON CONCRETE
4.	SLAT	75 MM WIDE - 1 MM THICK GI 1.2mm Thk
5.	BOTTOM PROFILE	M.S. PLATE 100X2.5 MM THICK WITH ANGLE STIFFNER Bottom plate (Min 3.15mm) with Angle (35x35x5)
6.	GUIDE PROFILE	M.S."T" SHAPE -100X125X3 MM THK 3.15mm Thk
7.	HOOD COVER	MADE OF GI SHEET THICKNESS 0.9 MM.
8.	MATERIAL FINISH	SYNTHETIC ENAMEL PAINT

NOTES
-Opening size & Nos shall be as per GAD
-All the make shall be approved by our Quality Team.
-Color shall be match with adjacent Puff Wall.

- GALVANISATION SHALL BE MIN 230g/Sqm.
- ROLLING SHUTTER SHALL WITHSTAND A BASIC WIND SPEED OF 50 m/s.
- Rolling shutter can open from both side. (Inside & Outside).
- Supporting Structural Frame shall be provided by vendor, so that during operation load can not transfer on Side Wall/Puff Wall.
- Rolling Shutter shall be confirming to IS 6248.

SR NO	(CW) CLEAR WIDTH	(CH) CLEAR HEIGHT	QUANTITY
1	3000	4000	04 NOS

For Utility Building

adani

Categories:
- Cat-I Approved. Good for Manufacturing/Construction/Fabrication
- Cat-II Approved with minor comments. No resubmission is required. To be incorporated in As-Built. Good for Manufacturing/ Construction/ Fabrication subject to incorporation of comments.
- Cat-III Approved. Released for Manufacturing/fabrication/construction subjected to incorporation of comments. Modification as Noted. Resubmission is required.
- Cat-III Not Approved
- Cat-IV For Information & Records

Note: "Approval of this document does not absolve the Contractor/ Supplier/ Fabricator from fulfilling Contractual obligations in any way".

Dinesh Purohit — Reviewer

Approver

This drawing & design is the property of NIHVA TECHNOLOGIES. Not to be sold or copied to any other concern.

TITLE	NAME	SIGN	DATE
GEAR OPERATED ROLLING SHUTTER			
DRAWN	V.W.		08.11.2025
CHECK	B.S.		08.11.2025
APPRD.	V.T.		08.11.2025

NIHVA TECHNOLOGIES PVT. LTD.
Website:- www.nihva.com
NIHVA TECHNOLOGIES PVT. LTD. PUNE
Tel : 020 66304033
Email:- info@nihva.com

CLIENT - ARCESGES BUILDING INDIA LLP
PROJECT -
SITE LOCATION -
If any queries contact : design@nihva.com
DWG. NO. : NIHVA/21-22/VDR/020
REV- R00
ALL DIMENSION ARE IN mm
SCALE: NTS
WT:
SHEET: 01 OF 01