


PRODUCED BY AN AUTODESK STUDENT VERSION

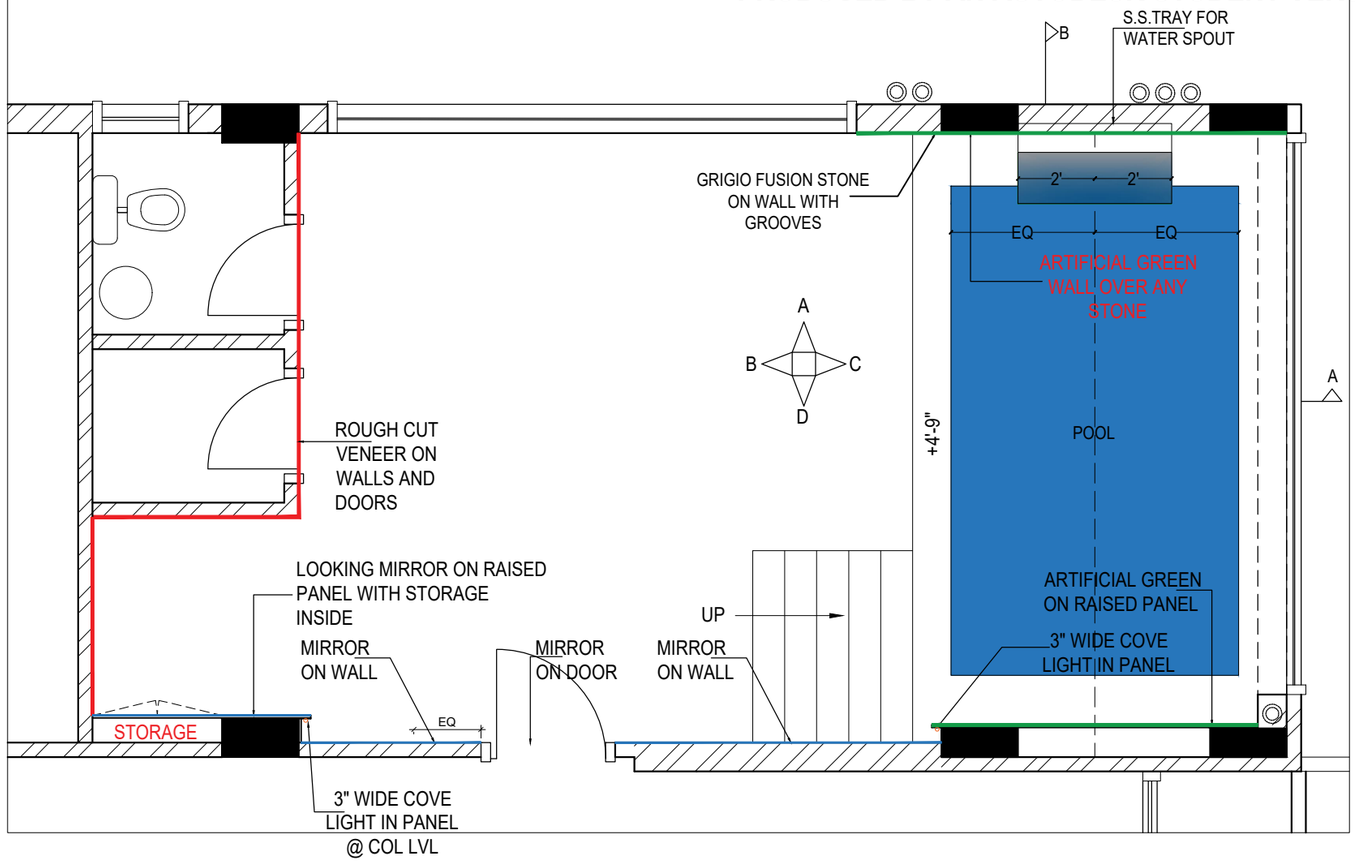

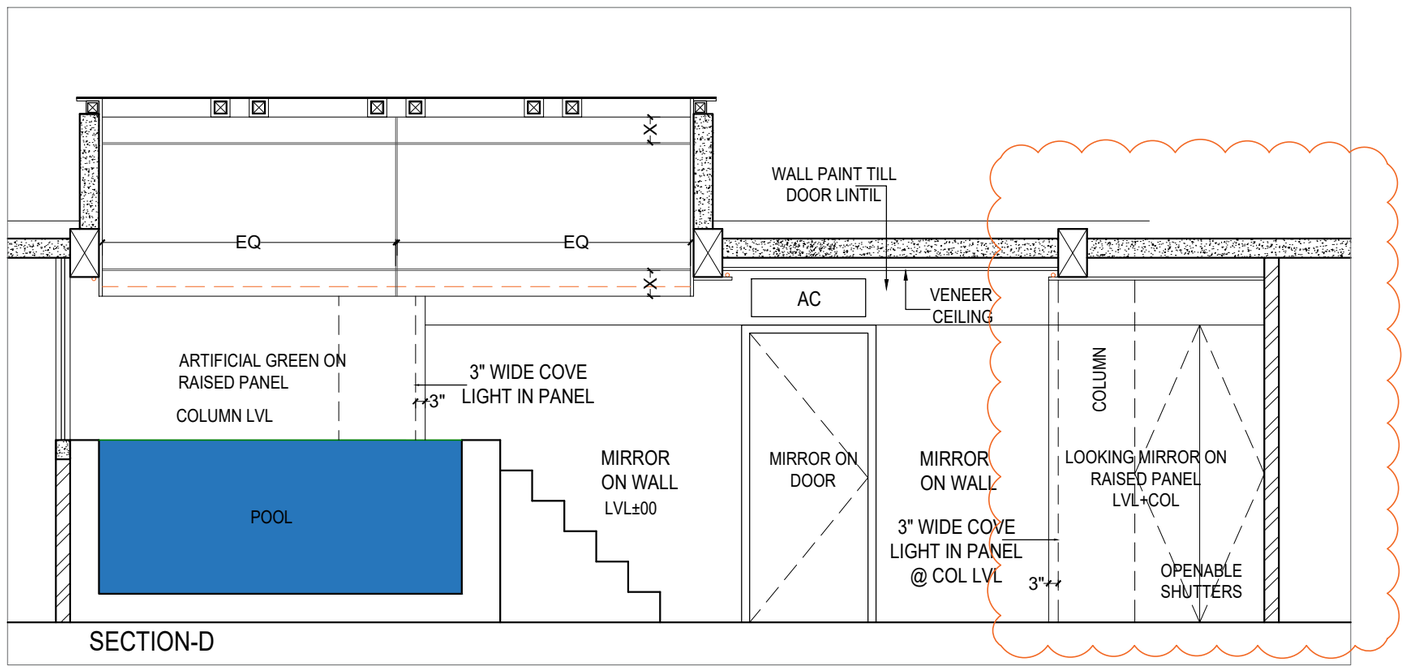

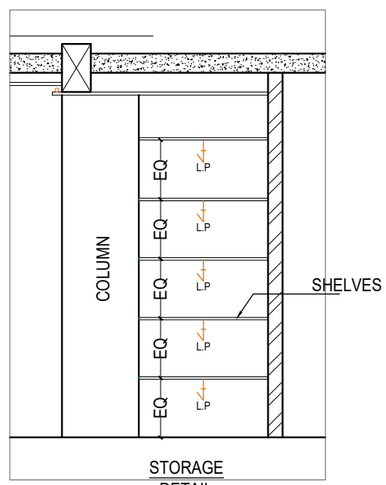

PROJECT-

RESIDENCE AT CIVIL LINES

NOTE:

1.ALL DIMENSIONS ARE EXCLUDING FINISHES
2.DO NOT SCALE DRAWING.ONLY MENTIONED DIMENSIONS ARE TO BE CONSIDERED.
3.ANY DISCREPANCIES SHALL BE BROUGHT UNDER THE NOTICE OF ARCHITECTS PRIOR COMMENCEMENT OF WORK.

RELEASED FOR: MR. RAHUL GOEL

information	tender	construction	as built

REVISION

S.NO.	REMARKS	DATE
	REV1	
2	REV2	
3	REV3	DATER3
4	REV4	DATER4
5	REV5	DATER5
6	REV6	DATER6
7	REV7	DATER7

TITLE

SECOND FLOOR - SPA
AREA DETAIL

DATE	17-04-2021
SCALE	NTS
DRAWN BY	YASHICA
CHD BY	VERTIKA
DWG. NO.	

ARCHITECT

ATREY & ASSOCIATES
Architecture, Landscape & Interiors
7G, 7th Floor Bigjos' Tower
Netaji Subhash Place, Delhi.
space@atreydesign.com

PRODUCED BY AN AUTODESK STUDENT VERSION
PRODUCED BY AN AUTODESK STUDENT VERSION
PRODUCED BY AN AUTODESK STUDENT VERSION