

CV04. Please check north

CV05. Please add any fixing arrangement required for motor, Jack etc inside pit

CV2. Please clear OK-FF, OK-RF

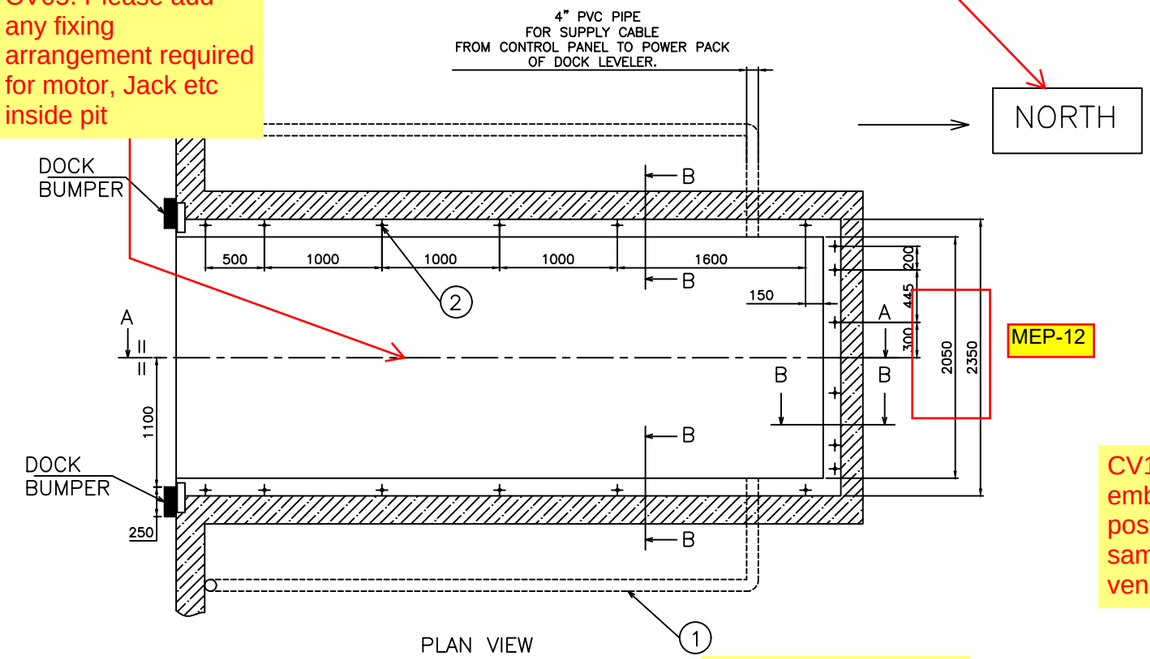


PLAN VIEW

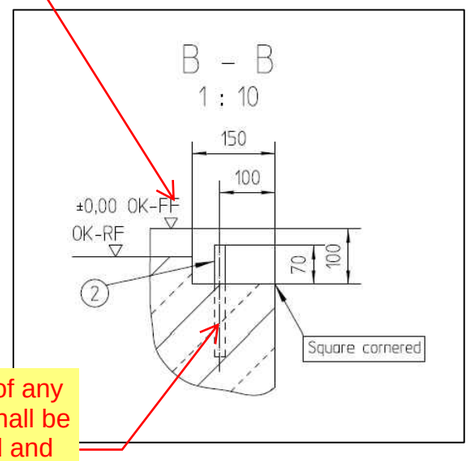

CV1. Fixing of any embedded shall be post installed and same shall be by vendor.

CV03. Please provide floor details. material, dimensions, scope etc

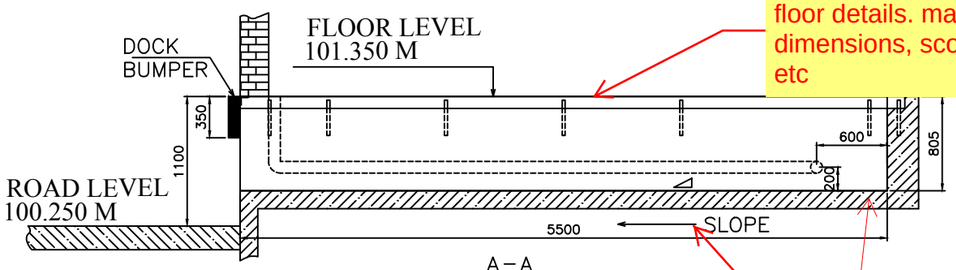


A – A

ELEVATION VIEW

MEP- 07


CV6. indicate TOC elevation

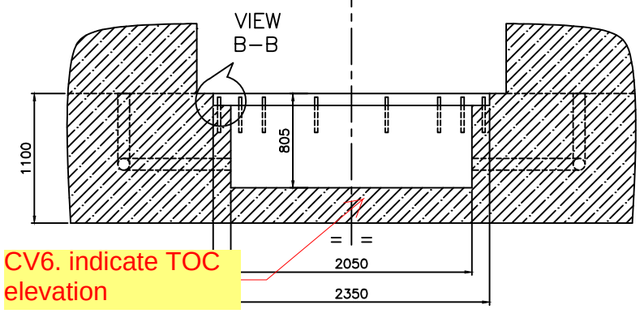

SIDE VIEW

CV6. indicate TOC elevation

NOTE:
1. DO NOT DEVIATE FROM THE MEASUREMENTS GIVEN.
2. THE PIT WALLS MUST BE VERTICAL.
3. THE CORNERS OF THE PIT MUST BE SQUARE.
4. DIAGONALS MUST BE EQUAL.
5. THE PREPARATION OF THE PIT IN L & T SCOPE.
6. FREE DRAIN SLOPE REQUIRED.
7. CONDUIT FOR ELECTRICAL WIRING INTERNAL DIAMETER MIN 70MM. (SCOPE – L & T).
8. EN8 STEEL DOWEL ø20/ø25 X 300MM. (SCOPE – NTPL).
9. DOCK LEVELER & ITS MOUNTING FRAME MATERIAL : M.S (IS 2062).
10. ANCHOR BOLTS : CARBON STEEL, ZINC–PLATED. MEP-01
11. TARE WEIGHT OF DOCK LEVELER : approx. 2000 KG.

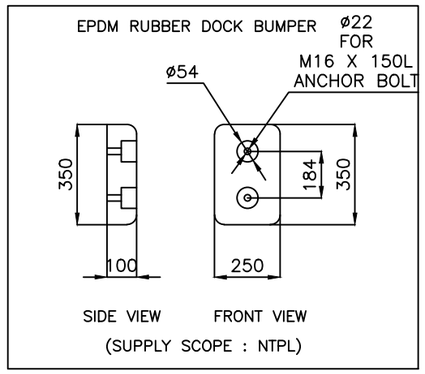

NOTE: –
1. TRENCH AS SHOWN SHOULD BE MADE BY DECIDING THE POWER PACK POSITION(SUPPLY CABLE LENGTH STD. 5000 MM)
2. LEVEL OF THE PIT SHOULD BE PLAIN AND SHOULD TAKE AT LEAST 9000 KGS FLOOR LOADING.
3. MOUNTING ARRANGEMENT FOR BUMPERS SHOULD BE 75 MM FROM PIT WIDTH & MATCH UPPER FACE TO FACTORY FLOOR LEVEL.

MEP-12

PIT DIMENSION	WIDTH (W1)	LENGTH (L1)	DEPTH (D)
	2050	5500	805

Drawing/ Document Category (Submission Purpose)	Drawing/Document Review Status (BY OWNER/PMC)		
	APPROVAL CODE	STATUS	ACTION REQUIRED
☑ For Approval	1	Rejected	Revise and resubmit
☐ For Review	2	Commented as noted	Work may proceed subject to acceptance and incorporation of comments.
☐ For Information	3	Acceptable with minor comments	Incorporate comments, if any. Resubmit as certified final.Work may proceed.
	4	Approved with No comments–FINAL	Work may proceed.
	5	Information Only	Accepted for information only.Work may proceed.

Date: __/__/____ Name : _____

This approval does not absolve the CONTRACTOR from meeting their contractual obligations of delivering a complete safe and efficiently operating unit facilities meeting all requirements of the contract.

REV	PURPOSE	PREPARE	CHKD	APPROVAL	DATE dd/mm/yy
					/ /
					/ /
A2	COMMENTED DRAWING ISSUED FOR APPROVAL	PRADEEP	GAURAV	AMIT	14/04/2020
A1	ISSUED FOR APPROVAL	PRADEEP	GAURAV	AMIT	19/02/2020

PROJECT
ETHYLENE GLYCOL PROJECT
PARADIP REFINERY, ODISHA-INDIA.

OWNER
INDIAN OIL CORPORATION LIMITED
PARADIP REFINERY, ODISHA, INDIA

This Drawing is the Property of INDIAN OIL CORPORATION LTD and is lent without consideration other than the Borrower's agreement that it shall not be reproduced, copied lent or disposed of directly or indirectly, nor used for any purpose other than that for which it is specifically furnished. The apparatus shown in the drawing is covered by patents information contained in this drawing may be proprietary to Indian Oil Corporation Ltd and/or licensors, and is subject to obligations of confidentiality.

PMC
Toyo Engineering India Private Limited
Mumbai, India
TEPL's Job No. 6389
WORK ORDER No. 25574423

LSTK–2
L&T Hydrocarbon Engineering
LSTK–2 Job No. IOCL–O&U
WORK ORDER No. LATER

DETAILED ENGINEERING CENTER: L&T - CHIYODA LIMITED

TITLE
UNIT NO–207D
CIVIL DRAWING FOR DOCK LEVELER

SCALE 1:1
DWG. NO. IPEG–6389–NTPL(1)–8470–43–207D–0001
REV. A2
1/1

L&T - CHIYODA LIMITED

- ☐ REVIEW CODE 1 – REJECTED REVISE & RESUBMIT.
- ☑ REVIEW CODE 2 – COMMENTED AS NOTED. WORK MAY PROCEED SUBJECT TO ACCEPTANCE AND INCORPORATION OF COMMENTS.
- ☐ REVIEW CODE 3 – ACCEPTABLE WITH MINOR COMMENTS INCORPORATE COMMENTS, IF ANY. RESUBMIT AS CERTIFIED FINAL. WORK MAY PROCEED.
- ☐ REVIEW CODE 4 – APPROVED WITH NO COMMENTS – FINAL WORK MAY PROCEED.
- ☐ REVIEW CODE 5 – INFORMATION ONLY ACCEPTED FOR INFORMATION ONLY. WORK MAY PROCEED.

COMMENTED BY	REVIEWED BY	APPROVED BY	DATE
MMR	MMR	PSS	29-04-20

THIS REVIEW / APPROVAL DOES NOT RELIEVE THE VENDOR / MANUFACTURER OF THE FULL RESPONSIBILITY AS TO DESIGN CORRECTNESS OF DIMENSIONS & COMPLIANCE WITHALL APPLICABLE REGULATIONS AND WITH THE REQUIREMENTS MADE IN PURCHASER SPECIFICATIONS.

CAD FILE REF: CFR