DELHI INTERNATIONAL AIRPORT LIMITED
PHASE 3A WORKS
IGI AIRPORT, NEW DELHI

L&T Construction

Transmittal

Date:	21-Dec-2021	Transmittal No:	DIAL/L&T/PHASE 3A/TRANS/12448

Package:	☐ Airside	☐ Landside	☑ **Terminal**	☐ BSF	☐ Utilities	☐ ECT	☐ ENB	☐ IT Works	☐ PRW

Sub Package 1:	PRW	Sub Package 2:	PRW
Sub Package 3:	Engineering	Sub Package 4:	NA

Following are our comments

Please Refer attached DIAL comments.

S. No.	No of Copies	Reference No.	Title	Remarks
1	1	L&T/DIAL/DES/PTB/1089	SHOP DRAWING-MEGADOOR FOR ARFF-04	

Please take necessary action			
☐	For your attention	☐	Per your request
☑	For your file and information	☐	Returned with Thanks
☐	For your comments		
☐	For your aproval		
☑	Please sign and return		

Note: Kindly acknowledge receipt of the above by signing the attached copy of this transmittal letter and returning same to us for files.

	Initiated by	Received by
Agency Name:	**DIAL**	**M/s. L&T Construction**
Name:	**Diksha Singh**	
Designation:	**Executive**	-
Signature:		
Date:	**21-Dec-2021**	

DELHI INDIRA GANDHI INTERNATIONAL AIRPORT | GMR

DELHI INTERNATIONAL AIRPORT LIMITED
PHASE 3A WORKS
IGI AIRPORT, NEW DELHI

L&T Construction

Comment Sheet

Date:	21-Dec-2021	Document No:	

Package:	Airside	Landside	Terminal	ATC Tower	Utilities	ECT	ENB	IT Works	PRW
	☐	☐	☑	☐	☐	☐	☐	☐	☐

Sub Package 1:	PRW	Sub Package 2:	PRW
Sub Package 3:		Sub Package 4:	
Submission Title	SHOP DRAWING-MEGADOOR FOR ARFF-04		
Submission Reference	L&T/DIAL/DES/PTB/1089		
Response Revision No	A		

Mode of Response	Email	Hand	Courier	USB	Others
	☑	☐	☐	☐	☐

	Response Category		Remarks
A	No Comments	☐	
B	**Proceed subject to amendment as noted**	☑	**LEVEL B**
C	Resubmit subject to amendment as noted	☐	
D	Rejected	☐	
E	For information only	☐	

S. No.	Document	Content	Comments
1		General Comments	1.1 The comments on this transmittal must be read in conjunction to the commented drawings sent along with this transmittal. 1.2 Review and confirm Control Panel location w.r.t ARFF Floor Plan. 1.3 Push button has been located on the external side of the Building/ Rolling shutter as per Architecture GFC. Clarify and confirm. 1.4 Review open door section w.r.t PVC Window. 1.5 Provide thickness of PVC Window 1.6 Include colour, thickness and finish of all components 1.7 Details of Hardware Set to be provided. 1.8 Align height of PVC windows of RS6 & RS7. 1.9 Review height of the PVC Window w.r.t Human Eye Level.

Appointment	Name	Signature	Date
PMC Reviewer	Ahmed Safi Ansari		21-Dec-2021
DIAL Reviewer	Deepika		21-Dec-2021
DIAL Reviewer	Kartik Ganapathy		21-Dec-2021
DIAL Reviewer	Harmandeep Ahluwalia		21-Dec-2021
CDO	Sri Rama Murthy Sattiraju		21-Dec-2021

***Note** : Documents reviewed does not relieve L&T of its responsibility under the contract, including responsibility for errors, omissions, discrepancies and non-compliances in the Contractor's Document. L&T is responsible for the completeness, accuracy and constructability of all the Contractor's Documents, including without limitation, the drawings, specifications and material tests in full compliances with all the engineering standards, codes, practices and technical or other specifications, as prescribed under the contract and / or the applicable laws and permitting agencies and authorities requirements.*

L&T Construction

Delhi International Airport Ltd.
Phase 3A Works,
IGI Airport, New Delhi

DELHI INDIRA GANDHI INTERNATIONAL AIRPORT | GMR

SUBMITTAL


Date:	**04-12-2021**	Submittal no.	**L&T/DIAL/DES/PTB/1089**
Ref. Date:	**NA**	Ref. Submittal no.	**NA**

Package:	☐ Airside	☐ Landside	☐ Terminal	☐ PRW	☑ Utilities	☐ ECT	☐ ENB	
Sub Package 1:	PRW			Sub Package 2:	PRW			
Sub Package 3:	-			Sub Package 4:	-			
Submission Title	**SHOP DRAWING-MEGADOOR FOR ARFF-04**							
Submission Mode	☑ **Soft Copy**	☐ **Hard Copy**	☐ DVD/CD	☐ USB	☐ Others			
Submission Type	☑ **Drawing**			☐ Document				
Sample Include	☐ Yes			☑ **No**				
No. of Copies								
Copy As Per Distribution		DIAL-Employer's Representative			To Document Control Library			
Reference Docs(if any)	NA							


Stage	
☐ Preliminary Design	☐ Detail Design
☐ GFC	☐ Construction Drawing
☑ Shop Drawing	☐ As Built Drawing

Submittal Category			
A	For Comments	☐	
B	For Information	☐	
C	For Approval	☑	


Sl. No.	Drawing /Document Number	Rev.	Drawing /Document Title
1	DIAL-LT-Q-UTL-A-10-101	A	ARFF4 MEGADOOR 8760 X 5400 (RS7)
2	DIAL-LT-Q-UTL-A-10-102	A	ARFF4 MEGADOOR 5800 X 5400 (RS6)
3	DIAL-LT-Q-UTL-A-10-103	A	ARFF5 MEGADOOR 5800 X 5360 (RS6)
4	DIAL-LT-Q-UTL-A-10-104	A	ARFF5 MEGADOOR 8760 X 4988 (RS7)
5	DIAL-LT-Q-UTL-A-10-105	A	Control panel locations

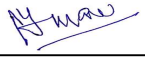	Initiated by			Received by
Agency Name:	**L&T Construction**			
	Prepared By	**Checked by**	**Authorised by**	
Name:	Parveen Chauhan	Brajesh Sharma	Ravi Kadam	
Designation:	Senior Architect	Finishes In-Charge	Chief Project Manager	
Signature:				
Date:	**04-12-2021**	**04-12-2021**	**04-12-2021**	


Sensitivity: LNT Construction Internal Use

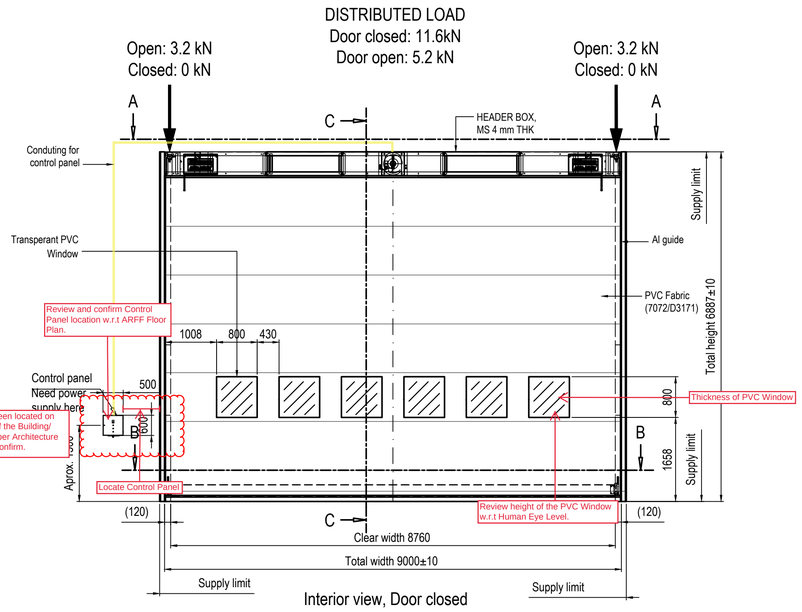

Interior view, Door closed

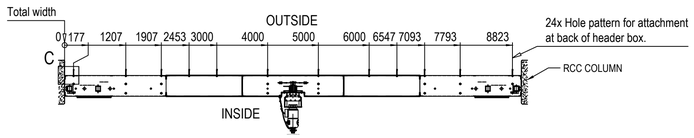


SECTION A-A Scale 1:50

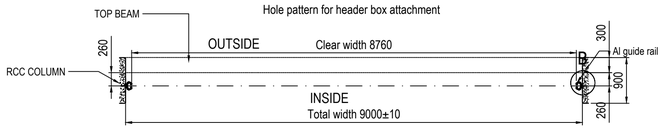


SECTION B-B Scale 1:50

Door leaf is not shown for clarification

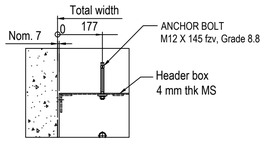


DETAIL C, SCALE (1:5)


ANCHOR POSITION FROM COLUMN

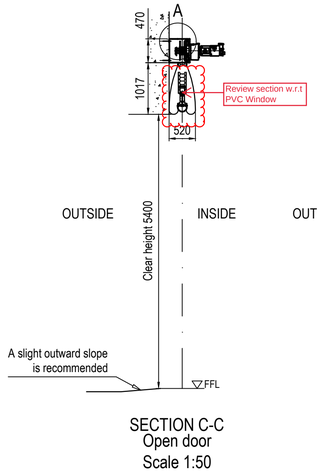


SECTION C-C
Open door
Scale 1:50

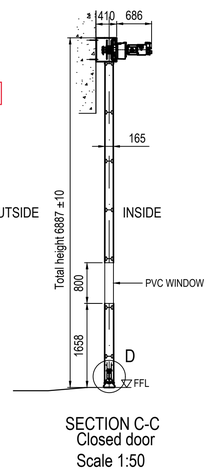


SECTION C-C
Closed door
Scale 1:50

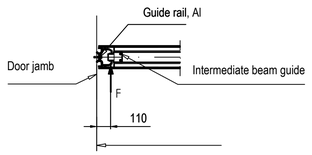

Force by differential pressure transferred to guide rail at each intermediate position.
F=4.7 kN

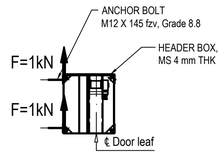

Load on header box attachment (each screw), due to wind load and door weight

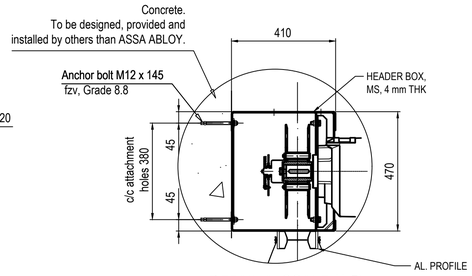


DETAIL B, SCALE (1:5)

GUIDE RAIL MOUNTING DETAILS

DETAIL A, SCALE (1:5)

HEADER BOX MOUNTING DETAILS

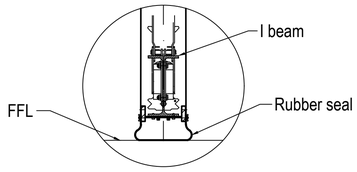

DETAIL D, SCALE (1:5)

BOTTOM PROFILE DETAILS

NOT INCLUDED IN DOOR SUPPLY:

1. Design and supply of all door supporting structural components.
2. Design and supply of all closure between door and adjacent steel.
3. Door jambs adjustable for overall door width and true to plumb.
4. Paint job after completed door installation.
5. Any frameworks being provided by ASSA ABLOY will be clearly indicated as "by ASSA ABLOY".

REQUIREMENTS ON BUILDING:

6. Door head support must be straight within 1/600 of span in the in/out direction and free from protrusions of any kind.
7. For a single door leaf, door head support should be horizontal and straight within 1/600 of span at distributed full door load.
8. Door side jambs must be smooth, straight and parallel, out of plumb must not exceed 2mm/m (total deviation at full length 5 mm) in any direction.
9. Any footings at bottom of jamb columns must not interfere with installation of guide rails at floor level.
10. At time of installation, finished floor, free from obstructions, out to a distance of 2 m on each side of door centreline must be available.
11. Header box must be accessible from both sides during installation.

DOOR PROPERTIES:


12. The door is designed to withstand a differential pressure of 1.15kPa x 1.5 FOS.
13. Guide rails, top- and intermediate beams in extruded aluminium with natural finish.
14. Color of header box: BLACK (NCS 9000-N. RAL 9005)
15. Color of door fabric: Color code of door fabric:Grey RAL 7004 (7072/ D3171) (Approved by DIAL)
16. Metal trim: motor side
17. Hand crank for manual operation.

ELECTRICAL:

18. One main control panel provided of PLC type.
19. Audible and visual alarm
20. Back-up power switch
21. Safety edge
22. Approx. size of main control panel: WxHxD (500mm x 600mmx250 mm),
23. Power: 2.7kW
24. Nom. current: 6.2A
25. (max. allowed voltage drop at start: 5%)
26. Power supply required: 3 Phase, 415 V +/-5%, 50 Hz +/- 3%
27. Cable tray size: 50mm (H) x 100mm (W)
28. Conduiting and cabling from motor to control panel is in NIHVA scope.

BELT HOIST UNITS:

SK 873.1-100L/4 Z dual brake

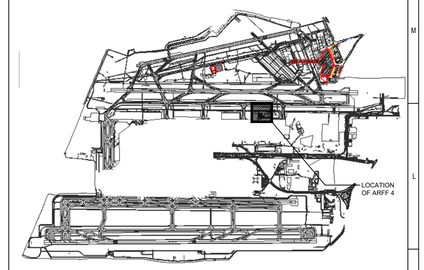

KEY PLAN (NOT TO SCALE)

NOTE:

1. 340 MM RCC COLUMN REQUIRED FOR GUIDE MOUNTING.
   IF RCC COLUMN NOT AVAILABLE THEN WE WILL REQUIRE MS STRUCTURE FOR THE SAME.

Include colour, thickness and finish of all components

Details of Hardware Set to be provided.

REFERENCE DRAWING :

DIAL-LT-D-UTL-A-20-300 : ARFF4 FIRE STATION ELEVATIONS
DIAL-LT-D-UTL-A-20-301 : ARFF4 FIRE STATION ELEVATIONS
DIAL-LT-D-UTL-A-10-300 : ARFF4 FIRE STATION GROUND FLOOR PLAN

SHOP DRAWING

Building: ARFF4

REV.NO.	DESCRIPTION	DESIGNED	DRAWN	CHECKED	APPROVED
A	FOR APPROVAL	25.11.2021 G.I.P	25.11.2021 G.I.P		

REVISIONS

CHECKED BY	SIGN	DATE	CHECKED BY	SIGN	DATE	CHECKED BY	SIGN	DATE
ARCHITECTURE			HVAC			GIS		
CIVIL & STRUCTURAL			FPS			GEOTECH.		
ELECTRICAL			PIPING			AIRPORT SYSTEMS		
ELV SYSTEM			PHE			INTERFACE		

DELHI INDIRA GANDHI INTERNATIONAL AIRPORT GMR L&T Construction

DELHI INTERNATIONAL AIRPORT LIMITED:

PROJECT: INDIRA GANDHI INTERNATIONAL AIRPORT PHASE-3A DEVELOPMENT WORKS

CLIENT :

ASSA ABLOY

CONCEPT :

PROJECT CONSULTING:
Engineering Design and Research Center (EDRC), L&T Construction

INSTALLED AND SUPPLIED BY:
NIHVA TECHNOLOGIES PVT LTD

JOB NO.			
JOB No :	NAME	SIGN	DATE
DSGN	G.I.P		02.10.2021
DRWN	G.I.P		02.10.2021
CHKD			
APPD			

TITLE:

ARFF4 MEGADOOR
8760 X 5400 (RS7)

SCALE 1:50


DRAWING No. DIAL-LT-Q-UTL-A-10-101

SHEET:


PROJECTION FIRST ANGLE

SIZE A1 | REV A

RELEASED FOR ☐ PRELIMINARY ☐ TENDER ☐ INFORMATION ☑ APPROVAL ☐ CONSTRUCTION

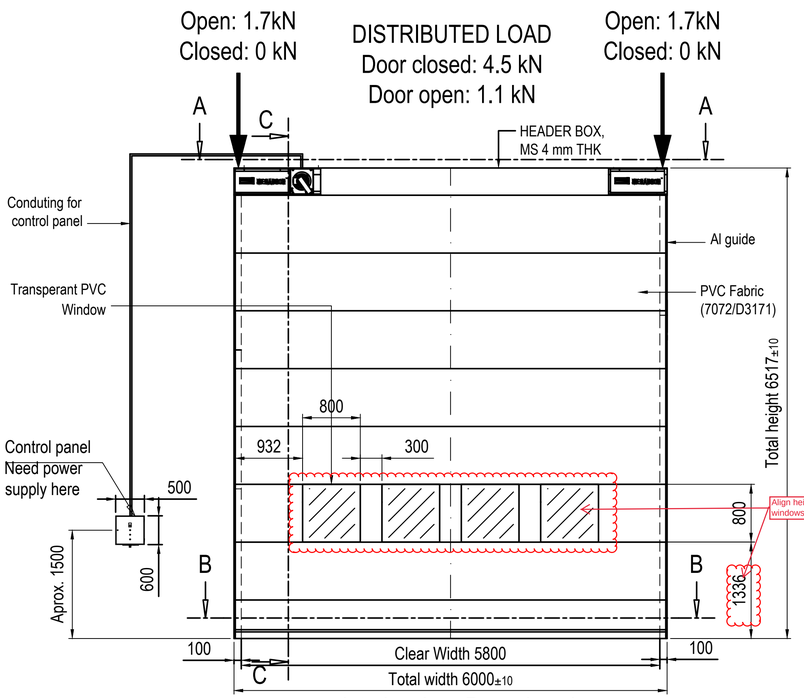


Interior view, Door closed

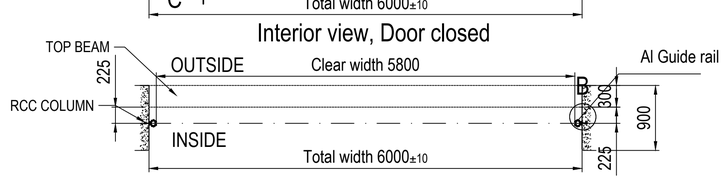


SECTION B-B Scale 1:50

Door leaf is not shown for clarification

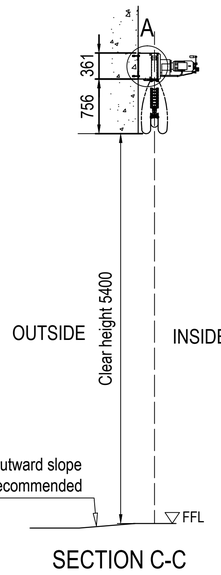

SECTION C-C
Open door
Scale 1:50

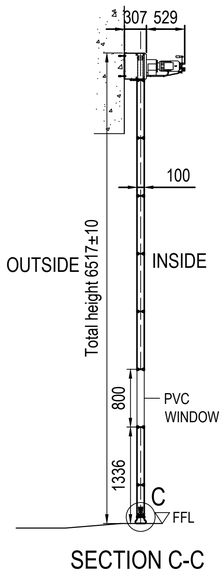

SECTION C-C
Closed door
Scale 1:50

NOT INCLUDED IN DOOR SUPPLY:

1. Design and supply of all door supporting structural components.
2. Design and supply of all closure between door and adjacent steel.
3. Door jambs adjustable for overall door width and true to plumb.
4. Paint job after completed door installation.
5. Any frameworks being provided by ASSA ABLOY will be clearly indicated as "by ASSA ABLOY".

REQUIREMENTS ON BUILDING:

6. Door head support must be straight within 1/600 of span in the in/out direction and free from protrusions of any kind.
7. For a single door leaf, door head support should be horizontal and straight within 1/600 of span at distributed full door load.
8. Door side jambs must be smooth, straight and parallel, out of plumb must not exceed 2mm/m (total deviation at full length 5 mm) in any direction.
9. Any footings at bottom of jamb columns must not interfere with installation of guide rails at floor level.
10. At time of installation, finished floor, free from obstructions, out to a distance of 2 m on each side of door centreline must be available.
11. Header box must be accessible from both sides during installation.

DOOR PROPERTIES:


12. The door is designed to withstand a differential pressure of 1.15kPa x 1.5 FOS.
13. Metal trim: motor side
14. Guide rails, top- and intermediate beams in extruded aluminium with natural finish.
15. Color of header box: BLACK (NCS 9000-N. RAL 9005)
16. Color of door fabric: Color code of door fabric:Grey RAL 7004 (7072/ D3171) (Approved by DIAL)
17. Hand crank for manual operation.

ELECTRICAL:

18. One main control panel provided of PLC type.
19. Audible and visual alarm
20. Safety edge
21. Back-up power switch
22. Approx. size of main control panel: WxHxD (500mm x 600mmx250 mm),
23. Power: 1.4kW
24. Nom. current: 3.2A
25. (max. allowed voltage drop at start: 5%)
26. Power supply required: 3 Phase, 415 V +/-5%, 50 Hz +/- 3%
27. Cable tray size: 50mm (H) x 100mm (W)
28. Conduiting and cabling from motor to control panel is in NIHVA scope.


BELT HOIST UNITS:

Sk 773.1-90S/4 Z dual brake

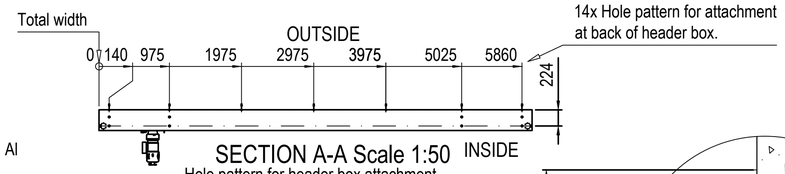


SECTION A-A Scale 1:50


Hole pattern for header box attachment

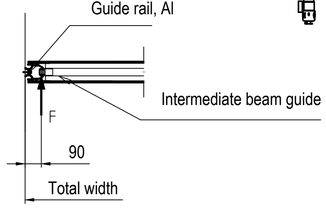

Force by differential pressure transferred to guide rail at each intermediate position.
F= 2.7 kN

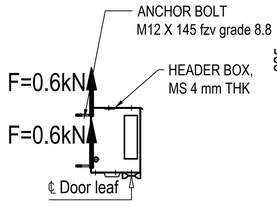


Load on header box attachment (each screw), due to wind load and door weight

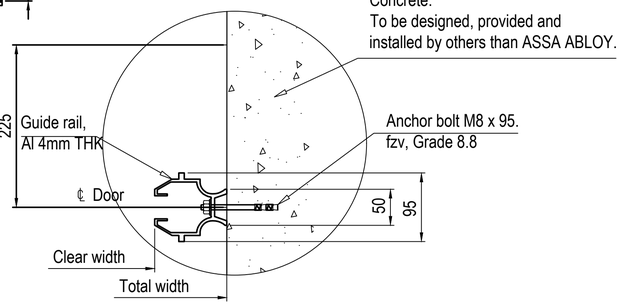


DETAIL B, SCALE (1:10)

GUIDE RAIL MOUNTING DETAILS

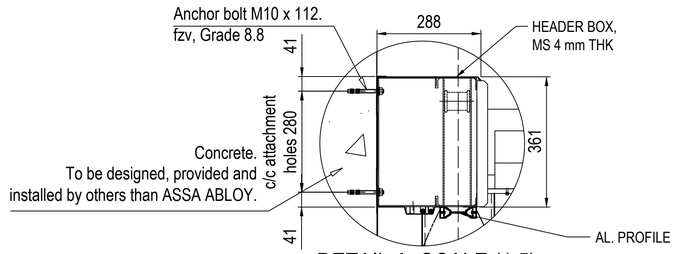

DETAIL A, SCALE (1:5)


HEADER BOX MOUNTING DETAILS

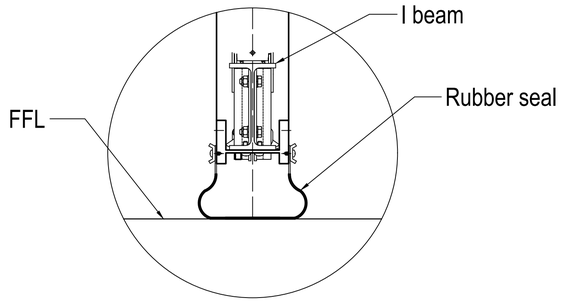

DETAIL C, SCALE (1:10)

BOTTOM PROFILE DETAILS

Refer comments on drawing
DIAL-LT-Q-UTL-A-10-101

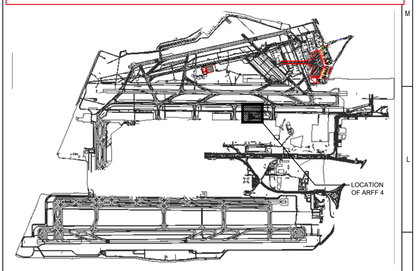

KEY PLAN (NOT TO SCALE)

NOTE:

1. 275 MM RCC COLUMN REQUIRED FOR GUIDE MOUNTING.
   IF RCC COLUMN NOT AVAILABLE THEN WE WILL REQUIRE MS STRUCTURE FOR THE SAME.

REFERENCE DRAWING :

DIAL-LT-D-UTL-A-20-300 : ARFF4 FIRE STATION ELEVATIONS
DIAL-LT-D-UTL-A-20-301 : ARFF4 FIRE STATION ELEVATIONS
DIAL-LT-D-UTL-A-10-300 : ARFF4 FIRE STATION GROUND FLOOR PLAN

SHOP DRAWING

Building: ARFF4

REV.NO.	DESCRIPTION	DESIGNED	DRAWN	CHECKED	APPROVED
A	FOR APPROVAL	25.11.2021 GJP	25.11.2021 GJP		

REVISIONS

CHECKED BY	SIGN	DATE	CHECKED BY	SIGN	DATE	CHECKED BY	SIGN	DATE
ARCHITECTURE			HVAC			GIS		
CIVIL & STRUCTURAL			FPS			GEOTECH.		
ELECTRICAL			PIPING			AIRPORT SYSTEMS		
ELV SYSTEM			PHE			INTERFACE		

CLIENT : DELHI INTERNATIONAL AIRPORT LIMITED.

PROJECT: INDIRA GANDHI INTERNATIONAL AIRPORT PHASE-3A DEVELOPMENT WORKS

CONCEPT : ASSA ABLOY

PROJECT CONSULTING: Engineering Design and Research Center (EDRC), L&T Construction

INSTALLED AND SUPPLIED BY: NIHVA TECHNOLOGIES PVT LTD

JOB No : JOBNO.

	NAME	SIGN	DATE
DSGN	G.J.P		02.10.2021
DRWN	G.J.P		02.10.2021
CHKD			
APPD			

TITLE: ARFF4 MEGADOOR 5800 X 5400 (RS6)

SCALE 1:50


DRAWING No. DIAL-LT-Q-UTL-A-10-102


SHEET:

PROJECTION FIRST ANGLE

SIZE A1 | REV A


RELEASED FOR ☐ PRELIMINARY ☐ TENDER ☐ INFORMATION ☑ APPROVAL ☐ CONSTRUCTION

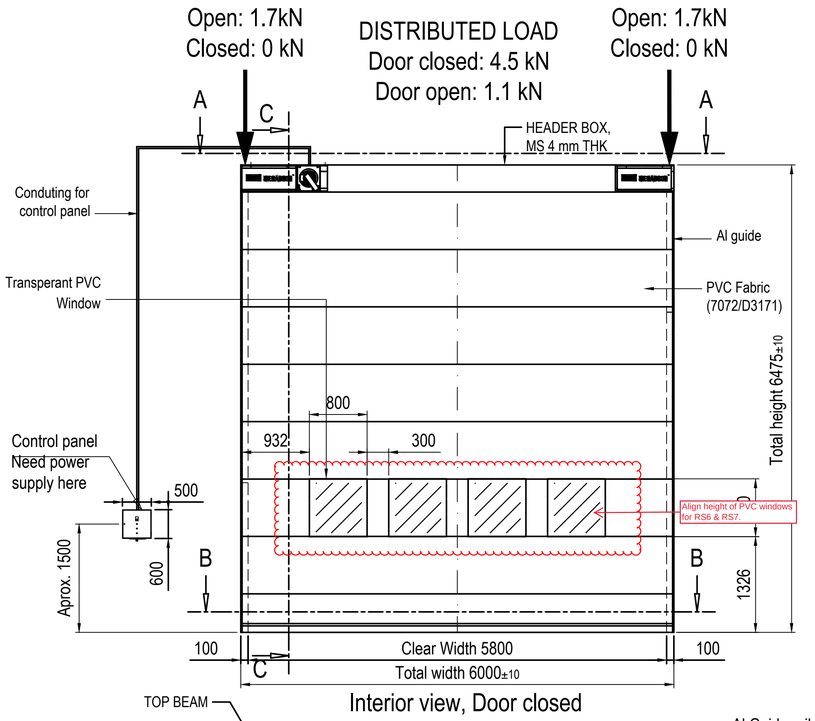

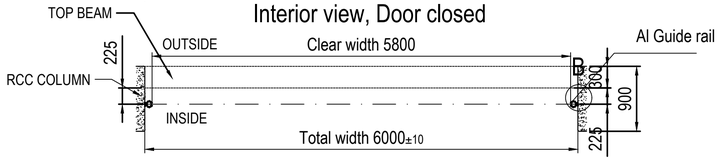


SECTION B-B Scale 1:50

Door leaf is not shown for clarification

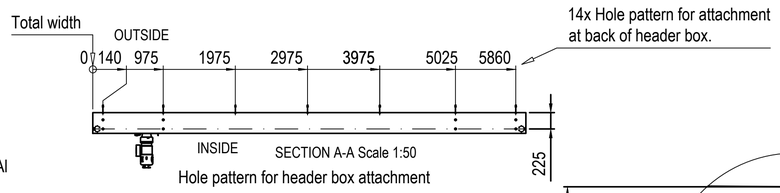


SECTION A-A Scale 1:50


Hole pattern for header box attachment

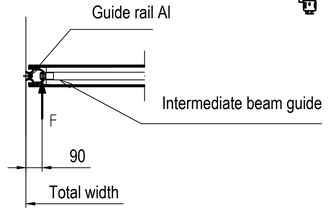

Force by differential pressure transferred to guide rail at each intermediate position.
F= 2.7 kN

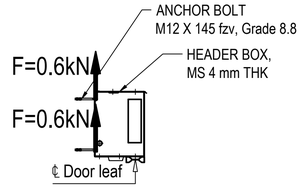


Load on header box attachment (each screw), due to wind load and door weight

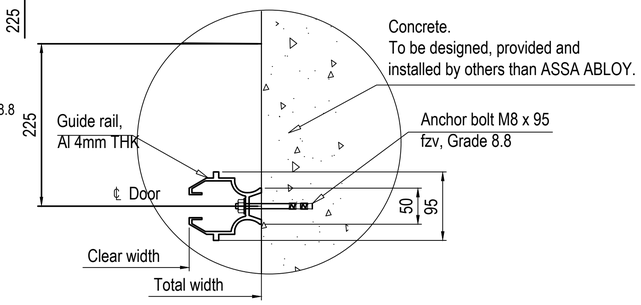

DETAIL B, SCALE (1:10)

GUIDE RAIL MOUNTING DETAILS

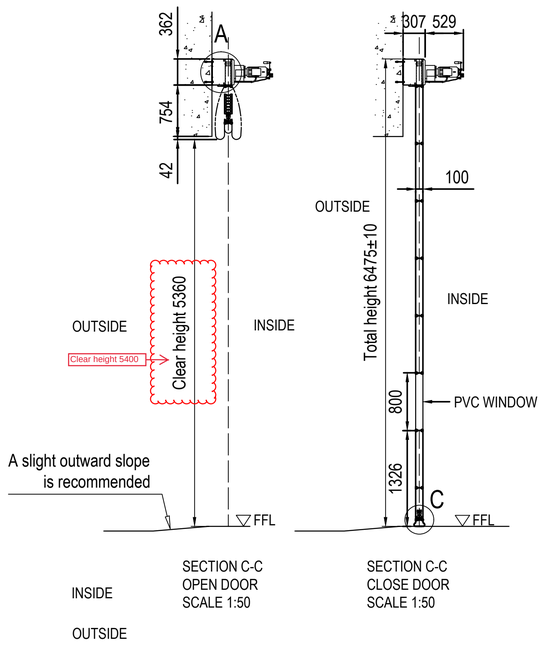

SECTION C-C
OPEN DOOR
SCALE 1:50

SECTION C-C
CLOSE DOOR
SCALE 1:50

NOT INCLUDED IN DOOR SUPPLY:

1. Design and supply of all door supporting structural components.
2. Design and supply of all closure between door and adjacent steel.
3. Door jambs adjustable for overall door width and true to plumb.
4. Paint job after completed door installation.
5. Any frameworks being provided by ASSA ABLOY will be clearly indicated as "by ASSA ABLOY".

REQUIREMENTS ON BUILDING:

6. Door head support must be straight within 1/600 of span in the in/out direction and free from protrusions of any kind.
7. For a single door leaf, door head support should be horizontal and straight within 1/600 of span at distributed full door load.
8. Door side jambs must be smooth, straight and parallel, out of plumb must not exceed 2mm/m (total deviation at full length 5 mm) in any direction.
9. Any footings at bottom of jamb columns must not interfere with installation of guide rails at floor level.
10. At time of installation, finished floor, free from obstructions, out to a distance of 2 m on each side of door centreline must be available.
11. Header box must be accessible from both sides during installation.

DOOR PROPERTIES:


12. The door is designed to withstand a differential pressure of 1.15kPa x 1.5 FOS.
13. Metal trim: motor side
14. Guide rails, top- and intermediate beams in extruded aluminium with natural finish.
15. Color of header box: BLACK (NCS 9000-N. RAL 9005)
16. Color of door fabric: Color code of door fabric: Grey RAL 7004 (7072/ D3171) (Approved by DIAL)
17. Hand crank for manual operation.

ELECTRICAL:

18. One main control panel provided of PLC type.
19. Audible and visual alarm
20. Safety edge
21. Back-up power switch
22. Approx. size of main control panel: WxHxD (500mm x 600mm x 250 mm),
23. Power: 1.4kW
24. Nom. current: 3.2A
25. (max. allowed voltage drop at start: 5%)
26. Power supply required: 3 Phase, 415 V +/-5%, 50 Hz +/- 3%
27. Cable tray size: 50mm (H) x 100mm (W)
28. Conduiting and cabling from motor to control panel is in NIHVA scope.


BELT HOIST UNITS:

Sk 773.1-90S/4 Z dual brake

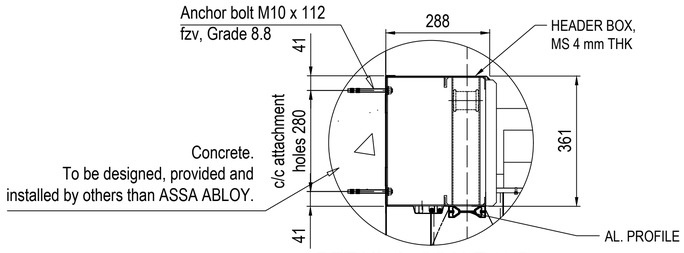

DETAIL A, SCALE (1:5)


HEADER BOX MOUNTING DETAILS

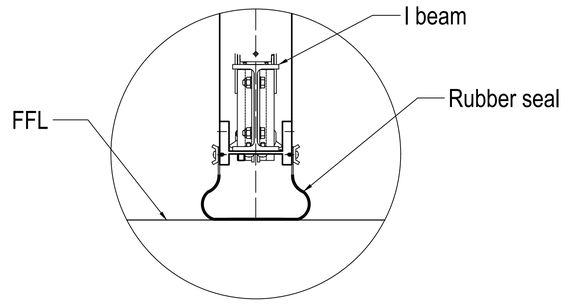

DETAIL C, SCALE (1:10)

BOTTOM PROFILE DETAILS

Refer comments on drawing DIAL-LT-Q-UTL-A-10-101

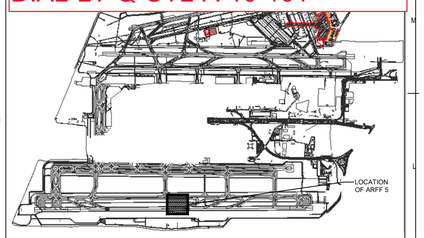

KEY PLAN (NOT TO SCALE)

NOTE:
1. 275 MM RCC COLUMN REQUIRED FOR GUIDE MOUNTING.
IF RCC COLUMN NOT AVAILABLE THEN WE WILL REQUIRE MS STRUCTURE FOR THE SAME.

REFERENCE DRAWINGS :

DIAL-LT-D-UTL-A-20-100 : ARFF4 FIRE STATION ELEVATIONS
DIAL-LT-D-UTL-A-20-101 : ARFF4 FIRE STATION ELEVATIONS
DIAL-LT-D-UTL-A-10-100 : ARFF4 FIRE STATION GROUND FLOOR PLAN

SHOP DRAWING
Building: ARFF5

REV.NO.	DESCRIPTION	DESIGNED	DRAWN	CHECKED	APPROVED
A	FOR APPROVAL	25.11.2021 G.LP	25.11.2021 G.LP		

REVISIONS

CHECKED BY	SIGN	DATE	CHECKED BY	SIGN	DATE	CHECKED BY	SIGN	DATE
ARCHITECTURE			HVAC			GIS		
CIVIL & STRUCTURAL			FPS			GEOTECH.		
ELECTRICAL			PIPING			AIRPORT SYSTEMS		
ELV SYSTEM			PHE			INTERFACE		

DELHI INDIRA GANDHI INTERNATIONAL AIRPORT GMR L&T Construction

CLIENT : DELHI INTERNATIONAL AIRPORT LIMITED

PROJECT: INDIRA GANDHI INTERNATIONAL AIRPORT PHASE-3A DEVELOPMENT WORKS

CONCEPT : ASSA ABLOY

PROJECT CONSULTANT: Engineering Design and Research Center (EDRC), L&T Construction

INSTALLED AND SUPPLIED BY: NIHVA TECHNOLOGIES PVT LTD

JOB No : JOBNO.

	NAME	SIGN	DATE
DSGN	G.LP		02.10.2021
DRWN	G.LP		02.10.2021
CHKD			
APPD			

TITLE: ARFF5 MEGADOOR 5800 X 5360 (RS6)

SCALE 1:50

DRAWING No. DIAL-LT-Q-UTL-A-10-103

PROJECTION FIRST ANGLE


SIZE A1

REV A


SHEET:

RELEASED FOR ☐ PRELIMINARY ☐ TENDER ☐ INFORMATION ☑ APPROVAL ☐ CONSTRUCTION


Refer comments on drawing DIAL-LT-Q-UTL-A-10-101

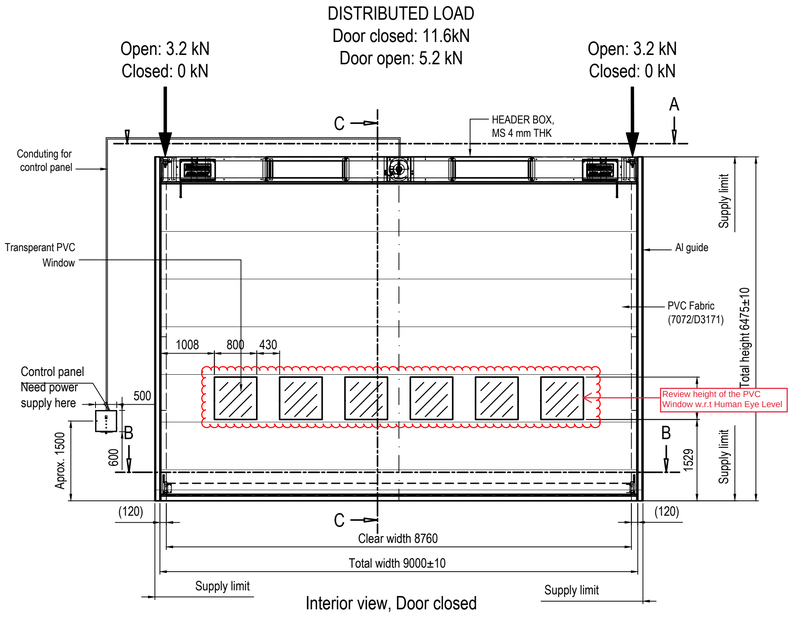

Interior view, Door closed

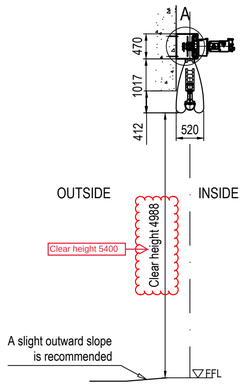

SECTION C-C
Open door
Scale 1 :50

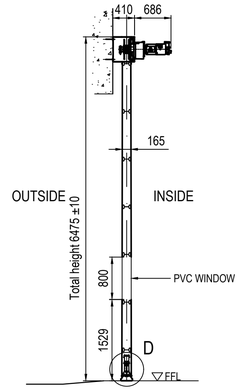

SECTION C-C
Closed door
Scale 1:50

NOT INCLUDED IN DOOR SUPPLY:

1. Design and supply of all door supporting structural components.
2. Design and supply of all closure between door and adjacent steel.
3. Door jambs adjustable for overall door width and true to plumb.
4. Paint job after completed door installation.
5. Any frameworks being provided by ASSA ABLOY will be clearly indicated as "by ASSA ABLOY".

REQUIREMENTS ON BUILDING:

6. Door head support must be straight within 1/600 of span in the in/out direction and free from protrusions of any kind.
7. For a single door leaf, door head support should be horizontal and straight within 1/600 of span at distributed full door load.
8. Door side jambs must be smooth, straight and parallel, out of plumb must not exceed 2mm/m (total deviation at full length 5 mm) in any direction.
9. Any footings at bottom of jamb columns must not interfere with installation of guide rails at floor level.
10. At time of installation, finished floor, free from obstructions, out to a distance of 2 m on each side of door centreline must be available.
11. Header box must be accessible from both sides during installation.


DOOR PROPERTIES:

12. The door is designed to withstand a differential pressure of 1.15kPa x 1.5 FOS.
13. Guide rails, top- and intermediate beams in extruded aluminium with natural finish.
14. Color of header box: BLACK (NCS 9000-N. RAL 9005)
15. Color of door fabric: Color code of door fabric: Grey RAL 7004 (7072/ D3171) (Approved by DIAL)
16. Metal trim: motor side
17. Hand crank for manual operation.


ELECTRICAL:

18. One main control panel provided of PLC type.
19. Audible and visual alarm
20. Back-up power switch
21. Safety edge
22. Approx. size of main control panel: WxHxD (500mm x 600mmx250 mm),
23. Power: 2.7kW
24. Nom. current: 6.2A
25. (max. allowed voltage drop at start: 5%)
26. Power supply required: 3 Phase, 415 V +/-5%, 50 Hz +/- 3%
27. Cable tray size: 50mm (H) x 100mm (W)
28. Conduiting and cabling from motor to control panel is in NIHVA scope.


BELT HOIST UNITS:
SK 873.1-100L/4 Z dual brake

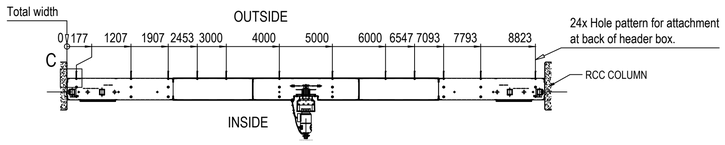


SECTION A-A Scale 1:50
Hole pattern for header box attachment

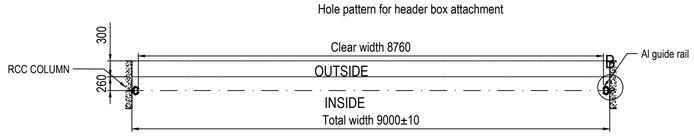


SECTION B-B Scale 1:50
Door leaf is not shown for clarification

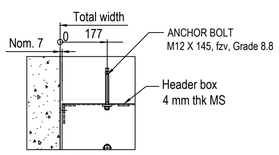

DETAIL C, SCALE (1:5)
ANCHOR POSITION FROM COLUMN

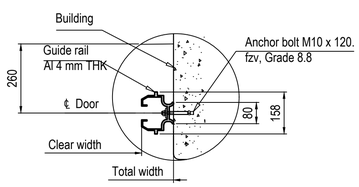


DETAIL B, SCALE (1:5)
GUIDE RAIL MOUNTING DETAILS

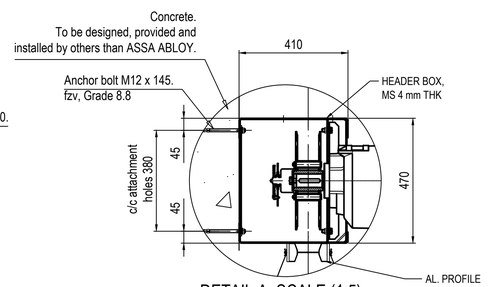


DETAIL A, SCALE (1:5)
HEADER BOX MOUNTING DETAILS




Force by differential pressure transferred to guide rail at each intermediate position.
F=4.7 kN

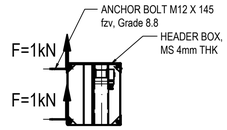

Load on header box attachment (each screw), due to wind load and door weight

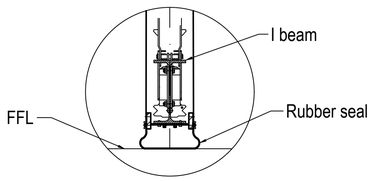

DETAIL D, SCALE (1:5)
BOTTOM PROFILE DETAILS

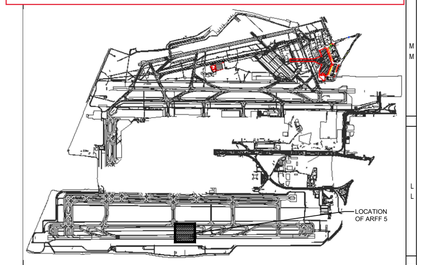

KEY PLAN (NOT TO SCALE)

NOTE:
1. 340 MM RCC COLUMN REQUIRED FOR GUIDE MOUNTING.
IF RCC COLUMN NOT AVAILABLE THEN WE WILL REQUIRE MS STRUCTURE FOR THE SAME.

REFERENCE DRAWINGS :

DIAL-LT-D-UTL-A-20-100 : ARFF4 FIRE STATION ELEVATIONS
DIAL-LT-D-UTL-A-20-101 : ARFF4 FIRE STATION ELEVATIONS
DIAL-LT-D-UTL-A-10-100 : ARFF4 FIRE STATION GROUND FLOOR PLAN

SHOP DRAWING
Building: ARFF5

REV.NO.	DESCRIPTION	DESIGNED	DRAWN	CHECKED	APPROVED
A	FOR APPROVAL	25.11.2021 G.J.P	25.11.2021 G.J.P		

REVISIONS

CHECKED BY	SIGN	DATE	CHECKED BY	SIGN	DATE	CHECKED BY	SIGN	DATE
ARCHITECTURE			HVAC			GIS		
CIVIL & STRUCTURAL			FPS			GEOTECH.		
ELECTRICAL			PIPING			AIRPORT SYSTEMS		
ELV SYSTEM			PHE			INTERFACE		

CLIENT : DELHI INTERNATIONAL AIRPORT LIMITED.
PROJECT: INDIRA GANDHI INTERNATIONAL AIRPORT PHASE-3A DEVELOPMENT WORKS
CONCEPT : ASSA ABLOY
PROJECT CONSULTING: Engineering Design and Research Center (EDRC), L&T Construction
INSTALLED AND SUPPLIED BY: NIHVA TECHNOLOGIES PVT LTD

JOB No : JOBNO.

	NAME	SIGN	DATE
DSGN	G.J.P		02.10.2021
DRWN	G.J.P		02.10.2021
CHKD			
APPD			

TITLE: ARFF5 MEGADOOR 8760 X 4988 (RS7)
SCALE 1:50
DRAWING No. DIAL-LT-Q-UTL-A-10-104
SHEET:
PROJECTION FIRST ANGLE
SIZE A1
REV A

RELEASED FOR ☐ PRELIMINARY ☐ TENDER ☐ INFORMATION ☑ APPROVAL ☐ CONSTRUCTION