
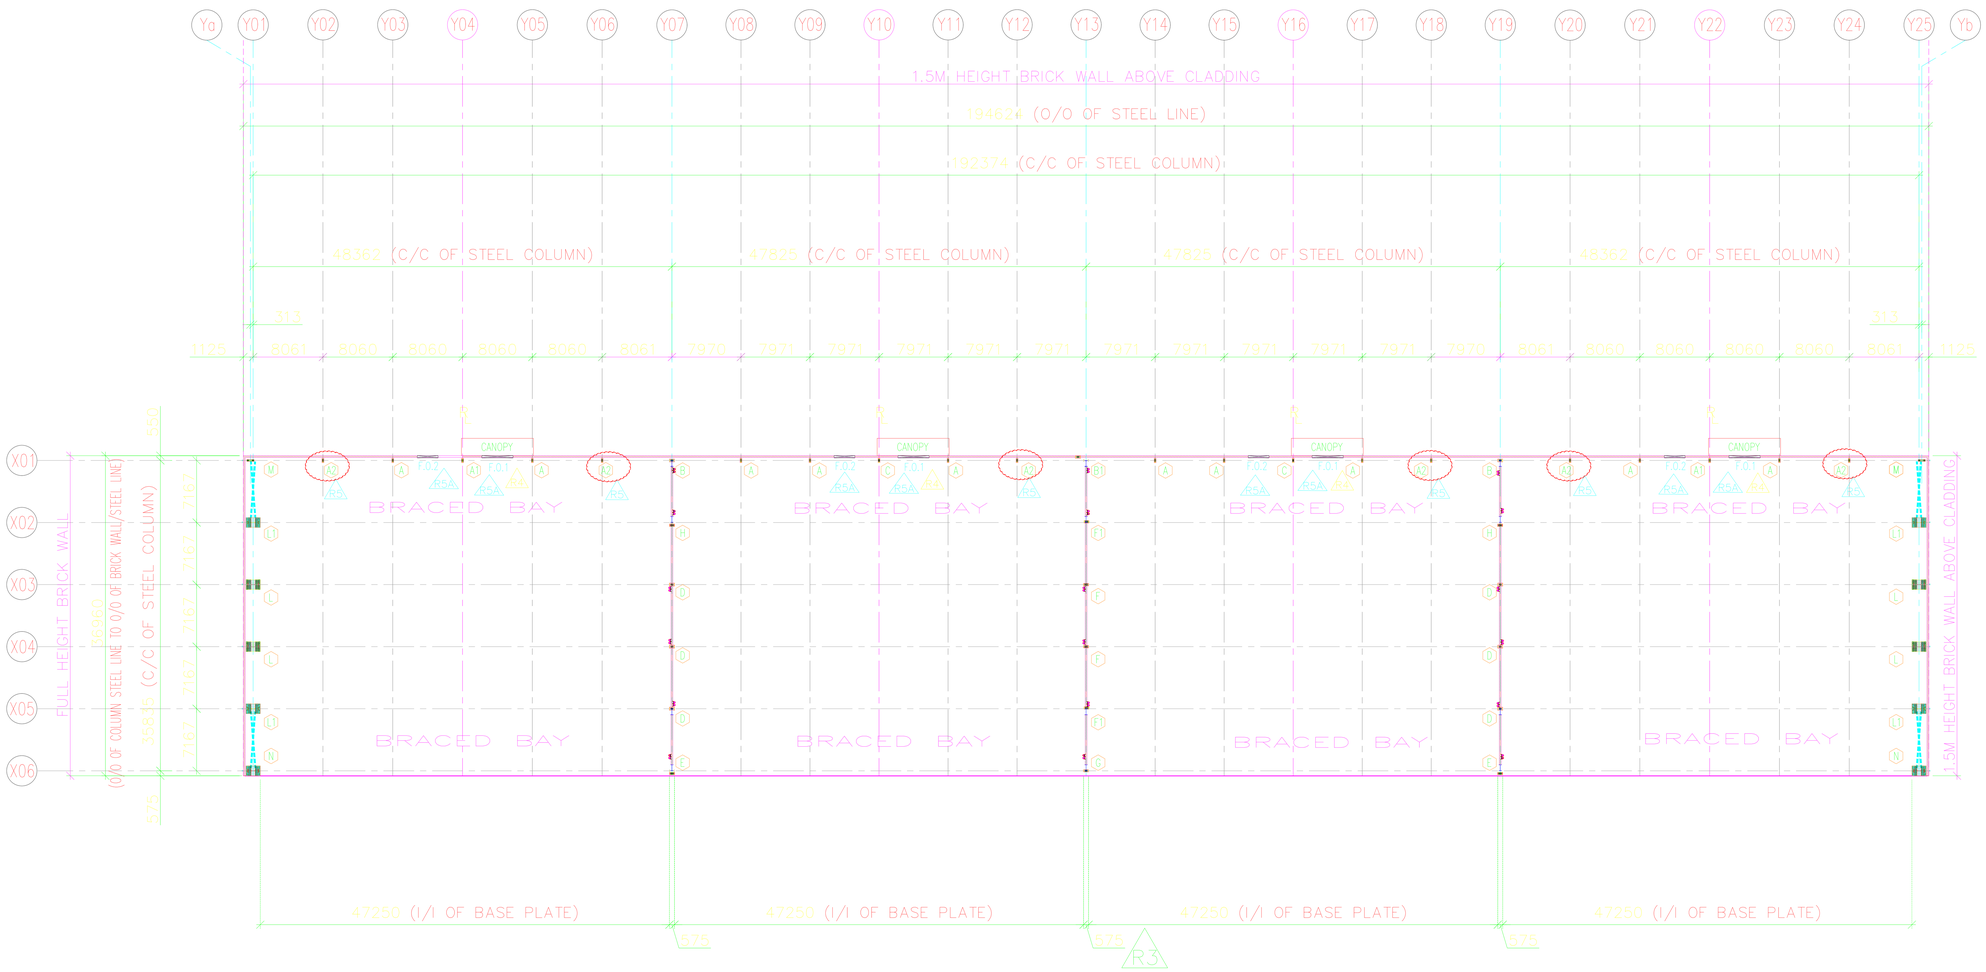


NOTE:- SCHEDULED OPENINGS IN BRICK WALL ARE NOT IN E/L SCOPE. HENCE IT IS NOT SHOWN IN THE PLAN.

COLUMN LAYOUT & DOWNTAKE PLAN

COLUMN BASE ELEVATION AS PER BASE PLATE DETAILS. R2

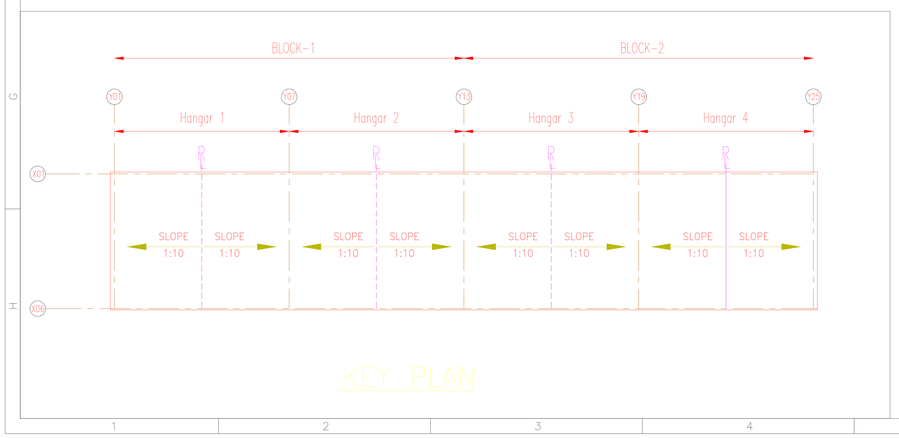

R5A R4

SCHEDULE FOR OPENING

S.No.		WIDTH	HEIGHT	No. OF QTY.
1.	F.O.1	3600	3600	4
2.	F.O.2	2400	2400	4
3.	F.O.3(SMOKE EXTRACTOR)	900	900	16

LEGENDS:-

- CROSS BRACING
- FULL HEIGHT PORTAL

NOTES:-

1. All dimensions are in mm & All levels are in Mtr. [u.n.o]
2. Only written dimensions shall be followed and drawings shall not be Scaled for obtaining any dimensions.
3. The slab or plinth beam should be level to within 5 mm tolerance. Anchor bolts should be set accurately under supervision of M/S Everest Industries Limited and held in position by template before casting to the given dimensions and projection , with maximum deviation of 5mm.Anchor bolt threads should be protected during concreting operation or thoroughly cleaned after pouring. All templates should be removed after the anchor bolts are set in concrete to full strength.
4. All anchor bolt diameters are in millimetres. Anchor bolt projection must be according to design and threads to be clean.
5. The installation of Anchor Bolts and embedded items must be done in accordance with the Code of Standard Practice for Steel Buildings of AISC Section 7. Anchor Bolts and Foundation Bolts shall be set for maximum allowable tolerances as follows :
   a) 3 mm center to center of any two bolts within an Anchor Bolt group.
   b) 6 mm center to center of adjacent Anchor Bolt groups.
   c) Elevation of the top of Anchor Bolts +/- 12 mm.
   d) Maximum accumulation of 6 mm per 30 mtrs. along the established column line of multiple anchor bolt groups but not to exceed a totall of 25 mm.
   e) 6 mm from the center of any anchor bolt group to the established column line through that group.
6. The tolerances of paragraphs b, c, and d apply to offset dimensions shown on the plans parallel and perpendicular to the nearest established column line for individual column shown on the plans to be offset from established column line.
7. Anchor bolts shall be set perpendicular to the theoretical bearing surface unless shown otherwise.
8. Anchor bolts are as per IS:2062,ASTM A1554 or equivalent. FY=240MPa,black steel.

IMPORTANT NOTES:

1. ANCHOR BOLT LOCATIONS HAVE TO BE VERIFIED & CERTIFIED BY COMPETENT AUTHORITY OF M/s EVEREST STEEL BUILDING SOLUTION FOR ACCURACY AT SITE.
2. LEVELS AS MARKED IN DETAILS TO BE CONFIRMED BY CLIENT/CONSULTANT & TO BE CROSS-CHECKED AT SITE BEFORE ERECTION.
3. GRADE OF CONCRETE SHALL BE OF MINIMUM M25 U.N.O.
4. SIZES OF THE PEDESTAL SHOULD BE 50mm MORE ON EITHER SIDE OF DIMENSION OF BASE PLATE.

ISSUED FOR APPROVAL

SENT ON .....

IN ORDER TO SCHEDULE THIS PROJECT IN THE MOST EFFICIENT MANNER, RETURN THESE DOCUMENTS, MARKED WITH YOUR COMMENTS, WITHIN TWO WEEKS FROM THE ABOVE MENTIONED DATE.

ANY CHANGES MADE AFTER APPROVAL OF THESE DRAWINGS MAY DELAY THE FABRICATION AND DELIVERY PROCESS.

THESE DRAWINGS ARE NOT FOR CONSTRUCTION.

1. ☐ APPROVED
   NO CHANGES. PROCEED WITH FABRICATION.
2. ☐ APPROVED AS NOTED
   FABRICATION MAY PROCEED ON THE BASIS OF CORRECTIONS INDICATED.
3. ☐ NOT APPROVED, RE-SUBMIT FOR APPROVAL.

GOOD FOR RECORDS

REVIEWED BY .....
NAME
SIGNATURE DATE

Rev.	Description	Name	Checked	Date
R3	GOOD FOR RECORDS	P.B/B.R	A.A/U.S.	26/05/2023
R2	ISSUED FOR APPROVAL	VAIBHAV	A.A/U.S.	30/03/2023

REVISIONS

Project: Pre Engineering Building At GMR-DELHI INTERNATIONAL AIRPORT LTD., NEW DELHI

Client: GMR-DELHI INTERNATIONAL AIRPORT LTD. NEW DELHI

Process Consultant:

Detailed Engineering Consultant:

Building: CA PARKING

Drawing Title: COLUMN LAYOUT PLAN

everest Everest Industries Limited
ESBS Division, Level 3, Tower 14, Solitaire Corporate Park, Chakala, Andheri (E) Mumbai-400093, India.
Website : www.everestind.com

Drawn by:	VAIBHAV	Scale:	N.T.S.	Date:	30/03/2023
Checked by:	A.A/U.S.	Project No:		Drawing No:	Revision:
Design By:	A.A.	ESBS/PB-02434:01.01.01		GA-018	R2

NOTE:-
1. All rights reserved. This drawing contains proprietary information which is protected by copyright. No part of this drawing may be reproduced, translated in computer language, or transmitted in any form whatsoever without the prior written consent of EVEREST INDUSTRIES LIMITED.

SHEET SIZE-A3