DWG.NO.	TITLE	DATE	REV.
IN-01	INDEX SHEET	17.09.25	R2
IN-02	GENERAL NOTES	17.09.25	R2
GA-01	FLOOR PLAN	17.09.25	R2
GA-02	ROOF BRACING PLAN	17.09.25	R2
GA-03	ROOF FRAMING PLAN	17.09.25	R2
GA-04	ROOF SHEETING PLAN	17.09.25	R2
GA-05	FRAME CROSS SECTION @ GL-1 & 1'	17.09.25	R2
GA-06	FRAME CROSS SECTION @ GL-2 TO 7	17.09.25	R2
GA-07	SIDE WALL BRACING ELEVATION	17.09.25	R2
GA-08	SIDE WALL FRAMING ELEVATION	17.09.25	R2
GA-09	SIDE WALL SHEETING ELEVATION	17.09.25	R2
GA-10	END WALL FRAMING ELEVATION @ GL-1 & 7	17.09.25	R2
GA-11	END WALL SHEETING ELEVATION @ GL-1&7	17.09.25	R2
GA-11A	4.824M LEVEL BRACING PLAN	17.09.25	R2
GA-12	CRANE BEAM PLAN	17.09.25	R2
GA-13	CRANE BEAM DETAILS	17.09.25	R2
GA-14	CAGE LADDER-1 FOR ROOF ACCESS	17.09.25	R2
GA-15	CAGE LADDER-2 FOR CRANE ACCESS	17.09.25	R2
GA-16	DETAILS-1	17.09.25	R2
GA-17	DETAILS-2	17.09.25	R2
GA-18	DETAILS-3	17.09.25	R2
GA-19	DETAILS-4	17.09.25	R2

*M/s Arcedges is solely responsible for correctness, structural stability of the building.
M/s Arcedges to incorporate all the comments mentioned in the GAD.

adani

Punit Chandnani — Digitally signed by Punit Chandnani Date: 2025.09.19 20:39:22 +05'30'

Dinesh Purohit — Digitally signed by Dinesh Purohit Date: 2025.09.19 20:17:55 +05'30'

Approver

Categories:

- ☐ **Cat-I** Approved. Good for Manufacturing/Construction/Fabrication
- ☑ **Cat-I*** Approved with minor comments. No resubmission is required. To be incorporated in As-Built. Good for Manufacturing/ Construction/ Fabrication subject to incorporation of comments.
- ☐ **Cat-II** Approved. Released for Manufacturing/fabrication/construction subjected to incorporation of comments. Modification as Noted. Resubmission is required.
- ☐ **Cat-III** Not Approved
- ☐ **Cat-IV** For Information & Records

Note: "Approval of this document does not absolve the Contractor/ Supplier/ Fabricator from fulfilling Contractual obligations in any way"

ARC EDGES

Towards future

DRAWING CROSS REFERENCE

DRG.NO.	REV	DESCRIPTION
IN-01	R2	INDEX SHEET

ISSUED FOR APPROVAL

SENT ON .....

IN ORDER TO SCHEDULE THIS PROJECT IN THE MOST EFFICIENT MANNER, RETURN THESE DOCUMENTS, MARKED WITH YOUR COMMENTS, WITHIN TWO WEEKS FROM THE ABOVE MENTIONED DATE

ANY CHANGES MADE AFTER APPROVAL OF THESE DRAWINGS MAY DELAY THE FABRICATION AND DELIVERY PROCESS.

THESE DRAWINGS ARE NOT FOR CONSTRUCTION.

1. ☐ APPROVED
   NO CHANGES. PROCEED WITH FABRICATION.
2. ☐ APPROVED AS NOTED
   FABRICATION MAY PROCEED ON THE BASIS OF CORRECTIONS INCORPORATED. RESUBMIT AFTER INCORPORATING THE COMMENTS FOR RECORD.
3. ☐ RESUBMIT AFTER INCORPORATING THE COMMENTS FOR REAPPROVAL.

REVIEWED BY .....

NAME

..... SIGNATURE ..... DATE

REV	REVISIONS	DRAWN	DESIGN	DATE
R2	ISSUED FOR RE-APPROVAL	SR	URVISH	17.09.25
R1	ISSUED FOR RE-APPROVAL	SAT/SR	URVISH	20.08.25
R0	ISSUED FOR APPROVAL	SAT/SR	URVISH	25.07.25

Project:
ADANI DEFENCE & AEROSPACE HYDERABAD

Building:
HELICOPTER COMPLEX (PEB-9)

Drawing Title:
INDEX SHEET

Architect/Consultant:
M/S ADANI LTD

Client:
M/S ADANI LTD

ARC EDGES
ARCEDGES BUILDING (INDIA) LLP.
Corporate Office:
505-506, Aamarakunj Avis, Near Tapovan Circle, Chandkheda, Ahmedabad-382424

Drawn by:	SR		Scale: N.T.S.	Date: 17.09.25	
Checked by:	MMK		Project No: J-388-B2	Drawing No: IN-01	Revision: R2
Designed by:	URVISH				
Checked by:	PAD				
Approved by:	ARH				

GENERAL NOTES

1. All dimensions are in mm unless noted otherwise.
2. All design units are in KN and meter.
3. Design Codes and Specifications :
   - i. DESIGN CODE : IS:800-2007(LSD) WITH CHP-12
   - ii. WIND CODE : IS:875(Part 3)-2015
   - iii. SERVICEABILITY: IS:800-2007(LSD)
   - iv. WIND APPLICATIONS : IS 875-2015 (PART-3)
   - v. SEISMIC ZONE : II
   - vi. STAAD.PRO : STAAD PRO : CONNECT EDITION (V22.08.00.175)
4. Loads :
   - i. DEAD LOAD ON FRAME : 0.2 KN/SQ.M.+ Self. Wt.
   - ii. LIVE LOAD ON FRAME: 0.75 KN/SQ.M.
   - iii. COLLETRAL LOAD ON RAFTER & PURLIN : 0.30 KN/SQ.M (ON ROOF)
   - iv. WIND SPEED : 44 M/SEC.
   - v. SOLAR PANEL LOAD : 0.3 KN/SQ.M.
   - vi. HVLS FAN LOAD ON PURLIN : 100 Kg(POINT LOAD ON EACH PURLIN)
   - vii. HVLS FAN LOAD ON RAFTER : 1000 Kg(POINT LOAD AT THE CENTER OF SNAP @ RIDGE)
5. General Specifications :
   - i. ANCHOR BOLTS :
     - b. Anchor bolts will be black unpainted.
   - ii. PRIMARY MEMBERS :
     - a. Built up members are made from hot rolled plates conforming to ASTM A572 Grade 50/IS2062 E350 or equivalent with a minimum yield strength of 350N/Sq.mm (MPa).
     - b. Continuous machine submerged arc weldings (S.A.W) meets the applicable requirements of American Welding Society,
     - c. Web to flange welds are DOUBLE SIDE fillet welds in accordance with the 9th edition of AISC table, J2.4
     - d. Web-Butt welds are complete penetration using flux back-up (upto 16mm plate Max.)
     - e. Color code : 1) ONE COAT OF PRIMER - ZINC SILICATE PRIMER 75 MICRON DFT; 2) TWO INTERMEDIATE COAT OF HIGH BUILD EPOXY M10 COAT (2 X 75 MICRON DFT)

     Finish Code : FINAL COAT OF ALL PHATIC ACRYLIC POLYURETHANE (50 MICRON DFT)
   - iii. SECONDARY MEMBERS :
     - a. All secondary members are cold formed sections like Z and C conforming to ASTM A653M, Gr-50/ BIS277 GP350 or equivalent. with a minimum yield strength of 350N/Sq.mm (MPa). if they are black shall conforming to ASTM A568 Gr-50.
     - b. Color code : PRE GALVANIZED-275 GSM


     Finish Code : PLAIN
   - iv. BRACING AND ANGLES :
     - a. All bracing rods conforming to ASTM A36M Gr.36/IS:2062 or equivalent) with a minimum yield strength of 250N/Sq.mm (MPa)
     - b. All bracing angles conforming to IS:2062, Grade-A or euivalent with a minimum yield strength of 250N/Sq.mm (MPa)
     - c. All Flage braces & Sag Angle sections conforming to ASTM A36M Gr.36/IS:2062 with a minimum yield strength of 250N/Sq.mm (MPa)
     - d. All Square & Round Tube sections confirming to IS 1239 Part 1 & IS 1161 for Round pipe, IS 4923 for square pipe with a minimum yield strength of **310** N/sq.mm (Mpa)
   - v. ROOF, WALL SHEET AND FLASHINGS:
     - a. The yield strength of all panels and flashings is 345/550 MPa. and shall conform to ASTM A792M Grade-B/ BIS 15961/15965, AZ150.
     - b. Roof sheet Color code : 30 MM THICK COMPOSITE SANDWICH PANEL

     Roof monitor roof&wall sheet color Code : NA

     Wall sheet color Code : 50mm thk. SANDWICH PANEL COLOR GALVALUME

     Flashings & TRIMS color Code : COLOR GALVALUME

     Gutter/Down spouts color : COLOR GALVALUME
   - vi. FASTENERS :
     - a. Mild Steel Machine Bolts (MSB) with HDG are Gr 4.6 IS1367 type1.Zinc Plated (10 Microns)
     - b. High Strength Bolts (HSB) with HDG are 10 Microns Yellow Passivation and are identifiable by marks on bolt head and are conforming to IS 1363 / IS 1364 (Grade-8.8).
6. Tolerances :
   - a. Fabrication tolerances shall confirm to requirements of IS : 7215-1974-Reaffirmed in 1995.
   - b. Erection Tolerances shall confirm to requirements of IS : 12843-1989-Reaffirmed in 1995 .
   - c. Cutting tolerance shall be as follows: For members connected at both ends + or -1 mm. Elsewhere + or -1 mm.
7. Anchor Bolt Setting :
   - a. All anchor bolt diameters are in mm, Anchor bolt projection must be according to design and threads to be clean.
   - b. Anchor bolt shall be set perpendicular to the theoretical bearing surface unless noted otherwise.
   - c. The installation of Anchor bolts and embedded items must be done in accordance with the code of standard practice for steel buildings of AISC section 7.
   - d. Anchor bolts and foundation bolts shall be set by the owner or(his Civil contractor) in accordance with Arcedges "ISSUE FOR CONSTRUCTION ANCHOR BOLT PLAN".
   - e. Arcedges assumes no responsibility or liability for the column foundations, slab design for construction. Foundations should be designed as a minimum for the given reaction load.
   - f. Bracing reactions are to be considered with the main frame reactions.
   - g. The slab or edge beam should be square and level to within 5mm tolerance. Anchor bolt threads should be projected during concreting operation and thoroughly cleaned after pouring.
   - h. Arcedges will assume minimum grade of concrete as M25 for pedestals.
   - i. Before commencing the erection of the building the erector must read Arcedges erection manual.
8. Roof / Wall Bracing & Secondaries :
   - a. Bracing is to be installed as per the erection drawings and must remain tight during the life time of building. Do not remove any bracing without prior written consent of Arcedges.
   - b. Placing permanent bracing and temporarily guying the structure during erection prior to placing sheeting is extremely important. The removal of permanent bracing and/or providing the insufficient temporary guy lines may cause the collapse of the building during or after erection which will be contractor's responsibility.
   - c. Start erection at Braced bay.
   - d. Use temporary guy wires and ratchet pullers for stability.
   - e. Install permanent bracing i.e., cables, rods, angles and flange braces.
   - f. Guy wires should be attached to an immovable object such as cast in anchor bolts or heavy object.
   - g. Plumb and align the first bay before proceeding.
   - h. Use High strength bolts where indicated and tighten all bolts after final alignment of the building.
   - i. Use temporary supports to align girts before fixing sheets and do not apply any live loads to purlins before roof sheeting is completed.
   - j. For aesthetic reasons, it is preferable to install flange braces at the same of the column/rafter. The side chosen depending on erection sequence when they are required on single side only.
9. Sheeting, Trims & Flashings :
   - a. Panels are to be field cut to suit openings.
   - b. Bead mastic shall be placed carefully over the panel profile to avoid stretching.
   - c. Trims are provided in Arcedges standard lengths. Trims quantities are provided to cover the whole length of the building using 76mm end laps (refer respective details). If lap length exceeds 76mm during erection, then shortage of length may result. If the lap length is reduced then leakage and appearance problems may result. Always cut any excess trim length at the end of the trim line.
   - d. Downspouts can be relocated at site, if required to avoid at wall accessories.
10. Mezzanine :
    - a. This Mezzanine designed for :
      - i. DEAD LOAD : NA
      - ii. LIVE LOAD : NA
      - iii. COLLATERAL LOAD : a)50 MM THICK FLOOR FINISH NA; b)SERVICES & FALSE CILEING NA; c)SUNK FILLING NA
      - iv. FALSE CEILING LOAD : NA
    - b. The design of the concrete slab and steel reinforcement or wire mesh placed in concrete is not the responsibility of Arcedges and must be designed by a qualified civil engineer in accordance with the correct concrete compressive strength using recognised building codes.
    - c. The concrete slab (Not by Arcedges) should be designed to carry the dead load, the full live load and any additional floor finishes loads depending upon the deck.
    - d. The mezzanine deck panels are designed to carry only the weight of concrete thickness and construction live loads.
    - e. Concentrated loads, due to storage of materials and heaping of concrete during casting should be avoided.
    - f. Small openings in the mezzanine slab (not by Arcedges) between steel joists can be made without affecting the steel mezzanine framing. Proper reinforcement around the opening should be provided in the slab by the Civil Contractor.
    - g. Depth of concrete including deck sheet is NA
    - h. Yield strength of all deck panels shall be 350MPa and made of Galvanized material.NA.mm deep with.NA.mm thickness conforming to ASTM A653M / BIS277 GP250.
10. Crane : (1)
    - i. Crane Capacity : #1-2 MT
    - ii. Crane Weight : 10.42 MT
    - iii. Crab Weight : 0.75 MT
    - iv. Wheel Base : 4 M
    - v. Wheel Load : 5.15 MT
    - vi. Crane Head Room : 1.079 M
    - vii. Hook End Approach : 2.3 M
11) Walkway considered with one side hand rail
    - i.WALK WAY LOADS : 150 KG/M²
12) 6mm thk. chequered pl. considered for crane walkway.
12. Important Erection Notes :
    - a. The building must be erected according to the erection drawings and safe erection practices.
    - b. If Arcedges is not erecting this building, then the erector must read the erection manual before starting the erection. For any technical assistance contact Arcedges customer service manager.

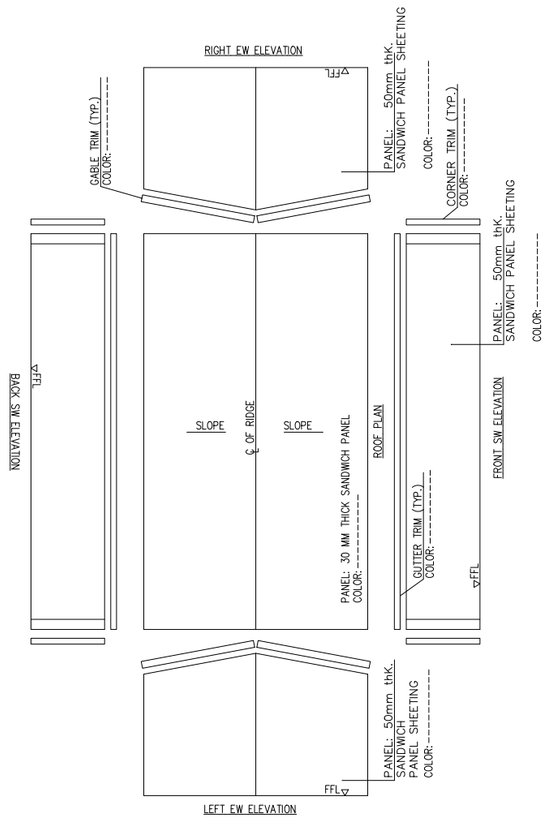

REV	REVISIONS	DRAWN	DESIGN	DATE
R2	ISSUED FOR RE-APPROVAL	SR	URVISH	17.09.25
R1	ISSUED FOR RE-APPROVAL	SAT/SR	URVISH	20.08.25
R0	ISSUED FOR APPROVAL	SAT/SR	URVISH	25.07.25

DRAWING CROSS REFERENCE

DRG.NO.	REV	DESCRIPTION
IN-02	R2	GENERAL NOTES

ISSUED FOR APPROVAL

SENT ON .....

IN ORDER TO SCHEDULE THIS PROJECT IN THE MOST EFFICIENT MANNER, RETURN THESE DOCUMENTS, MARKED WITH YOUR COMMENTS, WITHIN TWO WEEKS FROM THE ABOVE MENTIONED DATE.
ANY CHANGES MADE AFTER APPROVAL OF THESE DRAWINGS MAY DELAY THE FABRICATION AND DELIVERY PROCESS.

THESE DRAWINGS ARE NOT FOR CONSTRUCTION.

1. ☐ APPROVED
   NO CHANGES. PROCEED WITH FABRICATION.
2. ☐ APPROVED AS NOTED
   FABRICATION MAY PROCEED ON THE BASIS OF CORRECTIONS INDICATED. AFTER INCORPORATING THE COMMENTS FOR RECORD.
3. ☐ RESUBMIT AFTER INCORPORATING THE COMMENTS FOR REAPPROVAL.

REVIEWED BY .....
NAME
SIGNATURE DATE

Project: ADANI DEFENCE & AEROSPACE HYDERABAD

Building: HELICOPTER COMPLEX (PEB-9)


Drawing Title: GENERAL NOTES

Architect/Consultant: M/S ADANI LTD

Client: M/S ADANI LTD

ARC EDGES
ARCEDGES BUILDING (INDIA) LLP.
Corporate Office:
505-506, Aamarakunj Avis, Near Tapovan Circle, Chandkheda, Ahmedabad-382424


Drawn by:	SR		Scale: N.T.S.	Date: 17.09.25	
Checked by:	MMK		Project No: J-388-B2	Drawing No: IN-02	Revision: R2
Designed by:	URVISH				
Checked by:	PAD				
Approved by:	ARH				

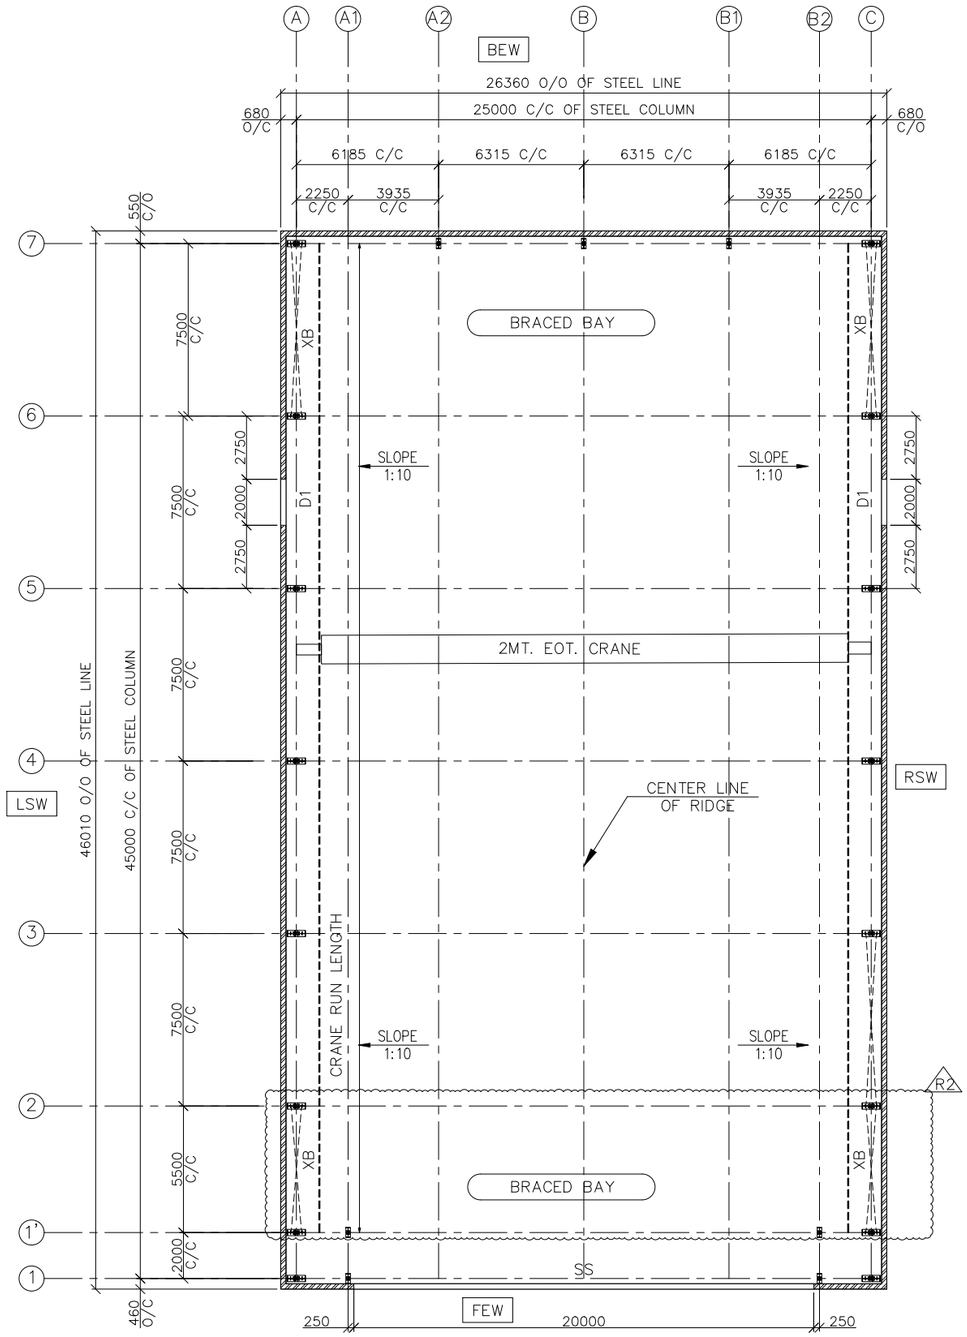

FLOOR PLAN

OPENING SCHEDULE–

DESCRIPTION	QUANTITY	WIDTH	HEIGHT
D1	02	2000MM.	2400MM.
SS	01	20000MM.	4600MM.
W1	12	2400MM.	1200MM.

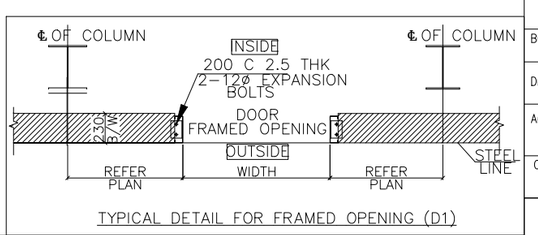

TYPICAL DETAIL FOR FRAMED OPENING (D1)

NOTES :–

1) ALL COLUMNS STARTS FROM F.F.L ± 0.00M LVL
2) ALL C/C & O/O DIMENSION NEED TO BE CONFIRM BY CLIENT.
3) XB: FULL HT. CROSS BRACING
4) 1000MM BRICK WALL AND ABOVE SANDWICH PANEL ALL AROUND THE BUILDING

LEGEND :–

BEW– BACK END WALL
FEW– FRONT END WALL
RSW– RIGHT SIDE WALL
LSW– LEFT SIDE WALL

DRAWING CROSS REFERENCE

DRG.NO.	REV	DESCRIPTION

IMPORTANT NOTES

ISSUED FOR APPROVAL

SENT ON .....

IN ORDER TO SCHEDULE THIS PROJECT IN THE MOST EFFICIENT MANNER, RETURN THESE DOCUMENTS, MARKED WITH YOUR COMMENTS, WITHIN TWO WEEKS FROM THE ABOVE MENTIONED DATE.
ANY CHANGES MADE AFTER APPROVAL OF THESE DRAWINGS MAY DELAY THE FABRICATION AND DELIVERY PROCESS.

THESE DRAWINGS ARE NOT FOR CONSTRUCTION.

1. ☐ APPROVED
NO CHANGES. PROCEED WITH FABRICATION.
2. ☐ APPROVED AS NOTED
FABRICATION MAY PROCEED ON THE BASIS OF CORRECTIONS INDICATED. RESUBMIT AFTER INCORPORATING THE COMMENTS FOR RECORD.
3. ☐ RESUBMIT AFTER INCORPORATING THE COMMENTS FOR REAPPROVAL.

REVIEWED BY .....
NAME
....
SIGNATURE DATE

REV	REVISIONS	DRAWN	DESIGN	DATE
R2	ISSUED FOR RE–APPROVAL	SR	URVISH	17.09.25
R1	ISSUED FOR RE–APPROVAL	SAT/SR	URVISH	20.08.25
R0	ISSUED FOR APPROVAL	SAT/SR	URVISH	25.07.25

Project: ADANI DEFENCE & AEROSPACE HYDERABAD

Building: HELICOPTER COMPLEX (PEB–9)


Drawing Title: FLOOR PLAN

Architect/Consultant: M/S ADANI LTD

Client: M/S ADANI LTD


ARCEDGES BUILDING (INDIA) LLP.
Corporate Office:
505–506, Aamarakunj Avis, Near Tapovan Circle, Chandkheda, Ahmedabad–382424

Drawn by:	SR		Scale: N.T.S.	Date: 17.09.25	
Checked by:	MMK		Project No:	Drawing No:	Revision:
Designed by:	URVISH		J–388–B2	GA–01	R2
Checked by:	PAD				
Approved by:	ARH				

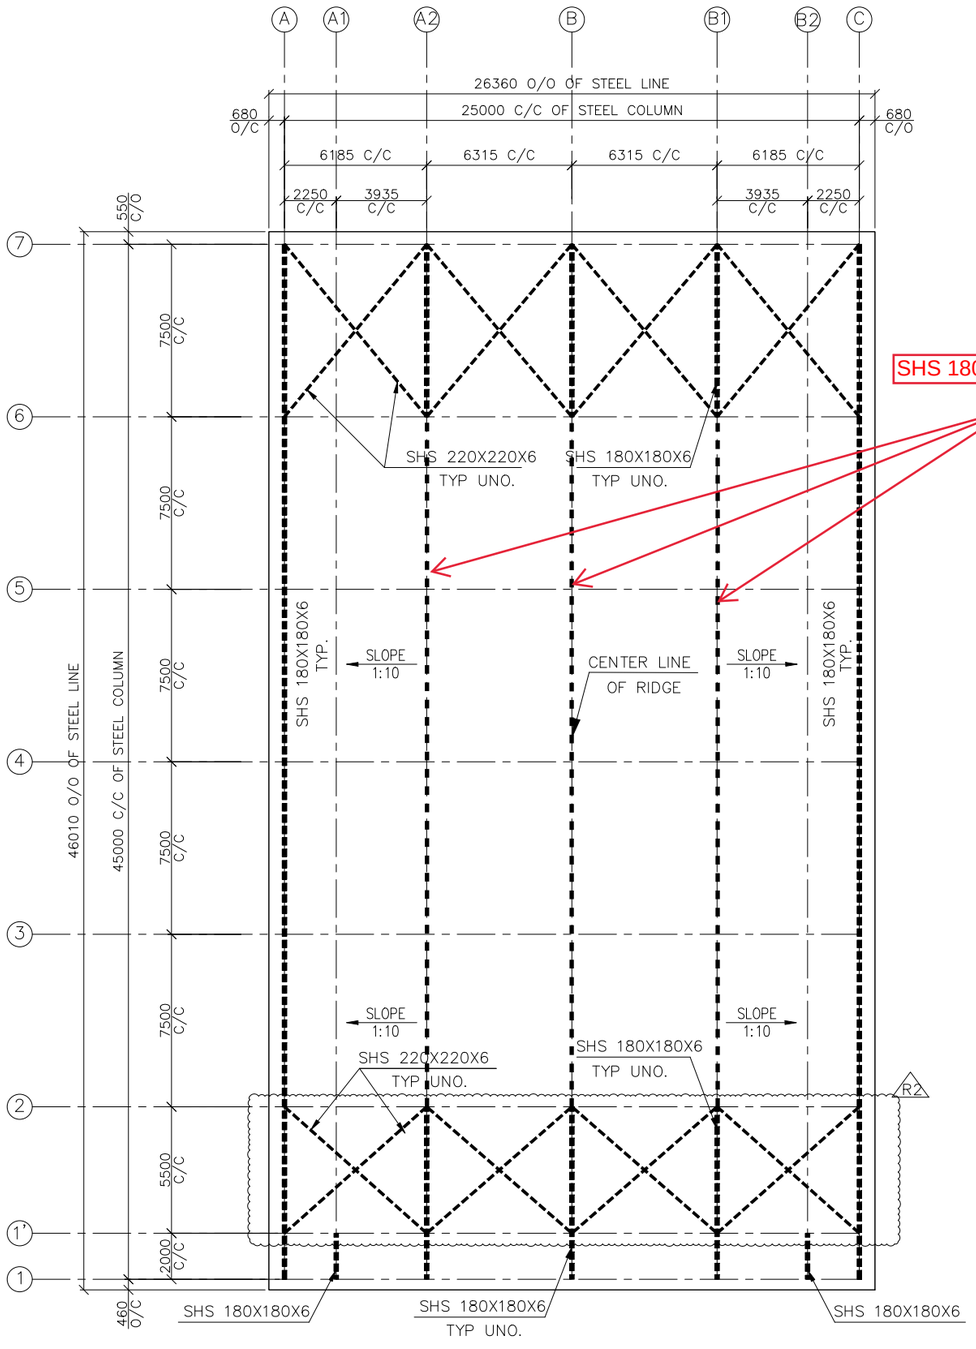


ROOF BRACING PLAN


SHS 180X180X6(TYP.)

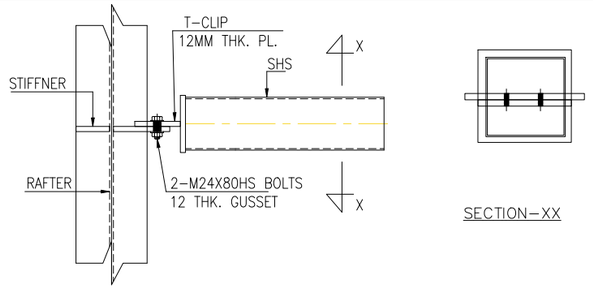


TYPICAL STRUT SHS CONNECTION DETAILS

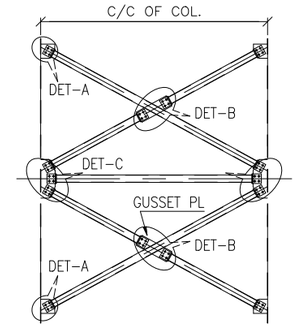


TYPICAL DETAIL OF SHS BRACINGS

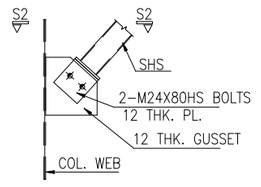


DETAIL-A

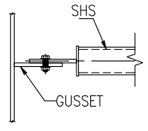


VIEW-S2 S2

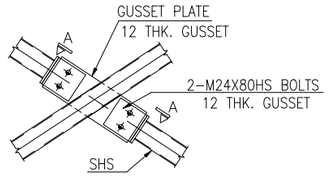

DETAIL-B

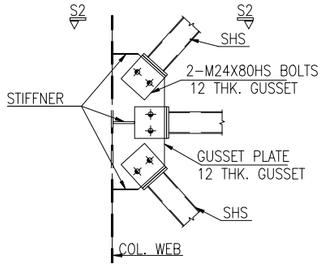

DETAIL-C

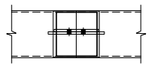

VIEW A-A
USE FOR 'SHS'

DRAWING CROSS REFERENCE

DRG.NO.	REV	DESCRIPTION

IMPORTANT NOTES

ISSUED FOR APPROVAL

SENT ON .....

IN ORDER TO SCHEDULE THIS PROJECT IN THE MOST EFFICIENT MANNER, RETURN THESE DOCUMENTS, MARKED WITH YOUR COMMENTS, WITHIN TWO WEEKS FROM THE ABOVE MENTIONED DATE.

ANY CHANGES MADE AFTER APPROVAL OF THESE DRAWINGS MAY DELAY THE FABRICATION AND DELIVERY PROCESS.

THESE DRAWINGS ARE NOT FOR CONSTRUCTION.

1. ☐ APPROVED
NO CHANGES. PROCEED WITH FABRICATION.
2. ☐ APPROVED AS NOTED
FABRICATION MAY PROCEED ON THE BASIS OF CORRECTIONS INDICATED. RESUBMIT AFTER INCORPORATING THE COMMENTS FOR RECORD.
3. ☐ RESUBMIT AFTER INCORPORATING THE COMMENTS FOR REAPPROVAL.

REVIEWED BY .....
NAME
SIGNATURE DATE

REV	REVISIONS	DRAWN	DESIGN	DATE
R2	ISSUED FOR RE-APPROVAL	SR	URVISH	17.09.25
R1	ISSUED FOR RE-APPROVAL	SAT/SR	URVISH	20.08.25
R0	ISSUED FOR APPROVAL	SAT/SR	URVISH	25.07.25

Project: ADANI DEFENCE & AEROSPACE HYDERABAD

Building: HELICOPTER COMPLEX (PEB-9)


Drawing Title: ROOF BRACING PLAN

Architect/Consultant: M/S ADANI LTD


Client: M/S ADANI LTD

ARCEDGES BUILDING (INDIA) LLP.
Corporate Office:
505-506, Aamarakunj Avis, Near Tapovan Circle, Chandkheda, Ahmedabad-382424


Drawn by:	SR		Scale: N.T.S.	Date: 17.09.25	
Checked by:	MMK		Project No:	Drawing No:	Revision:
Designed by:	URVISH		J-388-B2	GA-02	R2
Checked by:	PAD				
Approved by:	ARH				

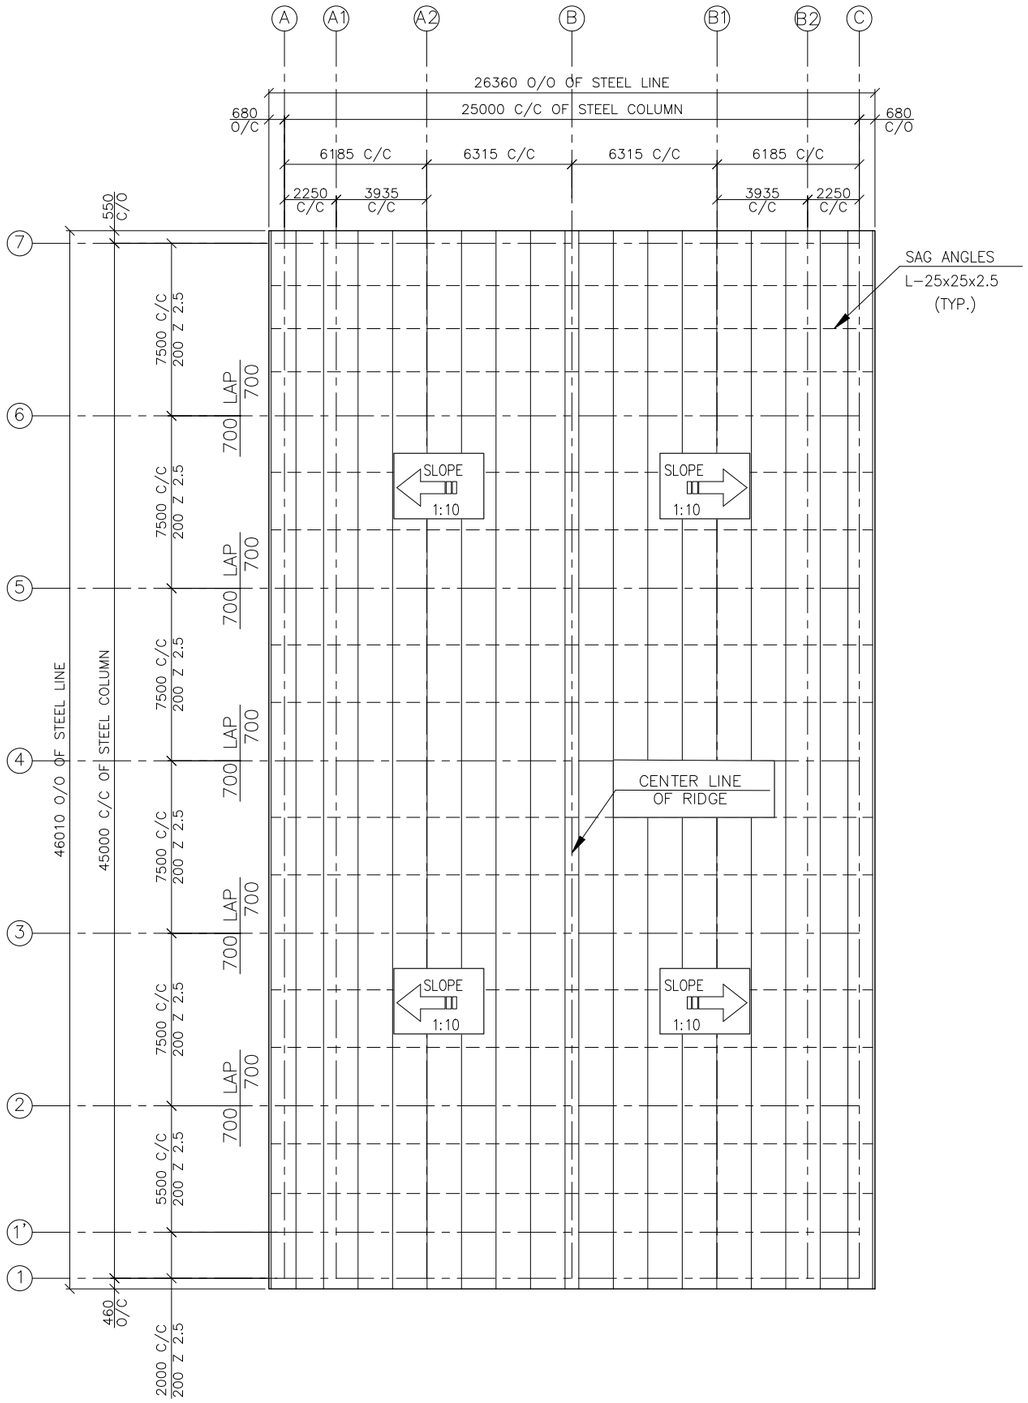


ROOF FRAMING PLAN

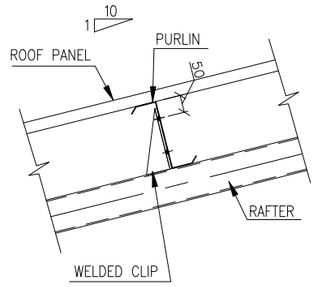

TYP. PURLIN CLIP DEATIL

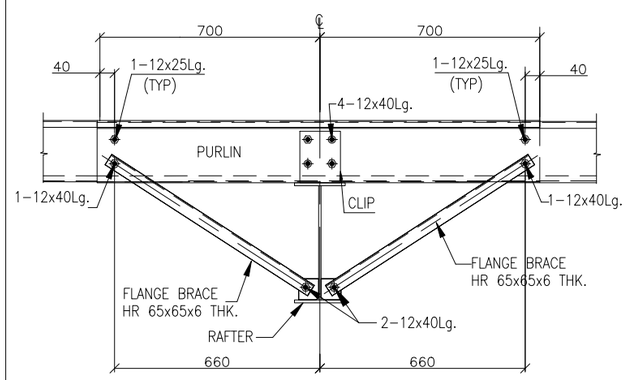

INTERMEDIATE PURLIN CONNECTION DETAIL
(700+700 LAP) WITH CLIP

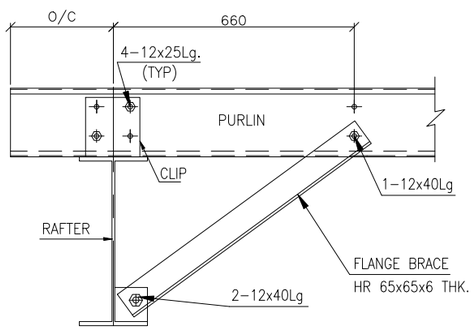

PURLIN CONNECTION DETAIL AT GABLE END
WITH CLIP

DRAWING CROSS REFERENCE

DRG.NO.	REV	DESCRIPTION

IMPORTANT NOTES

ISSUED FOR APPROVAL

SENT ON .....

IN ORDER TO SCHEDULE THIS PROJECT IN THE MOST EFFICIENT MANNER, RETURN THESE DOCUMENTS, MARKED WITH YOUR COMMENTS, WITHIN TWO WEEKS FROM THE ABOVE MENTIONED DATE.

ANY CHANGES MADE AFTER APPROVAL OF THESE DRAWINGS MAY DELAY THE FABRICATION AND DELIVERY PROCESS.

THESE DRAWINGS ARE NOT FOR CONSTRUCTION.

1. ☐ APPROVED
NO CHANGES. PROCEED WITH FABRICATION.
2. ☐ APPROVED AS NOTED
FABRICATION MAY PROCEED ON THE BASIS OF CORRECTIONS RECORDED. RESUBMIT AFTER INCORPORATING THE COMMENTS FOR RECORD.
3. ☐ RESUBMIT AFTER INCORPORATING THE COMMENTS FOR REAPPROVAL.

REVIEWED BY .....
NAME
SIGNATURE ..... DATE .....

REV	REVISIONS	DRAWN	DESIGN	DATE
R2	ISSUED FOR RE-APPROVAL	SR	URVISH	17.09.25
R1	ISSUED FOR RE-APPROVAL	SAT/SR	URVISH	20.08.25
R0	ISSUED FOR APPROVAL	SAT/SR	URVISH	25.07.25

Project: ADANI DEFENCE & AEROSPACE HYDERABAD

Building: HELICOPTER COMPLEX (PEB-9)


Drawing Title: ROOF FRAMING PLAN

Architect/Consultant: M/S ADANI LTD

Client: M/S ADANI LTD

ARCEDGES BUILDING (INDIA) LLP.
Corporate Office:
505-506, Aamarakunj Avis, Near Tapovan Circle,
Chandkheda, Ahmedabad-382424

Drawn by:	SR		Scale: N.T.S.	Date: 17.09.25	
Checked by:	MMK		Project No:	Drawing No:	Revision:
Designed by:	URVISH		J-388-B2	GA-03	R2
Checked by:	PAD				
Approved by:	ARH				

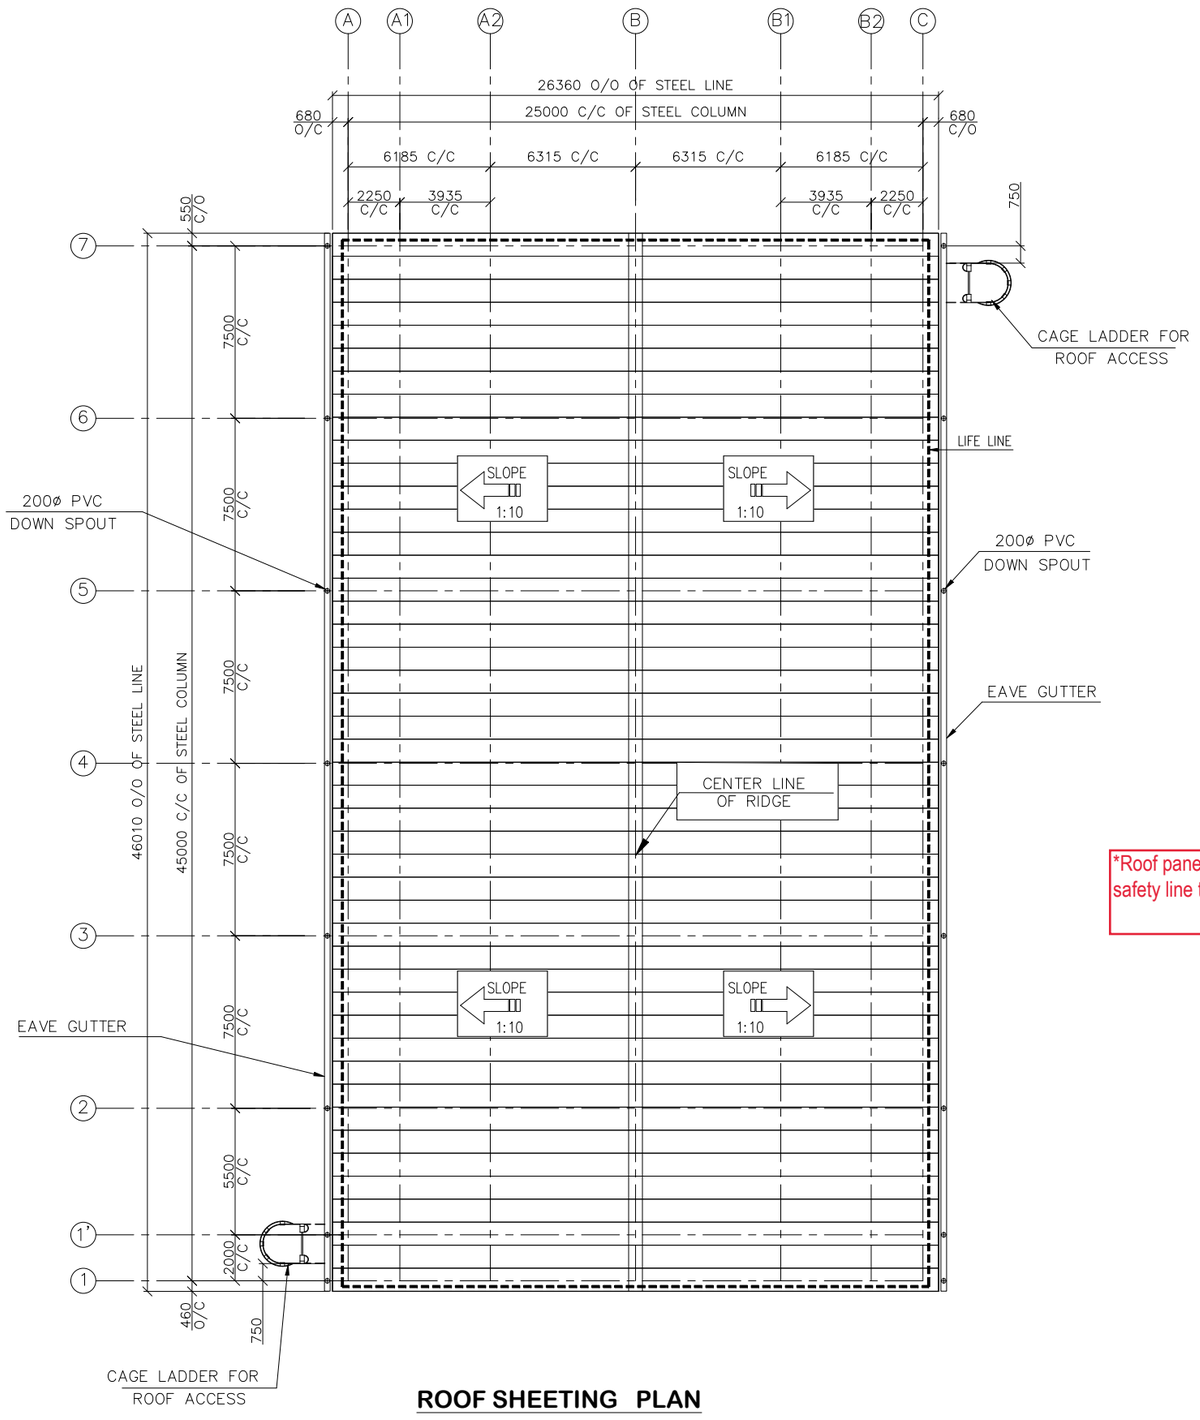

ROOF SHEETING PLAN

30 MM THICK COMPOSITE SANDWICH PANEL

*Roof panel to be single length
safety line to be provided at the roof level

NOTE:– CAGE LADDER LOCATION NEED TO CHECK AND CONFIRM BY CUSTOMER.

DRAWING CROSS REFERENCE

DRG.NO.	REV	DESCRIPTION

IMPORTANT NOTES

1.	ROOF PANEL.	30 MM THICK COMPOSITE SANDWICH PANEL
2.	ROOF LINER PANEL.	N/A
3.	ROOF INSULATION	N/A
4.	WELD MESH FOR SUPPORTING ROOF INSULATION	N/A
5.	CANOPY ROOF, SOFFIT & WALL PANEL	30 MM THICK COMPOSITE SANDWICH PANEL
6.	WALL PANEL	50 MM THICK COMPOSITE SANDWICH PANEL
	PARTITION WALL PANEL	N/A
7.	WALL LINER PANEL/SHEET	N/A
8.	WALL INSULATION	N/A
9.	WELD MESH FOR SUPPORTING WALL INSULATION	N/A
10.	FLASHINGS/TRIMS	0.5 MM THIK. PPGL
11.	GUTTER	EAVE GUTTER (300x240mm)
12.	DOWN-SPOUT/DOWN-TAKE PIPES	200Ø PVC -1NO' DOWNSPOUT AT EVERY COLUMN.
	DOWN-SPOUT-CANOPY	REVERSE DOWNTAKE 200Ø PVC
13.	SKY LIGHTS	N/A
14.	WELD MESH FOR SUPPORTING SKYLIGHT	N/A
15.	WALL-LIGHT	N/A
16.	WELD MESH FOR SUPPORTING WALL LIGHT.	N/A
17.	CAGE LADDER	2 NOS - FOR ROOF ACCESS WITH PLATFORM
18.	TURBO VENTS	N/A
19.	LIFE LINE	PERIPHERY OF THE BUILDING AS MARKED
20.	ROOF MONITOR	N/A
21.	Z- TYPE LOUVERS	N/A
22.	STAIR CASE	N/A

ISSUED FOR APPROVAL

SENT ON .....

IN ORDER TO SCHEDULE THIS PROJECT IN THE MOST EFFICIENT MANNER, RETURN THESE DOCUMENTS, MARKED WITH YOUR COMMENTS, WITHIN TWO WEEKS FROM THE ABOVE MENTIONED DATE.

ANY CHANGES MADE AFTER APPROVAL OF THESE DRAWINGS MAY DELAY THE FABRICATION AND DELIVERY PROCESS.

THESE DRAWINGS ARE NOT FOR CONSTRUCTION.

1. ☐ APPROVED
NO CHANGES. PROCEED WITH FABRICATION.

2. ☐ APPROVED AS NOTED
FABRICATION MAY PROCEED ON THE BASIS OF CORRECTIONS RECORD. RESUBMIT AFTER INCORPORATING THE COMMENTS FOR RECORD.

3. ☐ RESUBMIT AFTER INCORPORATING THE COMMENTS FOR REAPPROVAL.

REVIEWED BY .....

NAME

....

SIGNATURE DATE

REV	REVISIONS	DRAWN	DESIGN	DATE
R2	ISSUED FOR RE-APPROVAL	SR	URVISH	17.09.25
R1	ISSUED FOR RE-APPROVAL	SAT/SR	URVISH	20.08.25
R0	ISSUED FOR APPROVAL	SAT/SR	URVISH	25.07.25

Project: ADANI DEFENCE & AEROSPACE HYDERABAD

Building: HELICOPTER COMPLEX (PEB–9)


Drawing Title: ROOF SHEETING PLAN

Architect/Consultant: M/S ADANI LTD

Client: M/S ADANI LTD


ARCEDGES BUILDING (INDIA) LLP.
Corporate Office:
505–506, Aamarakunj Avis, Near Tapovan Circle,
Chandkheda, Ahmedabad–382424

Drawn by:	SR		Scale: N.T.S.	Date: 17.09.25	
Checked by:	MMK		Project No:	Drawing No:	Revision:
Designed by:	URVISH		J–388–B2	GA–04	R2
Checked by:	PAD				
Approved by:	ARH				

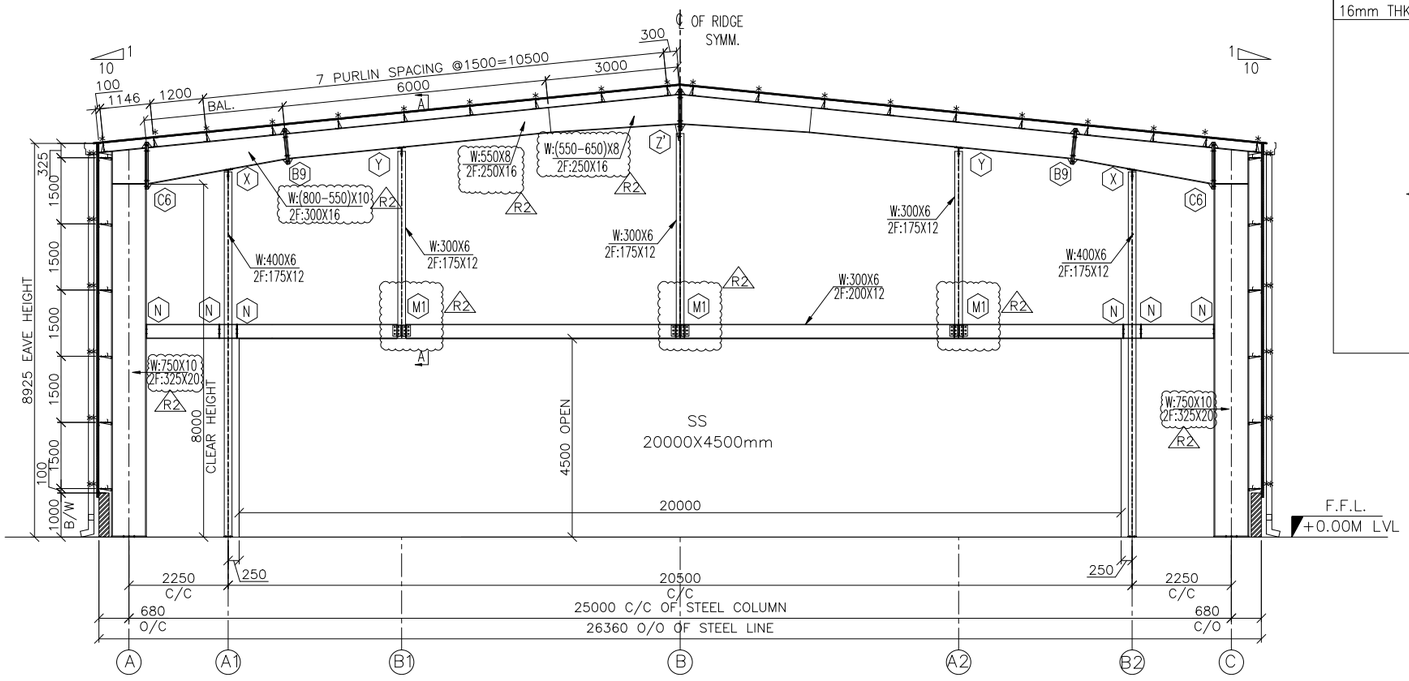

FRAME CROSS SECTION @ GL-1


** – DENOTES DOUBLE SIDE FLANGE BRACE LOCATIONS HR-65X65X6
* – DENOTES SINGLE SIDE FLANGE BRACE LOCATIONS HR-65X65X6

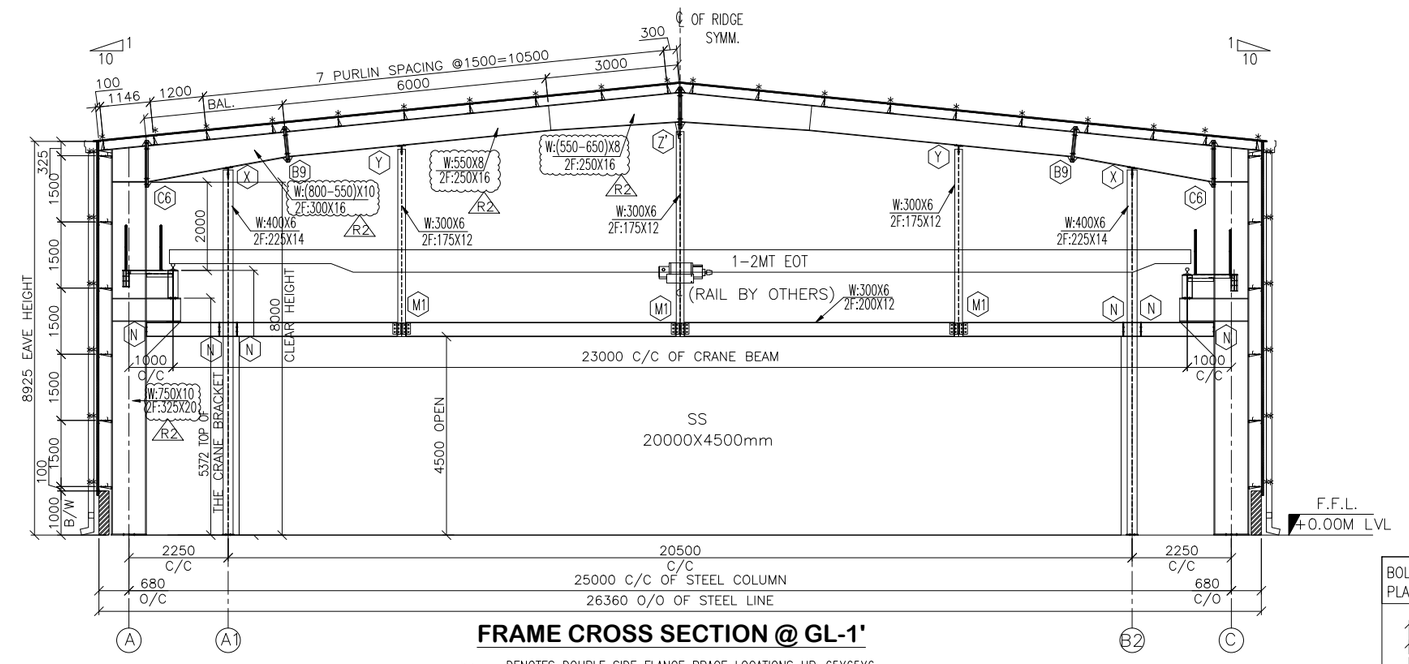

FRAME CROSS SECTION @ GL-1'


** – DENOTES DOUBLE SIDE FLANGE BRACE LOCATIONS HR-65X65X6
* – DENOTES SINGLE SIDE FLANGE BRACE LOCATIONS HR-65X65X6

BOLTS=24ø X 130L-6 NO'S
16mm THK STIFFENER

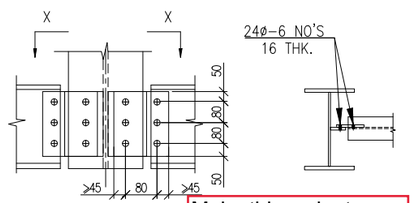


Make this a cleat connection.


DETAIL-M R2 SECTION-X-X

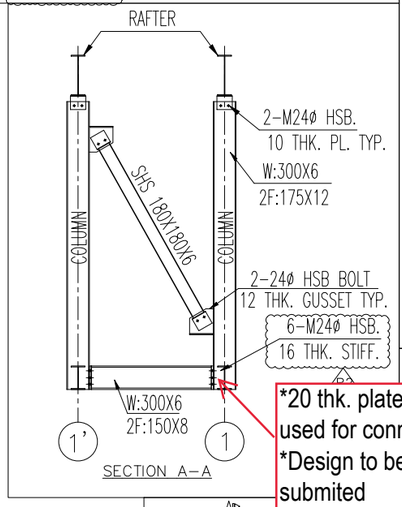

*20 thk. plate to be used for connection.
*Design to be submited

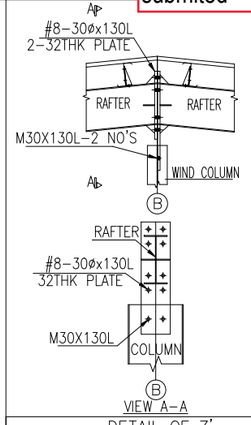


DETAIL OF Z'

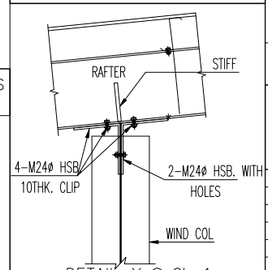

DETAIL-Y @ GL-1
WIND COL TO RAFTER CONN.

BOLTS=M20X100L-4 NO'S
PLATE THK.=10

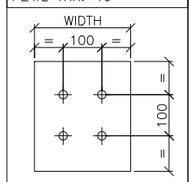

DETAIL-N

DRAWING CROSS REFERENCE

DRG.NO.	REV	DESCRIPTION

IMPORTANT NOTES

NOTE: – Minor adjustments at site during the installation of crane lacing, bracings, etc., due to slight mismatches in anchor bolt dimensions or fabrication tolerances, are considered a standard part of the erection process.

ISSUED FOR APPROVAL

SENT ON .....

SCHEDULE THIS PROJECT IN THE MOST EFFICIENT
URN THESE DOCUMENTS, MARKED WITH YOUR
ITHIN TWO WEEKS FROM THE ABOVE MENTIONED

MADE AFTER APPROVAL OF THESE DRAWINGS MAY
ABRICATION AND DELIVERY PROCESS.

NGS ARE NOT FOR CONSTRUCTION.

1. ☐ APPROVED
NO CHANGES. PROCEED WITH FABRICATION.
2. ☐ APPROVED AS NOTED
FABRICATION MAY PROCEED ON THE BASIS OF CORRECTIONS RECOMM. AFTER INCORPORATING THE COMMENTS FOR RECORD.
3. ☐ RESUBMIT AFTER INCORPORATING THE COMMENTS FOR REAPPROVAL.

REVIEWED BY .....
NAME
SIGNATURE DATE

REV	REVISIONS	DRAWN	DESIGN	DATE
R2	ISSUED FOR RE-APPROVAL	SR	URVISH	17.09.25
R1	ISSUED FOR RE-APPROVAL	SAT/SR	URVISH	20.08.25
R0	ISSUED FOR APPROVAL	SAT/SR	URVISH	25.07.25

Project:
ADANI DEFENCE & AEROSPACE
HYDERABAD

Building:
HELICOPTER COMPLEX (PEB-9)


Drawing Title: FRAME CROSS SECTION @ GL-1 & 1'

Architect/Consultant:
M/S ADANI LTD

Client:
M/S ADANI LTD


ARCEDGES BUILDING (INDIA) LLP.
Corporate Office:
505-506, Aamarakunj Avis, Near Tapovan Circle,
Chandkheda, Ahmedabad-382424

Drawn by:	SR		Scale: N.T.S.		Date: 17.09.25
Checked by:	MMK		Project No:	Drawing No:	Revision:
Designed by:	URVISH		J-388-B2	GA-05	R2
Checked by:	PAD				
Approved by:	ARH				

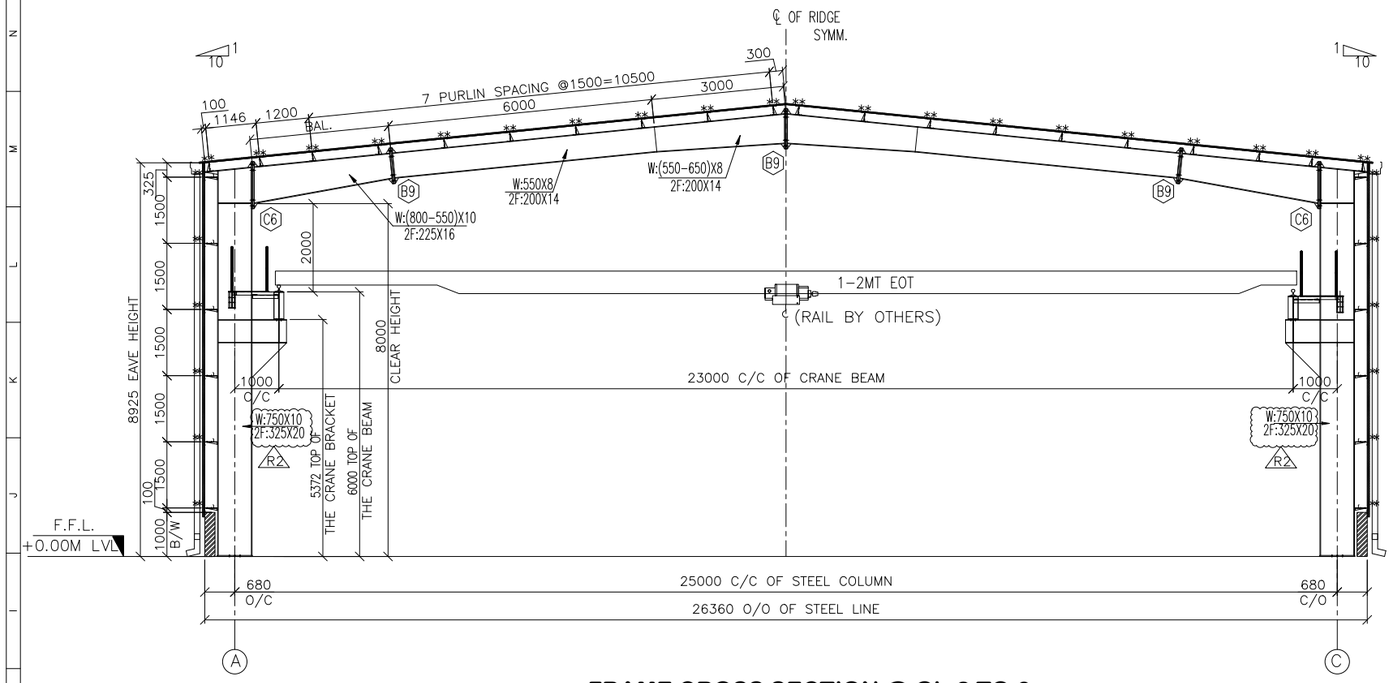


FRAME CROSS SECTION @ GL-2 TO 6

** – DENOTES DOUBLE SIDE FLANGE BRACE LOCATIONS HR-65X65X6
* – DENOTES SINGLE SIDE FLANGE BRACE LOCATIONS HR-65X65X6

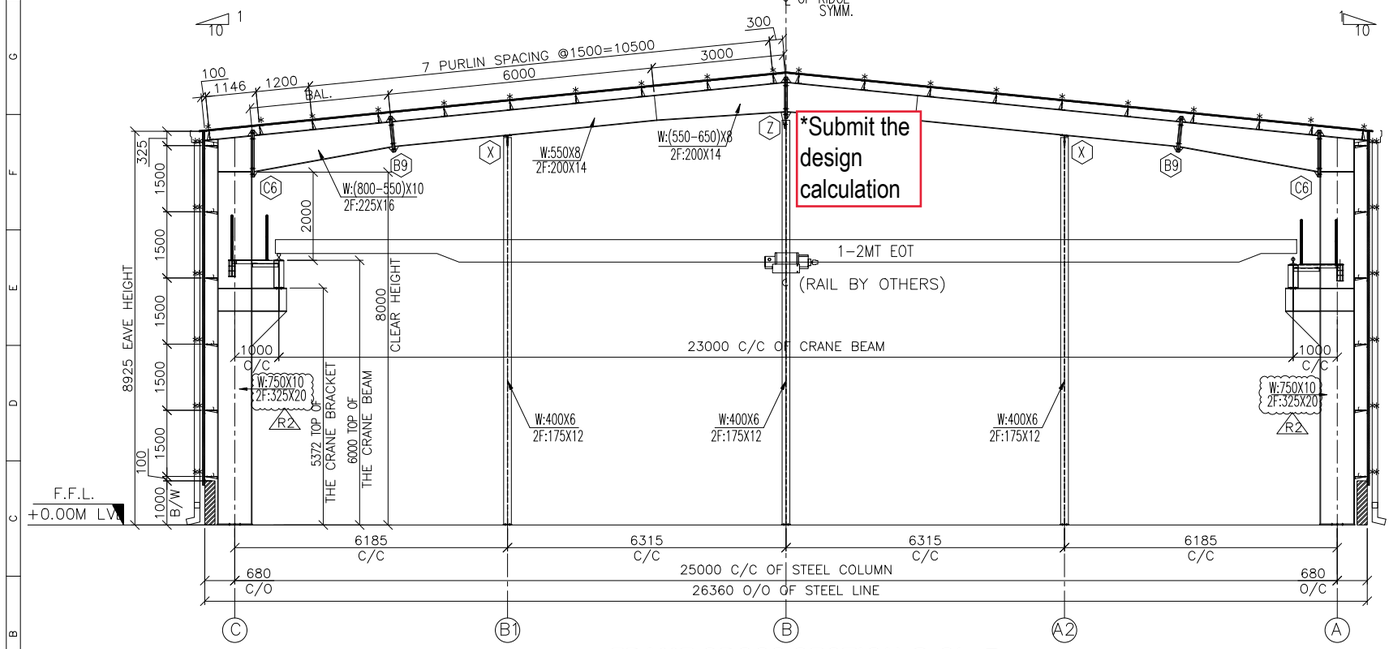

FRAME CROSS SECTION @ GL- 7


** – DENOTES DOUBLE SIDE FLANGE BRACE LOCATIONS HR-65X65X6
* – DENOTES SINGLE SIDE FLANGE BRACE LOCATIONS HR-65X65X6

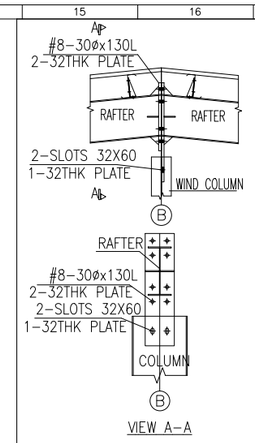

VIEW A-A


DETAIL OF Z

BOLTS=30ø X130L-16 NO'S
PLATE THK.=32
10mm THK STIFFENER

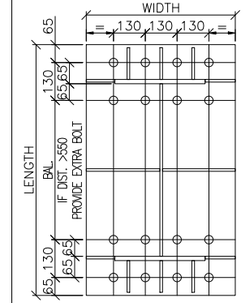


DETAIL OF C6

BOLTS=M30X130L-12 NO'S
PLATE THK.=32
10mm THK STIFFENER

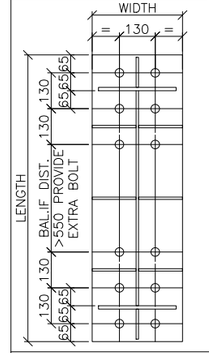

DETAIL OF B9

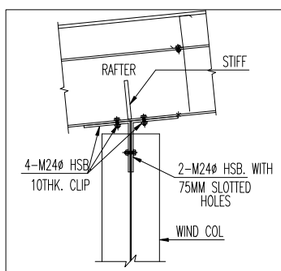

DETAIL-X

WIND COL TO RAFTER CONN.

DRAWING CROSS REFERENCE

DRG.NO.	REV	DESCRIPTION

IMPORTANT NOTES

NOTE: – Minor adjustments at site during the installation of crane lacing, bracings, etc., due to slight mismatches in anchor bolt dimensions or fabrication tolerances, are considered a standard part of the erection process.

ISSUED FOR APPROVAL

SENT ON .....

IN ORDER TO SCHEDULE THIS PROJECT IN THE MOST EFFICIENT MANNER, RETURN THESE DOCUMENTS, MARKED WITH YOUR COMMENTS, WITHIN TWO WEEKS FROM THE ABOVE MENTIONED DATE.
ANY CHANGES MADE AFTER APPROVAL OF THESE DRAWINGS MAY DELAY THE FABRICATION AND DELIVERY PROCESS.

THESE DRAWINGS ARE NOT FOR CONSTRUCTION.

1. ☐ APPROVED
NO CHANGES. PROCEED WITH FABRICATION.
2. ☐ APPROVED AS NOTED
FABRICATION MAY PROCEED ON THE BASIS OF CORRECTIONS INDICATED. RESUBMIT AFTER INCORPORATING THE COMMENTS FOR RECORD.
3. ☐ RESUBMIT AFTER INCORPORATING THE COMMENTS FOR REAPPROVAL.

REVIEWED BY .....
NAME
SIGNATURE DATE

REV	REVISIONS	DRAWN	DESIGN	DATE
R2	ISSUED FOR RE-APPROVAL	SR	URVISH	17.09.25
R1	ISSUED FOR RE-APPROVAL	SAT/SR	URVISH	20.08.25
R0	ISSUED FOR APPROVAL	SAT/SR	URVISH	25.07.25

Project: ADANI DEFENCE & AEROSPACE HYDERABAD

Building: HELICOPTER COMPLEX (PEB-9)


Drawing Title: FRAME CROSS SECTION @ GL-2 TO 7

Architect/Consultant: M/S ADANI LTD

Client: M/S ADANI LTD


ARCEDGES BUILDING (INDIA) LLP.
Corporate Office:
505-506, Aamarakunj Avis, Near Tapovan Circle, Chandkheda, Ahmedabad-382424

Drawn by:	SR		Scale: N.T.S.	Date: 17.09.25	
Checked by:	MMK		Project No:	Drawing No:	Revision:
Designed by:	URVISH		J-388-B2	GA-06	R2
Checked by:	PAD				
Approved by:	ARH				

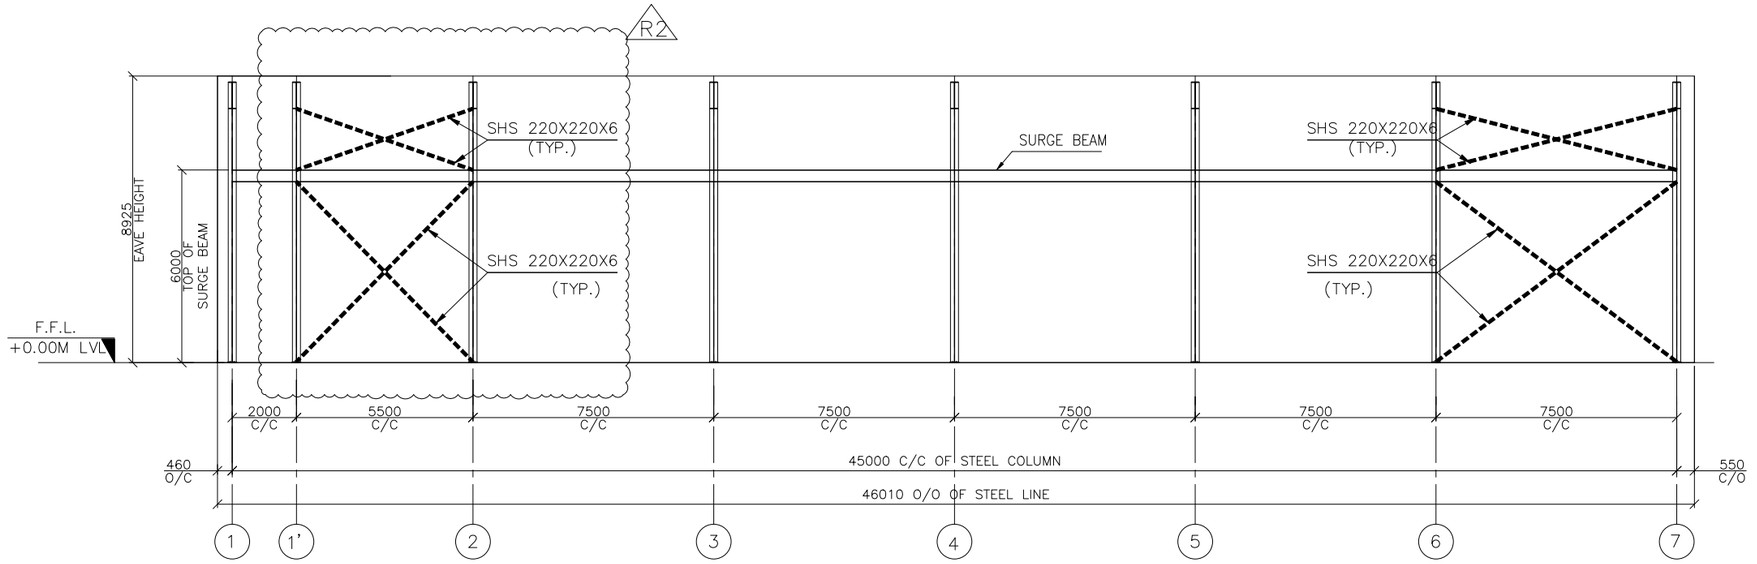

SIDE WALL BRACING ELEVATION ALONG AXIS-C (AS SHOWN)

SIDE WALL BRACING ELEVATION ALONG AXIS-A (AS MIRROR)

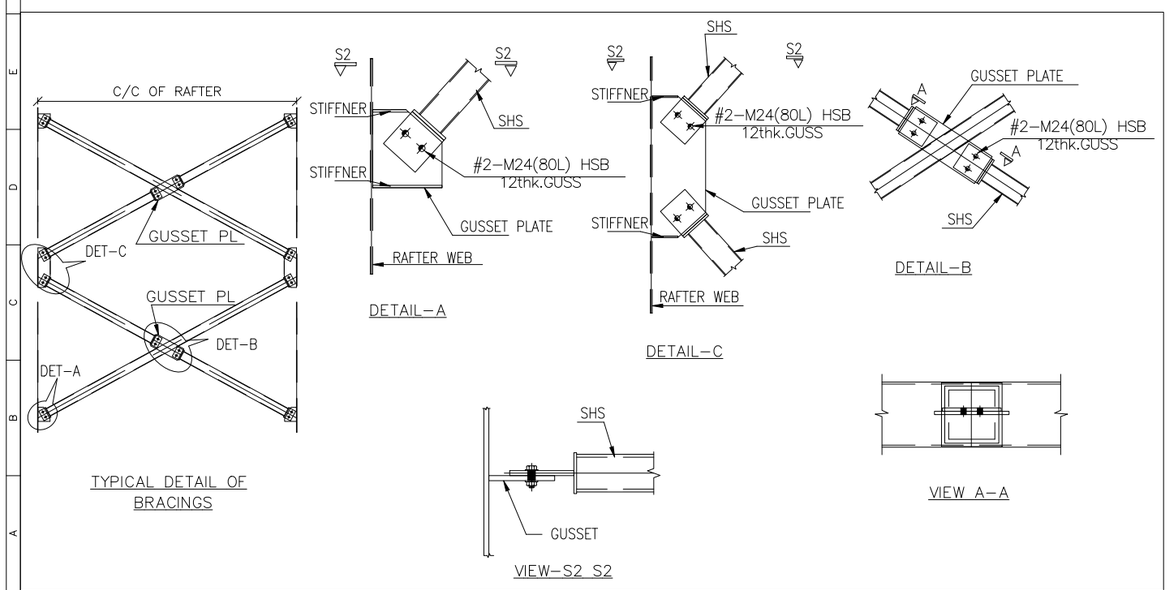

DRAWING CROSS REFERENCE

DRG.NO.	REV	DESCRIPTION

IMPORTANT NOTES

NOTE: – Minor adjustments at site during the installation of crane lacing, bracings, etc., due to slight mismatches in anchor bolt dimensions or fabrication tolerances, are considered a standard part of the erection process.

ISSUED FOR APPROVAL

SENT ON .....

IN ORDER TO SCHEDULE THIS PROJECT IN THE MOST EFFICIENT MANNER, RETURN THESE DOCUMENTS, MARKED WITH YOUR COMMENTS, WITHIN TWO WEEKS FROM THE ABOVE MENTIONED DATE.

ANY CHANGES MADE AFTER APPROVAL OF THESE DRAWINGS MAY DELAY THE FABRICATION AND DELIVERY PROCESS.

THESE DRAWINGS ARE NOT FOR CONSTRUCTION.

1. ☐ APPROVED
   NO CHANGES. PROCEED WITH FABRICATION.
2. ☐ APPROVED AS NOTED
   FABRICATION MAY PROCEED ON THE BASIS OF CORRECTIONS INDICATED. RESUBMIT AFTER INCORPORATING THE COMMENTS FOR RECORD.
3. ☐ RESUBMIT AFTER INCORPORATING THE COMMENTS FOR REAPPROVAL.

REVIEWED BY .....
NAME
SIGNATURE DATE

REV	REVISIONS	DRAWN	DESIGN	DATE
R2	ISSUED FOR RE-APPROVAL	SR	URVISH	17.09.25
R1	ISSUED FOR RE-APPROVAL	SAT/SR	URVISH	20.08.25
R0	ISSUED FOR APPROVAL	SAT/SR	URVISH	25.07.25

Project:
ADANI DEFENCE & AEROSPACE
HYDERABAD

Building:
HELICOPTER COMPLEX (PEB-9)


Drawing Title: SIDE WALL BRACING ELEVATION

Architect/Consultant:
M/S ADANI LTD

Client:
M/S ADANI LTD

ARCEDGES BUILDING (INDIA) LLP.
Corporate Office:
505-506, Aamarakunj Avis, Near Tapovan Circle,
Chandkheda, Ahmedabad-382424

Drawn by:	SR		Scale: N.T.S.	Date: 17.09.25	
Checked by:	MMK		Project No: J-388-B2	Drawing No: GA-07	Revision: R2
Designed by:	URVISH				
Checked by:	PAD				
Approved by:	ARH				

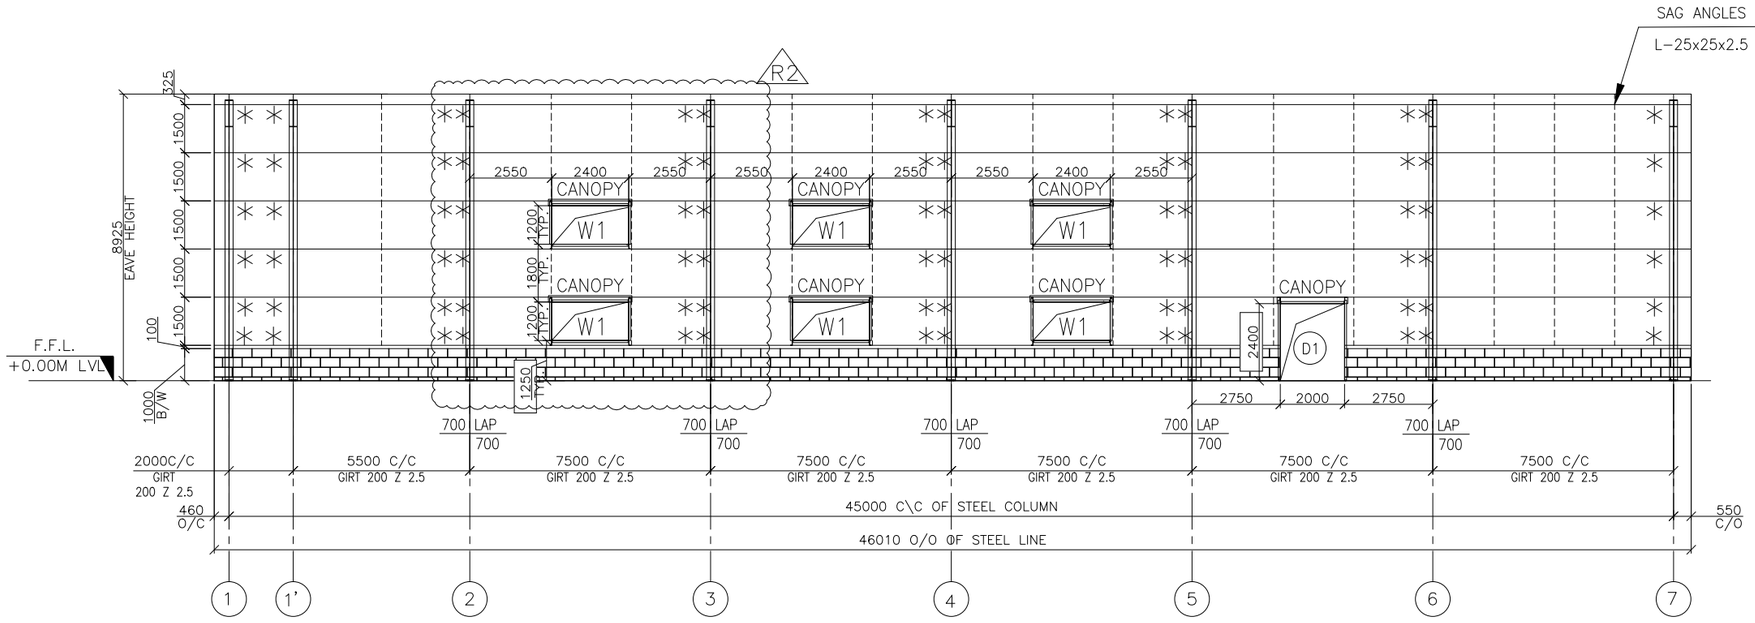

SIDE WALL FRAMING ELEVATION ALONG AXIS-C (AS SHOWN)


SIDE WALL FRAMING ELEVATION ALONG AXIS-A (AS MIRROR)

NOTE:- ✳✳ - DENOTES DOUBLE SIDE FLANGE BRACE LOCATIONS HR-65X65x6


✳ - DENOTES SINGLE SIDE FLANGE BRACE LOCATIONS HR-65X65x6

Welded Connection

NOTE:- DOOR AND WINDOW OPENING LOCATION NEED TO CONFIRM BY CLIENT

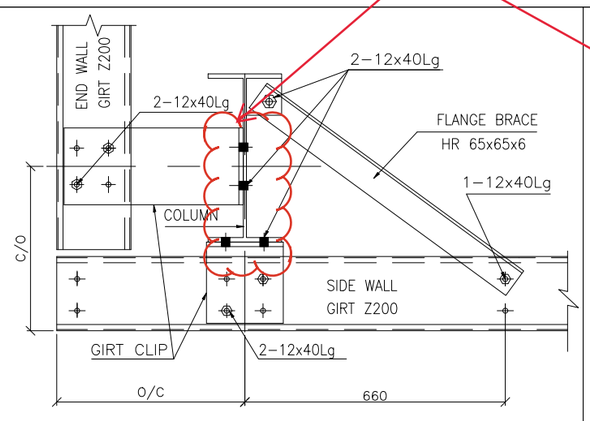

CORNER GIRT CONNECTION DETAIL

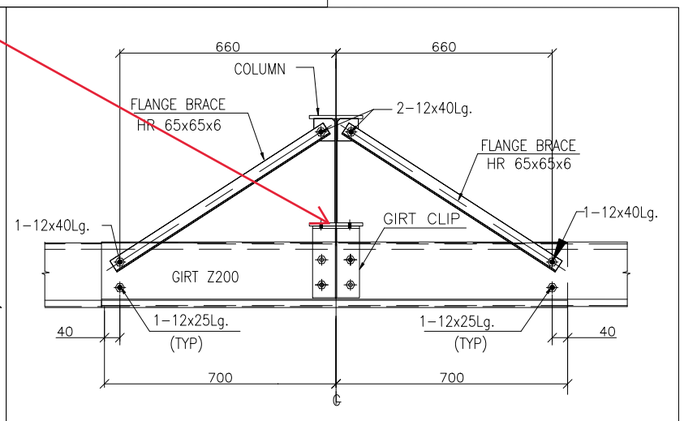

INTERMEDIATE GIRT CONNECTION DETAIL
(700+700 LAP)

NOTE:-
LOWER WINDOWS SHALL BE SLIDING & UPPER WINODWS SHALL BE FIXED.

OPENING SCHEDULE-

DESCRIPTION	WIDTH	HEIGHT	QUANTITY
D1	2000MM.	2400MM.	2 NO.

DRAWING CROSS REFERENCE

DRG.NO.	REV	DESCRIPTION

IMPORTANT NOTES

NOTE:- Minor adjustments at site during the installation of crane lacing, bracings, etc., due to slight mismatches in anchor bolt dimensions or fabrication tolerances, are considered a standard part of the erection process.

ISSUED FOR APPROVAL

SENT ON .....

IN ORDER TO SCHEDULE THIS PROJECT IN THE MOST EFFICIENT MANNER, RETURN THESE DOCUMENTS, MARKED WITH YOUR COMMENTS, WITHIN TWO WEEKS FROM THE ABOVE MENTIONED DATE.

ANY CHANGES MADE AFTER APPROVAL OF THESE DRAWINGS MAY DELAY THE FABRICATION AND DELIVERY PROCESS.

THESE DRAWINGS ARE NOT FOR CONSTRUCTION.

1. ☐ APPROVED
NO CHANGES. PROCEED WITH FABRICATION.
2. ☐ APPROVED AS NOTED
FABRICATION MAY PROCEED ON THE BASIS OF CORRECTIONS INDICATED. RESUBMIT AFTER INCORPORATING THE COMMENTS FOR RECORD.
3. ☐ RESUBMIT AFTER INCORPORATING THE COMMENTS FOR REAPPROVAL.

REVIEWED BY .....
NAME
SIGNATURE ..... DATE .....

REV	REVISIONS	DRAWN	DESIGN	DATE
R2	ISSUED FOR RE-APPROVAL	SR	URVISH	17.09.25
R1	ISSUED FOR RE-APPROVAL	SAT/SR	URVISH	20.08.25
R0	ISSUED FOR APPROVAL	SAT/SR	URVISH	25.07.25

Project:
ADANI DEFENCE & AEROSPACE
HYDERABAD

Building:
HELICOPTER COMPLEX (PEB-9)


Drawing Title: SIDE WALL FRAMING ELEVATION

Architect/Consultant:
M/S ADANI LTD

Client:
M/S ADANI LTD

ARC EDGES
ARCEDGES BUILDING (INDIA) LLP.
Corporate Office:
505-506, Aamarakunj Avis, Near Tapovan Circle,
Chandkheda, Ahmedabad-382424


Drawn by:	SR		Scale: N.T.S.	Date: 17.09.25	
Checked by:	MMK		Project No: J-388-B2	Drawing No: GA-08	Revision: R2
Designed by:	URVISH				
Checked by:	PAD				
Approved by:	ARH				

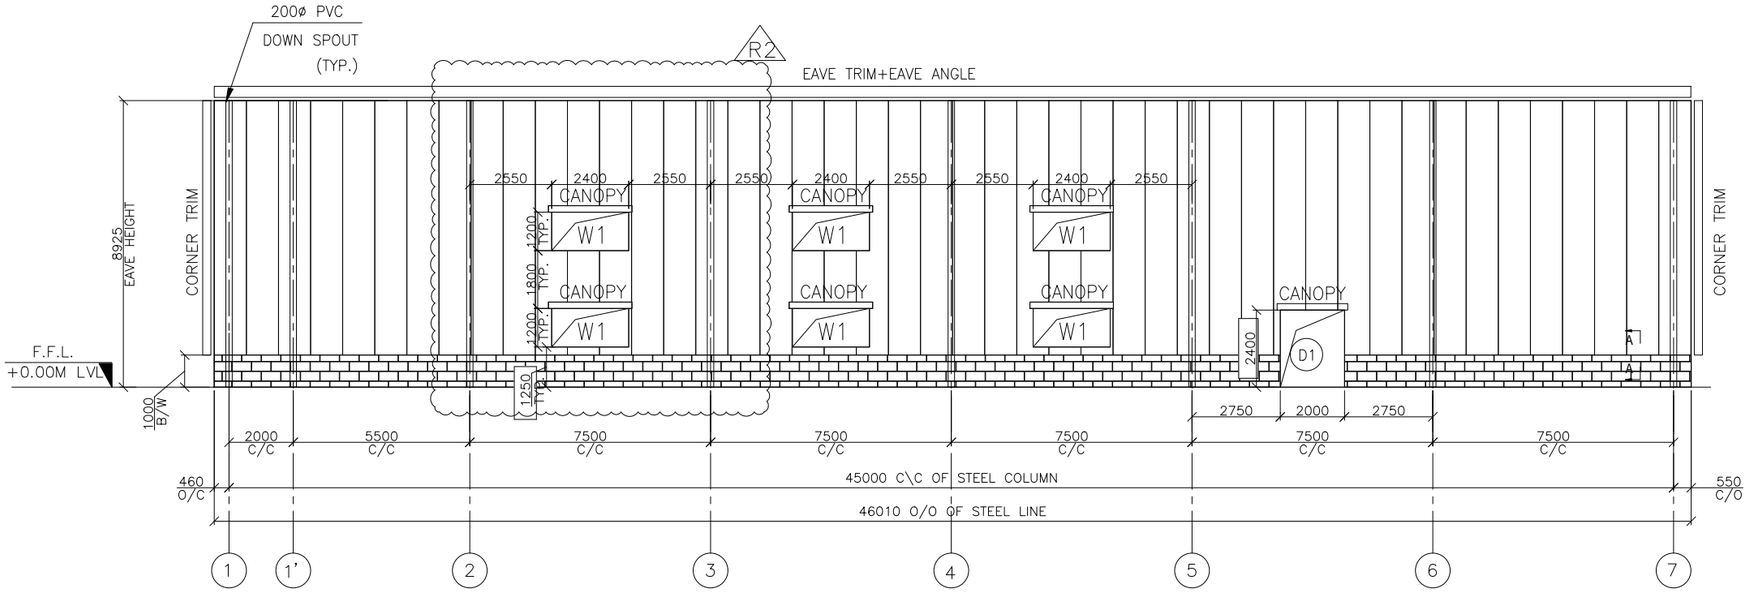


SIDE WALL SHEETING ELEVATION ALONG AXIS-C (AS SHOWN)


SIDE WALL SHEETING ELEVATION ALONG AXIS-A (AS MIRROR)

NOTE:– DOOR AND WINDOW OPENING LOCATION NEED TO CONFIRM BY CLIENT

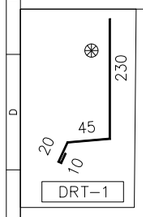

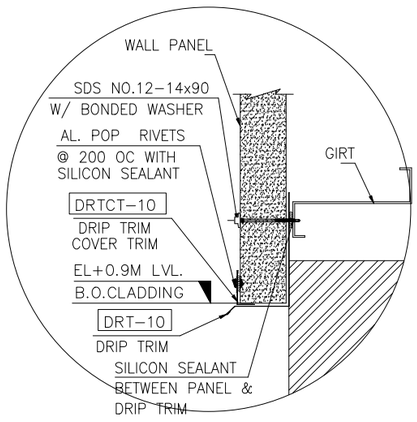

DETAIL–A

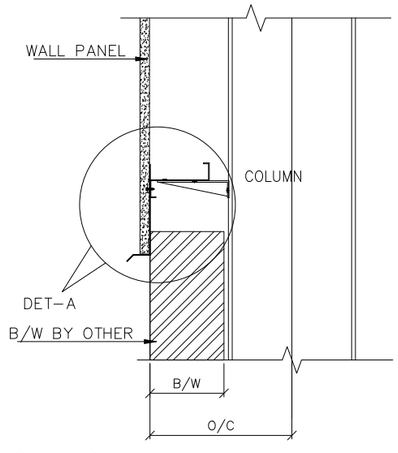

TYPICAL MASONARY DETAIL

NOTE:–
LOWER WINDOWS SHALL BE SLIDING & UPPER WINODWS SHALL BE FIXED.

OPENING SCHEDULE–

DESCRIPTION	WIDTH	HEIGHT	QUANTITY
D1	2000MM.	2400MM.	2 NO.
W1	2400MM.	1200MM.	12 NOS.

DRAWING CROSS REFERENCE

DRG.NO.	REV	DESCRIPTION

IMPORTANT NOTES

NOTE:– Minor adjustments at site during the installation of crane lacing, bracings, etc., due to slight mismatches in anchor bolt dimensions or fabrication tolerances, are considered a standard part of the erection process.

ISSUED FOR APPROVAL

SENT ON .....

IN ORDER TO SCHEDULE THIS PROJECT IN THE MOST EFFICIENT MANNER, RETURN THESE DOCUMENTS, MARKED WITH YOUR COMMENTS, WITHIN TWO WEEKS FROM THE ABOVE MENTIONED DATE.

ANY CHANGES MADE AFTER APPROVAL OF THESE DRAWINGS MAY DELAY THE FABRICATION AND DELIVERY PROCESS.

THESE DRAWINGS ARE NOT FOR CONSTRUCTION.

1. ☐ APPROVED
NO CHANGES. PROCEED WITH FABRICATION.

2. ☐ APPROVED AS NOTED
FABRICATION MAY PROCEED ON THE BASIS OF CORRECTIONS INDICATED. RESUBMIT AFTER INCORPORATING THE COMMENTS FOR RECORD.

3. ☐ RESUBMIT AFTER INCORPORATING THE COMMENTS FOR REAPPROVAL.

REVIEWED BY .....
NAME
SIGNATURE ..... DATE .....

REV	REVISIONS	DRAWN	DESIGN	DATE
R2	ISSUED FOR RE–APPROVAL	SR	URVISH	17.09.25
R1	ISSUED FOR RE–APPROVAL	SAT/SR	URVISH	20.08.25
R0	ISSUED FOR APPROVAL	SAT/SR	URVISH	25.07.25

Project:
ADANI DEFENCE & AEROSPACE
HYDERABAD

Building: HELICOPTER COMPLEX (PEB–9)


Drawing Title: SIDE WALL SHEETING ELEVATION

Architect/Consultant: M/S ADANI LTD


Client: M/S ADANI LTD

ARCEDGES BUILDING (INDIA) LLP.
Corporate Office:
505–506, Aamarakunj Avis, Near Tapovan Circle,
Chandkheda, Ahmedabad–382424


Drawn by:	SR		Scale: N.T.S.	Date: 17.09.25	
Checked by:	MMK		Project No: J–388–B2	Drawing No: GA–09	Revision: R2
Designed by:	URVISH				
Checked by:	PAD				
Approved by:	ARH				

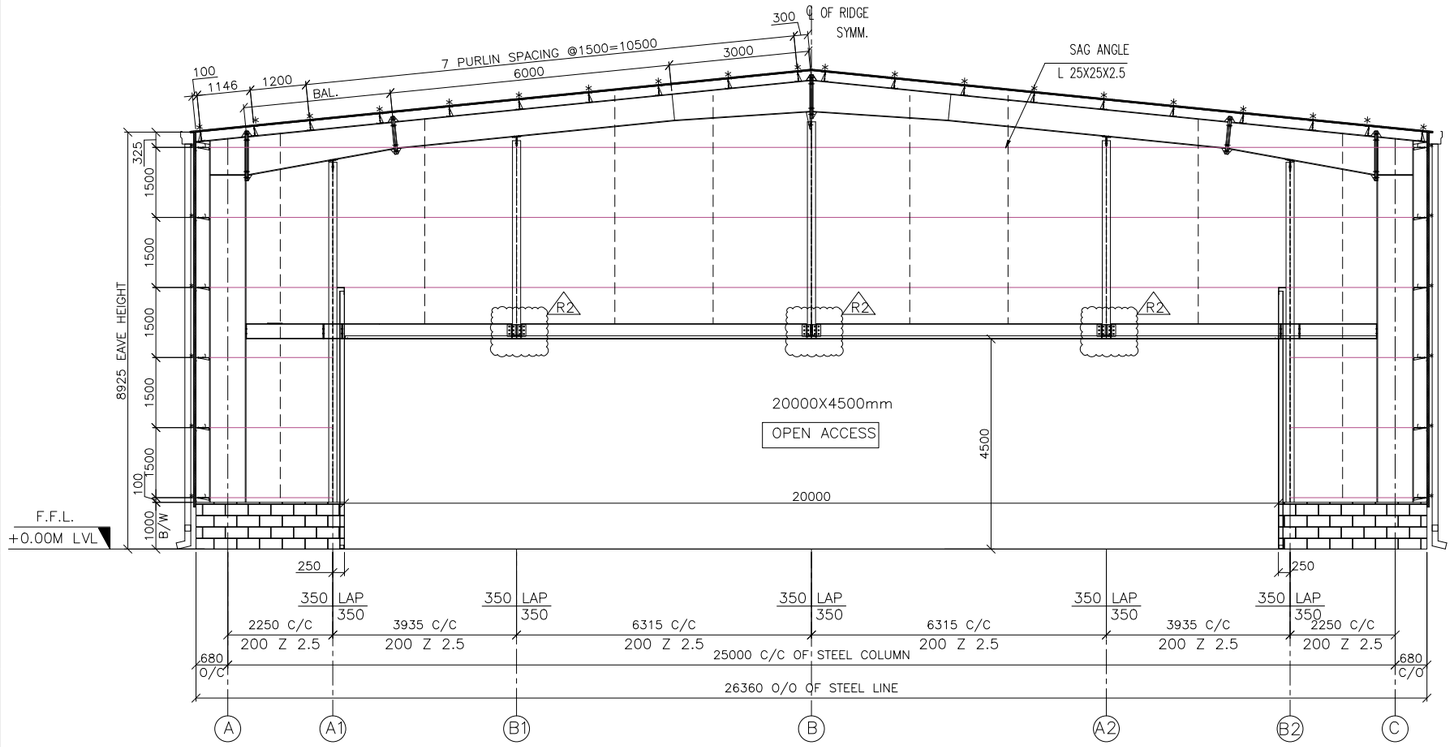


FRAME CROSS SECTION @ GL-1

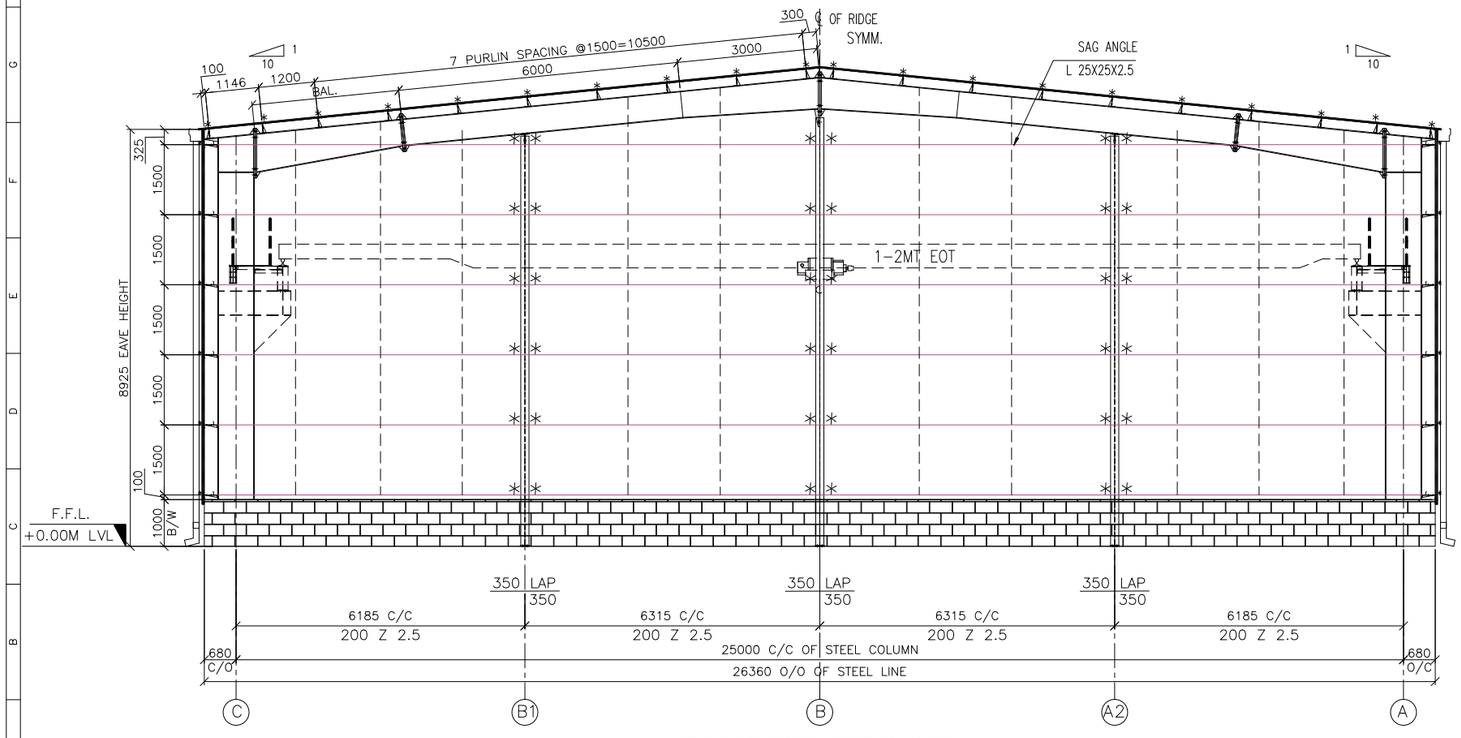

FRAME CROSS SECTION @ GL- 7

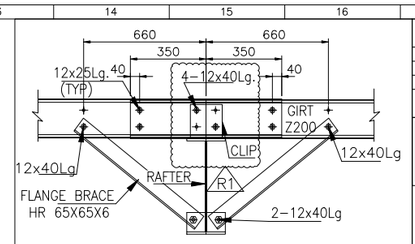

INTERMEDIATE GIRT CONNECTION DETAIL (350+350 LAP)

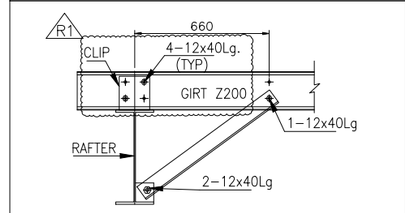

GIRT CONNECTION DETAIL AT GABLE END

** - DENOTES DOUBLE SIDE FLANGE BRACE LOCATIONS HR-65X65X6
* - DENOTES SINGLE SIDE FLANGE BRACE LOCATIONS HR-65X65X6

DRAWING CROSS REFERENCE

DRG.NO.	REV	DESCRIPTION

IMPORTANT NOTES

NOTE: – Minor adjustments at site during the installation of crane lacing, bracings, etc., due to slight mismatches in anchor bolt dimensions or fabrication tolerances, are considered a standard part of the erection process.

ISSUED FOR APPROVAL

SENT ON .....

IN ORDER TO SCHEDULE THIS PROJECT IN THE MOST EFFICIENT MANNER, RETURN THESE DOCUMENTS, MARKED WITH YOUR COMMENTS, WITHIN TWO WEEKS FROM THE ABOVE MENTIONED DATE

ANY CHANGES MADE AFTER APPROVAL OF THESE DRAWINGS MAY DELAY THE FABRICATION AND DELIVERY PROCESS.

THESE DRAWINGS ARE NOT FOR CONSTRUCTION.

1. ☐ APPROVED
NO CHANGES. PROCEED WITH FABRICATION.

2. ☐ APPROVED AS NOTED
FABRICATION MAY PROCEED ON THE BASIS OF CORRECTIONS INDICATED. RESUBMIT AFTER INCORPORATING THE COMMENTS FOR RECORD.

3. ☐ RESUBMIT AFTER INCORPORATING THE COMMENTS FOR REAPPROVAL.

REVIEWED BY .....

NAME

SIGNATURE ..... DATE .....

REV	REVISIONS	DRAWN	DESIGN	DATE
R2	ISSUED FOR RE-APPROVAL	SR	URVISH	17.09.25
R1	ISSUED FOR RE-APPROVAL	SAT/SR	URVISH	20.08.25
R0	ISSUED FOR APPROVAL	SAT/SR	URVISH	25.07.25

Project:
ADANI DEFENCE & AEROSPACE
HYDERABAD

Building:
HELICOPTER COMPLEX (PEB-9)


Drawing Title: END WALL FRAMING ELEVATION @ GL-1 & 7

Architect/Consultant:
M/S ADANI LTD


Client:
M/S ADANI LTD

ARCEDGES BUILDING (INDIA) LLP.
Corporate Office:
505-506, Aamarakunj Avis, Near Tapovan Circle,
Chandkheda, Ahmedabad-382424

Drawn by:	SR		Scale: N.T.S.	Date: 17.09.25	
Checked by:	MMK		Project No:	Drawing No:	Revision:
Designed by:	URVISH		J-388-B2	GA-10	R2
Checked by:	PAD				
Approved by:	ARH				

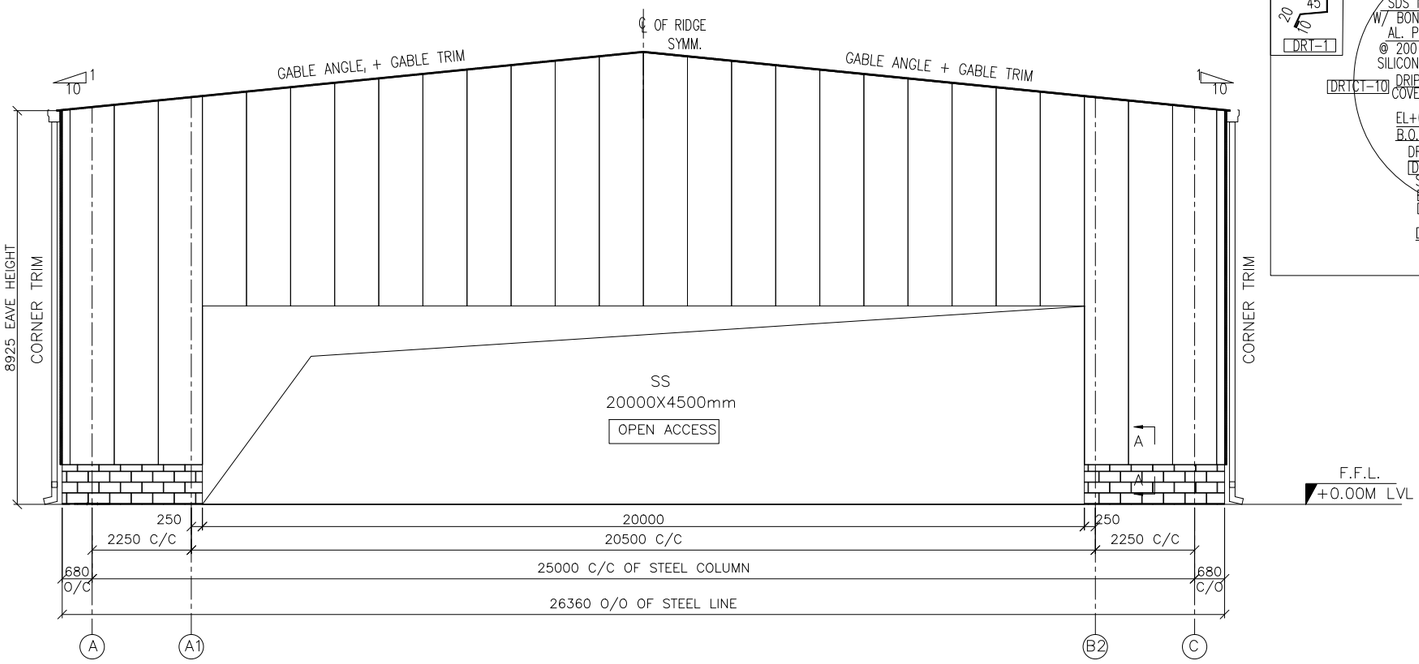

END WALL SHEETING ELEVATION @ GL-1

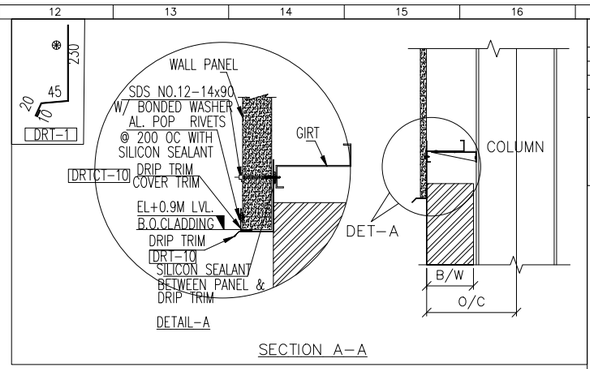


DRAWING CROSS REFERENCE

DRG.NO.	REV	DESCRIPTION

IMPORTANT NOTES

NOTE: – Minor adjustments at site during the installation of crane lacing, bracings, etc., due to slight mismatches in anchor bolt dimensions or fabrication tolerances, are considered a standard part of the erection process.

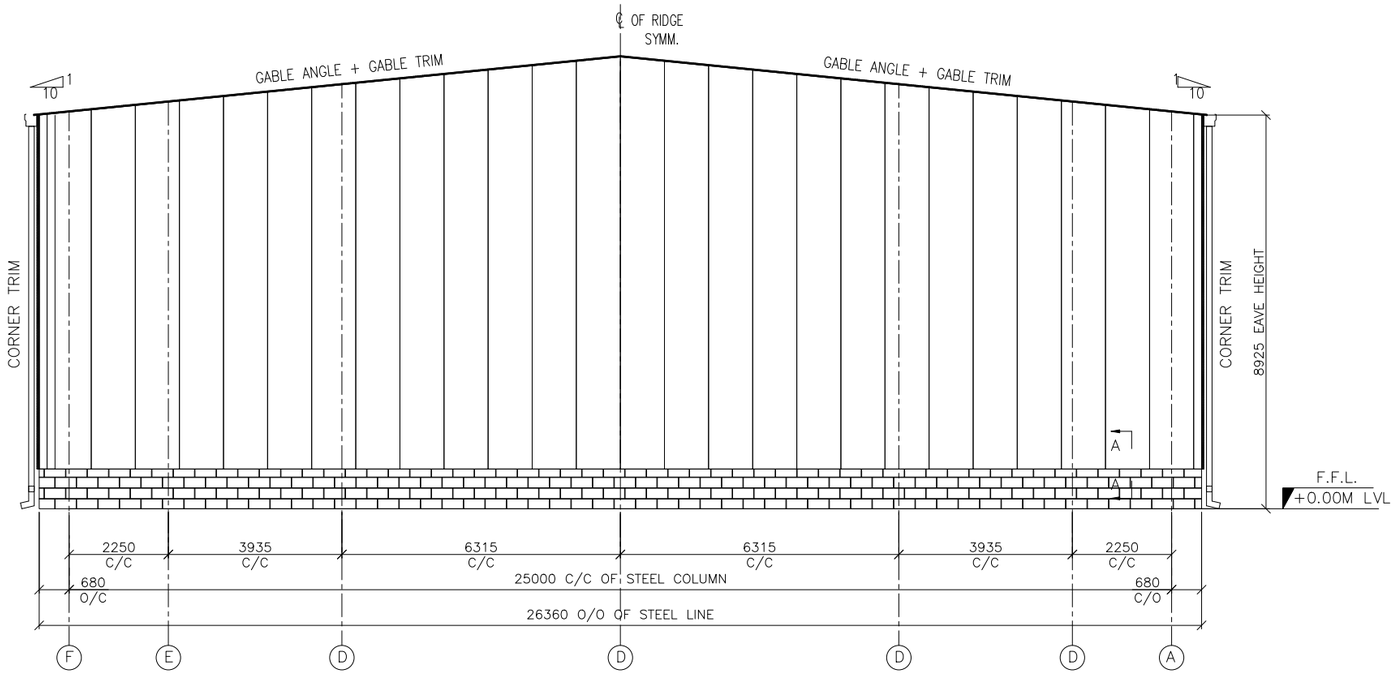

END WALL SHEETING ELEVATION @ GL-7

OPENING SCHEDULE–

DESCRIPTION	WIDTH	HEIGHT	QUANTITY
SS	20000MM.	4500MM.	1 NOS.

ISSUED FOR APPROVAL

SENT ON .....

IN ORDER TO SCHEDULE THIS PROJECT IN THE MOST EFFICIENT MANNER, RETURN THESE DOCUMENTS, MARKED WITH YOUR COMMENTS, WITHIN TWO WEEKS FROM THE ABOVE MENTIONED DATE.

ANY CHANGES MADE AFTER APPROVAL OF THESE DRAWINGS MAY DELAY THE FABRICATION AND DELIVERY PROCESS.

THESE DRAWINGS ARE NOT FOR CONSTRUCTION.

1. ☐ APPROVED
NO CHANGES. PROCEED WITH FABRICATION.
2. ☐ APPROVED AS NOTED
FABRICATION MAY PROCEED ON THE BASIS OF CORRECTIONS INDICATED. RESUBMIT AFTER INCORPORATING THE COMMENTS FOR RECORD.
3. ☐ RESUBMIT AFTER INCORPORATING THE COMMENTS FOR REAPPROVAL.

REVIEWED BY .....
NAME
SIGNATURE ..... DATE .....

REV	REVISIONS	DRAWN	DESIGN	DATE
R2	ISSUED FOR RE-APPROVAL	SR	URVISH	17.09.25
R1	ISSUED FOR RE-APPROVAL	SAT/SR	URVISH	20.08.25
R0	ISSUED FOR APPROVAL	SAT/SR	URVISH	25.07.25

Project:
ADANI DEFENCE & AEROSPACE
HYDERABAD

Building:
HELICOPTER COMPLEX (PEB-9)


Drawing Title: END WALL SHEETING ELEVATION @ GL-1&7

Architect/Consultant:
M/S ADANI LTD

Client:
M/S ADANI LTD


ARC EDGES
ARCEDGES BUILDING (INDIA) LLP.
Corporate Office:
505-506, Aamarakunj Avis, Near Tapovan Circle,
Chandkheda, Ahmedabad-382424


Drawn by:	SR		Scale: N.T.S.	Date: 17.09.25	
Checked by:	MMK		Project No: J-388-B2	Drawing No: GA-11	Revision: R2
Designed by:	URVISH				
Checked by:	PAD				
Approved by:	ARH				

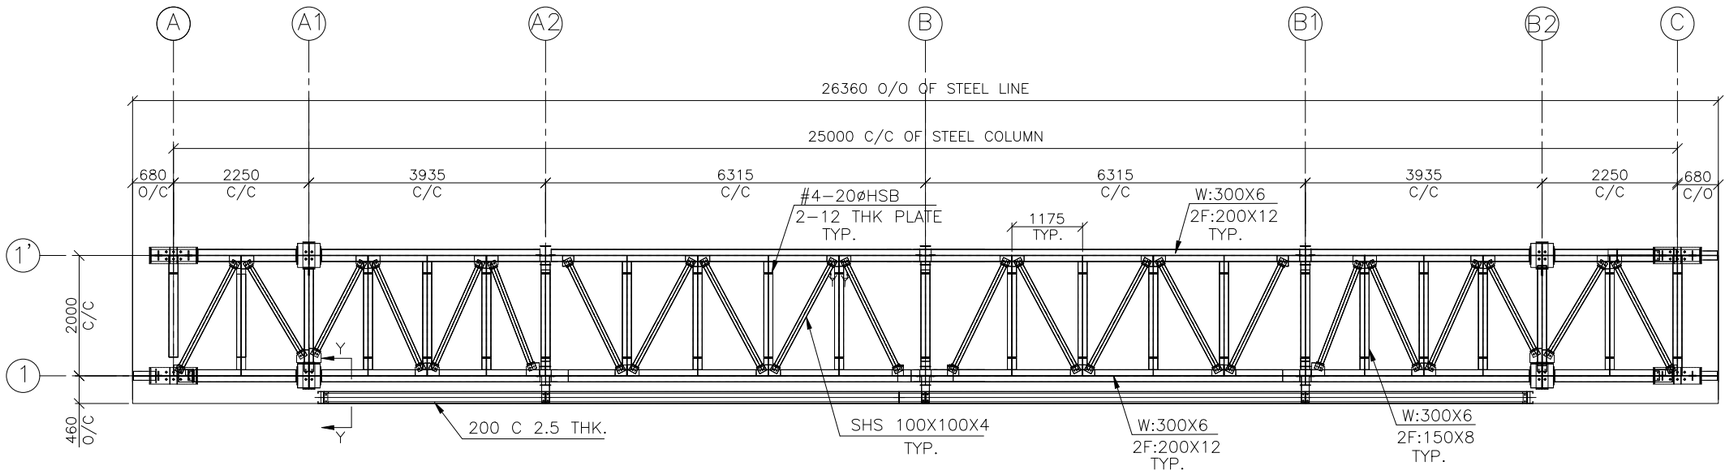


4.824m LEVEL BRACING PLAN

R2

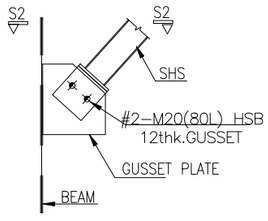

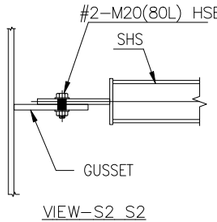

VIEW-S2 S2

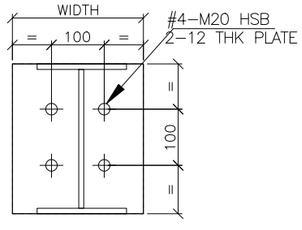

SECTION-Y-Y

DRAWING CROSS REFERENCE

DRG.NO.	REV	DESCRIPTION

IMPORTANT NOTES

ISSUED FOR APPROVAL

SENT ON .....

IN ORDER TO SCHEDULE THIS PROJECT IN THE MOST EFFICIENT MANNER, RETURN THESE DOCUMENTS, MARKED WITH YOUR COMMENTS, WITHIN TWO WEEKS FROM THE ABOVE MENTIONED DATE

ANY CHANGES MADE AFTER APPROVAL OF THESE DRAWINGS MAY DELAY THE FABRICATION AND DELIVERY PROCESS.

THESE DRAWINGS ARE NOT FOR CONSTRUCTION.

1. ☐ APPROVED
   NO CHANGES. PROCEED WITH FABRICATION.
2. ☐ APPROVED AS NOTED
   FABRICATION MAY PROCEED ON THE BASIS OF CORRECTIONS INDICATED. RESUBMIT AFTER INCORPORATING THE COMMENTS FOR RECORD.
3. ☐ RESUBMIT AFTER INCORPORATING THE COMMENTS FOR REAPPROVAL.

REVIEWED BY .....

NAME

SIGNATURE DATE

REV	REVISIONS	DRAWN	DESIGN	DATE
R2	ISSUED FOR RE-APPROVAL	SR	URVISH	17.09.25
R1	ISSUED FOR RE-APPROVAL	SAT/SR	URVISH	20.08.25
R0	ISSUED FOR APPROVAL	SAT/SR	URVISH	25.07.25

Project:
ADANI DEFENCE & AEROSPACE
HYDERABAD

Building: HELICOPTER COMPLEX (PEB-9)


Drawing Title: 4.824m LEVEL BRACING PLAN

Architect/Consultant: M/S ADANI LTD

Client: M/S ADANI LTD

ARCEDGES BUILDING (INDIA) LLP.
Corporate Office:
505-506, Aamarakunj Avis, Near Tapovan Circle,
Chandkheda, Ahmedabad-382424

Drawn by:	SR		Scale: N.T.S.	Date: 17.09.25	
Checked by:	MMK		Project No: J-388-B2	Drawing No: GA-11A	Revision: R2
Designed by:	URVISH				
Checked by:	PAD				
Approved by:	ARH				

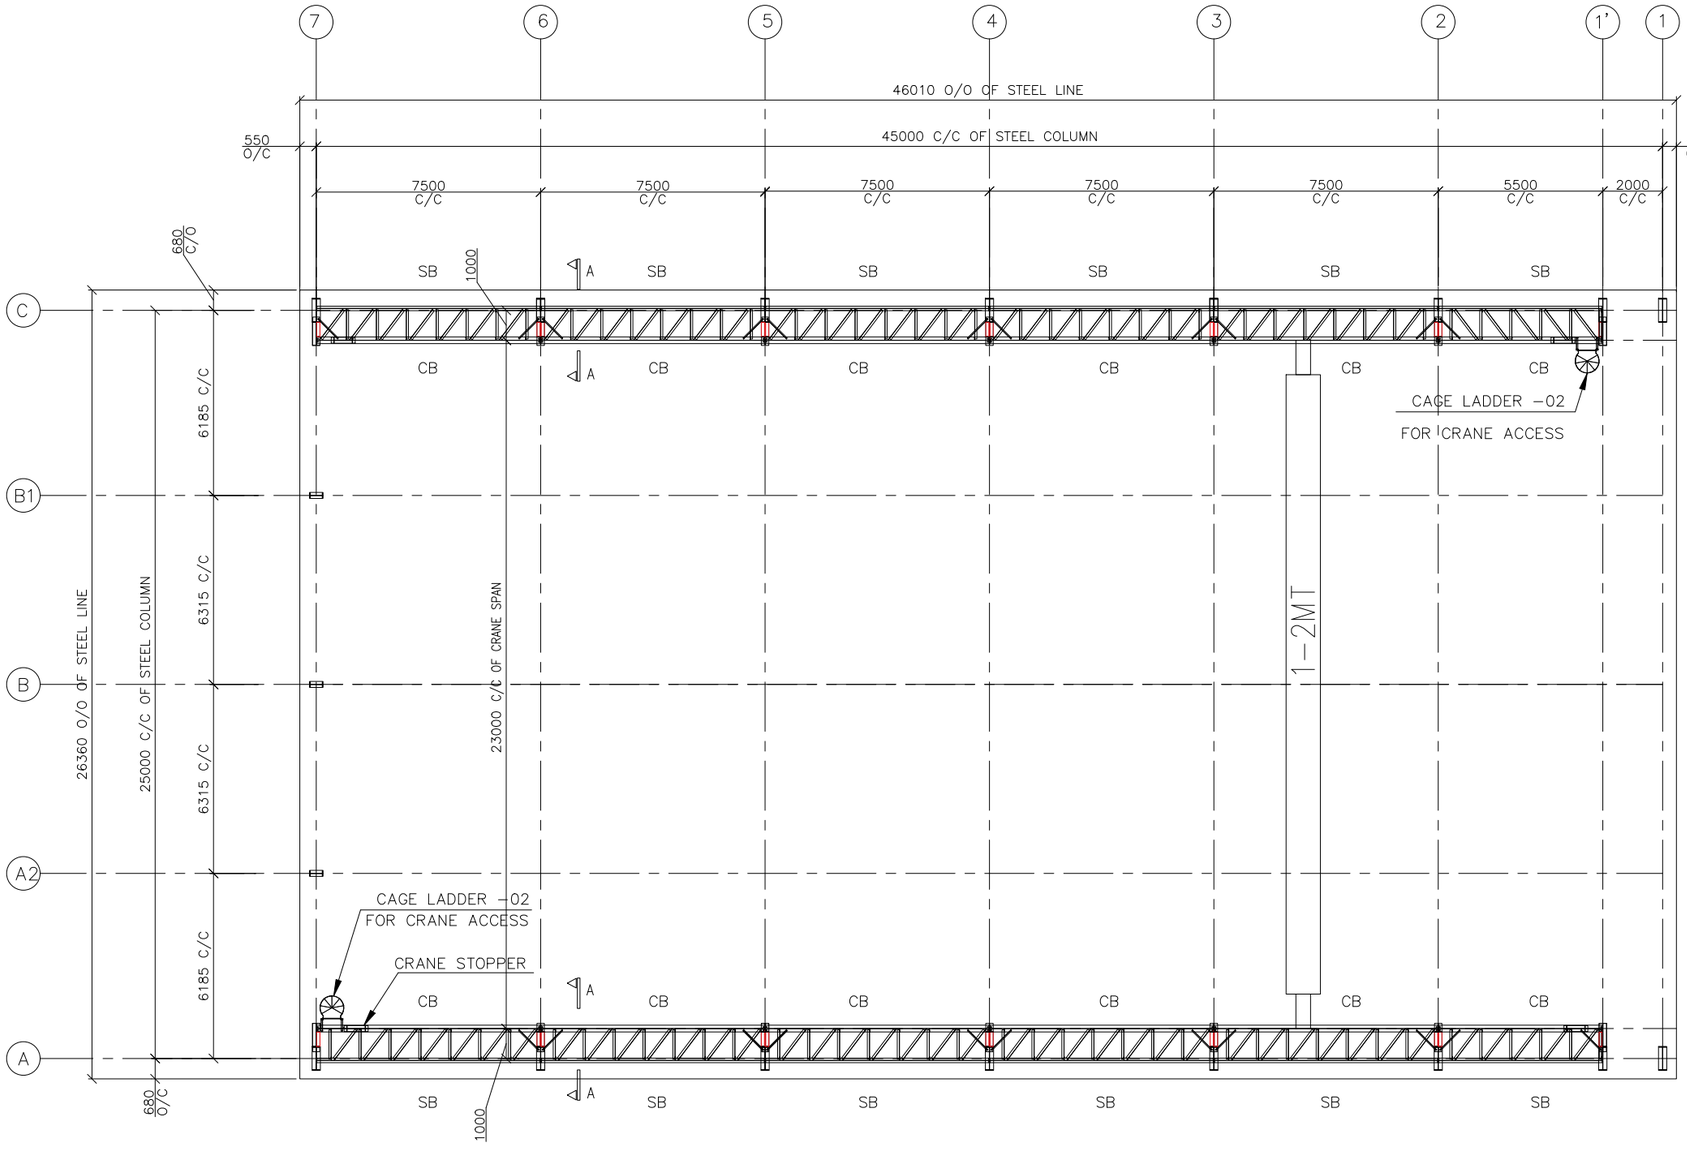

CRANE BEAM PLAN

S.NO	DESCRIPTION	SECTION SIZES
1.	CB	W-600X6 2F-225x14 (600 x 8 250x14)
2.	SB	W-350X6 2F-150X10

NOTE: FINGER SHIMS-BELOW THE CRANE BRACKET
2MM THICK-2NOS-PRE GALVANISED
4MM THICK-1NOS-BLACK HR PLATES

NOTE: FOR CONNECTION DETAIL PLEASE REFER GA-14

NOTE:- CAGE LADDER LOCATION NEED TO CHECK AND CONFIRM BY CUSTOMER.

DRAWING CROSS REFERENCE

DRG.NO.	REV	DESCRIPTION

IMPORTANT NOTES

NOTE:- Minor adjustments at site during the installation of crane lacing, bracings, etc., due to slight mismatches in anchor bolt dimensions or fabrication tolerances, are considered a standard part of the erection process.

ISSUED FOR APPROVAL

SENT ON .....

IN ORDER TO SCHEDULE THIS PROJECT IN THE MOST EFFICIENT MANNER, RETURN THESE DOCUMENTS, MARKED WITH YOUR COMMENTS, WITHIN TWO WEEKS FROM THE ABOVE MENTIONED DATE.

ANY CHANGES MADE AFTER APPROVAL OF THESE DRAWINGS MAY DELAY THE FABRICATION AND DELIVERY PROCESS.

THESE DRAWINGS ARE NOT FOR CONSTRUCTION.

1. ☐ APPROVED
NO CHANGES. PROCEED WITH FABRICATION.

2. ☐ APPROVED AS NOTED
FABRICATION MAY PROCEED ON THE BASIS OF CORRECTIONS INDICATED. RESUBMIT AFTER INCORPORATING THE COMMENTS FOR RECORD.

3. ☐ RESUBMIT AFTER INCORPORATING THE COMMENTS FOR REAPPROVAL.

REVIEWED BY .....
NAME
SIGNATURE DATE

REV	REVISIONS	DRAWN	DESIGN	DATE
R2	ISSUED FOR RE-APPROVAL	SR	URVISH	17.09.25
R1	ISSUED FOR RE-APPROVAL	SAT/SR	URVISH	20.08.25
R0	ISSUED FOR APPROVAL	SAT/SR	URVISH	25.07.25

Project: ADANI DEFENCE & AEROSPACE HYDERABAD

Building: HELICOPTER COMPLEX (PEB-9)


Drawing Title: CRANE BEAM PLAN


Architect/Consultant: M/S ADANI LTD

Client: M/S ADANI LTD

ARCEDGES BUILDING (INDIA) LLP.
Corporate Office:
505-506, Aamarakunj Avis, Near Tapovan Circle, Chandkheda, Ahmedabad-382424


Drawn by:	SR		Scale: N.T.S.	Date: 17.09.25	
Checked by:	MMK		Project No:	Drawing No:	Revision:
Designed by:	URVISH		J-388-B2	GA-12	R2
Checked by:	PAD				
Approved by:	ARH				

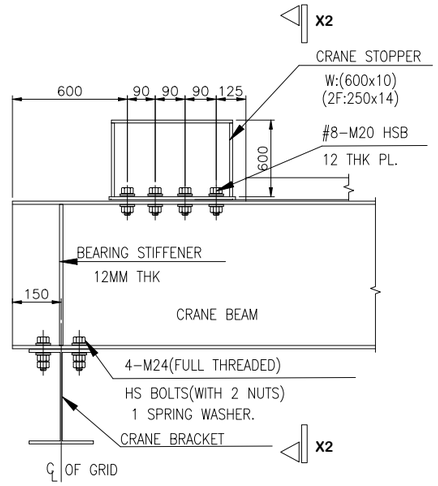

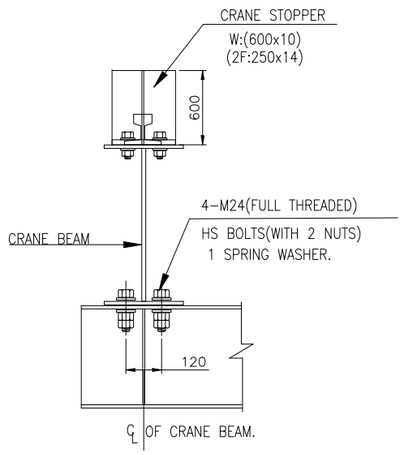

SECTION X2-X2


TYP. CRANE STOPPER DETAILS

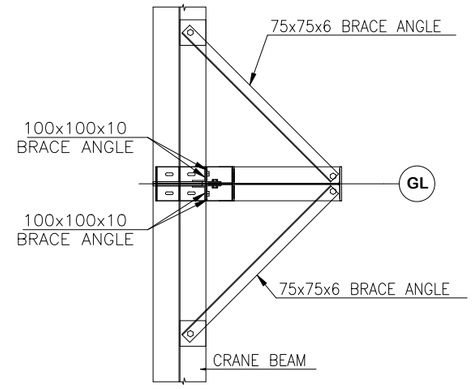


ALL BOLTS ARE 24 DIA(U.N.O)

CRANE BEAM BRACE CONNECTION @ COLUMN


This connection will be reviewed in tekla model & will be confirmed at later stage

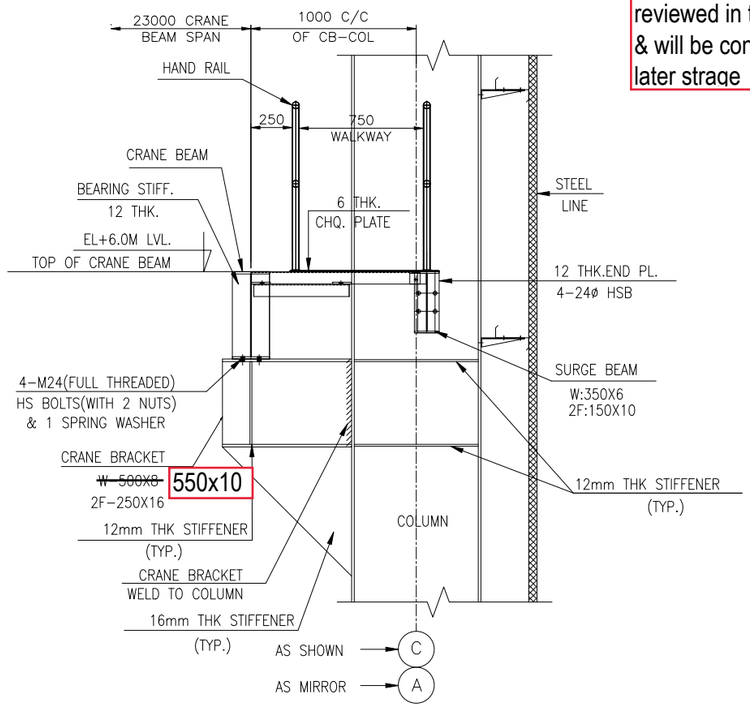


SECTION A-A

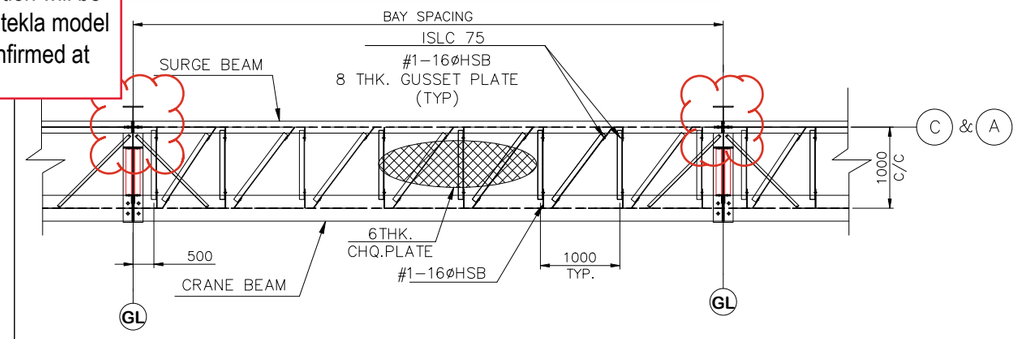

TYP. CRANE BEAM LACING DETAIL ALONG AXIS -A&F

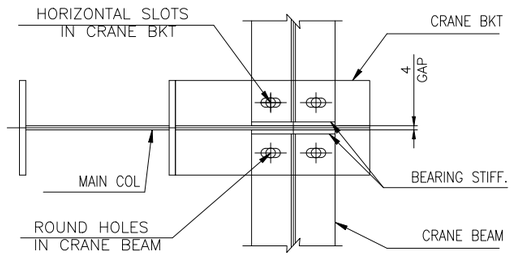

CRANE BKT TO CRANE BEAM DETAIL

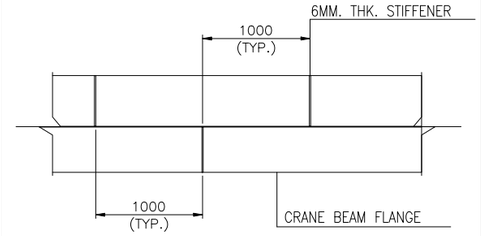

TYP. STIFFINER DETAIL IN CRANE BEAMS

DRAWING CROSS REFERENCE

DRG.NO.	REV	DESCRIPTION

IMPORTANT NOTES

NOTE:- Minor adjustments at site during the installation of crane lacing, bracings, etc., due to slight mismatches in anchor bolt dimensions or fabrication tolerances, are considered a standard part of the erection process.

ISSUED FOR APPROVAL

SENT ON .....

IN ORDER TO SCHEDULE THIS PROJECT IN THE MOST EFFICIENT MANNER, RETURN THESE DOCUMENTS, MARKED WITH YOUR COMMENTS, WITHIN TWO WEEKS FROM THE ABOVE MENTIONED DATE.

ANY CHANGES MADE AFTER APPROVAL OF THESE DRAWINGS MAY DELAY THE FABRICATION AND DELIVERY PROCESS.

THESE DRAWINGS ARE NOT FOR CONSTRUCTION.

1. ☐ APPROVED
NO CHANGES. PROCEED WITH FABRICATION.

2. ☐ APPROVED AS NOTED
FABRICATION MAY PROCEED ON THE BASIS OF CORRECTIONS RESTATED. AFTER INCORPORATING THE COMMENTS FOR RECORD.

3. ☐ RESUBMIT AFTER INCORPORATING THE COMMENTS FOR REAPPROVAL.

REVIEWED BY .....
NAME
SIGNATURE ..... DATE .....

REV	REVISIONS	DRAWN	DESIGN	DATE
R2	ISSUED FOR RE-APPROVAL	SR	URVISH	17.09.25
R1	ISSUED FOR RE-APPROVAL	SAT/SR	URVISH	20.08.25
R0	ISSUED FOR APPROVAL	SAT/SR	URVISH	25.07.25

Project:
ADANI DEFENCE & AEROSPACE
HYDERABAD

Building:
HELICOPTER COMPLEX (PEB-9)


Drawing Title: CRANE BEAM DETAILS

Architect/Consultant:
M/S ADANI LTD


Client:
M/S ADANI LTD


ARCEDGES
ARCEDGES BUILDING (INDIA) LLP.
Corporate Office:
505-506, Aamarakunj Avis, Near Tapovan Circle,
Chandkheda, Ahmedabad-382424

Drawn by:	SR		Scale: N.T.S.	Date: 17.09.25	
Checked by:	MMK		Project No:	Drawing No:	Revision:
Designed by:	URVISH		J-388-B2	GA-13	R2
Checked by:	PAD				
Approved by:	ARH				

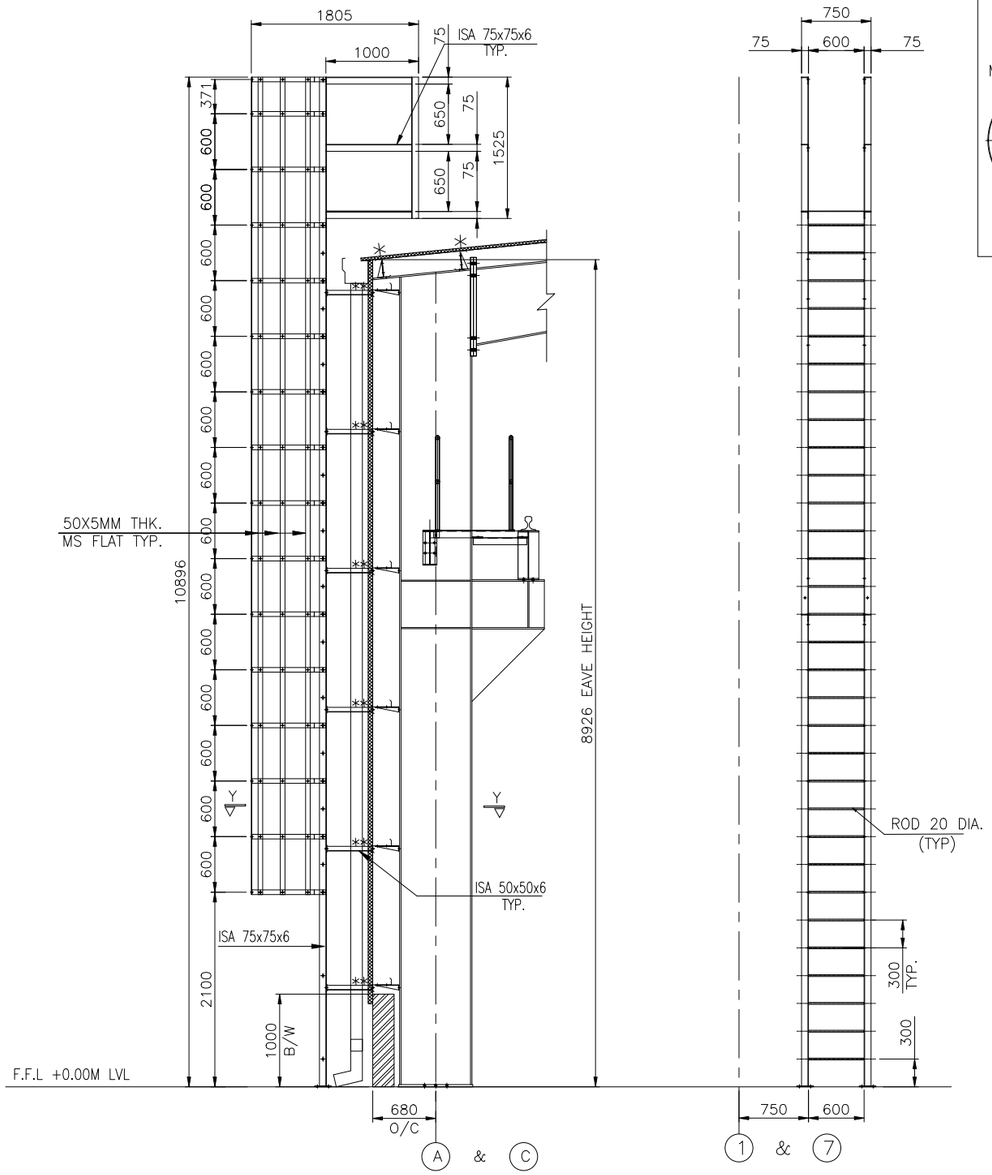


CAGE LADDER -1
ELEVATION

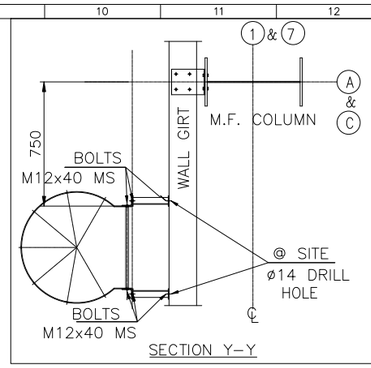


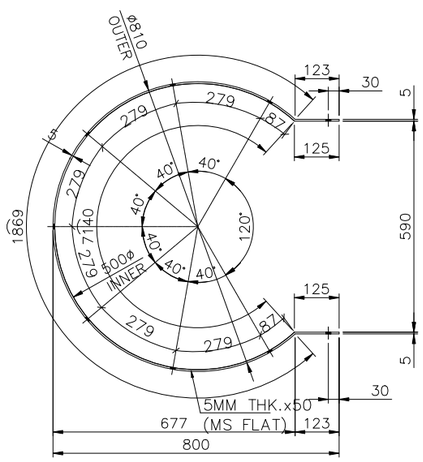


CAGE DETAIL

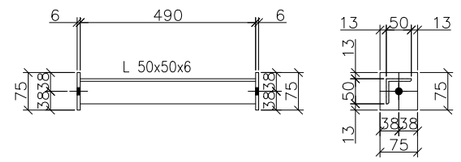

CONNECTION DETAIL

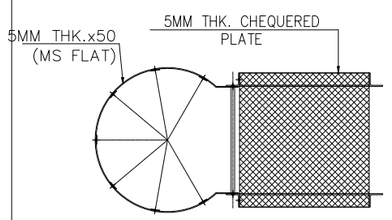

SECTION A-A

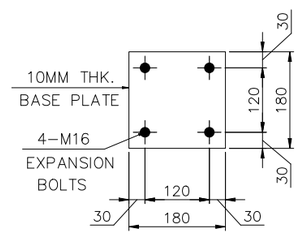

BASE PLATE DETAIL

DRAWING CROSS REFERENCE

DRG.NO.	REV	DESCRIPTION

IMPORTANT NOTES

ISSUED FOR APPROVAL

SENT ON .....

IN ORDER TO SCHEDULE THIS PROJECT IN THE MOST EFFICIENT MANNER, RETURN THESE DOCUMENTS, MARKED WITH YOUR COMMENTS, WITHIN TWO WEEKS FROM THE ABOVE MENTIONED DATE.

ANY CHANGES MADE AFTER APPROVAL OF THESE DRAWINGS MAY DELAY THE FABRICATION AND DELIVERY PROCESS.

THESE DRAWINGS ARE NOT FOR CONSTRUCTION.

1. ☐ APPROVED
   NO CHANGES. PROCEED WITH FABRICATION.
2. ☐ APPROVED AS NOTED
   FABRICATION MAY PROCEED ON THE BASIS OF CORRECTIONS INDICATED. RESUBMIT AFTER INCORPORATING THE COMMENTS FOR RECORD.
3. ☐ RESUBMIT AFTER INCORPORATING THE COMMENTS FOR REAPPROVAL.

REVIEWED BY .....

NAME

....

SIGNATURE DATE

REV	REVISIONS	DRAWN	DESIGN	DATE
R2	ISSUED FOR RE-APPROVAL	SR	URVISH	17.09.25
R1	ISSUED FOR RE-APPROVAL	SAT/SR	URVISH	20.08.25
R0	ISSUED FOR APPROVAL	SAT/SR	URVISH	25.07.25

Project:
ADANI DEFENCE & AEROSPACE
HYDERABAD

Building:
HELICOPTER COMPLEX (PEB-9)


Drawing Title: CAGE LADDER-1 FOR ROOF ACCESS

Architect/Consultant:
M/S ADANI LTD

Client:
M/S ADANI LTD


ARCEDGES BUILDING (INDIA) LLP.
Corporate Office:
505-506, Aamarakunj Avis, Near Tapovan Circle,
Chandkheda, Ahmedabad-382424

Drawn by:	SR		Scale: N.T.S.	Date: 17.09.25	
Checked by:	MMK		Project No: J-388-B2	Drawing No: GA-14	Revision: R2
Designed by:	URVISH				
Checked by:	PAD				
Approved by:	ARH				

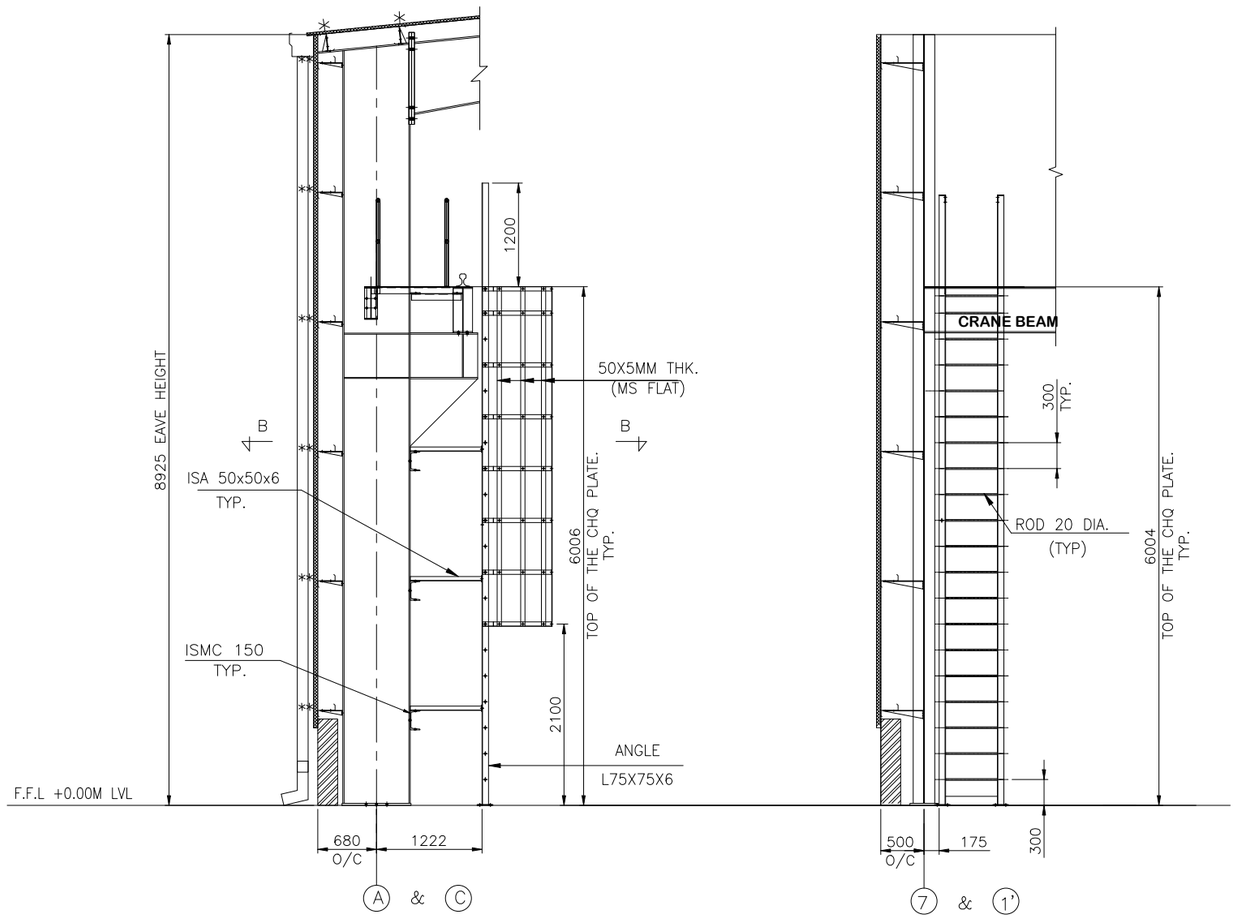


CAGE LADDER-2 FOR CRANE ACCESS (QTY = 2 NO'S)


CAGE LADDER-2 ELEVATION

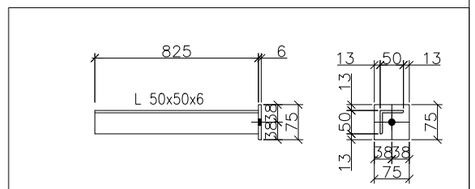


CONNECTION DETAIL

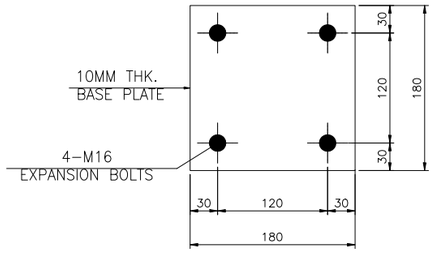

BASE PLATE DETAIL

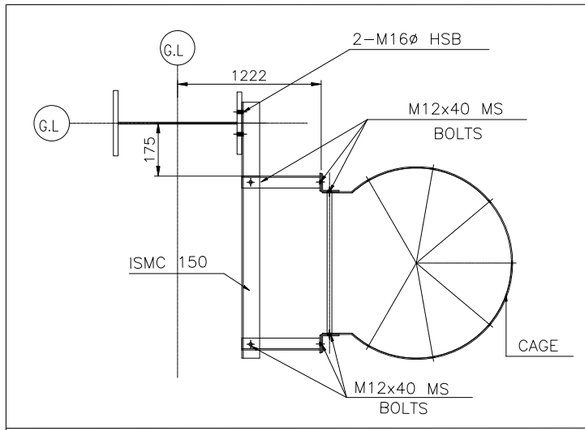

SECTION B-B

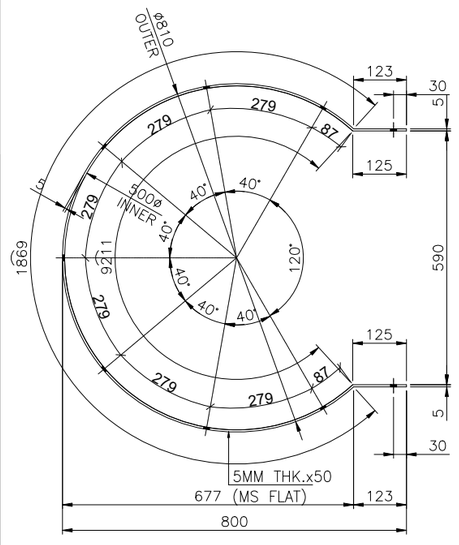

CAGE DETAIL

DRAWING CROSS REFERENCE

DRG.NO.	REV	DESCRIPTION

IMPORTANT NOTES

ISSUED FOR APPROVAL

SENT ON .....

IN ORDER TO SCHEDULE THIS PROJECT IN THE MOST EFFICIENT MANNER, RETURN THESE DOCUMENTS, MARKED WITH YOUR COMMENTS, WITHIN TWO WEEKS FROM THE ABOVE MENTIONED DATE

ANY CHANGES MADE AFTER APPROVAL OF THESE DRAWINGS MAY DELAY THE FABRICATION AND DELIVERY PROCESS.

THESE DRAWINGS ARE NOT FOR CONSTRUCTION.

1. ☐ APPROVED
   NO CHANGES. PROCEED WITH FABRICATION.
2. ☐ APPROVED AS NOTED
   FABRICATION MAY PROCEED ON THE BASIS OF CORRECTIONS INDICATED. AFTER INCORPORATING THE COMMENTS FOR RECORD.
3. ☐ RESUBMIT AFTER INCORPORATING THE COMMENTS FOR REAPPROVAL.

REVIEWED BY .....

NAME

SIGNATURE ..... DATE .....

REV	REVISIONS	DRAWN	DESIGN	DATE
R2	ISSUED FOR RE-APPROVAL	SR	URVISH	17.09.25
R1	ISSUED FOR RE-APPROVAL	SAT/SR	URVISH	20.08.25
R0	ISSUED FOR APPROVAL	SAT/SR	URVISH	25.07.25

Project:
ADANI DEFENCE & AEROSPACE
HYDERABAD

Building:
HELICOPTER COMPLEX (PEB-9)


Drawing Title: CAGE LADDER-2 FOR CRANE ACCESS

Architect/Consultant: M/S ADANI LTD


Client: M/S ADANI LTD

ARCEDGES BUILDING (INDIA) LLP.
Corporate Office:
505-506, Aamarakunj Avis, Near Tapovan Circle,
Chandkheda, Ahmedabad-382424


Drawn by:	SR		Scale: N.T.S.	Date: 17.09.25	
Checked by:	MMK		Project No:	Drawing No:	Revision:
Designed by:	URVISH		J-388-B2	GA-15	R2
Checked by:	PAD				
Approved by:	ARH				

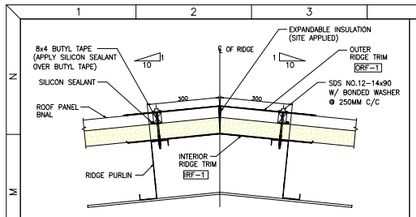


RIDGE DETAIL (BNAL PROFILE)

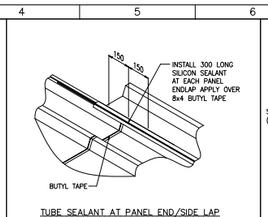


TUBE SEALANT AT PANEL END/SIDE LAP BNAL PROFILE

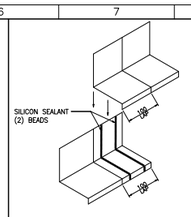


TYPICAL FLASHING "Z" LAP CONDITION

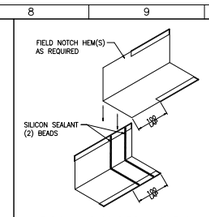


TYPICAL LAP CONDITION W/ HEMS

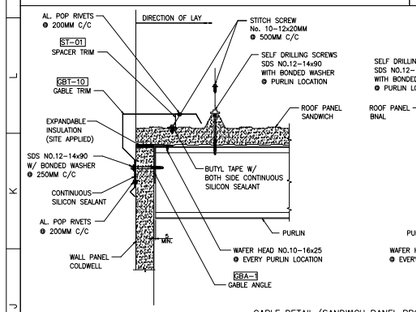



GABLE DETAIL (SANDWICH PANEL PROFILE)

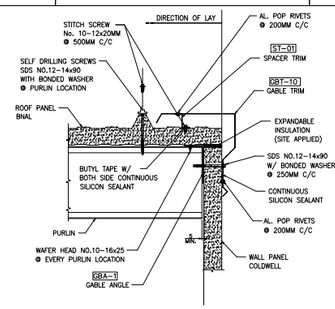


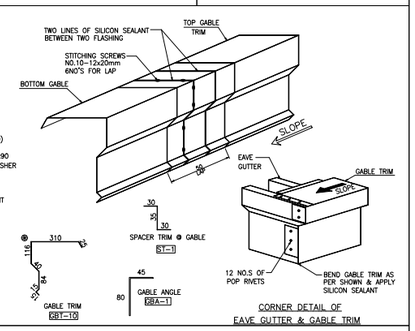


CORNER DETAIL OF EAVE GUTTER & GABLE TRIM

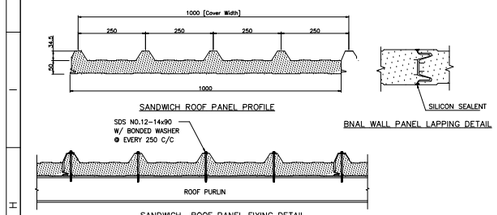

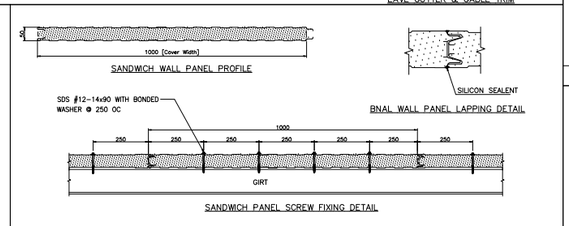

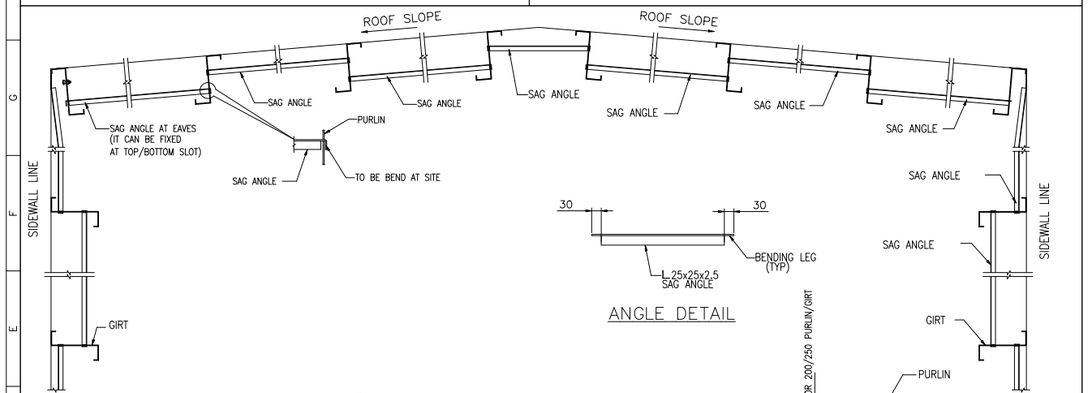

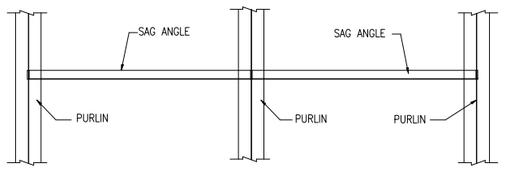



PLAN


TYP.PUNCHING DETAILS

TYP. SAG ANGLE FIXING DETAIL


SAG ANGLE FIXING DETAIL

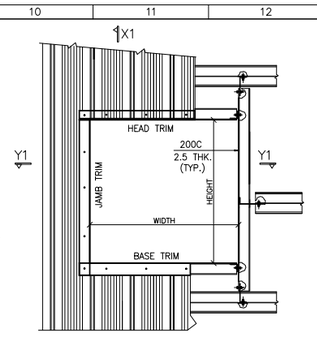


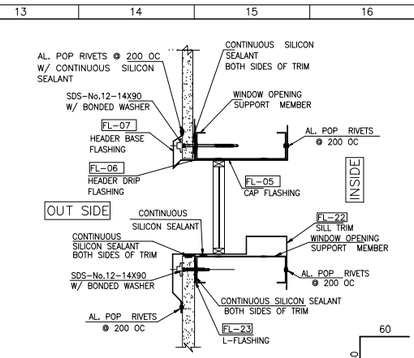


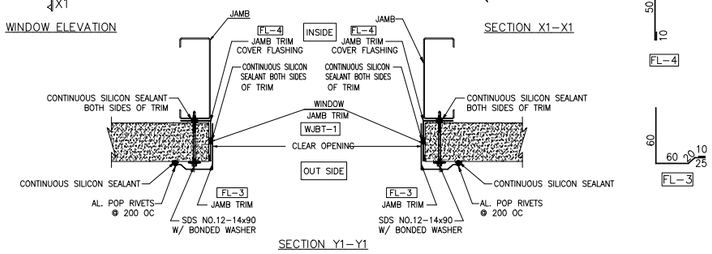


TYP. WINDOW OPENING DETAIL

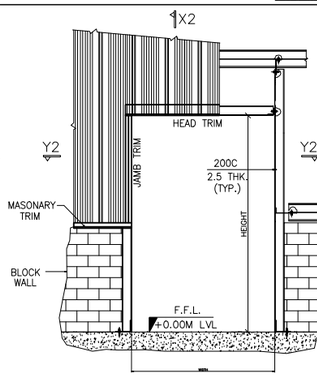

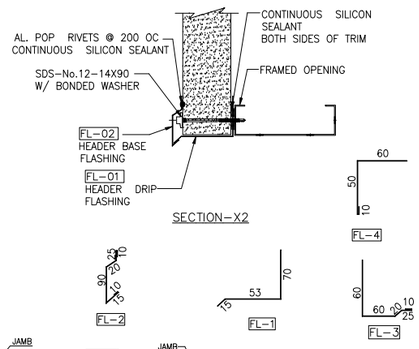

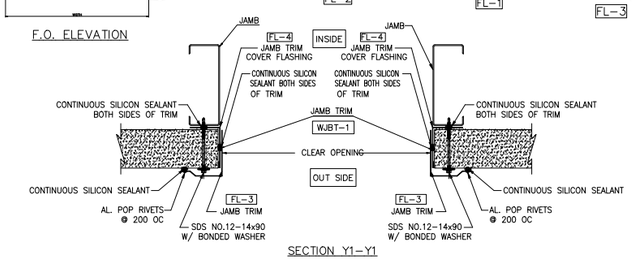

TYP. FRAMED OPENING DETAIL

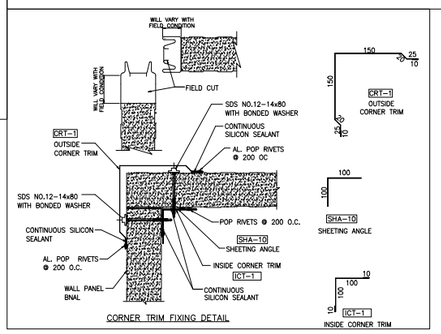

CORNER TRIM FIXING DETAIL

DRAWING CROSS REFERENCE

DRG.NO.	REV	DESCRIPTION

IMPORTANT NOTES

ISSUED FOR APPROVAL

SENT ON .....

IN ORDER TO SCHEDULE THIS PROJECT IN THE MOST EFFICIENT MANNER, RETURN THESE DOCUMENTS, MARKED WITH YOUR COMMENTS, WITHIN TWO WEEKS FROM THE ABOVE MENTIONED DATE.

ANY CHANGES MADE AFTER APPROVAL OF THESE DRAWINGS MAY DELAY THE FABRICATION AND DELIVERY PROCESS.

THESE DRAWINGS ARE NOT FOR CONSTRUCTION.

1. ☐ APPROVED
   NO CHANGES. PROCEED WITH FABRICATION.
2. ☐ APPROVED AS NOTED
   FABRICATION MAY PROCEED ON THE BASIS OF CORRECTIONS RECOMMD. AFTER INCORPORATING THE COMMENTS FOR RECORD.
3. ☐ RESUBMIT AFTER INCORPORATING THE COMMENTS FOR REAPPROVAL.

REVIEWED BY .....

NAME

SIGNATURE ..... DATE .....

REV	REVISIONS	DRAWN	DESIGN	DATE
R2	ISSUED FOR RE-APPROVAL	SR	URVISH	17.09.25
R1	ISSUED FOR RE-APPROVAL	SAT/SR	URVISH	20.08.25
R0	ISSUED FOR APPROVAL	SAT/SR	URVISH	25.07.25

Project:
ADANI DEFENCE & AEROSPACE
HYDERABAD

Building:
HELICOPTER COMPLEX (PEB-9)


Drawing Title: DETAILS-1

Architect/Consultant:
M/S ADANI LTD

Client:
M/S ADANI LTD

ARCEDGES BUILDING (INDIA) LLP.
Corporate Office:
505-506, Aamarakunj Avis, Near Tapovan Circle,
Chandkheda, Ahmedabad-382424


Drawn by:	SR		Scale: N.T.S.	Date: 17.09.25	
Checked by:	MMK		Project No: J-388-B2	Drawing No: GA-16	Revision: R2
Designed by:	URVISH				
Checked by:	PAD				
Approved by:	ARH				

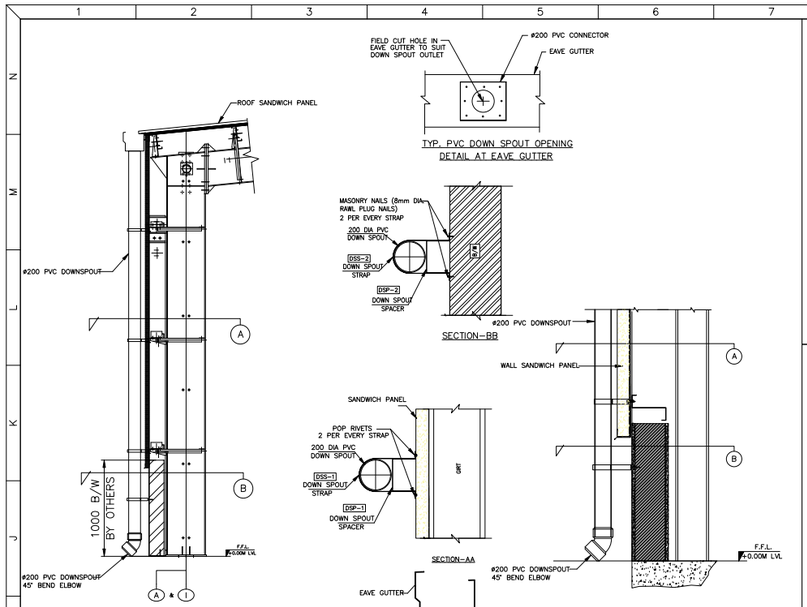

DOWNSPOUT ARRANGEMENT DETAILS @ AXIS A&I G.L-1 TO 15


TYP. PVC DOWN SPOUT OPENING DETAIL AT EAVE GUTTER

SECTION-BB

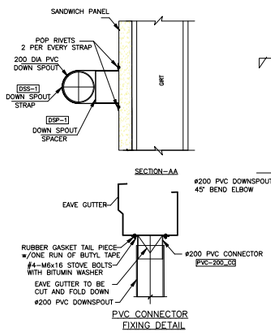


PVC CONNECTOR FIXING DETAIL

DOWNSPOUT ARRANGEMENT DETAILS

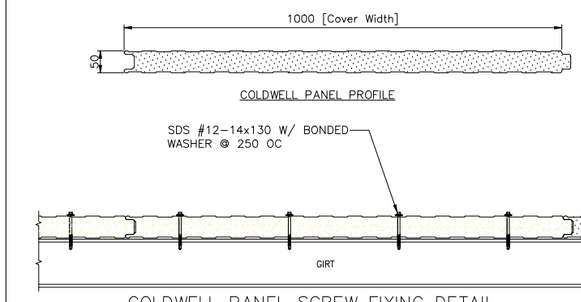


COLDWELL PANEL PROFILE


COLDWELL PANEL SCREW FIXING DETAIL

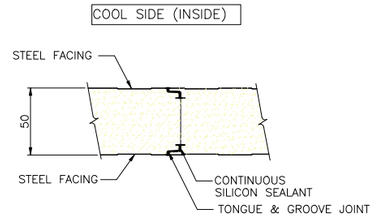


COLDWELL WALL PANEL LAPPING DETAIL

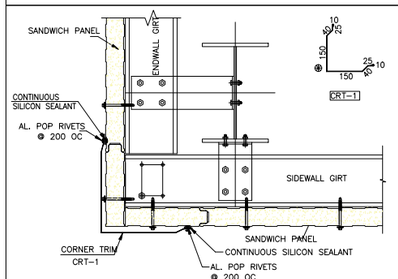


CORNER TRIM FIXING DETAIL

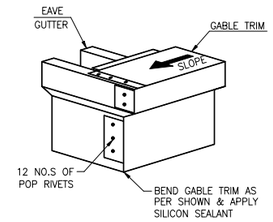


CORNER DETAIL OF EAVE GUTTER & GABLE TRIM

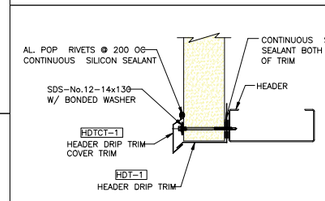


DOOR OPENING HEADER DETAIL

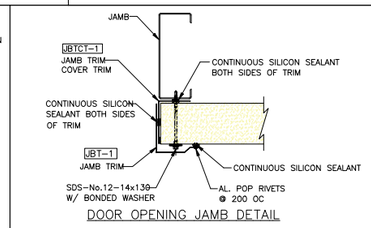

DOOR OPENING JAMB DETAIL

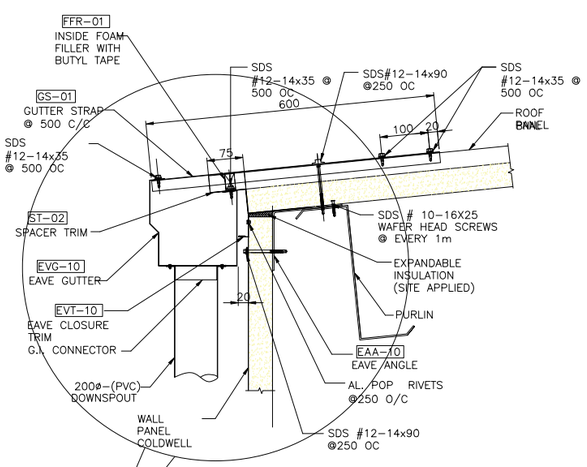


EAVES GUTTER DETAIL

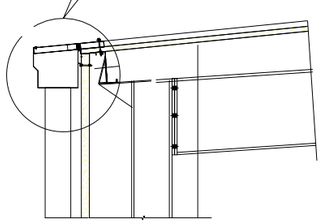


TYPICAL EAVE GUTTER DETAIL


G.L-A &C

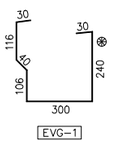



EVG-1

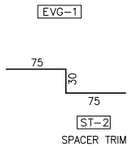

ST-2 SPACER TRIM

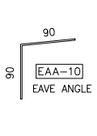

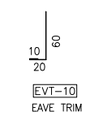

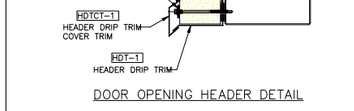


MASONRY DETAILL



NOTE: TO ENSURE CORRECT PANEL INSTALLATION, ROOF PURLINS MUST BE CORRECTLY ALIGNED PRIOR TO INSERTION OF FIXINGS

NOTE: TO ENSURE CORRECT PANEL INSTALLATION, ROOF PURLINS MUST BE CORRECTLY ALIGNED PRIOR TO INSERTION OF FIXINGS

ROOF PANEL SIDELAP DETAIL (BNAL PROFILE)

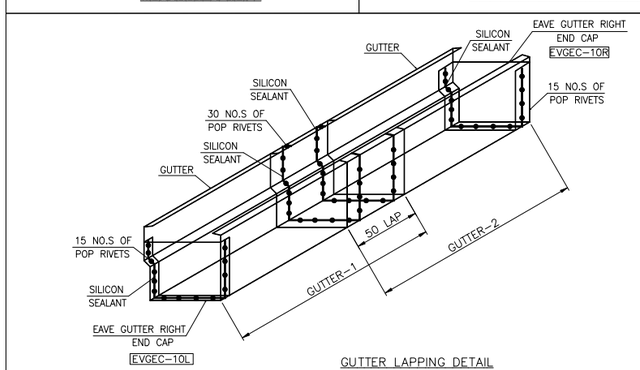

GUTTER LAPPING DETAIL

DRAWING CROSS REFERENCE

DRG.NO.	REV	DESCRIPTION

IMPORTANT NOTES

ISSUED FOR APPROVAL

SENT ON .....

IN ORDER TO SCHEDULE THIS PROJECT IN THE MOST EFFICIENT MANNER, RETURN THESE DOCUMENTS, MARKED WITH YOUR COMMENTS, WITHIN TWO WEEKS FROM THE ABOVE MENTIONED DATE

ANY CHANGES MADE AFTER APPROVAL OF THESE DRAWINGS MAY DELAY THE FABRICATION AND DELIVERY PROCESS.

THESE DRAWINGS ARE NOT FOR CONSTRUCTION.

1. ☐ APPROVED
   NO CHANGES. PROCEED WITH FABRICATION.
2. ☐ APPROVED AS NOTED
   FABRICATION MAY PROCEED ON THE BASIS OF CORRECTIONS NOTED. RESUBMIT AFTER INCORPORATING THE COMMENTS FOR RECORD.
3. ☐ RESUBMIT AFTER INCORPORATING THE COMMENTS FOR REAPPROVAL.

REVIEWED BY .....

NAME .....

SIGNATURE ..... DATE .....

REV	REVISIONS	DRAWN	DESIGN	DATE
R2	ISSUED FOR RE-APPROVAL	SR	URVISH	17.09.25
R1	ISSUED FOR RE-APPROVAL	SAT/SR	URVISH	20.08.25
R0	ISSUED FOR APPROVAL	SAT/SR	URVISH	25.07.25

Project: ADANI DEFENCE & AEROSPACE HYDERABAD

Building: HELICOPTER COMPLEX (PEB-9)


Drawing Title: DETAILS-2


Architect/Consultant: M/S ADANI LTD


Client: M/S ADANI LTD


ARCEDGES BUILDING (INDIA) LLP.
Corporate Office:
505-506, Aamarakunj Avis, Near Tapovan Circle, Chandkheda, Ahmedabad-382424

Drawn by:	SR		Scale: N.T.S.	Date: 17.09.25	
Checked by:	MMK		Project No: J-388-B2	Drawing No: GA-17	Revision: R2
Designed by:	URVISH				
Checked by:	PAD				
Approved by:	ARH				

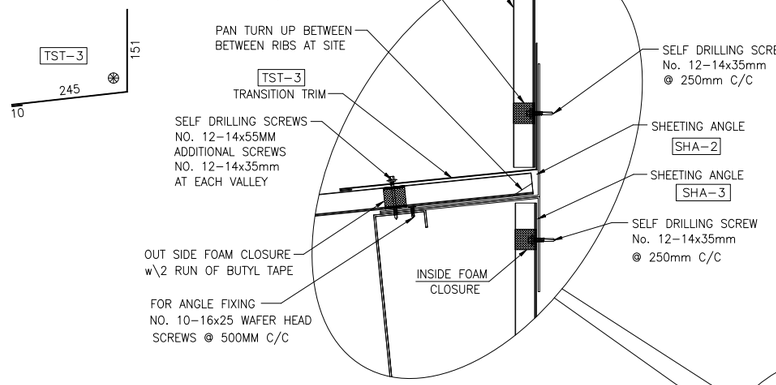


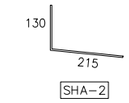


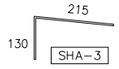


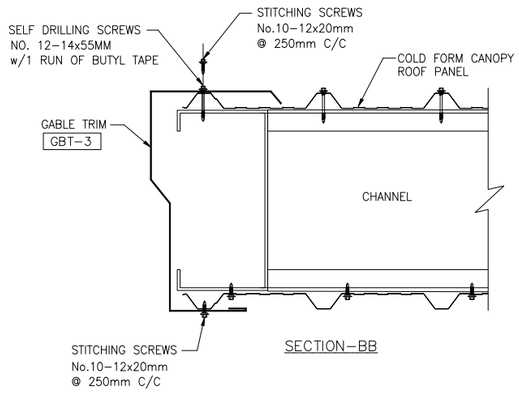



SECTION-BB

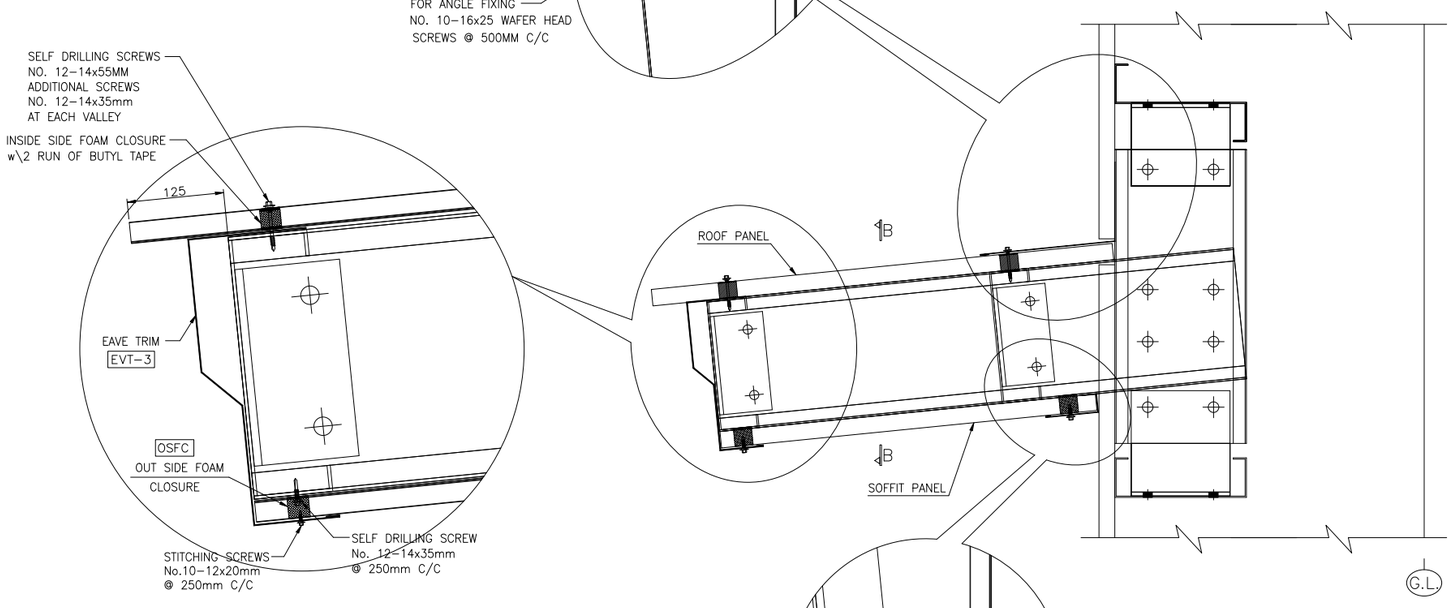

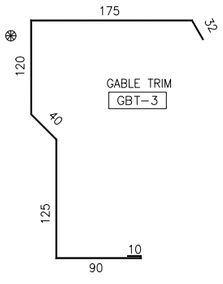

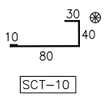

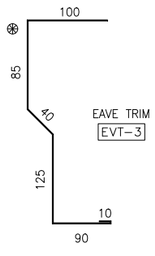

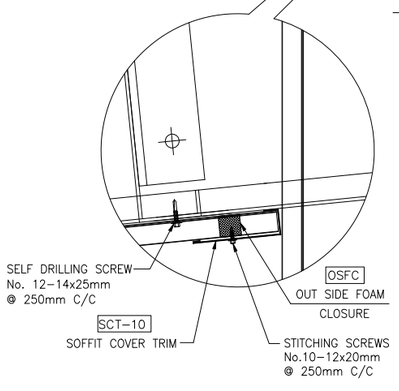

COLD FORM CANOPY WITH SOFFIT DETAIL

DRAWING CROSS REFERENCE

DRG.NO.	REV	DESCRIPTION

IMPORTANT NOTES

ISSUED FOR APPROVAL

SENT ON .....

IN ORDER TO SCHEDULE THIS PROJECT IN THE MOST EFFICIENT MANNER, RETURN THESE DOCUMENTS, MARKED WITH YOUR COMMENTS, WITHIN TWO WEEKS FROM THE ABOVE MENTIONED DATE.

ANY CHANGES MADE AFTER APPROVAL OF THESE DRAWINGS MAY DELAY THE FABRICATION AND DELIVERY PROCESS.

THESE DRAWINGS ARE NOT FOR CONSTRUCTION.

1. ☐ APPROVED
   NO CHANGES. PROCEED WITH FABRICATION.
2. ☐ APPROVED AS NOTED
   FABRICATION MAY PROCEED ON THE BASIS OF CORRECTIONS RESTATED. AFTER INCORPORATING THE COMMENTS FOR RECORD.
3. ☐ RESUBMIT AFTER INCORPORATING THE COMMENTS FOR REAPPROVAL.

REVIEWED BY .....

NAME

....

SIGNATURE DATE

REV	REVISIONS	DRAWN	DESIGN	DATE
R2	ISSUED FOR RE-APPROVAL	SR	URVISH	17.09.25
R1	ISSUED FOR RE-APPROVAL	SAT/SR	URVISH	20.08.25
R0	ISSUED FOR APPROVAL	SAT/SR	URVISH	25.07.25

Project:
ADANI DEFENCE & AEROSPACE
HYDERABAD

Building: HELICOPTER COMPLEX (PEB-9)

Drawing Title: DETAILS-3

Architect/Consultant: M/S ADANI LTD

Client: M/S ADANI LTD

ARCEDGES BUILDING (INDIA) LLP.
Corporate Office:
505-506, Aamarakunj Avis, Near Tapovan Circle,
Chandkheda, Ahmedabad-382424

Drawn by:	SR		Scale: N.T.S.	Date: 17.09.25	
Checked by:	MMK		Project No: J-388-B2	Drawing No: GA-18	Revision: R2
Designed by:	URVISH				
Checked by:	PAD				
Approved by:	ARH				