
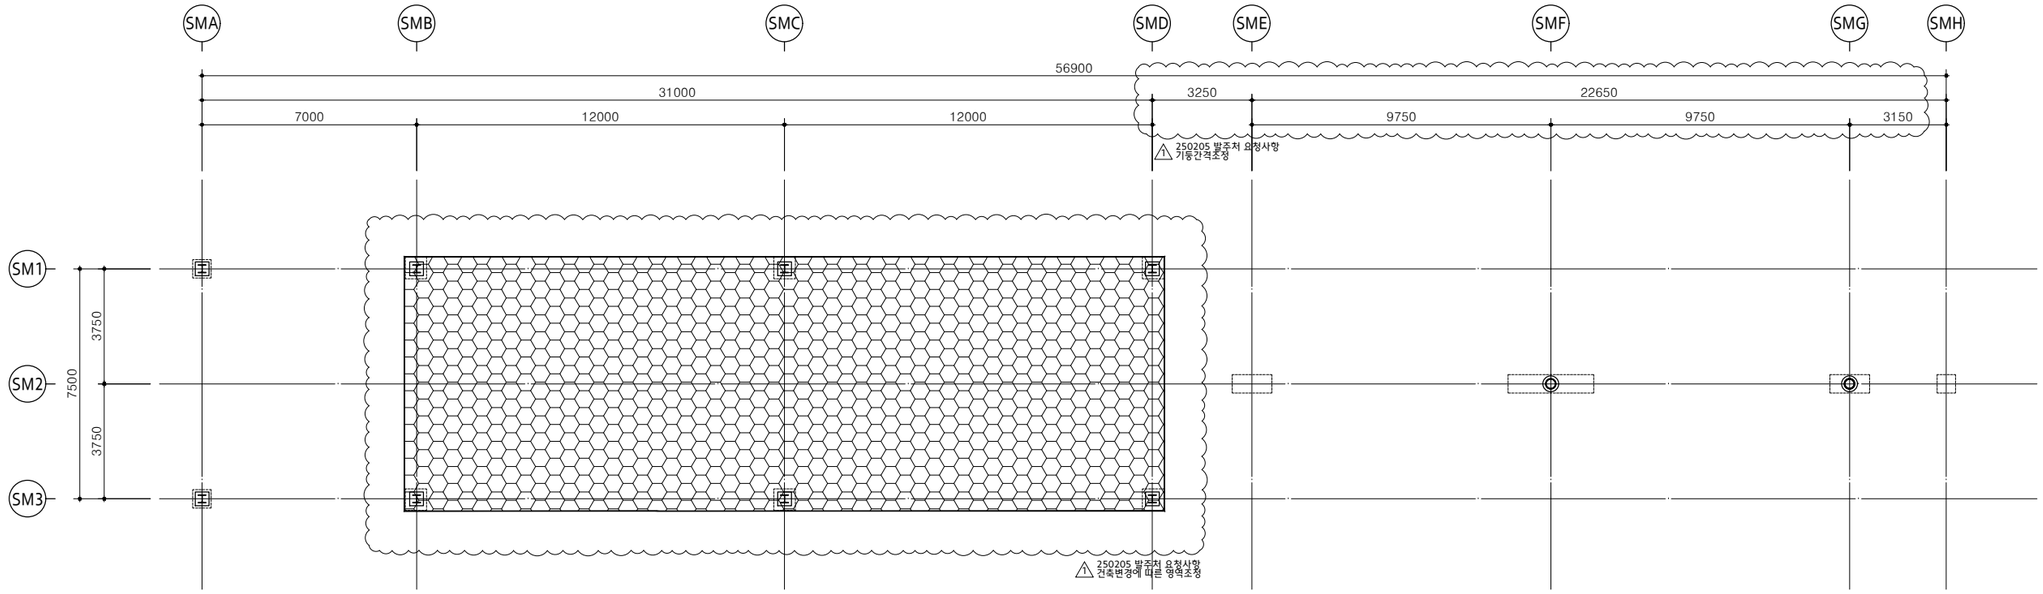


1 GROUND FLOOR LOADING PLAN

SCALE : 1/100

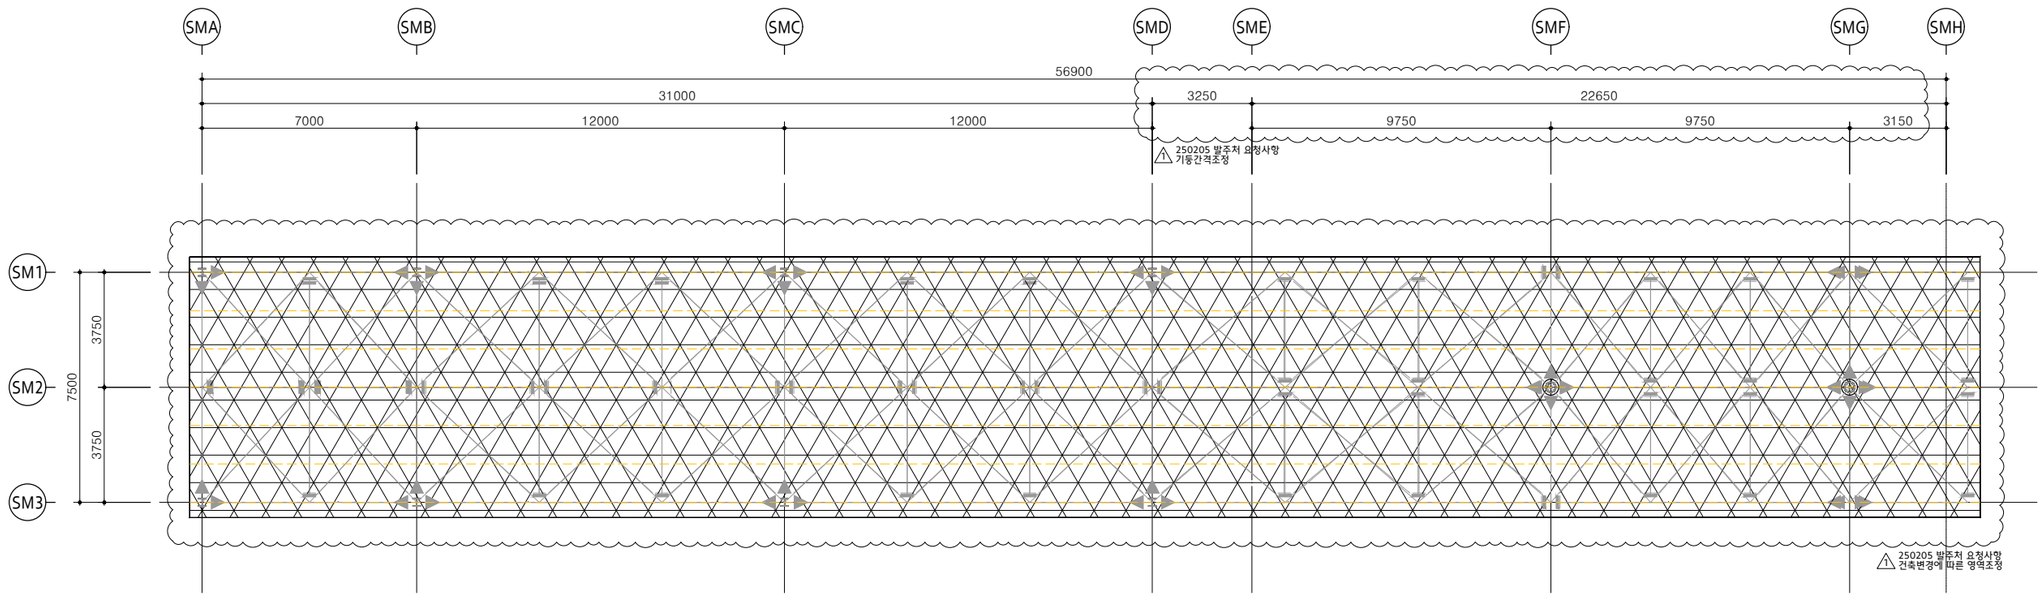

2 ROOF LOADING PLAN

SCALE : 1/100

KEY PLAN

NOTE

1. THIS DRAWING IS MAINLY FOR THE BASIC INFORMATION AND GUIDANCE FOR THE DESIGN AND ENGINEERING FOR THE PROJECT. DO NOT USE THIS FOR CONSTRUCTION.
2. THE INFORMATIONS ON THIS DRAWING CAN BE CHANGED ACCORDING TO THE CLIENT'S UPDATED DECISION.
3. THIS DRAWING CAN BE ADJUSTED AND REVISED ACCORDING TO THE LOCAL CONDITIONS AND REGULATIONS SUPPLIED BY THE LOCAL ARCHITECTS ENGINEERS AND THE INSURANCE UNDERWRITER.
4. ALL STRUCTURAL, MECHANICAL, ELECTRICAL ITEMS ARE ONLY FOR INFORMATION. FURTHER COORDINATION IS NEEDED.
5. LIVE LOAD LEGEND
   - LIVE LOAD : 5.0 kN/m²
   - LIVE LOAD : 0.75(ROOF) kN/m²

REV.	DESCRIPTION	DRAWN	DATE
1	CD Rev.1	OH,J.S	2025. 02.14
0	CONSTRUCTION DRAWING	OH,J.S	2024. 07.30
A	DESIGN DEVELOPMENT	OH,J.S	2024. 06.28

CLIENT

HYUNDAI

ARCHITECTS & ENGINEERS

JUNGLIM ARCHITECTURE

PROJECT TITLE

PUNE HMI PROJECT

DRAWING TITLE

[MAIN SECURITY OFFICE] LOADING PLAN

SCALE	DRAWN	CHECKED	REVIEWED	APPROVED	APPROVED
A1:1/100 A3:1/200	OH,J.S	HONG,G.D	LEE,S.L	HEC INDIA	PARK,T.S
DATE					
14 FEB,2025					


MAIN CONTRACTOR


HEC INDIA LLP

DRAWING NO. WA-IPB-645-S-0201

REV. 1

A1 SIZE (841mm x 594mm)

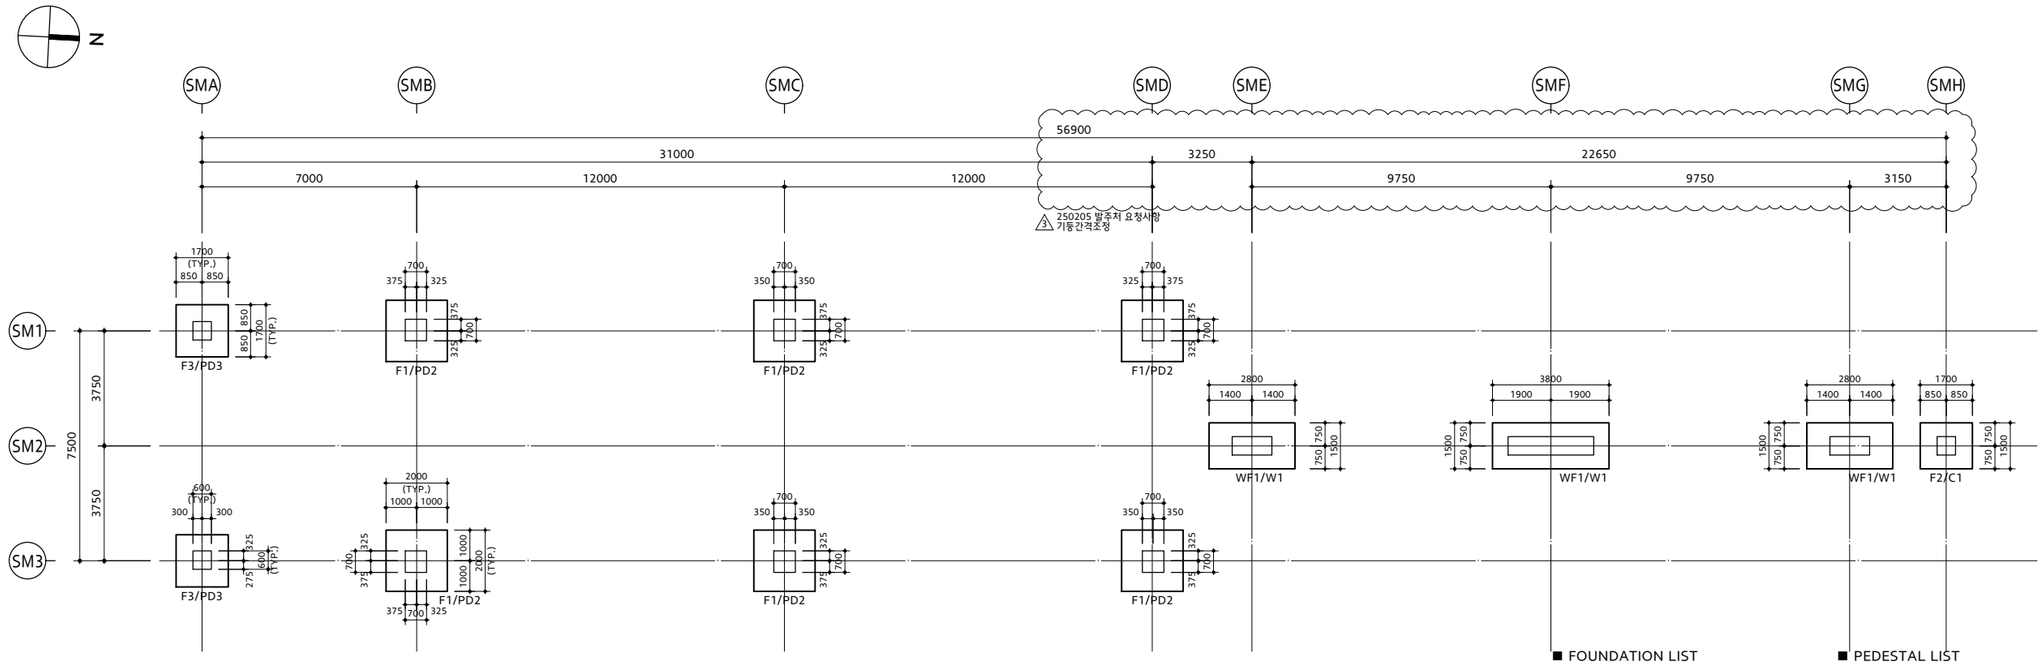

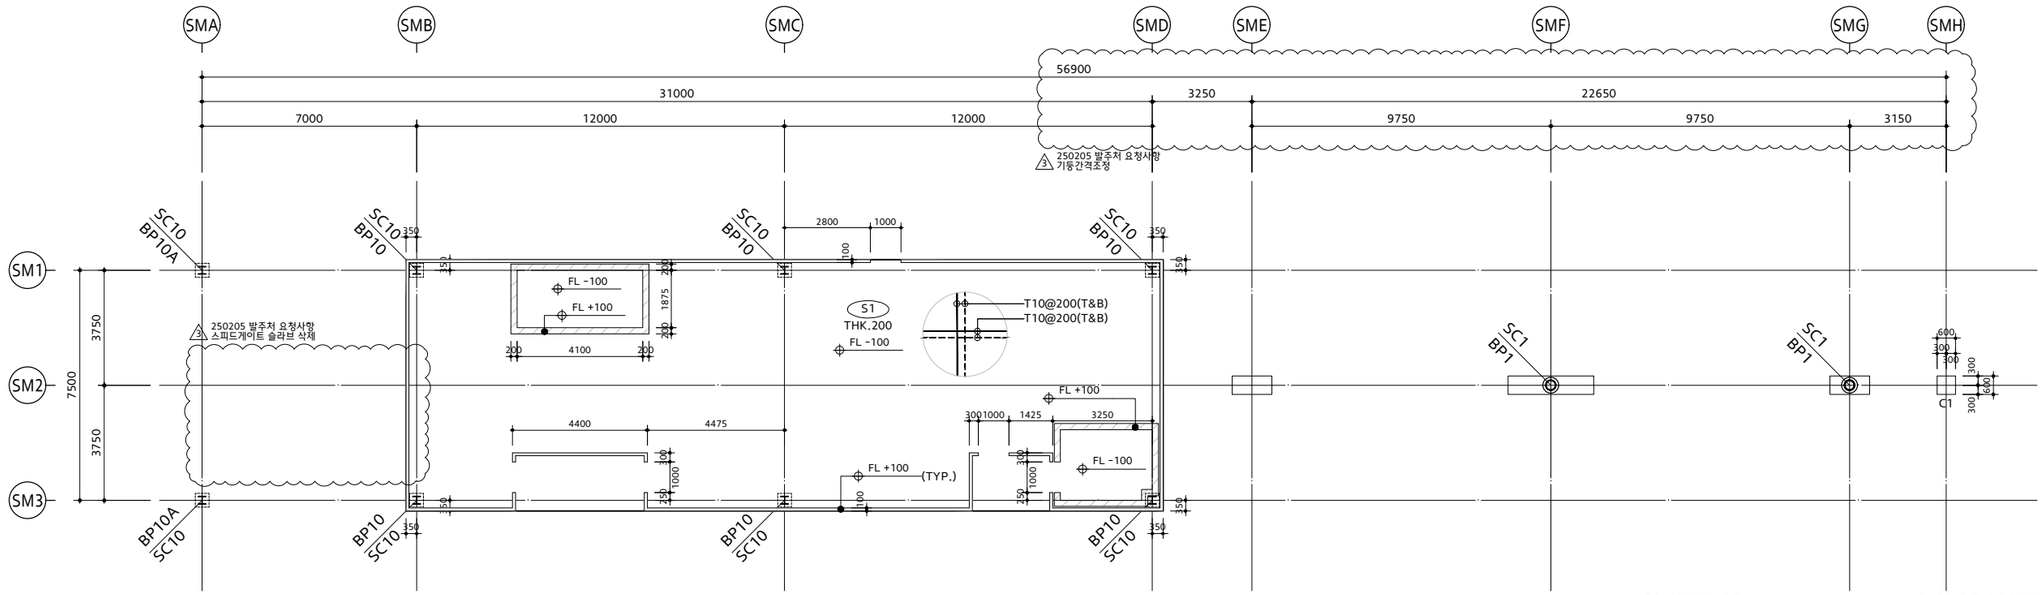

KEY PLAN

NOTE

■ MATERIAL STRENGTH

1. CONCRETE
   1) STRUCTURAL CONCRETE
   - fck = 30 MPa (Cubic Strength)
   - fck = 24 MPa (Cylinder Strength)
   2) LEAN CONCRETE
   - fck = 15 MPa (Cubic Strength)
   - fck = 12 MPa (Cylinder Strength)
2. REINFORCING BAR
   - fy = 415 MPa (IS Fe415)
3. STEEL
   1) ALL STEEL MEMBERS
   EXCEPT THOSE SPECIFIED BELOW
   - E250 (Fy = 230~250 MPa, Fu = 410 MPa)
   2) RECT.HSS : IS YST 240
   - YST 240(Fy=240MPa, Fu=410MPa)
4. HIGH STRENGTH BOLT
   - KS F10T TS BOLT OR
   EQUIVALENT TO GRADE 10.9
   (Fy = 900MPa, Fu = 1,000MPa)
5. ANCHOR BOLT
   - IS GRADE 4.6 (Fu = 400 MPa)
6. CONNECTION OF STEEL STRUCTURES
   ▶ : FIX CONNECTION & GIRDER CONNECTION
   ⊢ : HINGE CONNECTION

■ NOTE

1. ALL DIMENSIONS AND ELEVATIONS ARE IN MILLIMETERS UNLESS OTHERWISE NOTED.
2. CLEAR COVER TO MAIN REINFORCEMENT
   1) FOOTING : 40mm (CONSIDERING LEAN CONCRETE)
   2) COLUMN : 40 mm (CONSIDERING FORM)
   3) BEAM : 40 mm (CONSIDERING FORM)
   4) SLAB : 20 mm (CONSIDERING LEAN CONCRETE)
3. ALLOWABLE SOIL BEARING CAPACITY
   1) Fe = 100 kN/m² (SFRC SLAB & S.O.G SLAB)
   2) Fe = 150 kN/m² (FOUNDATION)
4. ALLOWABLE SOIL BEARING CAPACITY
   IS IT MAY BE CHANGED DEPENDING ON THE SITE AND SOIL CONDITIONS.

■ FOUNDATION LIST

NAME	MEMBER	B.O.F
F1	2000 X 2000 X 400	FL-1650
F2	1700 X 1700 X 400	FL-1300
F3	1700 X 1700 X 400	FL-1300
WF1	(2800,3800) X 1500 X 600	FL-1300

■ PEDESTAL LIST

NAME	MEMBER	T.O.C
~~PD1~~	~~600X600~~	~~FL-300~~
PD2	700X700	FL-600
PD3	750X750	FL-300
C1	600X600	FL+2300

■ COLUMN LIST

NAME	MEMBER	GRADE
SC1	CHS-Ø323X8.0t	E250
SC10	UC 254X254X89	

■ SLAB & TIE BEAM LIST

NAME	MEMBER
S1	THK=200mm (S.O.G, SLAB)
S2	THK=300mm (S.O.G, SLAB)

REV.	DESCRIPTION	DRAWN	DATE
3	CD Rev.3	OH.J.S	2025. 02.14
2	CD Rev.2	OH.J.S	2024. 11.29
1	CD Rev.1	OH.J.S	2024. 10.18
0	CONSTRUCTION DRAWING	OH.J.S	2024. 07.30
A	DESIGN DEVELOPMENT	OH.J.S	2024. 06.28

CLIENT

HYUNDAI

ARCHITECTS & ENGINEERS

JUNGLIM ARCHITECTURE

PROJECT TITLE

PUNE HMI PROJECT

DRAWING TITLE

[MAIN SECURITY OFFICE]
STRUCTURE PLAN

SCALE	DRAWN	CHECKED	REVIEWED	APPROVED	APPROVED
A1: 1/100 A3: 1/200	OH.J.S	HONG.G.D	LEE.S.L	HEC INDIA	PARK.T.S
DATE					
14 FEB,2025					


MAIN CONTRACTOR

HEC INDIA LLP

DRAWING NO. WA-IPB-645-S-2001

REV. 3

A1 SIZE (841mm x 594mm)

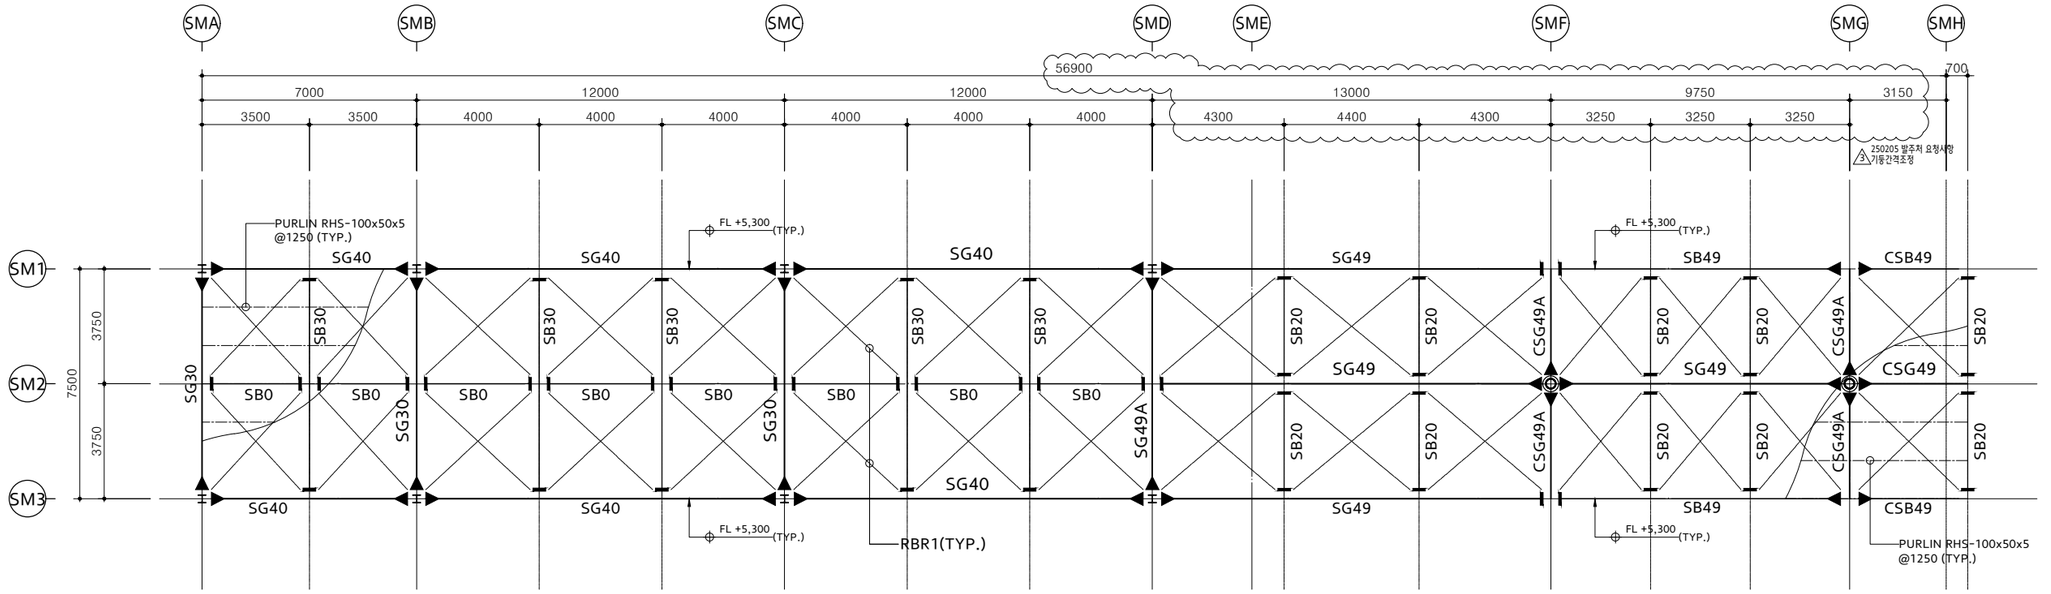

1 ROOF FRAMING PLAN

SCALE : 1/100

KEY PLAN

NOTE

■ MATERIAL STRENGTH

1. CONCRETE
   1) STRUCTURAL CONCRETE
   - fck = 30 MPa (Cubic Strength)
   - fck = 24 MPa (Cylinder Strength)
   2) LEAN CONCRETE
   - fck = 15 MPa (Cubic Strength)
   - fck = 12 MPa (Cylinder Strength)
2. REINFORCING BAR
   - fy = 415 MPa (IS Fe415)
3. STEEL
   1) ALL STEEL MEMBERS
   EXCEPT THOSE SPECIFIED BELOW
   - E250 (Fy = 230~250 MPa, Fu = 410 MPa)
   2) RECT.HSS : IS YST 240
   - YST 240(Fy=240MPa, Fu=410MPa)
4. HIGH STRENGTH BOLT
   - KS F10T TS BOLT OR
   EQUIVALENT TO GRADE 10.9
   (Fy = 900MPa, Fu = 1,000MPa)
5. ANCHOR BOLT
   - IS GRADE 4.6 (Fu = 400 MPa)
6. CONNECTION OF STEEL STRUCTURES
   ▶— : FIX CONNECTION & GIRDER CONNECTION
   —| : HINGE CONNECTION

■ NOTE

1. ALL DIMENSIONS AND ELEVATIONS ARE IN MILLIMETERS UNLESS OTHERWISE NOTED.
2. CLEAR COVER TO MAIN REINFORCEMENT
   1) FOOTING : 40mm (CONSIDERING LEAN CONCRETE)
   2) COLUMN : 40 mm (CONSIDERING FORM)
   3) BEAM : 40 mm (CONSIDERING FORM)
   4) SLAB : 20 mm (CONSIDERING LEAN CONCRETE)
3. ALLOWABLE SOIL BEARING CAPACITY
   1) Fe = 100 kN/m² (SFRC SLAB & S.O.G SLAB)
   2) Fe = 150 kN/m² (FOUNDATION)
4. ALLOWABLE SOIL BEARING CAPACITY
   IS IT MAY BE CHANGED DEPENDING ON THE SITE AND SOIL CONDITIONS.

■ MEMBER LIST

NAME	MEMBER	GRADE
SB0	ISA 100x100x8	E250
SB20	UB 203X133X25	
SB30	UB 305X165X40	
CSB49	BH 450X200X8X16	
SG30	UB 305X165X40	
SG40	BH 400X150X8X12	
SG49,SG49A CSG49,CSG49A	BH 450X200X8X16	

■ MEMBER LIST

NAME	MEMBER	GRADE
RBR1	ROD BAR D16	E250
	(Turn buckle)	
PURLIN	RHS-100x50x5@1250	E250
	(MIN 2 SPAN CONTINOUS)	

REV.	DESCRIPTION	DRAWN	DATE
3	CD Rev.3	OH.J.S	2025. 02.14
2	CD Rev.2	OH.J.S	2024. 11.29
1	CD Rev.1	OH.J.S	2024. 10.18
0	CONSTRUCTION DRAWING	OH.J.S	2024. 07.30
A	DESIGN DEVELOPMENT	OH.J.S	2024. 06.28

CLIENT

HYUNDAI

ARCHITECTS & ENGINEERS

JUNGLIM ARCHITECTURE

PROJECT TITLE

PUNE HMI PROJECT

DRAWING TITLE

[MAIN SECURITY OFFICE]
ROOF FRAMING PLAN

SCALE	DRAWN	CHECKED	REVIEWED	APPROVED	APPROVED
A1: 1/100 A3:1/200	OH.J.S	HONG.G.D	LEE.S.L	HEC INDIA	PARK.T.S
DATE 14 FEB,2025					


MAIN CONTRACTOR

HEC INDIA LLP

DRAWING NO. WA-IPB-645-S-2002


REV. 3

A1 SIZE (841mm x 594mm)

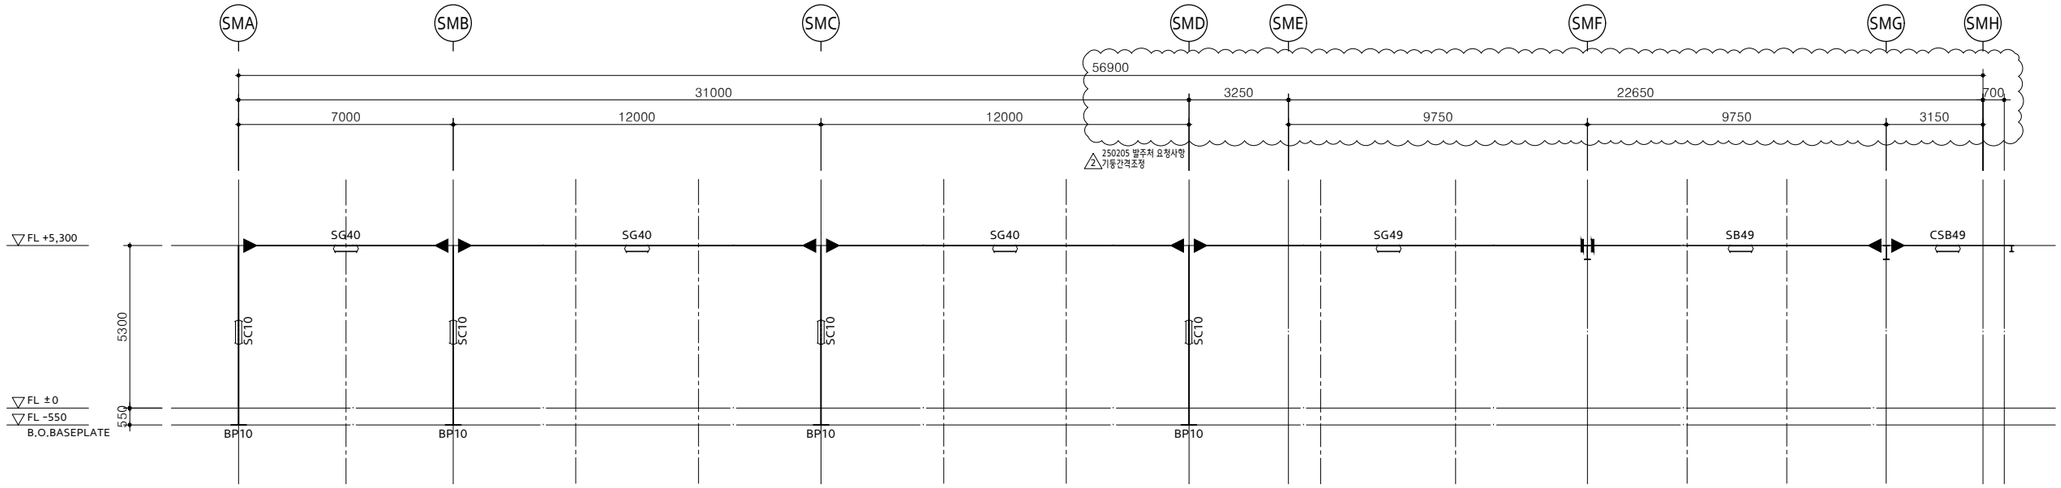


1 SM1,3 LINE FRAMING ELEVATION

SCALE : 1/100

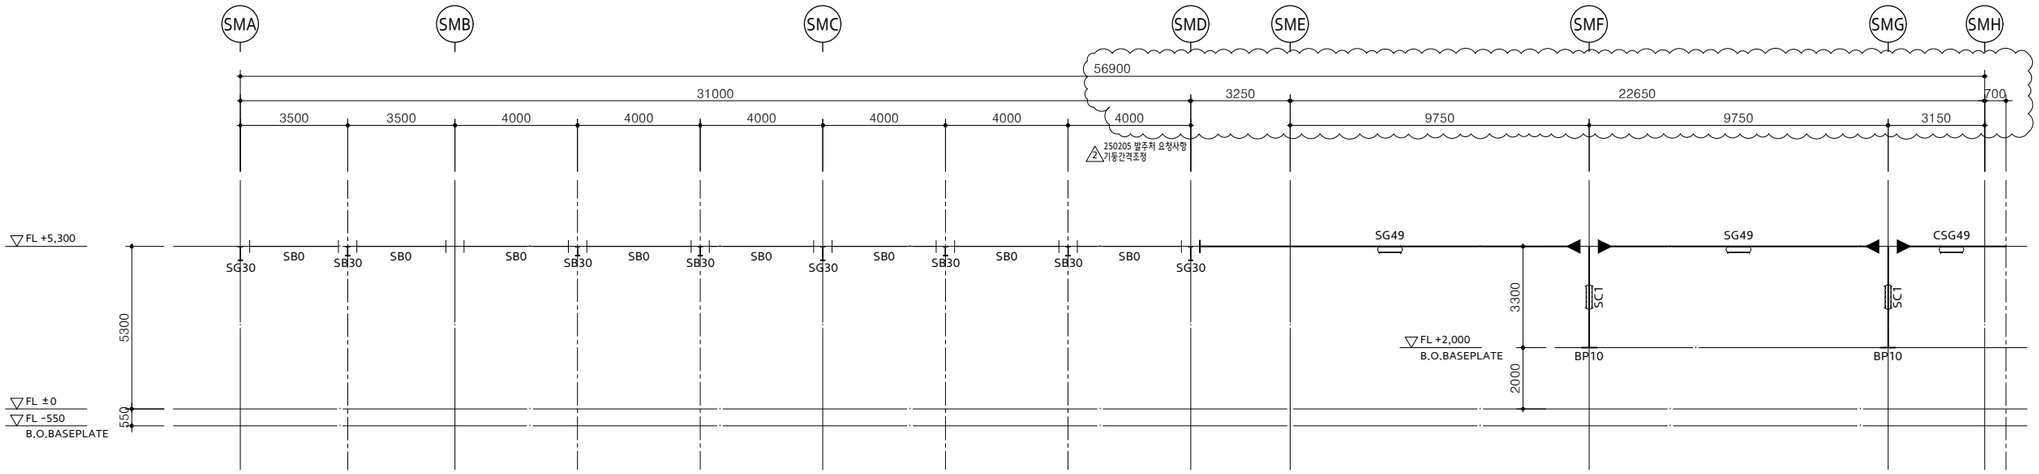


2 SM2 LINE FRAMING ELEVATION

SCALE : 1/100

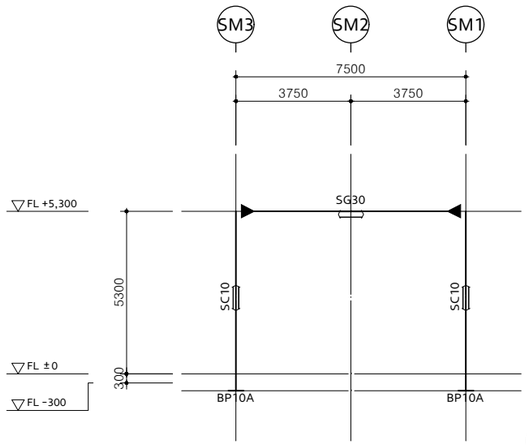

3 SM A~D LINE FRAMING ELEVATION

SCALE : 1/100

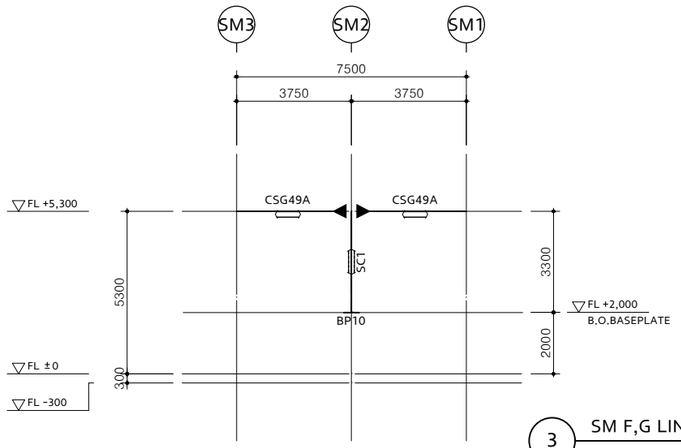

3 SM F,G LINE FRAMING ELEVATION

SCALE : 1/100

KEY PLAN

NOTE

■ MATERIAL STRENGTH

1. CONCRETE
   1) STRUCTURAL CONCRETE
   - fck = 30 MPa (Cubic Strength)
   - fck = 24 MPa (Cylinder Strength)
   2) LEAN CONCRETE
   - fck = 15 MPa (Cubic Strength)
   - fck = 12 MPa (Cylinder Strength)
2. REINFORCING BAR
   - fy = 415 MPa (IS Fe415)
3. STEEL
   1) ALL STEEL MEMBERS
   EXCEPT THOSE SPECIFIED BELOW
   - E250 (Fy = 230~250 MPa, Fu = 410 MPa)
   2) RECT.HSS : IS YST 240
   - YST 240(Fy=240MPa, Fu=410MPa)
4. HIGH STRENGTH BOLT
   - KS F10T TS BOLT OR
   EQUIVALENT TO GRADE 10.9
   (Fy = 900MPa, Fu = 1,000MPa)
5. ANCHOR BOLT
   - IS GRADE 4.6 (Fu = 400 MPa)
6. CONNECTION OF STEEL STRUCTURES
   ▶ : FIX CONNECTION & GIRDER CONNECTION
   ⊢ : HINGE CONNECTION

■ NOTE

1. ALL DIMENSIONS AND ELEVATIONS ARE IN MILLIMETERS UNLESS OTHERWISE NOTED.
2. CLEAR COVER TO MAIN REINFORCEMENT
   1) FOOTING : 40mm (CONSIDERING LEAN CONCRETE)
   2) COLUMN : 40 mm (CONSIDERING FORM)
   3) BEAM : 40 mm (CONSIDERING FORM)
   4) SLAB : 20 mm (CONSIDERING LEAN CONCRETE)
3. ALLOWABLE SOIL BEARING CAPACITY
   1) Fe = 100 kN/m² (SFRC SLAB & S,O,G SLAB)
   2) Fe = 150 kN/m² (FOUNDATION)
4. ALLOWABLE SOIL BEARING CAPACITY IS IT MAY BE CHANGED DEPENDING ON THE SITE AND SOIL CONDITIONS.

REV.	DESCRIPTION	DRAWN	DATE
2	CD Rev.2	OH.J.S	2025. 02.14
1	CD Rev.1	OH.J.S	2024. 10.18
0	CONSTRUCTION DRAWING	OH.J.S	2024. 07.30
A	DESIGN DEVELOPMENT	OH.J.S	2024. 06.28

CLIENT

HYUNDAI

ARCHITECTS & ENGINEERS

JUNGLIM ARCHITECTURE

PROJECT TITLE

PUNE HMI PROJECT

DRAWING TITLE

[MAIN SECURITY OFFICE] FRAMING ELEVATIONS-1

SCALE A1:1/100 A3:1/200	DRAWN	CHECKED	REVIEWED	APPROVED	APPROVED
	OH.J.S	HONG.G.D	LEE.S.L	HEC INDIA	PARK.T.S
DATE 14 FEB,2025					

MAIN CONTRACTOR

HEC

DRAWING NO. WA-IPB-645-S-2003

REV. 2

A1 SIZE (841mm x 594mm)