

IPS-MEHTALIA PVT. LTD.

VENDOR DRAWING REVIEW


- [x] Drawing approved
- [ ] Drawing approved with comments as noted. Proceed with Fabrication incorporating comments.
- [ ] Drawing commented. Resubmit revised drawing for approval
- [ ] Drawing rejected. Revise and resubmit for approval

Signature Suraj Date: 24/05/2017

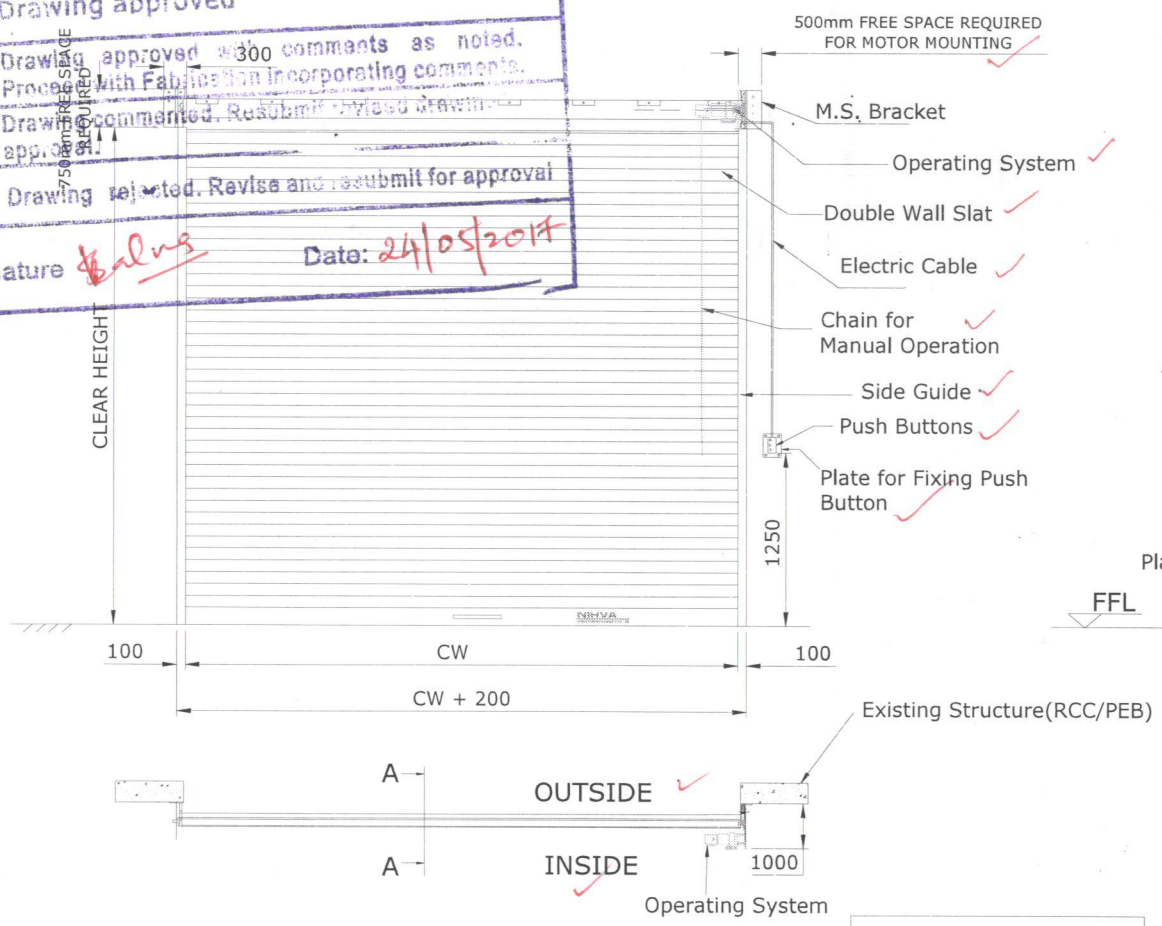

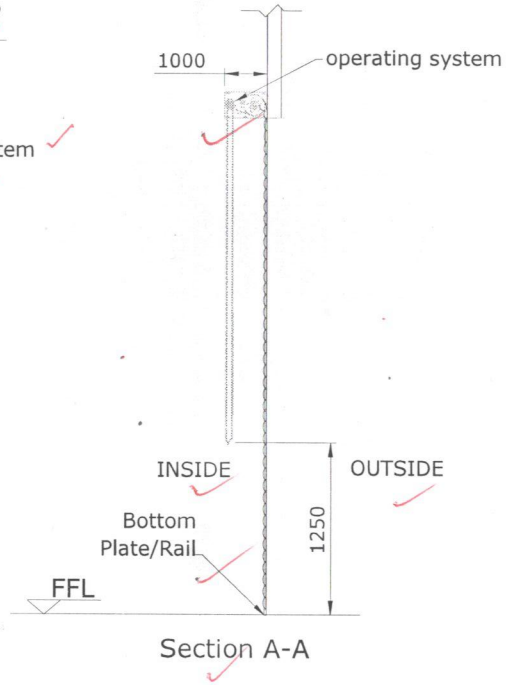

Section A-A

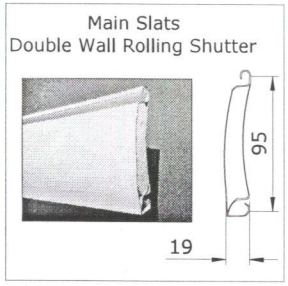



CLEAR WIDTH (CW)	CLEAR HEIGHT (CH)	QUANTITY
3000mm	4500mm	4 NOS
2850mm	4500mm	4 NOS

NOTE: COLOUR OF THE SHUTTER WILL BE OFF WHITE → The color of shutter to be finalized by Lupin teams

REVISION 1- SHUTTER WILL BE INSTALLED FROM INSIDE

DIMENSION :		
CLEAR WIDTH	CLEAR HEIGHT	QUANTITY
3000mm	4500mm	4NOS
2850mm	4500mm	4NOS

MATERIAL :

THICKNESS :

NOTE-
01. REQUIERD STRUCTURE FOR ROLLING SHUTTER WILL BE IN CLIENT'S SCOPE.
02. IF WALL FOR GUIDE AND RCC LINTEL FOR MS BRACKET IS PRESENT AT SITE THEN THIS MS STRUCTURE WILL NOT BE REQUIRED.
03. SINGLE PHASE SUPPLY IS REQUIRED.

NIHVA TECHNOLOGIES PVT. LTD. PUNE
Email:- info@nihva.com
Website:- www.nihva.com

TITLE:

DOUBLE WALL ROLLING SHUTTER

CLIENT'S APPROVAL :

CLIENT - LUPIN

PROJECT - LUPIN

SITE LOCATION -NAGPUR.

DWG. NO. : NIHVA/17-18/0030/R01

SCALE: NTS	WT:	SHEET:1 OF 1
DRAWN BY: SURAJ		DATE: 24-05-2017
CHECK BY: SAGAR P.		DATE: 24-05-2017
APPROVED BY : S.S		DATE: 24-05-2017

If any queries contact : projects@nihva.com

NOTE: ALL DIMENSIONS ARE IN mm

THIS DRAWING & DESIGN IS THE PROPERTY OF NIHVA TECHNOLOGIES. NOT TO BE SOLD OR COPIED TO ANY OTHER CONCERN.