
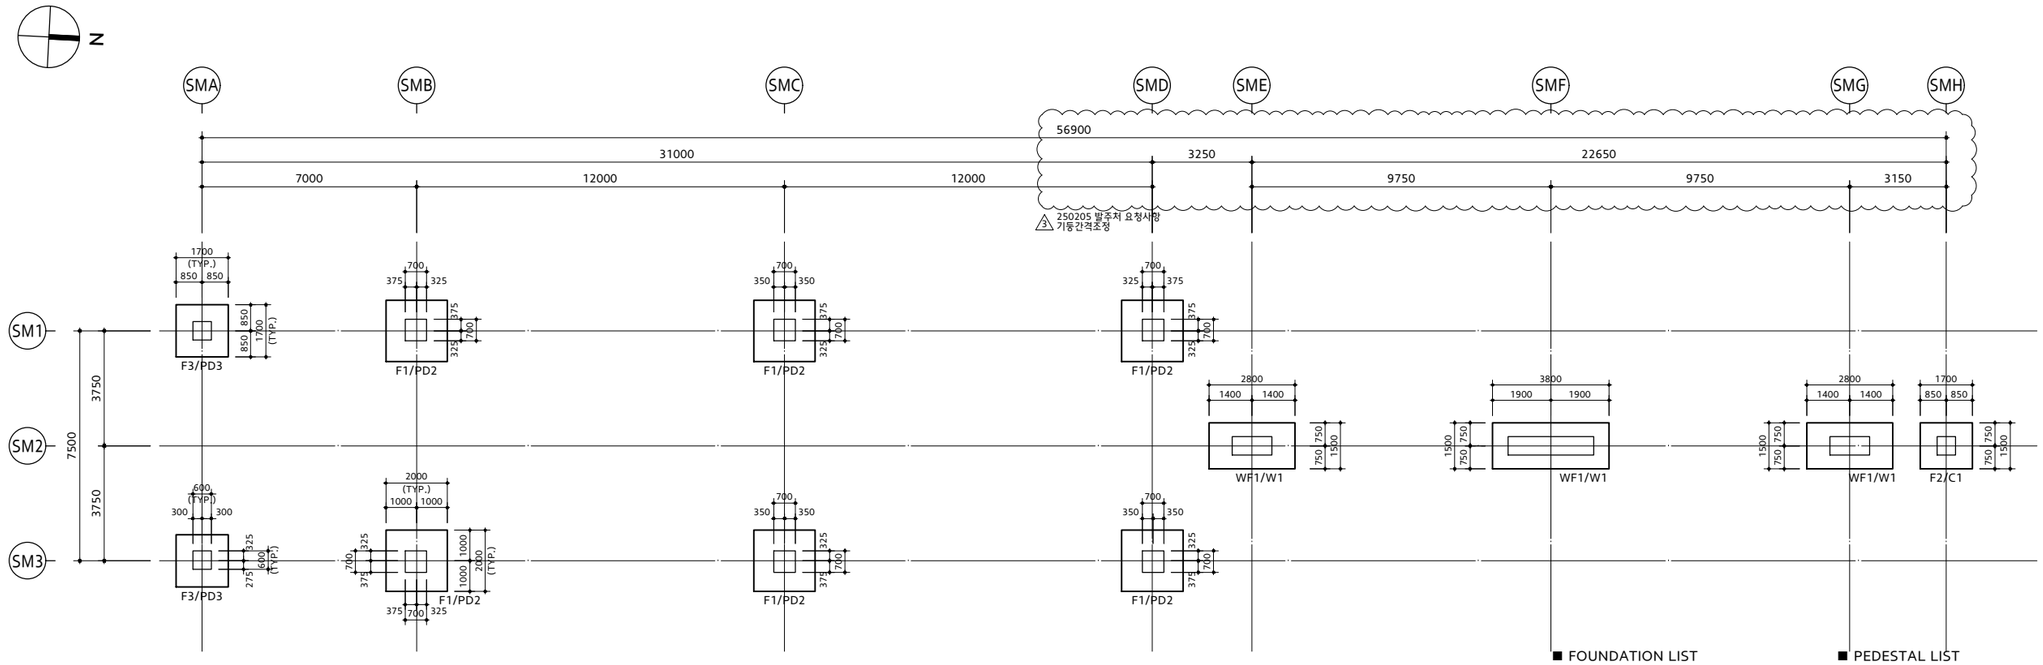


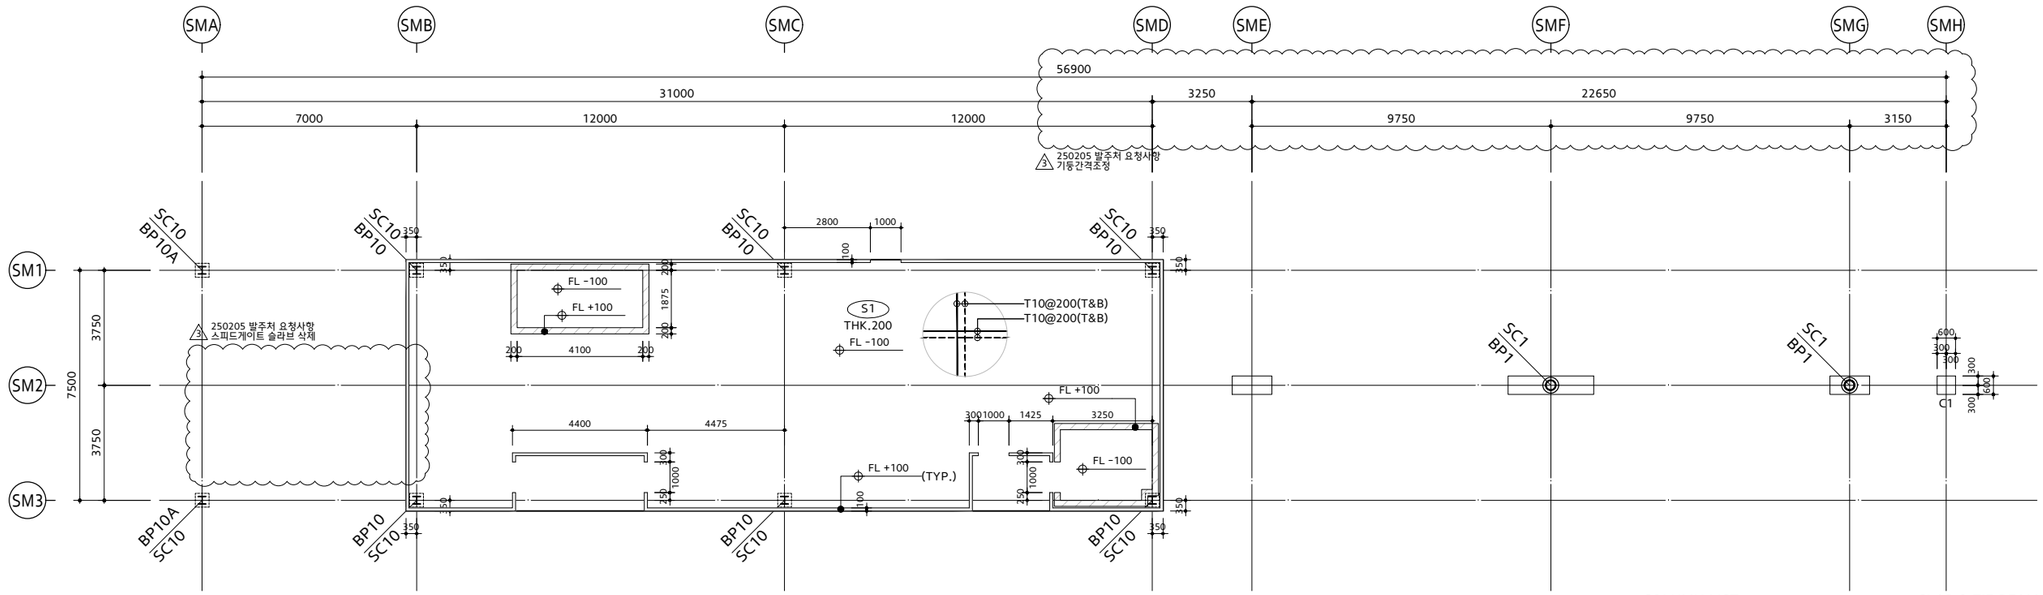

KEY PLAN

NOTE

■ MATERIAL STRENGTH

1. CONCRETE
   1) STRUCTURAL CONCRETE
   - fck = 30 MPa (Cubic Strength)
   - fck = 24 MPa (Cylinder Strength)
   2) LEAN CONCRETE
   - fck = 15 MPa (Cubic Strength)
   - fck = 12 MPa (Cylinder Strength)
2. REINFORCING BAR
   - fy = 415 MPa (IS Fe415)
3. STEEL
   1) ALL STEEL MEMBERS
   EXCEPT THOSE SPECIFIED BELOW
   - E250 (Fy = 230~250 MPa, Fu = 410 MPa)
   2) RECT.HSS : IS YST 240
   - YST 240(Fy=240MPa, Fu=410MPa)
4. HIGH STRENGTH BOLT
   - KS F10T TS BOLT OR
   EQUIVALENT TO GRADE 10.9
   (Fy = 900MPa, Fu = 1,000MPa)
5. ANCHOR BOLT
   - IS GRADE 4.6 (Fu = 400 MPa)
6. CONNECTION OF STEEL STRUCTURES
   ▶ : FIX CONNECTION & GIRDER CONNECTION
   ⊢ : HINGE CONNECTION

■ NOTE

1. ALL DIMENSIONS AND ELEVATIONS ARE IN MILLIMETERS UNLESS OTHERWISE NOTED.
2. CLEAR COVER TO MAIN REINFORCEMENT
   1) FOOTING : 40mm (CONSIDERING LEAN CONCRETE)
   2) COLUMN : 40 mm (CONSIDERING FORM)
   3) BEAM : 40 mm (CONSIDERING FORM)
   4) SLAB : 20 mm (CONSIDERING LEAN CONCRETE)
3. ALLOWABLE SOIL BEARING CAPACITY
   1) Fe = 100 kN/m² (SFRC SLAB & S.O.G SLAB)
   2) Fe = 150 kN/m² (FOUNDATION)
4. ALLOWABLE SOIL BEARING CAPACITY
   IS IT MAY BE CHANGED DEPENDING ON THE SITE AND SOIL CONDITIONS.

■ FOUNDATION LIST

NAME	MEMBER	B.O.F
F1	2000 X 2000 X 400	FL-1650
F2	1700 X 1700 X 400	FL-1300
F3	1700 X 1700 X 400	FL-1300
WF1	(2800,3800) X 1500 X 600	FL-1300

■ PEDESTAL LIST

NAME	MEMBER	T.O.C
~~PD1~~	~~600X600~~	~~FL-300~~
PD2	700X700	FL-600
PD3	750X750	FL-300
C1	600X600	FL+2300

■ COLUMN LIST

NAME	MEMBER	GRADE
SC1	CHS-Ø323X8.0t	E250
SC10	UC 254X254X89	

■ SLAB & TIE BEAM LIST

NAME	MEMBER
S1	THK=200mm (S.O.G, SLAB)
S2	THK=300mm (S.O.G, SLAB)

REV.	DESCRIPTION	DRAWN	DATE
3	CD Rev.3	OH.J.S	2025. 02.14
2	CD Rev.2	OH.J.S	2024. 11.29
1	CD Rev.1	OH.J.S	2024. 10.18
0	CONSTRUCTION DRAWING	OH.J.S	2024. 07.30
A	DESIGN DEVELOPMENT	OH.J.S	2024. 06.28

CLIENT

HYUNDAI

ARCHITECTS & ENGINEERS

JUNGLIM ARCHITECTURE

PROJECT TITLE

PUNE HMI PROJECT

DRAWING TITLE

[MAIN SECURITY OFFICE]
STRUCTURE PLAN

SCALE	DRAWN	CHECKED	REVIEWED	APPROVED	APPROVED
A1: 1/100 A3: 1/200	OH.J.S	HONG.G.D	LEE.S.L	HEC INDIA	PARK.T.S
DATE					
14 FEB,2025					

MAIN CONTRACTOR

HEC INDIA LLP

DRAWING NO. WA-IPB-645-S-2001

REV. 3

A1 SIZE (841mm x 594mm)