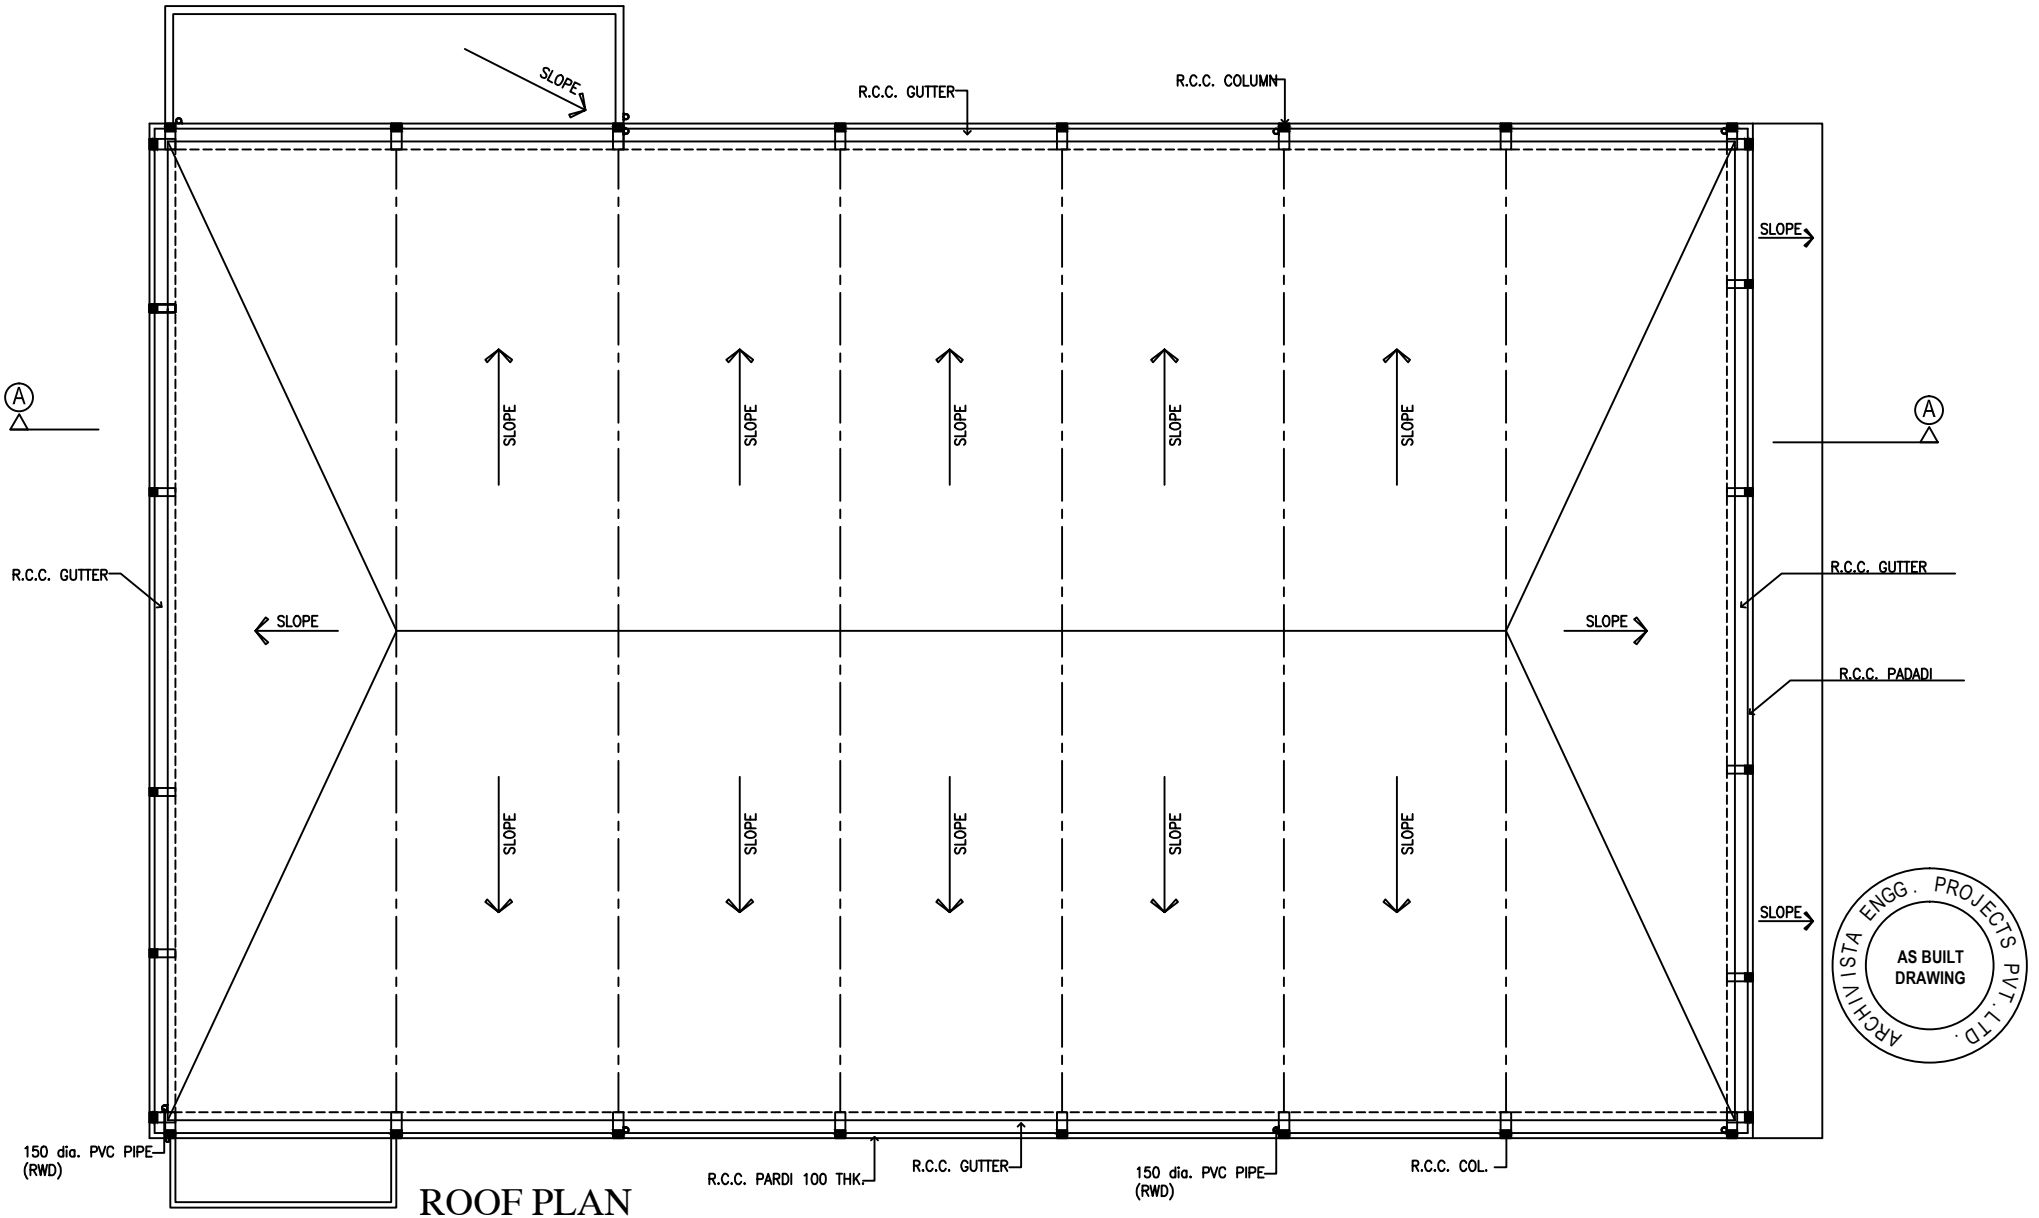

SLOPE
R.C.C. GUTTER
R.C.C. COLUMN
SLOPE
A
A
SLOPE
SLOPE
SLOPE
SLOPE
SLOPE
SLOPE
R.C.C. GUTTER
R.C.C. GUTTER
SLOPE
SLOPE
R.C.C. PADADI
SLOPE
SLOPE
SLOPE
SLOPE
SLOPE
SLOPE
SLOPE
150 dia. PVC PIPE (RWD)
R.C.C. PARDI 100 THK.
R.C.C. GUTTER
150 dia. PVC PIPE (RWD)
R.C.C. COL.
ARCHITISTA ENGG. PROJECTS PVT. LTD.
AS BUILT DRAWING

ROOF PLAN