HYOSUNG T&D

HYOSUNG CORPORATION INDIA PVT. LTD.


HYOSUNG PUNE PLANT

ARCHITECTURE

09.DEC.2015

"OFFICE LAYOUT REVISION AS PER CLIENT'S REQUEST FOR REFERENCE ONLY"

HTI ENGINEERING PVT. LTD.
91.44.2252.3743 www.mapgroup.co.kr

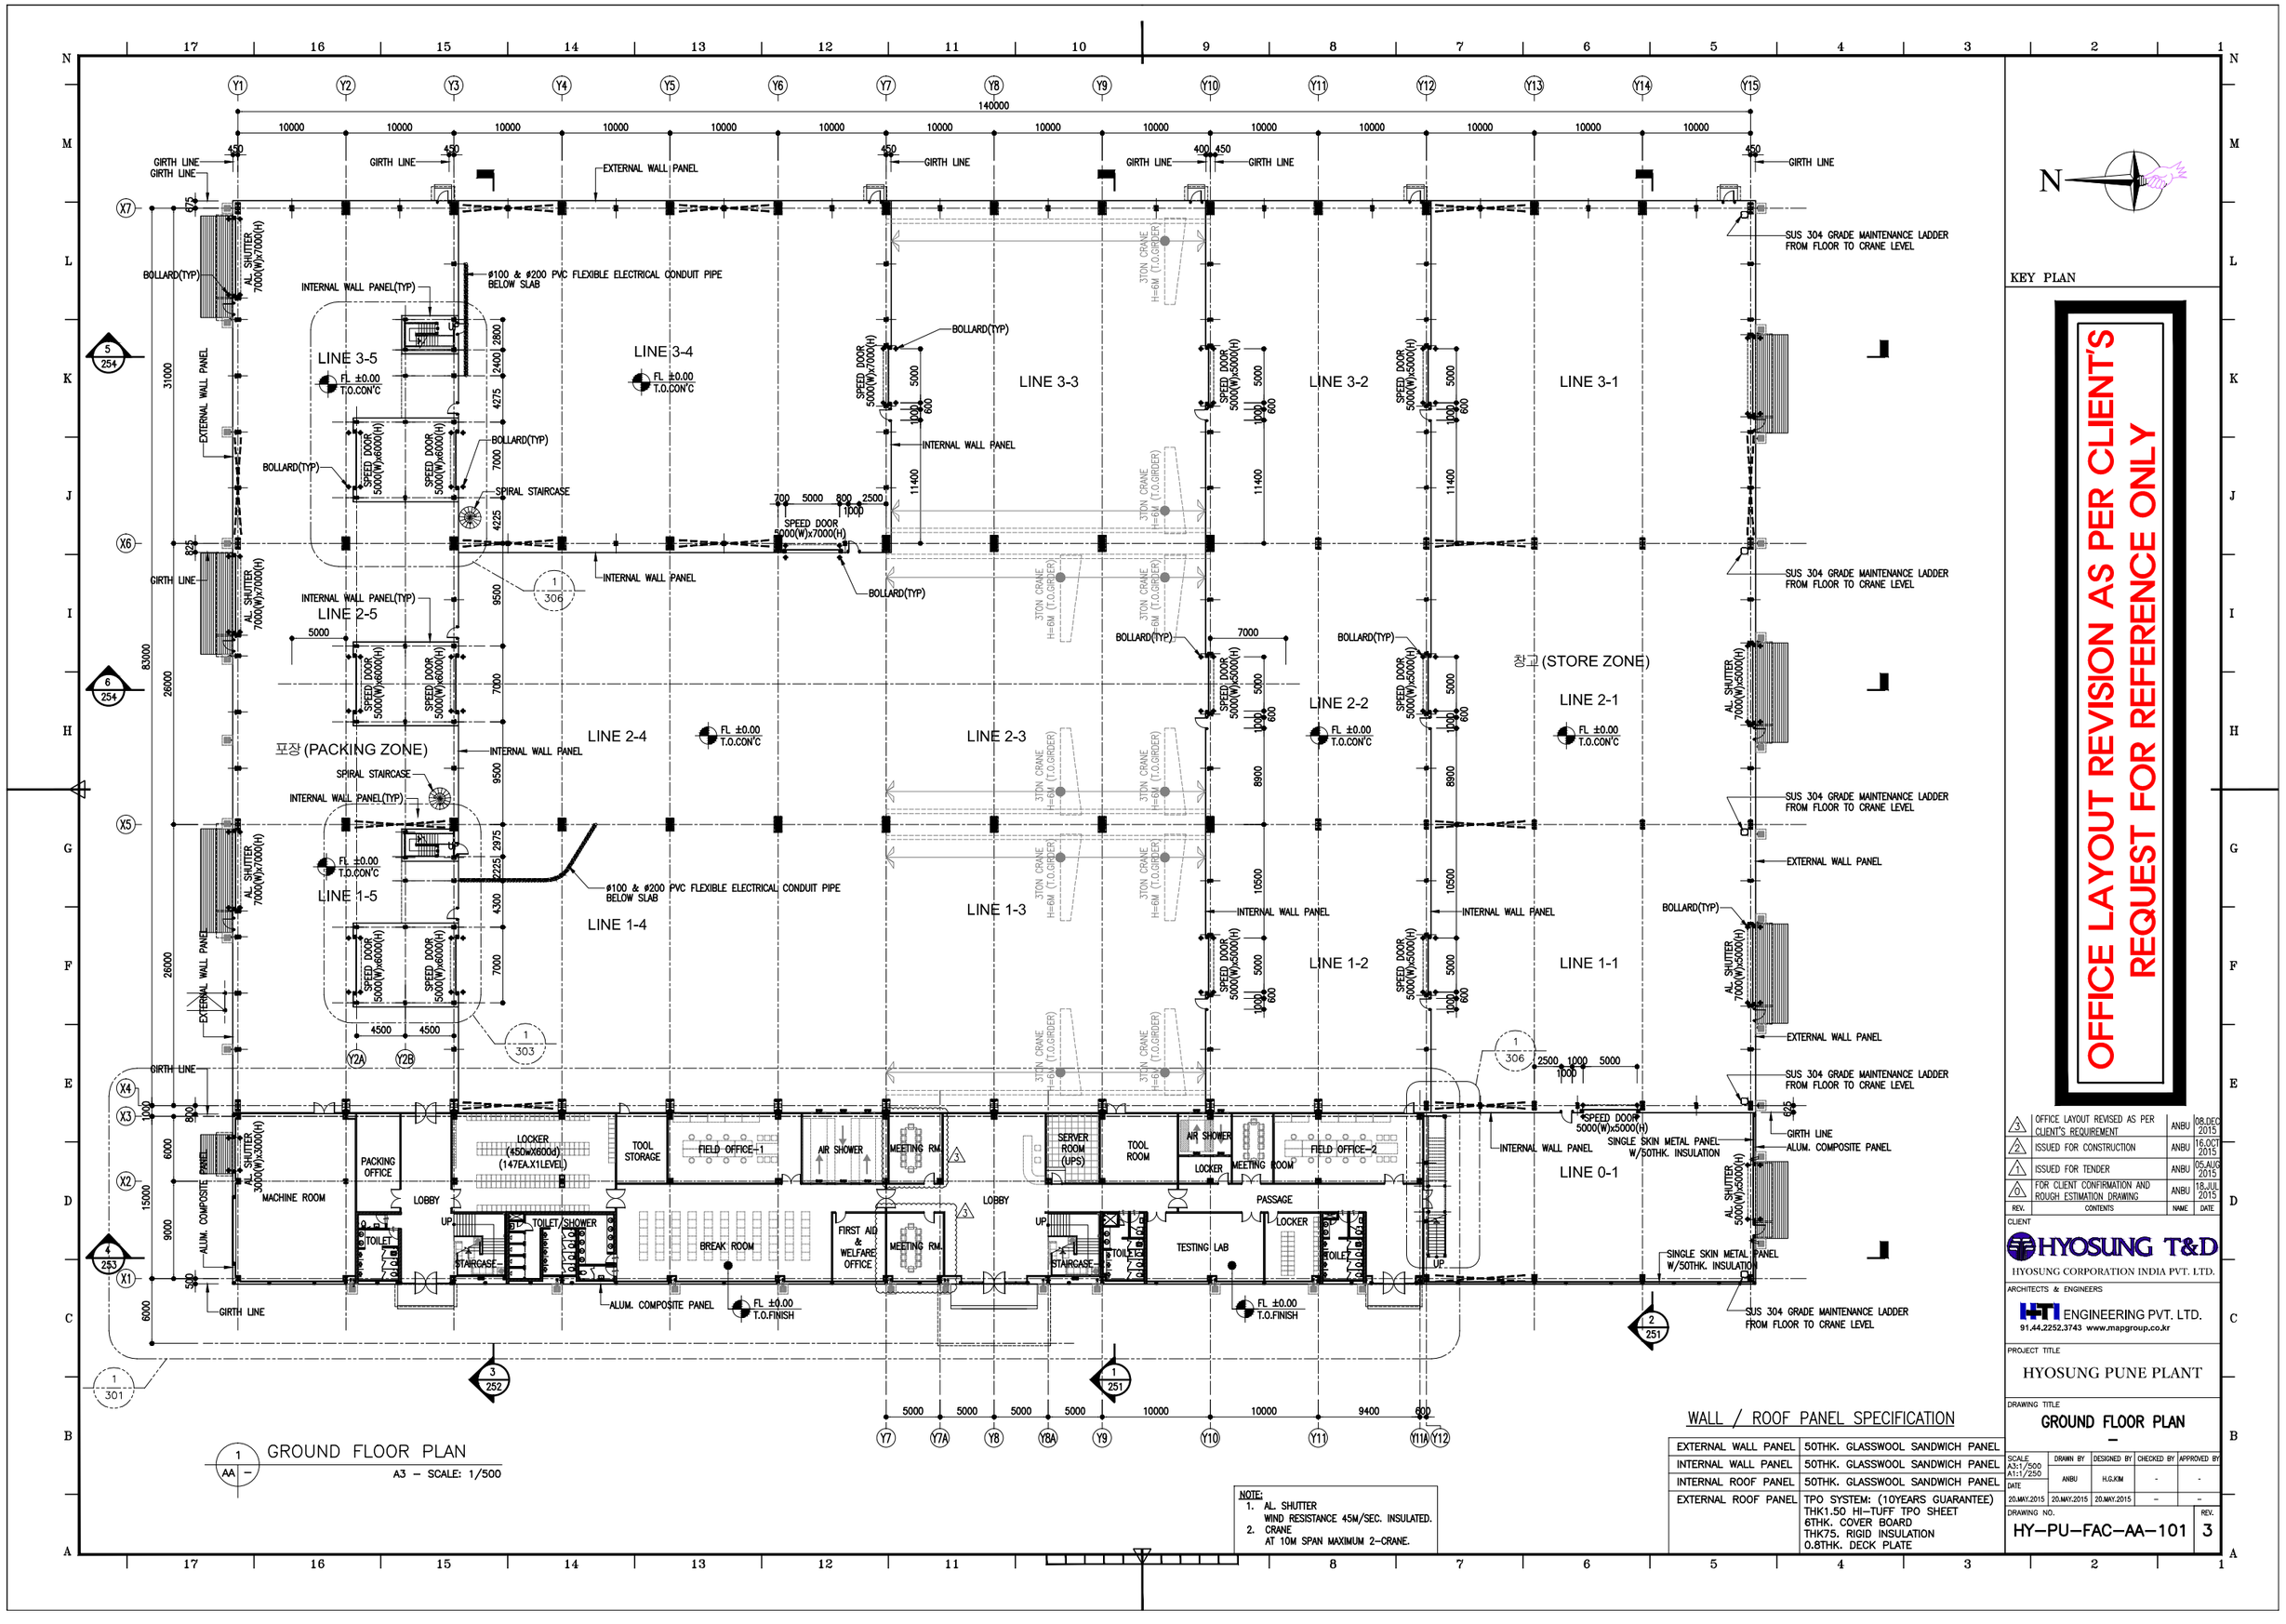

NOTE:
1. AL. SHUTTER WIND RESISTANCE 45M/SEC. INSULATED.
2. CRANE AT 10M SPAN MAXIMUM 2-CRANE.

WALL / ROOF PANEL SPECIFICATION

EXTERNAL WALL PANEL	50THK. GLASSWOOL SANDWICH PANEL
INTERNAL WALL PANEL	50THK. GLASSWOOL SANDWICH PANEL
INTERNAL ROOF PANEL	50THK. GLASSWOOL SANDWICH PANEL
EXTERNAL ROOF PANEL	TPO SYSTEM: (10YEARS GUARANTEE) THK1.50 HI-TUFF TPO SHEET 6THK. COVER BOARD THK75. RIGID INSULATION 0.8THK. DECK PLATE

KEY PLAN

OFFICE LAYOUT REVISION AS PER CLIENT'S REQUIREMENT FOR REFERENCE ONLY

REV.	CONTENTS	NAME	DATE
3	OFFICE LAYOUT REVISED AS PER CLIENT'S REQUIREMENT	ANBU	08.DEC.2015
2	ISSUED FOR CONSTRUCTION	ANBU	16.OCT.2015
1	ISSUED FOR TENDER	ANBU	05.AUG.2015
0	FOR CLIENT CONFIRMATION AND ROUGH ESTIMATION DRAWING	ANBU	18.JUL.2015

CLIENT
HYOSUNG T&D
HYOSUNG CORPORATION INDIA PVT. LTD.


ARCHITECTS & ENGINEERS
HTI ENGINEERING PVT. LTD.
91.44.2252.3743 www.mapgroup.co.kr

PROJECT TITLE
HYOSUNG PUNE PLANT

DRAWING TITLE
GROUND FLOOR PLAN
–

SCALE	DRAWN BY	DESIGNED BY	CHECKED BY	APPROVED BY
A3:1/500 A1:1/250	ANBU	H.G.KIM	-	-
DATE				
20.MAY.2015	20.MAY.2015	20.MAY.2015	–	–

DRAWING NO.
HY–PU–FAC–AA–101
REV. 3

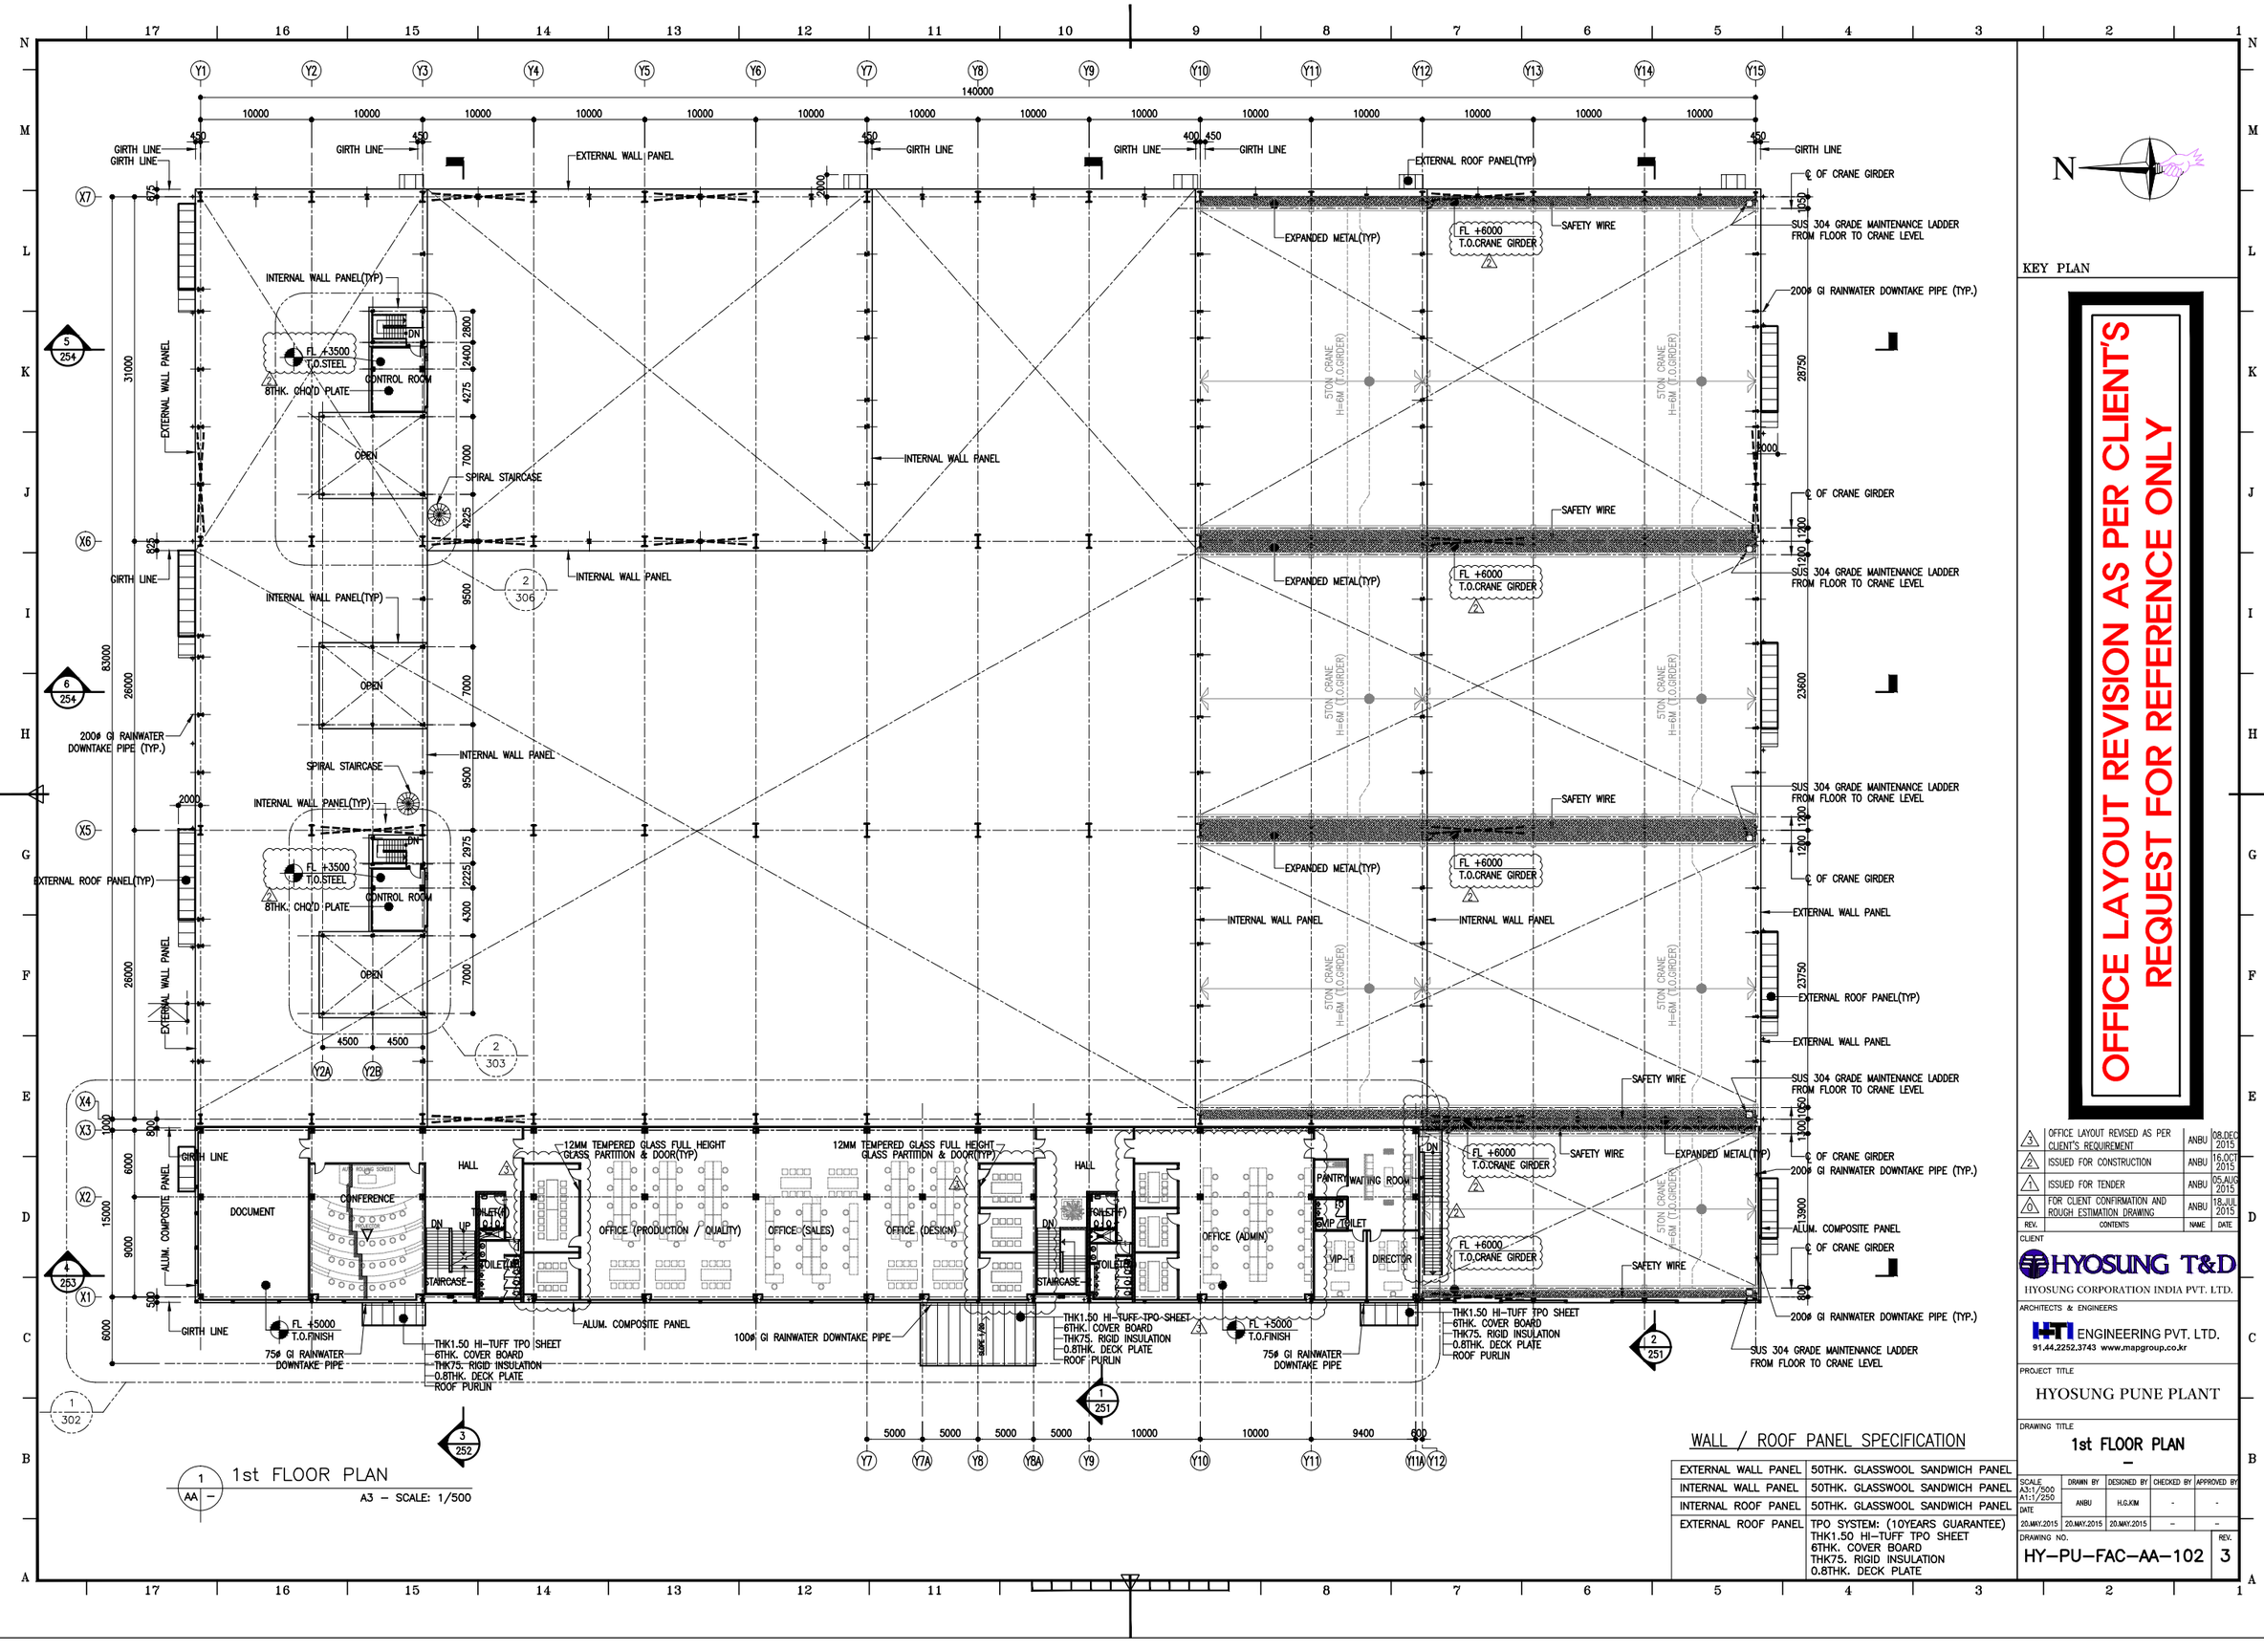

1 AA – 1st FLOOR PLAN

A3 – SCALE: 1/500

WALL / ROOF PANEL SPECIFICATION

EXTERNAL WALL PANEL	50THK. GLASSWOOL SANDWICH PANEL
INTERNAL WALL PANEL	50THK. GLASSWOOL SANDWICH PANEL
INTERNAL ROOF PANEL	50THK. GLASSWOOL SANDWICH PANEL
EXTERNAL ROOF PANEL	TPO SYSTEM: (10YEARS GUARANTEE) THK1.50 HI-TUFF TPO SHEET 6THK. COVER BOARD THK75. RIGID INSULATION 0.8THK. DECK PLATE

N

KEY PLAN

OFFICE LAYOUT REVISED AS PER CLIENT'S REQUIREMENT FOR REFERENCE ONLY

REV.	CONTENTS	NAME	DATE
3	OFFICE LAYOUT REVISED AS PER CLIENT'S REQUIREMENT	ANBU	08.DEC 2015
2	ISSUED FOR CONSTRUCTION	ANBU	16.OCT 2015
1	ISSUED FOR TENDER	ANBU	05.AUG 2015
A	FOR CLIENT CONFIRMATION AND ROUGH ESTIMATION DRAWING	ANBU	18.JUL 2015

CLIENT

HYOSUNG T&D

HYOSUNG CORPORATION INDIA PVT. LTD.

ARCHITECTS & ENGINEERS

HTI ENGINEERING PVT. LTD.

91.44.2252.3743 www.mapgroup.co.kr

PROJECT TITLE

HYOSUNG PUNE PLANT


DRAWING TITLE


1st FLOOR PLAN

–

SCALE	DRAWN BY	DESIGNED BY	CHECKED BY	APPROVED BY
A3:1/500 A1:1/250	ANBU	H.G.KIM	-	-
DATE				
20.MAY.2015	20.MAY.2015	20.MAY.2015	–	–

DRAWING NO. HY–PU–FAC–AA–102 REV. 3

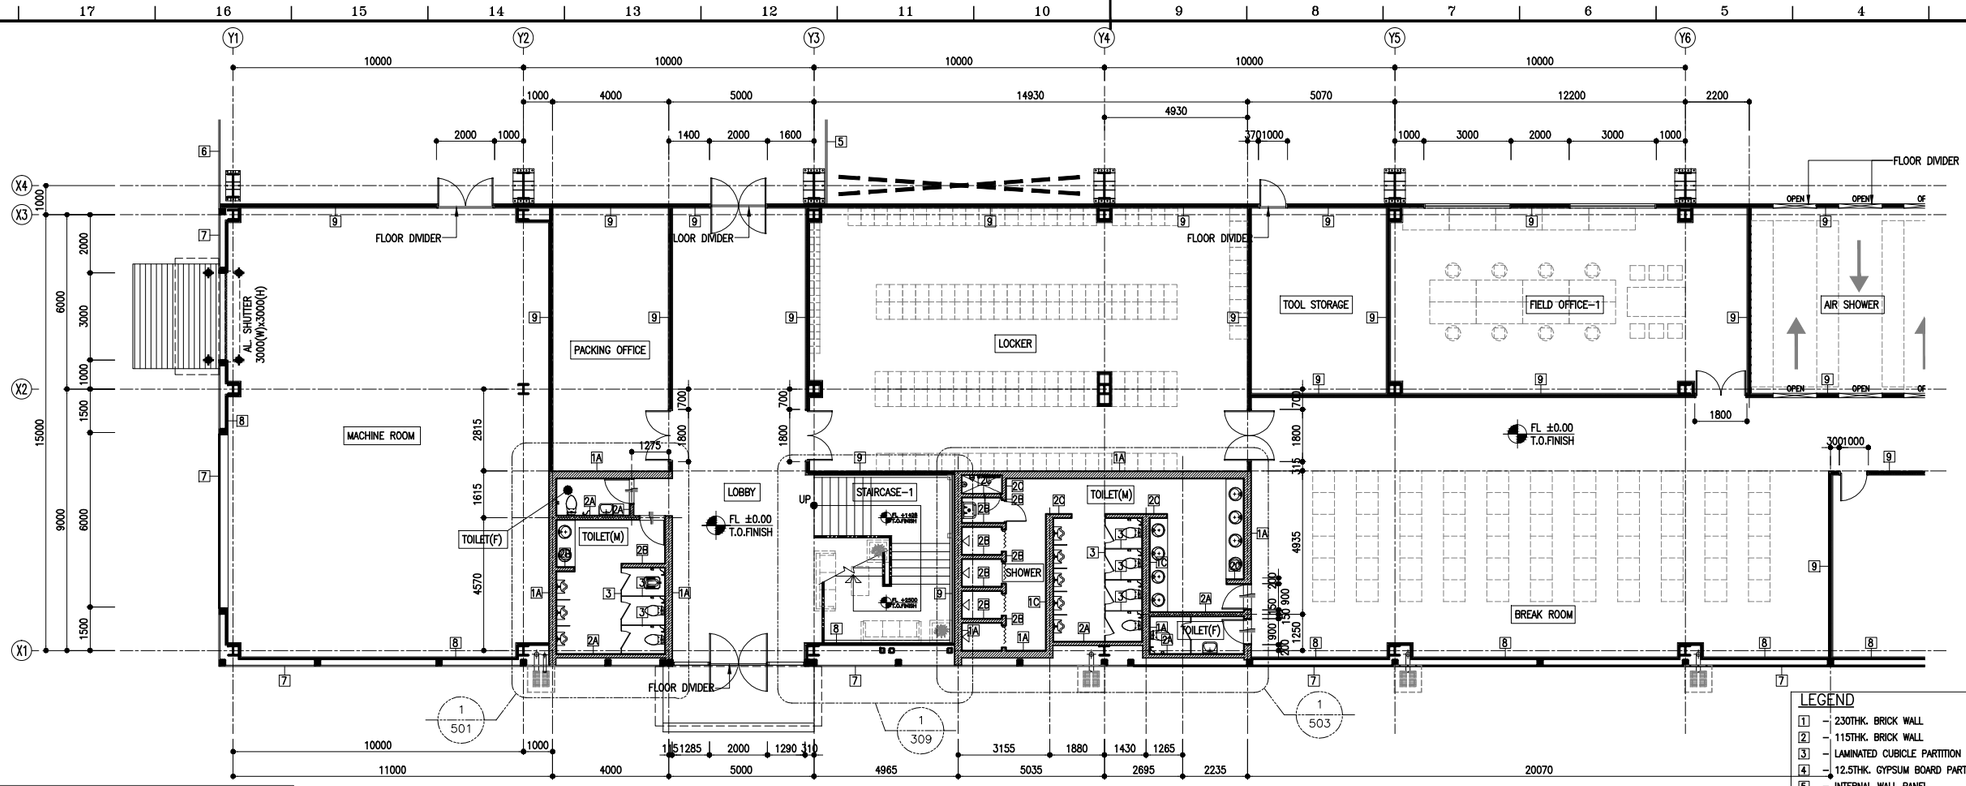

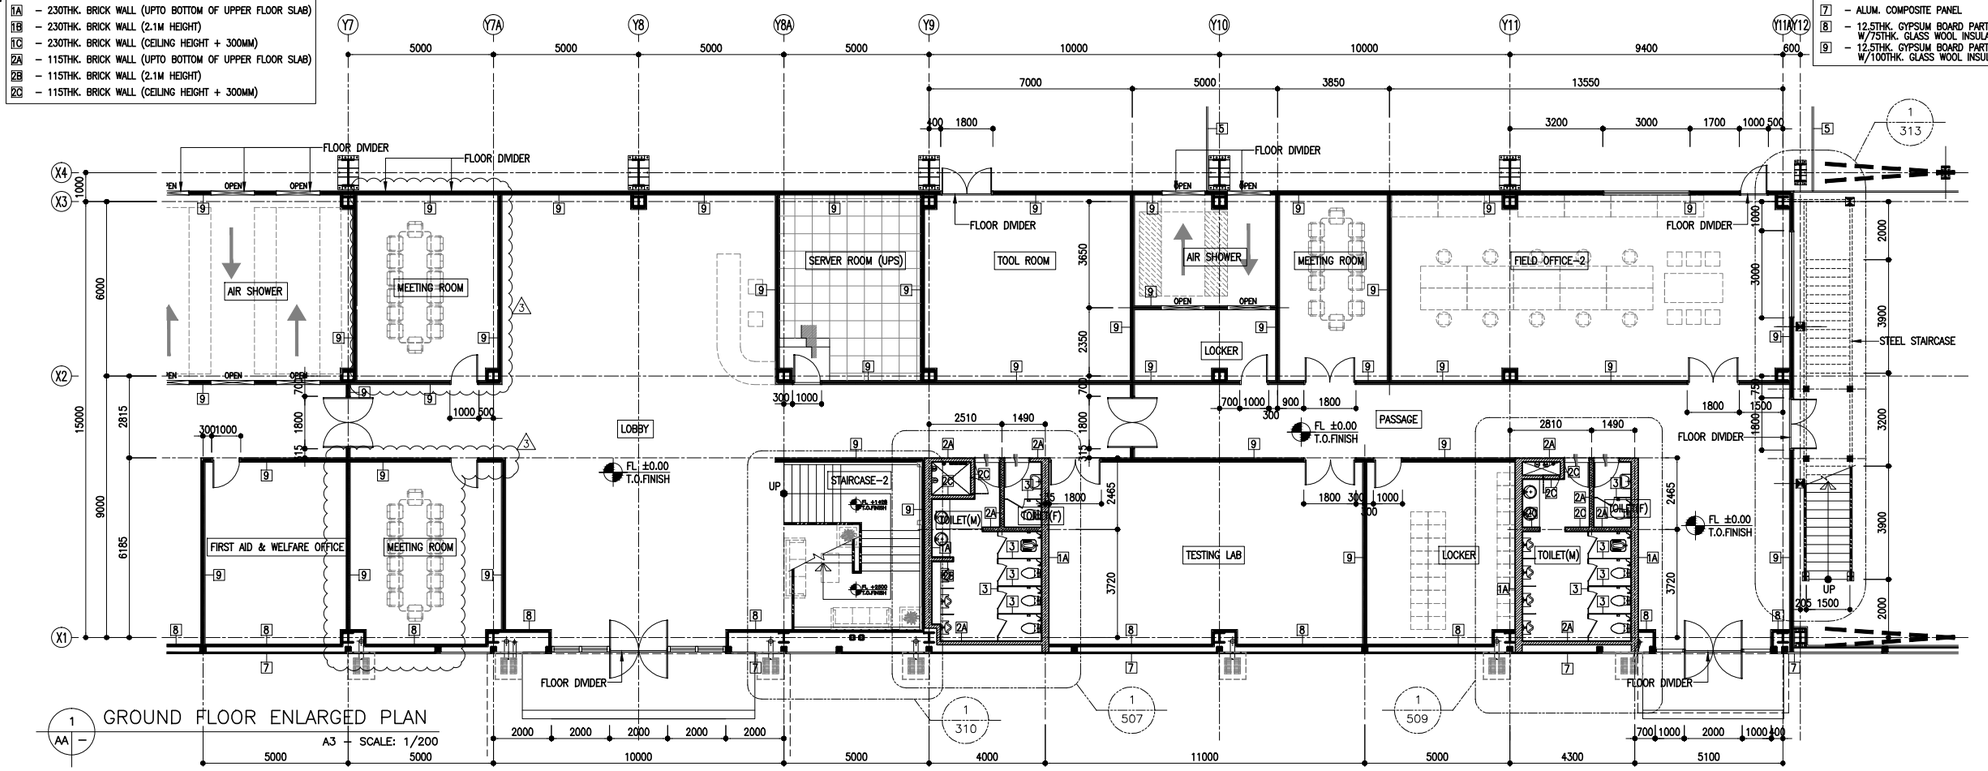

LEGEND

1A – 230THK. BRICK WALL (UPTO BOTTOM OF UPPER FLOOR SLAB)
1B – 230THK. BRICK WALL (2.1M HEIGHT)
1C – 230THK. BRICK WALL (CEILING HEIGHT + 300MM)
2A – 115THK. BRICK WALL (UPTO BOTTOM OF UPPER FLOOR SLAB)
2B – 115THK. BRICK WALL (2.1M HEIGHT)
2C – 115THK. BRICK WALL (CEILING HEIGHT + 300MM)

LEGEND

1 – 230THK. BRICK WALL
2 – 115THK. BRICK WALL
3 – LAMINATED CUBICLE PARTITION
4 – 12.5THK. GYPSUM BOARD PARTITION (2PLY)
5 – INTERNAL WALL PANEL
6 – EXTERNAL WALL PANEL
7 – ALUM. COMPOSITE PANEL
8 – 12.5THK. GYPSUM BOARD PARTITION (2PLY) W/75THK. GLASS WOOL INSULATION (20kg/M3)
9 – 12.5THK. GYPSUM BOARD PARTITION (2PLY) W/100THK. GLASS WOOL INSULATION (20kg/M3)

1 / AA – GROUND FLOOR ENLARGED PLAN
A3 – SCALE: 1/200

KEY PLAN

OFFICE LAYOUT REVISION AS PER CLIENT'S REQUEST FOR REFERENCE ONLY

REV.	CONTENTS	NAME	DATE
3	OFFICE LAYOUT REVISED AS PER CLIENT'S REQUIREMENT	ANBU	08.DEC 2015
2	ISSUED FOR CONSTRUCTION	ANBU	16.OCT 2015
1	ISSUED FOR TENDER	ANBU	05.AUG 2015
0	FOR CLIENT CONFIRMATION AND ROUGH ESTIMATION DRAWING	ANBU	18.JUL 2015

CLIENT
HYOSUNG T&D
HYOSUNG CORPORATION INDIA PVT. LTD.


ARCHITECTS & ENGINEERS
HTI ENGINEERING PVT. LTD.
91.44.2252.3743 www.mapgroup.co.kr

PROJECT TITLE
HYOSUNG PUNE PLANT

DRAWING TITLE
GROUND FLOOR OFFICE ENLARGED PLAN-1

SCALE	DRAWN BY	DESIGNED BY	CHECKED BY	APPROVED BY
A3:1/200 A1:1/100	ANBU	H.G.KIM	-	-
DATE	20.MAY.2015	20.MAY.2015	-	-

DRAWING NO. HY–PU–FAC–AA–301 REV. 3

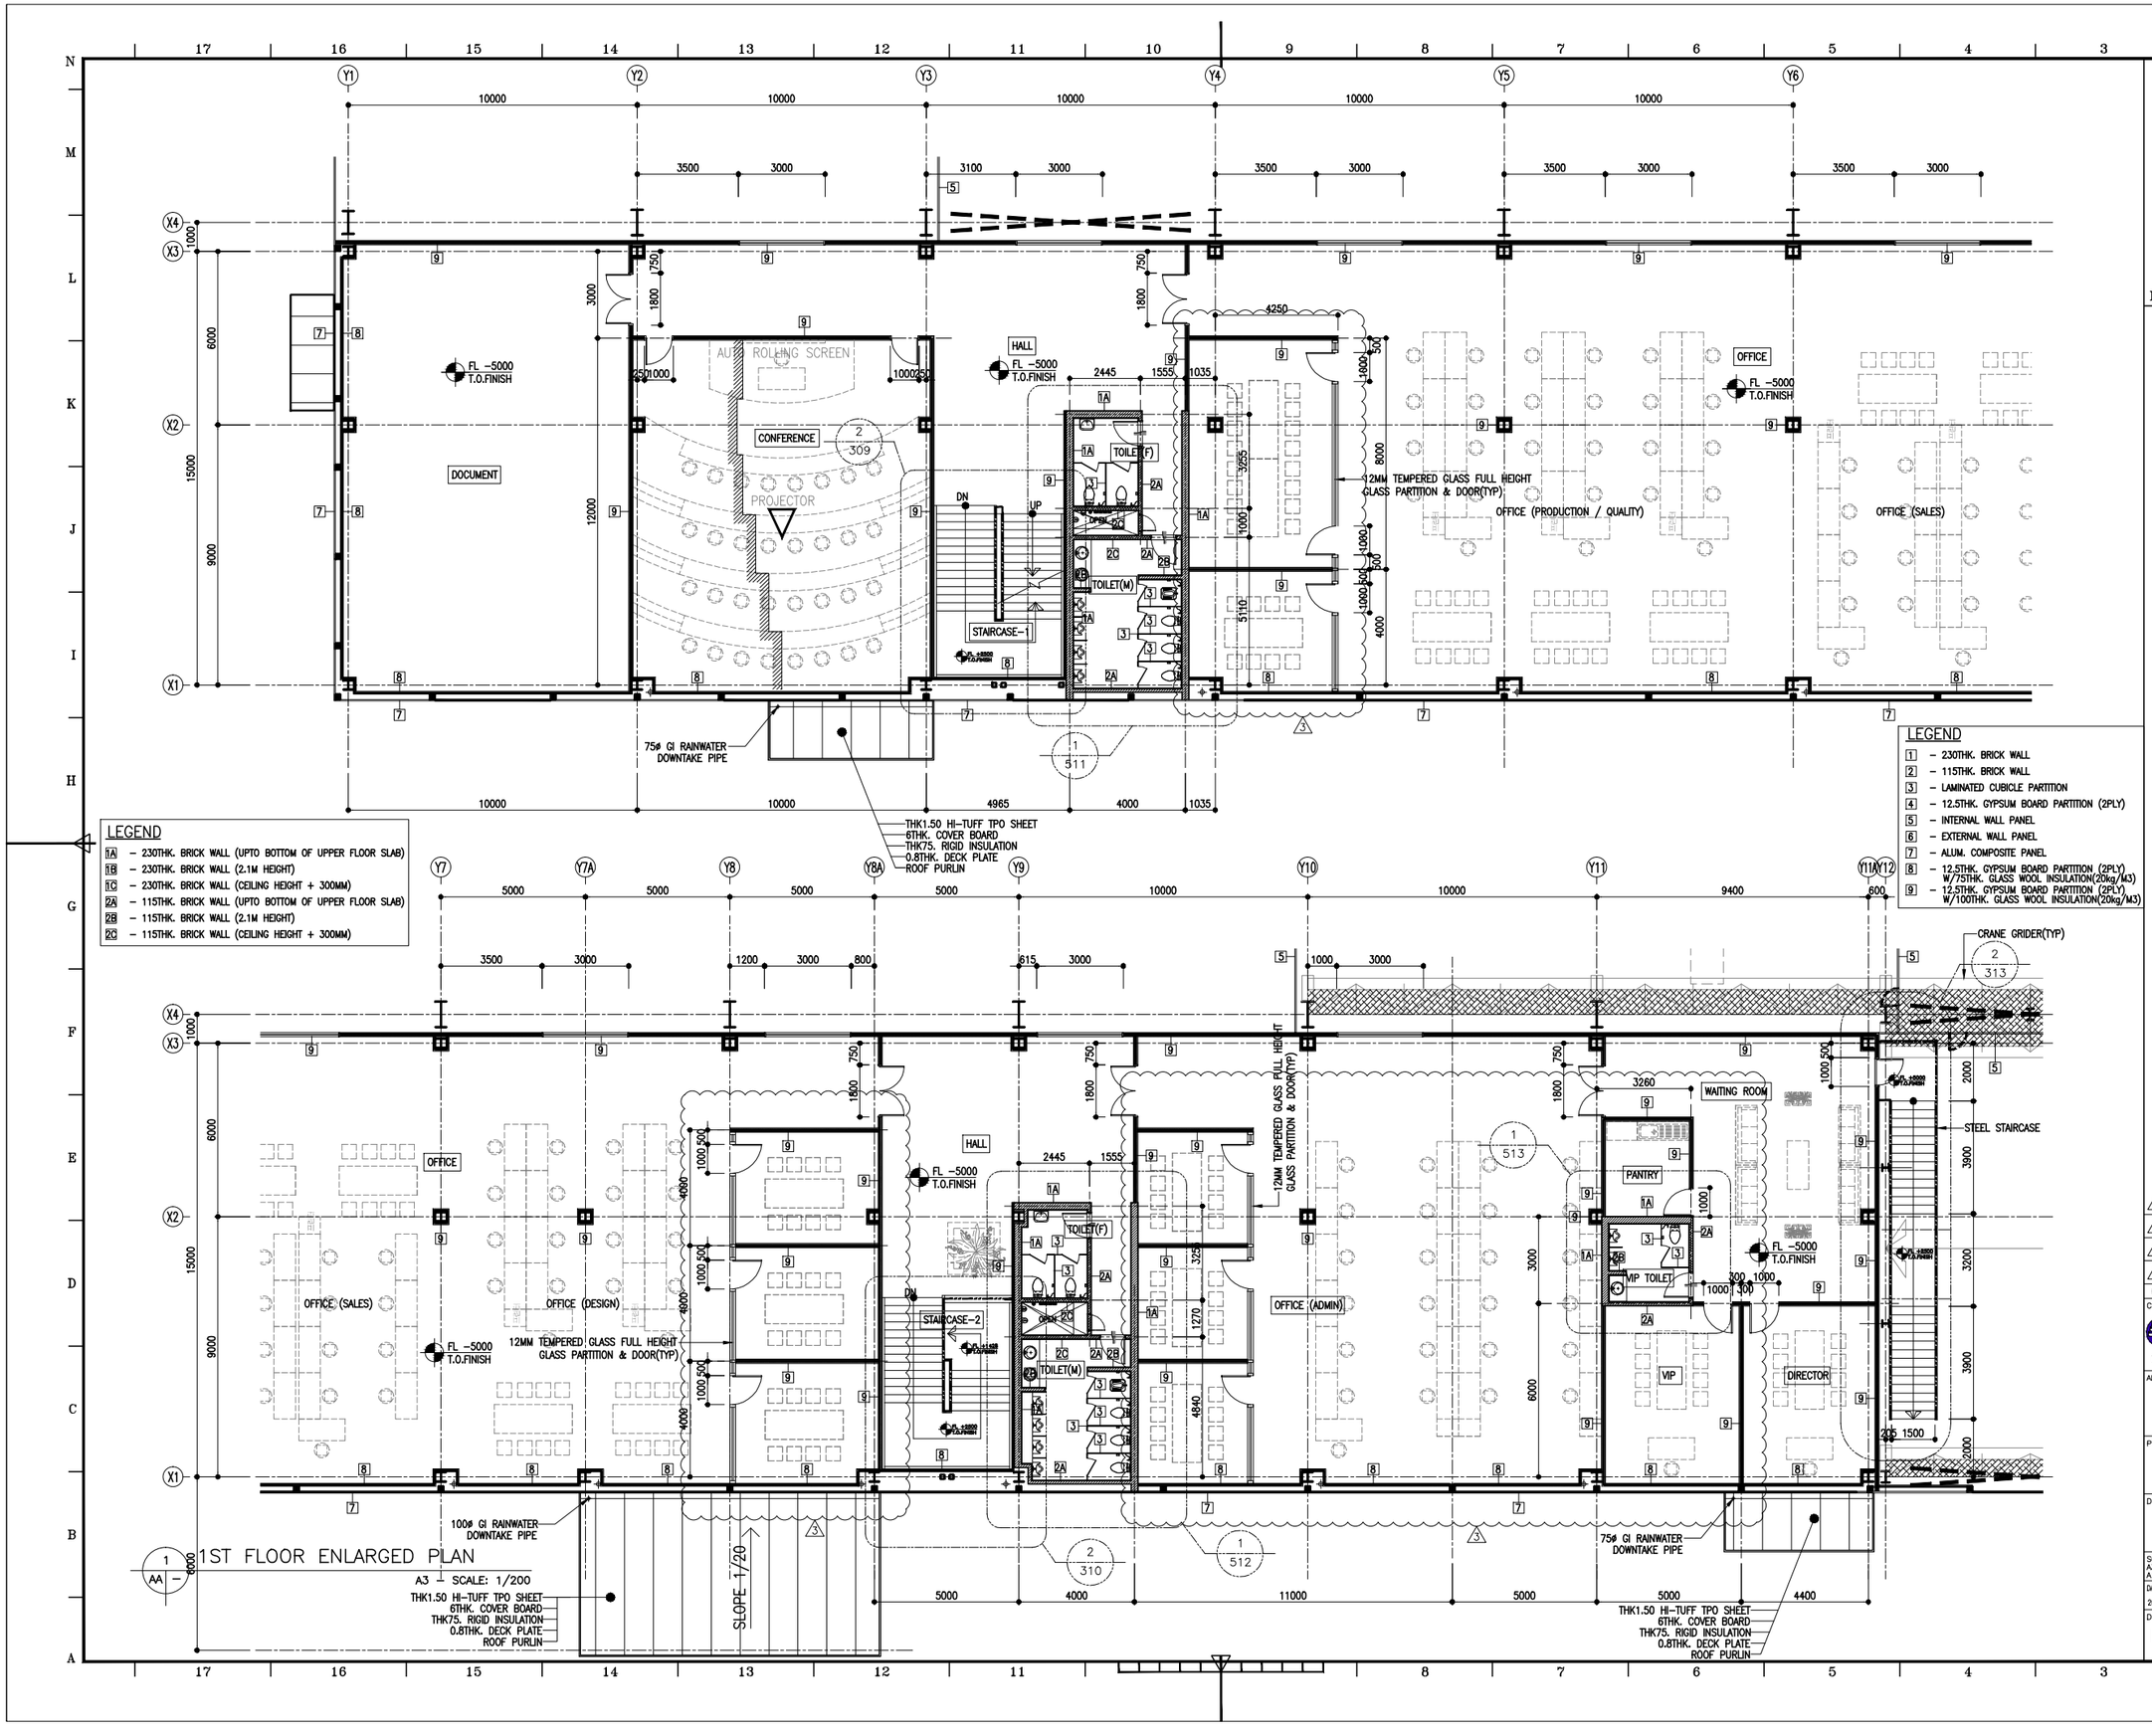

REV.	CONTENTS	NAME	DATE
3	OFFICE LAYOUT REVISED AS PER CLIENT'S REQUIREMENT	ANBU	08.DEC 2015
2	ISSUED FOR CONSTRUCTION	ANBU	16.OCT 2015
1	ISSUED FOR TENDER	ANBU	05.AUG 2015
0	FOR CLIENT CONFIRMATION AND ROUGH ESTIMATION DRAWING	ANBU	18.JUL 2015

CLIENT

HYOSUNG T&D

HYOSUNG CORPORATION INDIA PVT. LTD.

ARCHITECTS & ENGINEERS

HTI ENGINEERING PVT. LTD.

91.44.2252.3743 www.mapgroup.co.kr

PROJECT TITLE


HYOSUNG PUNE PLANT

DRAWING TITLE

1ST FLOOR OFFICE ENLARGED PLAN–2


SCALE	DRAWN BY	DESIGNED BY	CHECKED BY	APPROVED BY
A3:1/200 A1:1/100	ANBU	H.G.KIM	-	-
DATE				
20.MAY.2015	20.MAY.2015	20.MAY.2015	–	–

DRAWING NO. HY–PU–FAC–AA–302 REV. 3

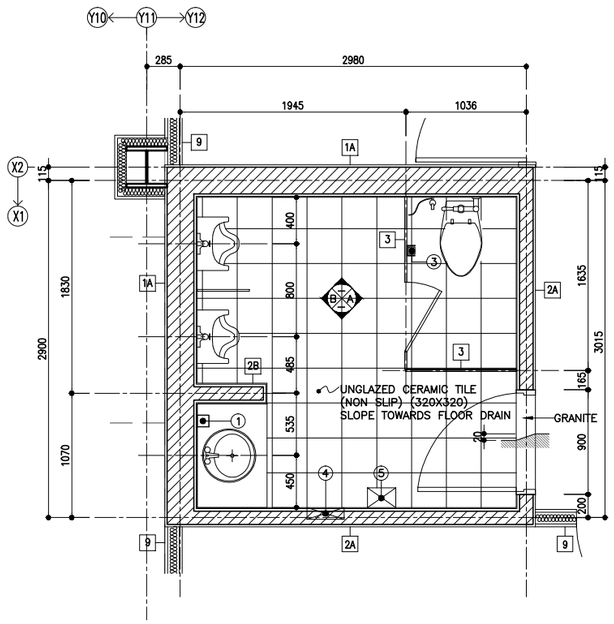


1 AA – 1ST FLOOR VIP TOILET ENLARGED

A3 – SCALE: 1/50

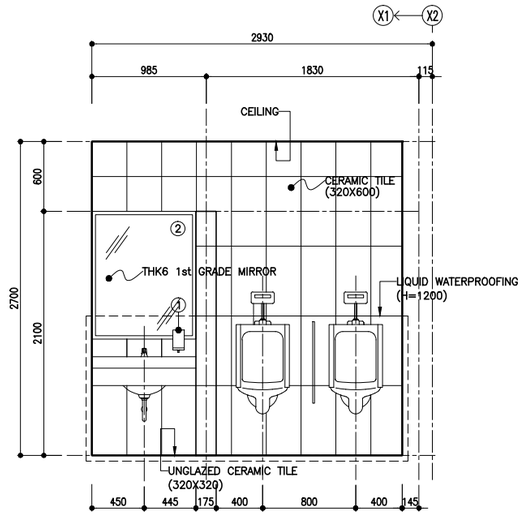

3 AA – ELEVATION–B

A3 – SCALE: 1/50

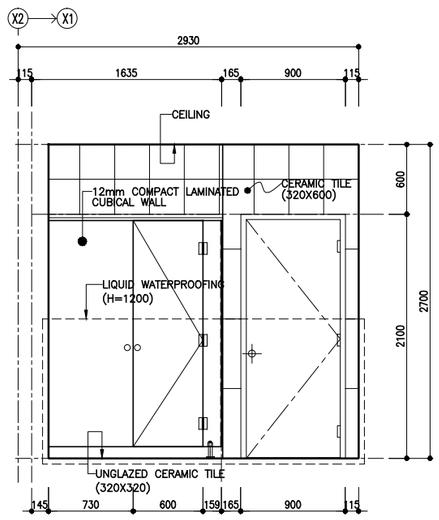

2 AA – ELEVATION–A

A3 – SCALE: 1/50

KEY PLAN

OFFICE LAYOUT REVISION AS PER CLIENT'S REQUEST FOR REFERENCE ONLY

LEGEND

SYMBOL	DESCRIPTION	REMARK
①	SOAP (HAND WASH)	AS PER MANUFACTURER'S SPEC.
②	THK6 1st GRADE MIRROR	AS PER MANUFACTURER'S SPEC.
③	TOILET PAPER HOLDER	AS PER MANUFACTURER'S SPEC.
④	PAPER TOWEL	AS PER MANUFACTURER'S SPEC.
⑤	HAND DRIER	AS PER MANUFACTURER'S SPEC.

LEGEND

1A	– 230THK. BRICK WALL (UPTO BOTTOM OF UPPER FLOOR SLAB)
1B	– 230THK. BRICK WALL (2.1M HEIGHT)
1C	– 230THK. BRICK WALL (CEILING HEIGHT + 300MM)
2A	– 115THK. BRICK WALL (UPTO BOTTOM OF UPPER FLOOR SLAB)
2B	– 115THK. BRICK WALL (2.1M HEIGHT)
2C	– 115THK. BRICK WALL (CEILING HEIGHT + 300MM)

LEGEND

1	– 230THK. BRICK WALL
2	– 115THK. BRICK WALL
3	– LAMINATED CUBICLE PARTITION
4	– 12.5THK. GYPSUM BOARD PARTITION (2PLY)
5	– INTERNAL WALL PANEL
6	– EXTERNAL WALL PANEL
7	– ALUM. COMPOSITE PANEL
8	– 12.5THK. GYPSUM BOARD PARTITION (2PLY) W/75THK. GLASS WOOL INSULATION(20kg/M3)

REV.	CONTENTS	NAME	DATE
2	ISSUED FOR CONSTRUCTION	ANBU	16.OCT.2015
1	ISSUED FOR TENDER	ANBU	05.AUG.2015
0	FOR CLIENT CONFIRMATION AND ROUGH ESTIMATION DRAWING	ANBU	18.JUL.2015

CLIENT

HYOSUNG T&D

HYOSUNG CORPORATION INDIA PVT. LTD.

ARCHITECTS & ENGINEERS

HTI ENGINEERING PVT. LTD.
91.44.2252.3743 www.mapgroup.co.kr

PROJECT TITLE


HYOSUNG PUNE PLANT

DRAWING TITLE

1ST FLOOR
VIP TOILET ENLARGED PLAN/ELEVATION

SCALE	DRAWN BY	DESIGNED BY	CHECKED BY	APPROVED BY
A3:1/50 A1:1/25	ANBU	H.G.KIM	-	-
DATE				
20.MAY.2015	20.MAY.2015	20.MAY.2015	–	–

DRAWING NO. HY–PU–FAC–AA–513 REV. 2

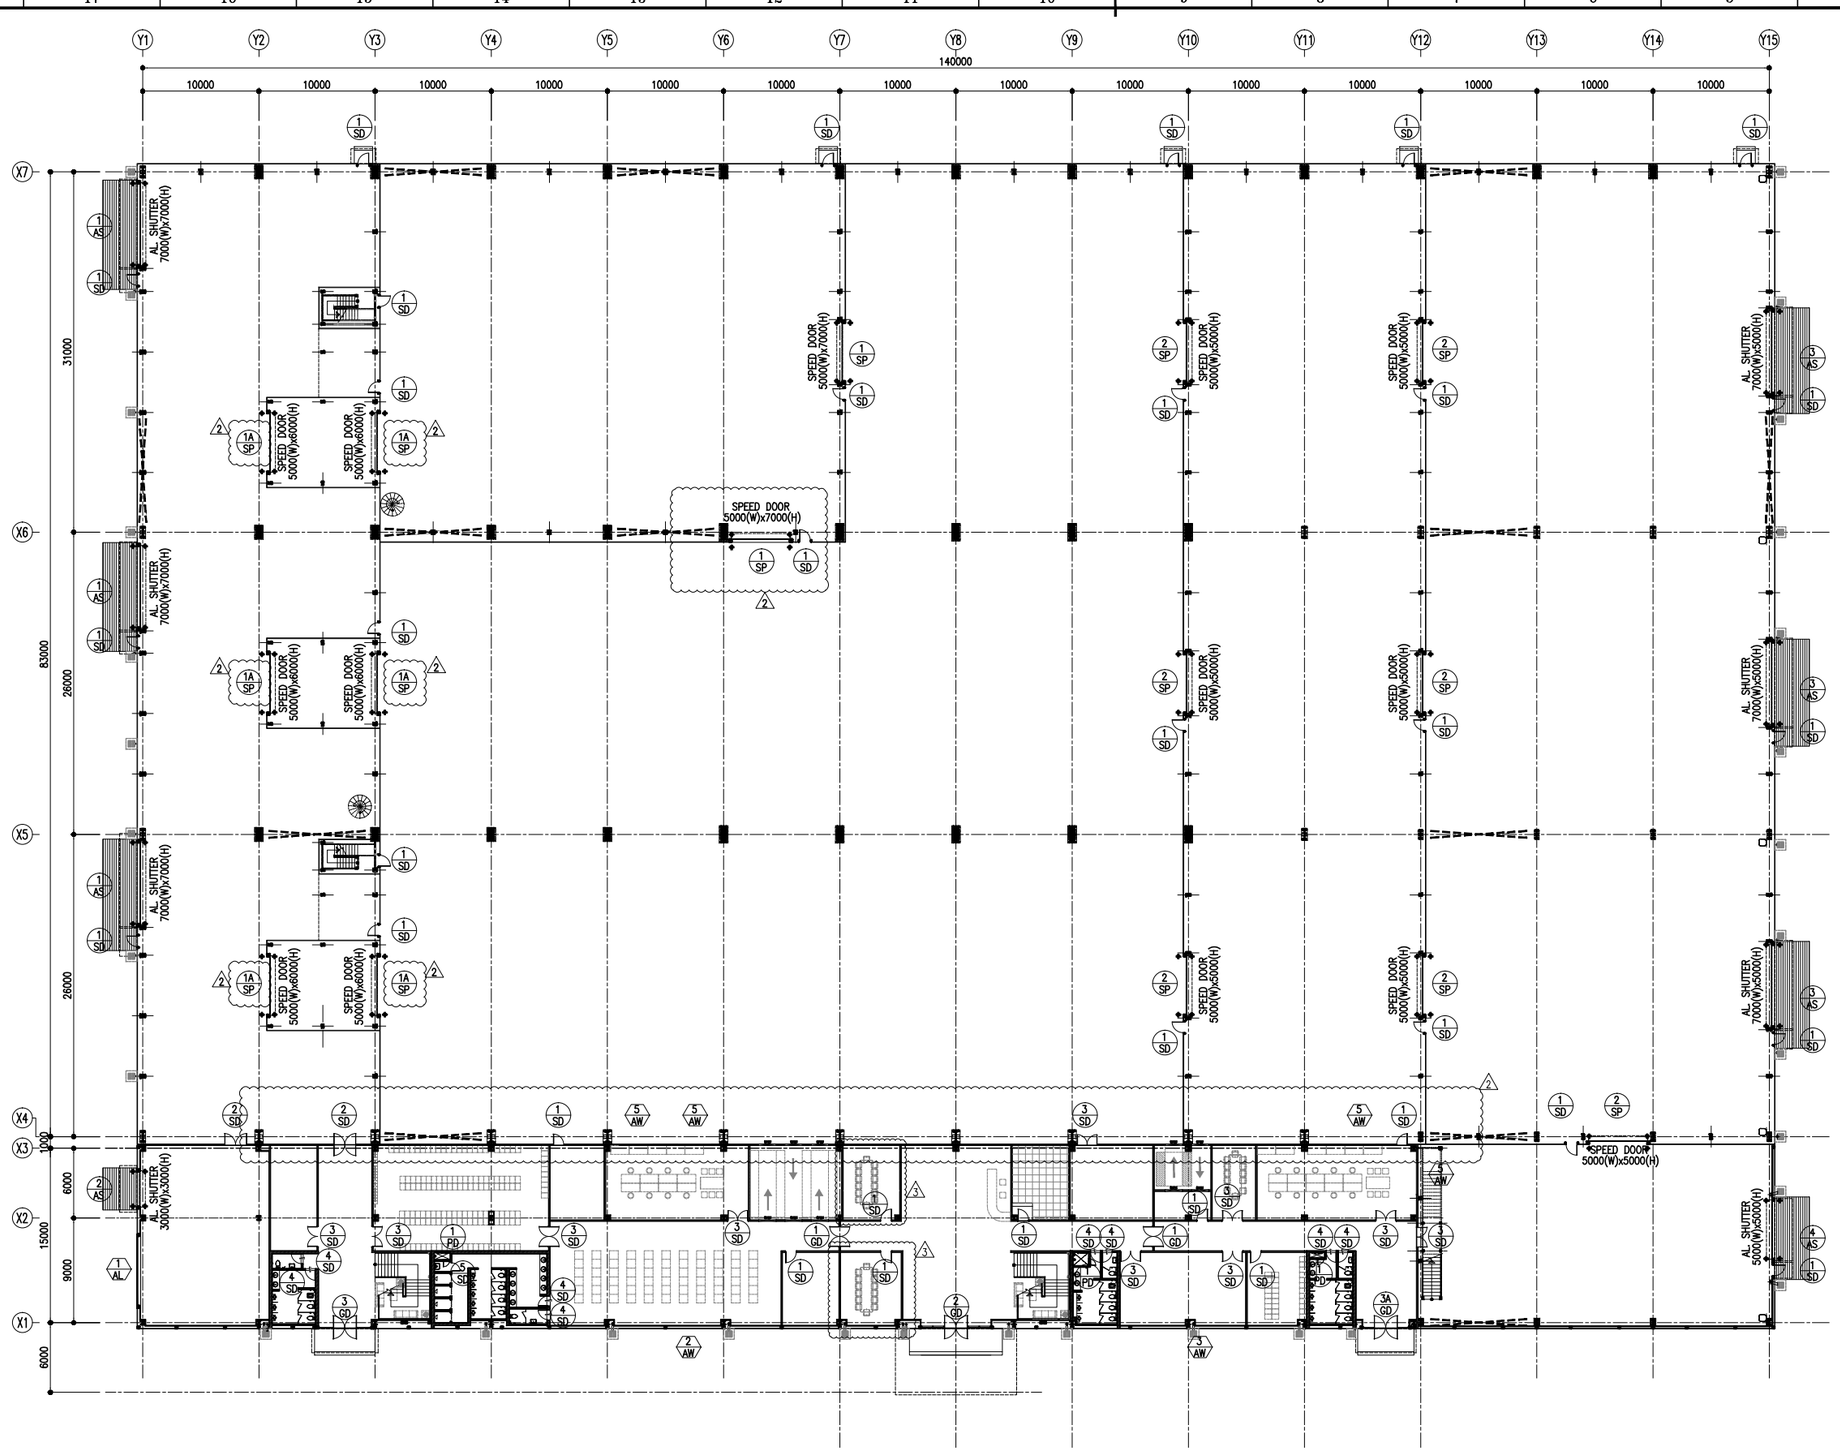

1 / AA – GROUND FLOOR DOOR AND WINDOW ARRANGEMENT PLAN

A3 – SCALE: 1/500

N

KEY PLAN

OFFICE LAYOUT REVISION AS PER CLIENT'S REQUIREMENT FOR REFERENCE ONLY

REV.	CONTENTS	NAME	DATE
3	OFFICE LAYOUT REVISED AS PER CLIENT'S REQUIREMENT	ANBU	08.DEC 2015
2	ISSUED FOR CONSTRUCTION	ANBU	16.OCT 2015
1	ISSUED FOR TENDER	ANBU	05.AUG 2015
0	FOR CLIENT CONFIRMATION AND ROUGH ESTIMATION DRAWING	ANBU	18.JUL 2015

CLIENT

HYOSUNG T&D

HYOSUNG CORPORATION INDIA PVT. LTD.

ARCHITECTS & ENGINEERS

HTI ENGINEERING PVT. LTD.

91.44.2252.3743 www.mapgroup.co.kr

PROJECT TITLE


HYOSUNG PUNE PLANT

DRAWING TITLE

GROUND FLOOR DOOR AND WINDOW ARRANGEMENT PLAN

SCALE	DRAWN BY	DESIGNED BY	CHECKED BY	APPROVED BY
A3:1/500 A1:1/250	ANBU	H.G.KIM	-	-
DATE				
20.MAY.2015	20.MAY.2015	20.MAY.2015	–	–

DRAWING NO. HY–PU–FAC–AA–601 REV. 3

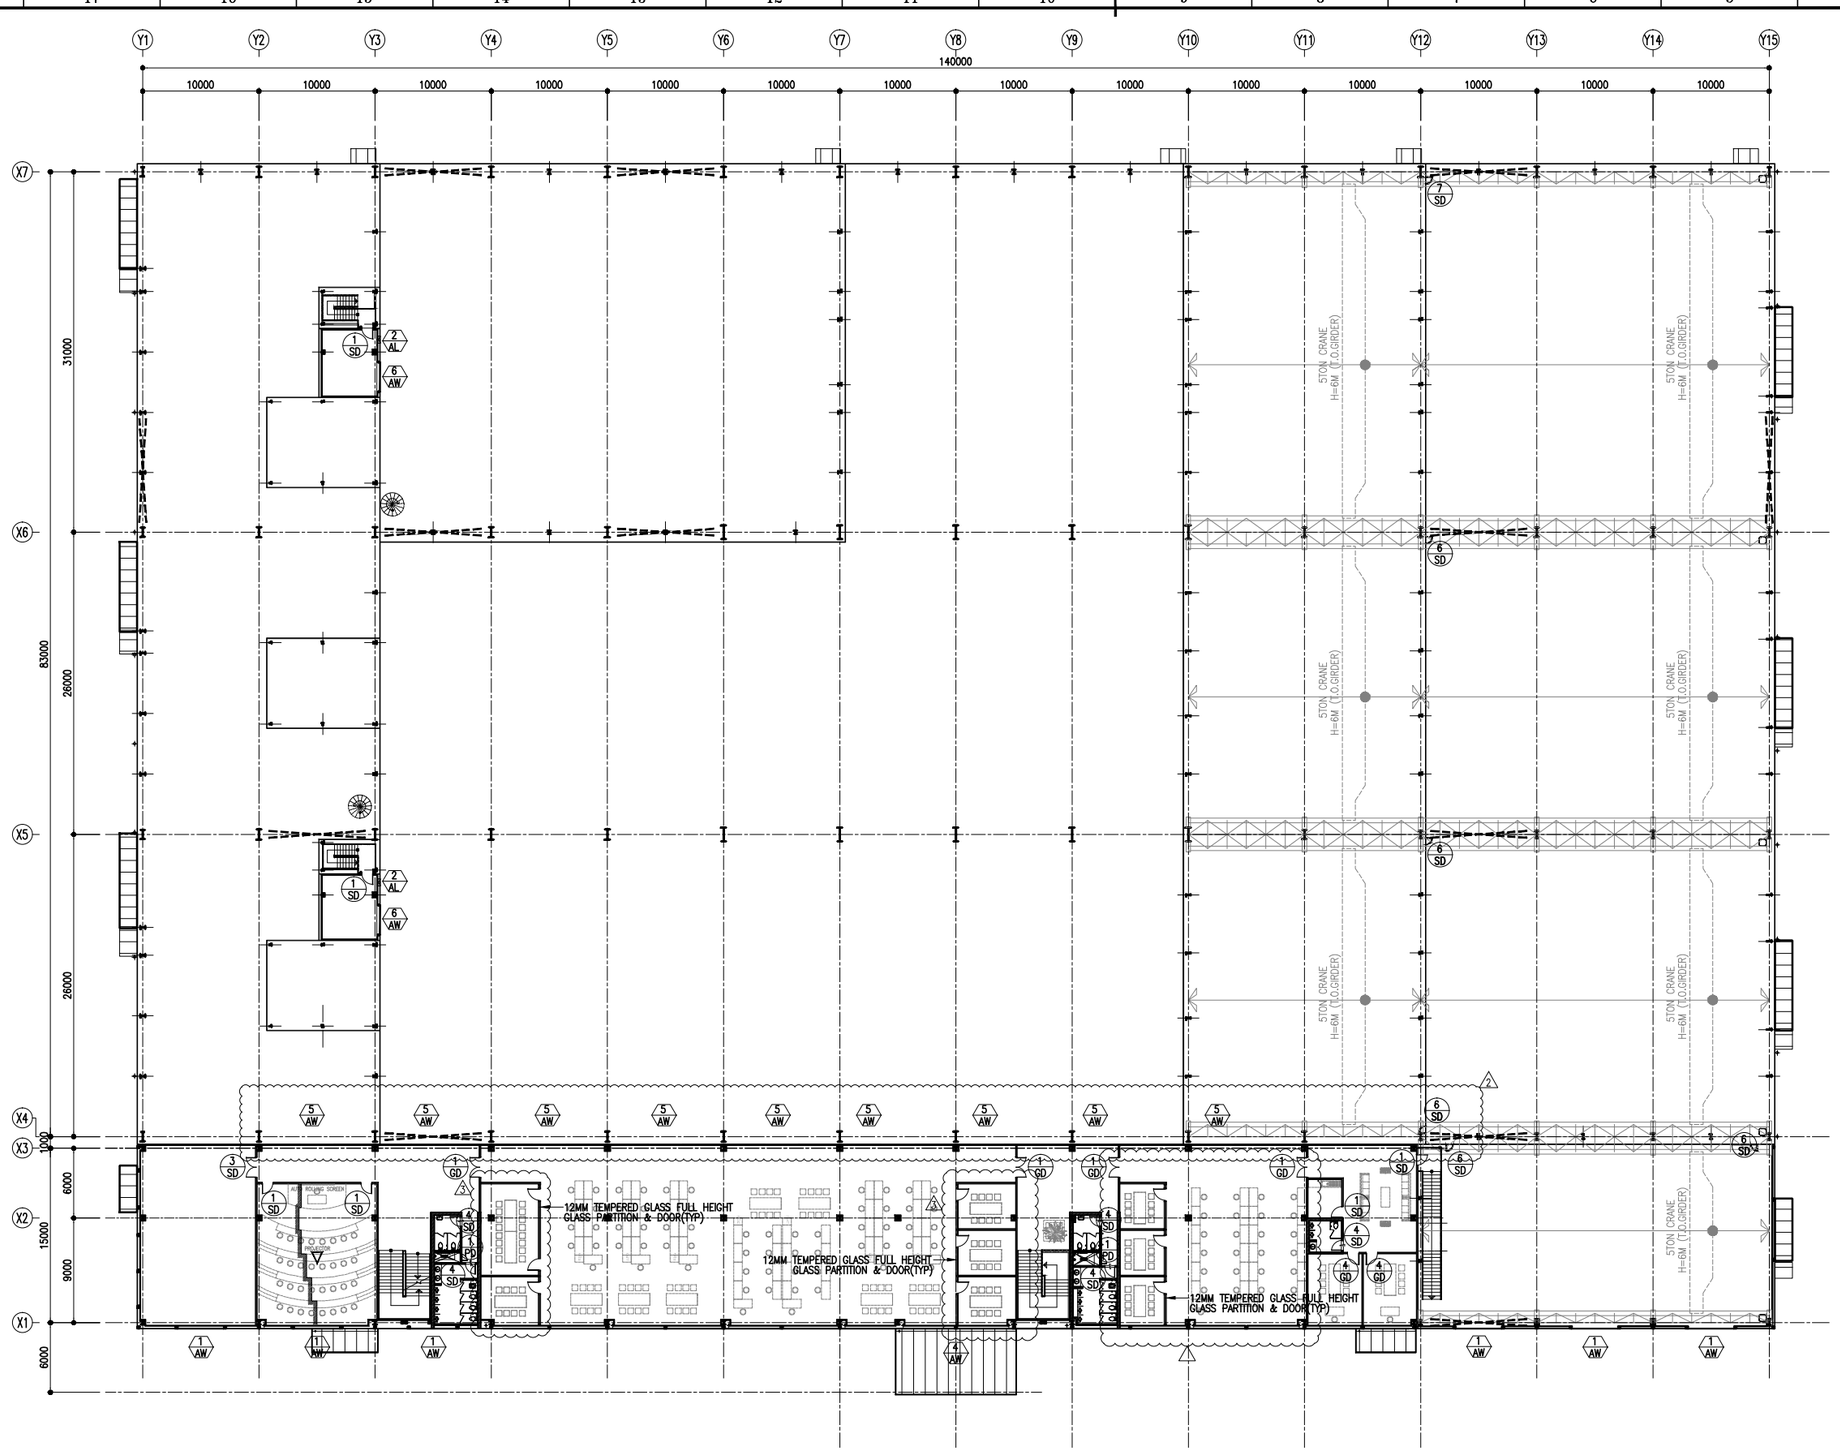

1 / AA – 1st FLOOR DOOR AND WINDOW ARRANGEMENT PLAN

A3 – SCALE: 1/500

N

KEY PLAN

OFFICE LAYOUT REVISION AS PER CLIENT'S REQUEST FOR REFERENCE ONLY

REV.	CONTENTS	NAME	DATE
3	OFFICE LAYOUT REVISED AS PER CLIENT'S REQUIREMENT	ANBU	08.DEC 2015
2	ISSUED FOR CONSTRUCTION	ANBU	16.OCT 2015
1	ISSUED FOR TENDER	ANBU	05.AUG 2015
0	FOR CLIENT CONFIRMATION AND ROUGH ESTIMATION DRAWING	ANBU	18.JUL 2015

CLIENT

HYOSUNG T&D

HYOSUNG CORPORATION INDIA PVT. LTD.

ARCHITECTS & ENGINEERS

HTI ENGINEERING PVT. LTD.

91.44.2252.3743 www.mapgroup.co.kr

PROJECT TITLE


HYOSUNG PUNE PLANT

DRAWING TITLE

1st FLOOR DOOR AND WINDOW ARRANGEMENT PLAN

SCALE	DRAWN BY	DESIGNED BY	CHECKED BY	APPROVED BY
A3:1/500 A1:1/250	ANBU	H.G.KIM	-	-
DATE				
20.MAY.2015	20.MAY.2015	20.MAY.2015	–	–

DRAWING NO. HY–PU–FAC–AA–602 REV. 3

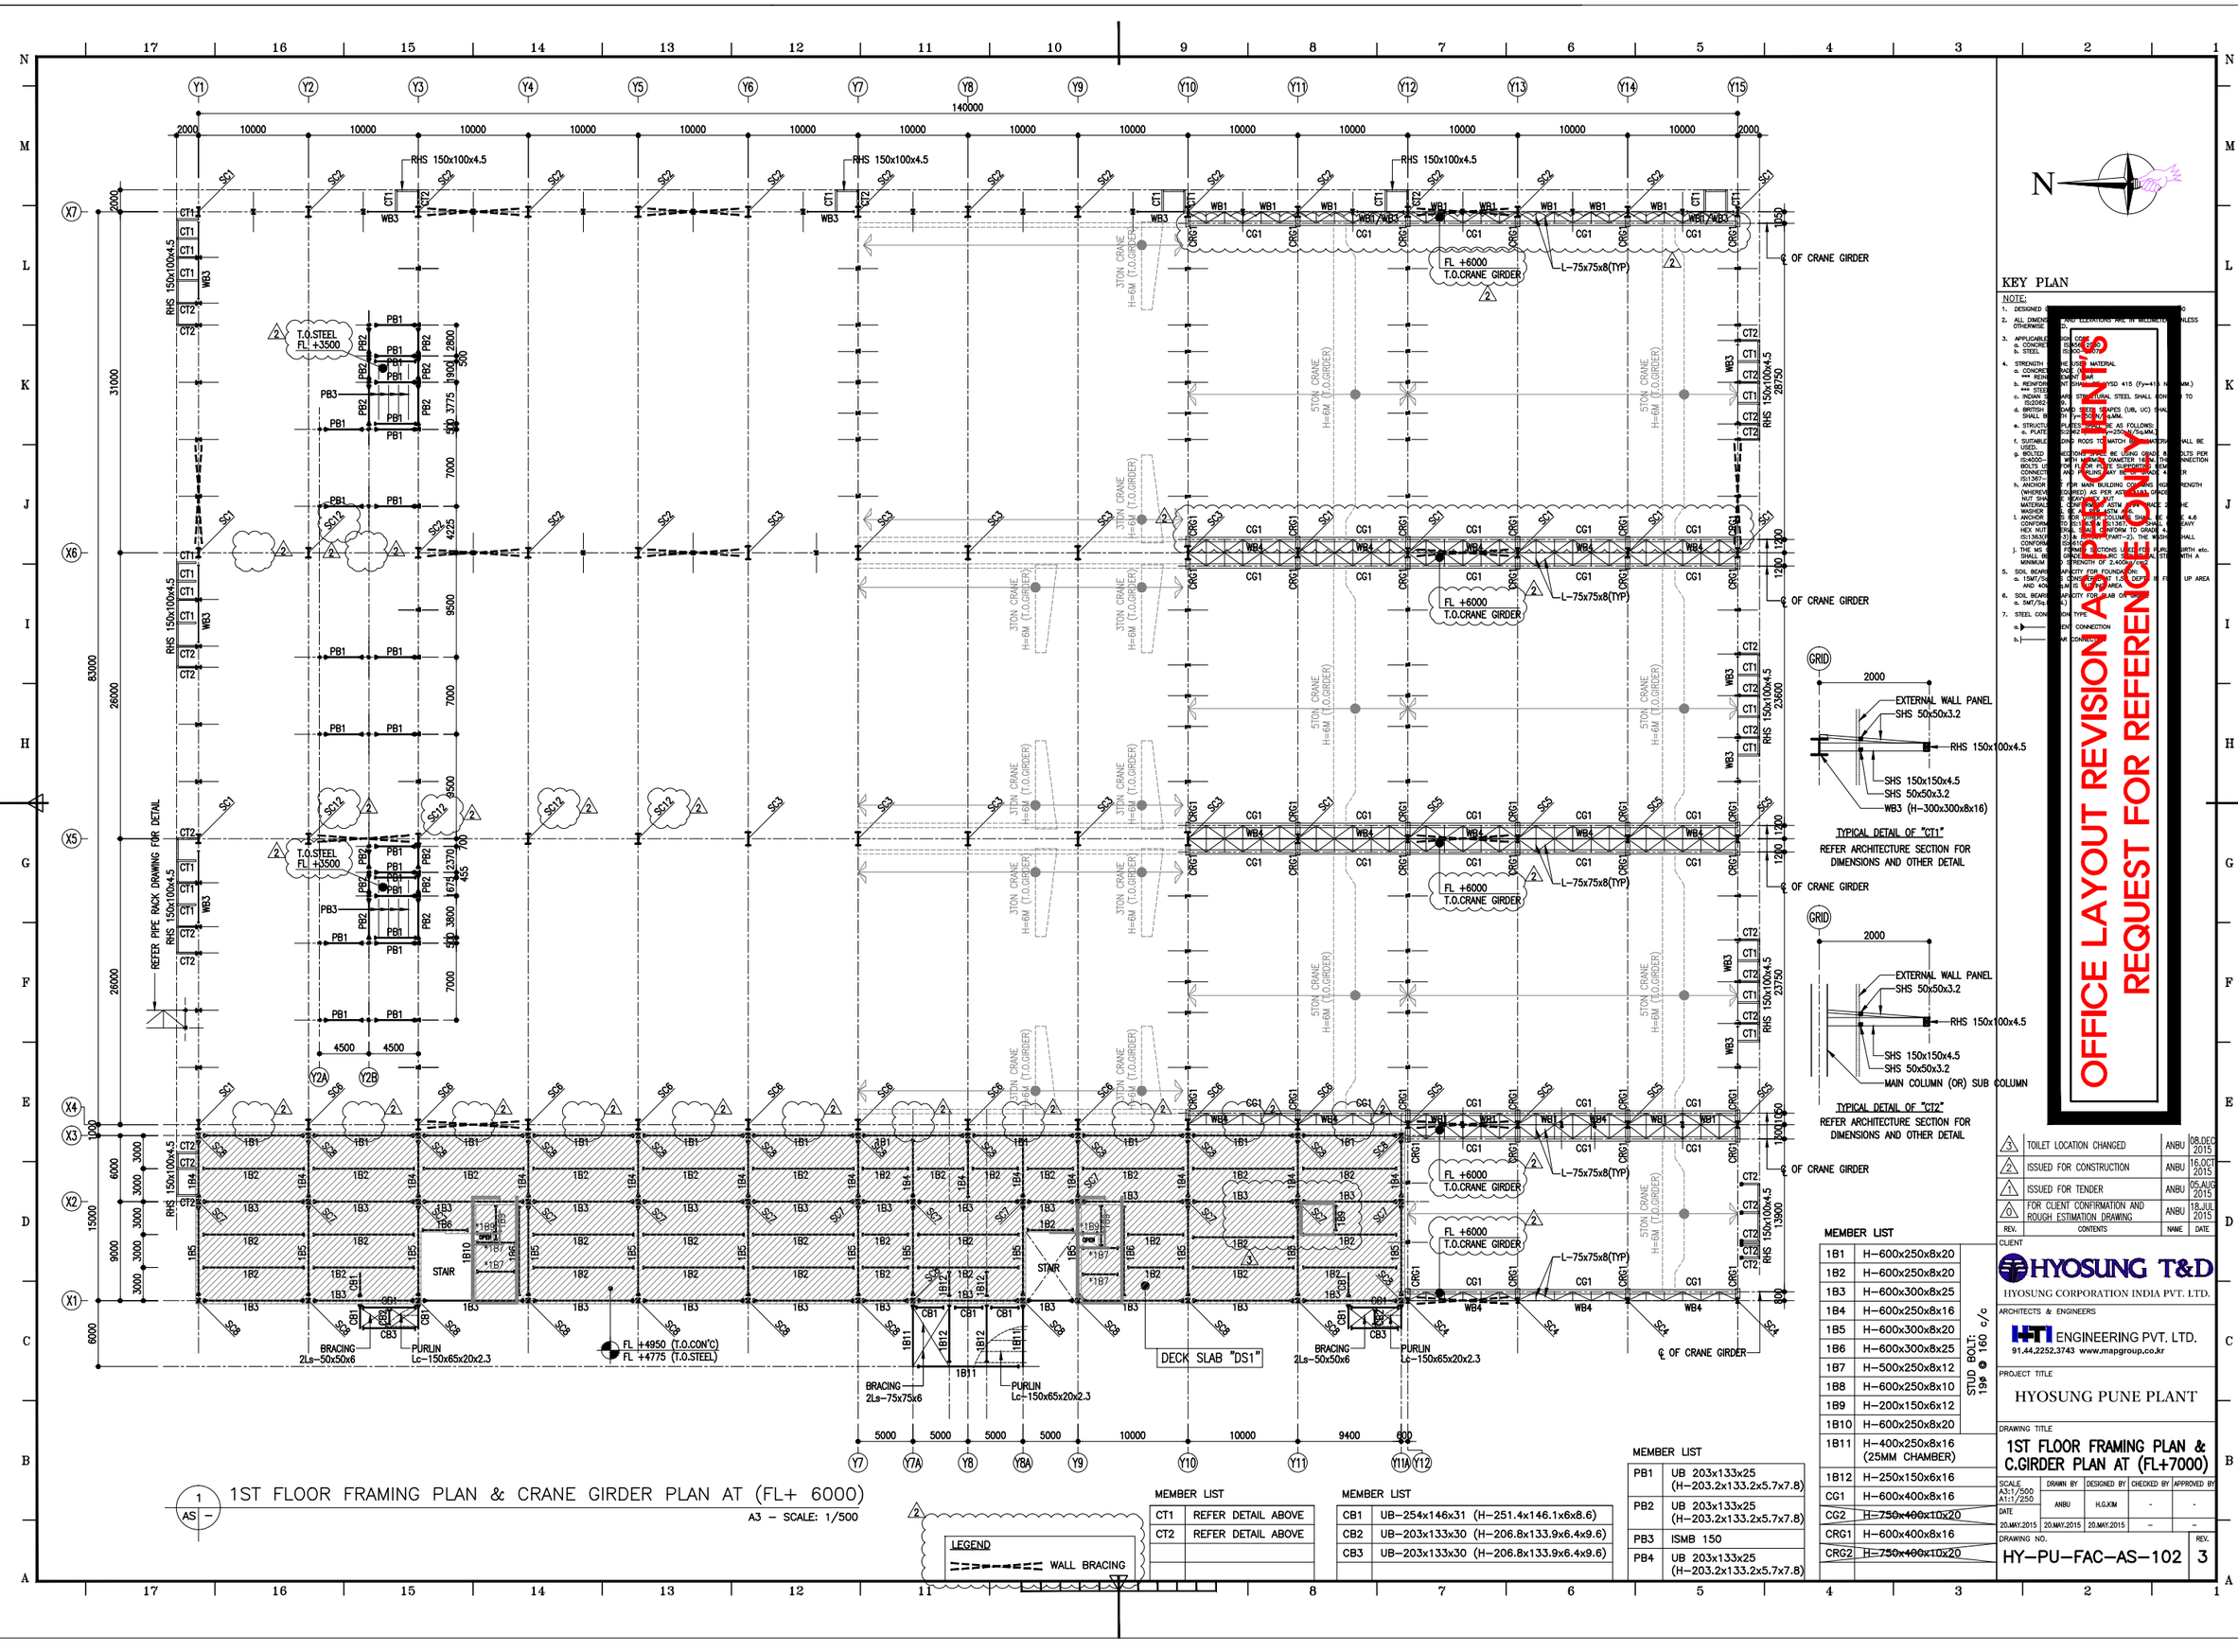

1 AS – 1ST FLOOR FRAMING PLAN & CRANE GIRDER PLAN AT (FL+ 6000)

A3 – SCALE: 1/500

NOTE:

1. DESIGNED [illegible] 0
2. ALL DIMENSIONS [illegible] AND ELEVATIONS ARE IN MILLIMETER UNLESS OTHERWISE [illegible]
3. APPLICABLE [illegible] CODE
   a. CONCRETE [illegible] IS456:2000
   b. STEEL [illegible] IS800:2007
4. STRENGTH [illegible] THE USED MATERIAL
   a. CONCRETE [illegible] GRADE (N/MM²)
   *** REINFORCEMENT [illegible] CEMENT BAR
   b. REINFORCEMENT [illegible] SHALL BE HYSD 415 (Fy=415 N/MM²)
   *** STEEL [illegible]
   c. INDIAN STANDARD [illegible] STRUCTURAL STEEL SHALL CONFORM TO IS2062
   d. BRITISH STANDARD [illegible] ROLLED STEEL SECTIONS (UB, UC) SHALL SHALL BE [illegible] BS4:1993
   e. STRUCTURAL [illegible] PLATES SHALL BE AS FOLLOWS:
      a. PLATE [illegible] IS2062 GRADE E250(Fe410W)A/B/C
   f. SUITABLE [illegible] WELDING RODS TO MATCH THE [illegible] MATERIAL SHALL BE USED.
   g. BOLTED [illegible] CONNECTIONS SHALL BE USING GRADE [illegible] BOLTS PER IS:4000- [illegible] WITH MINIMUM DIAMETER 16 MM. THE CONNECTION BOLTS USED [illegible] FOR FLOOR OR PLATE SUPPORTS. OVERALL CONNECTIONS AND [illegible] PULLING MAY BE [illegible] AS PER IS:1367- [illegible]
   h. ANCHOR [illegible] FOR MAIN BUILDING CONSISTING HIGH STRENGTH (WHEREVER [illegible] REQUIRED) AS PER ASTM A193 GRADE [illegible] NUT SHALL BE [illegible] ASTM A194 GRADE 2H. THE MATERIALS [illegible] CONFORM TO ASTM A36. FACE OF THE WASHER [illegible] BE A [illegible] ASTM A563.
   i. ANCHOR [illegible] FOR OTHER COLUMNS SHALL BE [illegible] 4.6 CONFORMING TO IS:1367. [illegible] SHALL BE HEAVY HEX NUT [illegible] SHALL CONFORM TO GRADE 4S OF IS:1363 (PART-3) & WASHER SHALL CONFORM TO IS:6610.
   j. THE MS [illegible] FOR FORMATIONS LIKE FOR PURLIN, GIRTH etc. SHALL BE [illegible] GRADE [illegible] MS CONFORMING TO IS 2062 STEEL WITH A MINIMUM [illegible] STRENGTH OF 2400KG/CM².
5. SOIL BEARING [illegible] CAPACITY FOR FOUNDATION:
   a. 15MT/Sq.M [illegible] CONSIDERED AT 1.5M DEPTH IN FIRM UP AREA AND 40MT/SQ.M IS [illegible] AREA
6. SOIL BEARING [illegible] CAPACITY FOR SLAB ON GRADE:
   a. 5MT/Sq.M [illegible]
7. STEEL CONNECTION TYPE
   a. [illegible] CONNECTION
   b. [illegible] CONNECTION

MEMBER LIST

1B1	H-600x250x8x20
1B2	H-600x250x8x20
1B3	H-600x300x8x25
1B4	H-600x250x8x16
1B5	H-600x300x8x20
1B6	H-600x300x8x25
1B7	H-500x250x8x12
1B8	H-600x250x8x10
1B9	H-200x150x6x12
1B10	H-600x250x8x20
1B11	H-400x250x8x16 (25MM CHAMBER)
1B12	H-250x150x6x16
CG1	H-600x400x8x16
CG2	~~H-750x400x10x20~~
CRG1	H-600x400x8x16
CRG2	~~H-750x400x10x20~~

MEMBER LIST

CT1	REFER DETAIL ABOVE
CT2	REFER DETAIL ABOVE

MEMBER LIST

CB1	UB-254x146x31 (H-251.4x146.1x6x8.6)
CB2	UB-203x133x30 (H-206.8x133.9x6.4x9.6)
CB3	UB-203x133x30 (H-206.8x133.9x6.4x9.6)

MEMBER LIST

PB1	UB 203x133x25 (H-203.2x133.2x5.7x7.8)
PB2	UB 203x133x25 (H-203.2x133.2x5.7x7.8)
PB3	ISMB 150
PB4	UB 203x133x25 (H-203.2x133.2x5.7x7.8)

OFFICE LAYOUT REVISIONS AS PER REQUEST FOR REFERENCE

REV.	CONTENTS	NAME	DATE
3	TOILET LOCATION CHANGED	ANBU	08.DEC.2015
2	ISSUED FOR CONSTRUCTION	ANBU	16.OCT.2015
1	ISSUED FOR TENDER	ANBU	05.AUG.2015
0	FOR CLIENT CONFIRMATION AND ROUGH ESTIMATION DRAWING	ANBU	18.JUL.2015

CLIENT: HYOSUNG T&D
HYOSUNG CORPORATION INDIA PVT. LTD.


ARCHITECTS & ENGINEERS
HTI ENGINEERING PVT. LTD.
91,44,2252,3743 www.mapgroup.co.kr

PROJECT TITLE: HYOSUNG PUNE PLANT

DRAWING TITLE: 1ST FLOOR FRAMING PLAN & C.GIRDER PLAN AT (FL+7000)


SCALE	DRAWN BY	DESIGNED BY	CHECKED BY	APPROVED BY
A3:1/500 A1:1/250	ANBU	H.G.KIM	-	-
DATE	20.MAY.2015	20.MAY.2015	–	–

DRAWING NO. HY-PU-FAC-AS-102 REV. 3

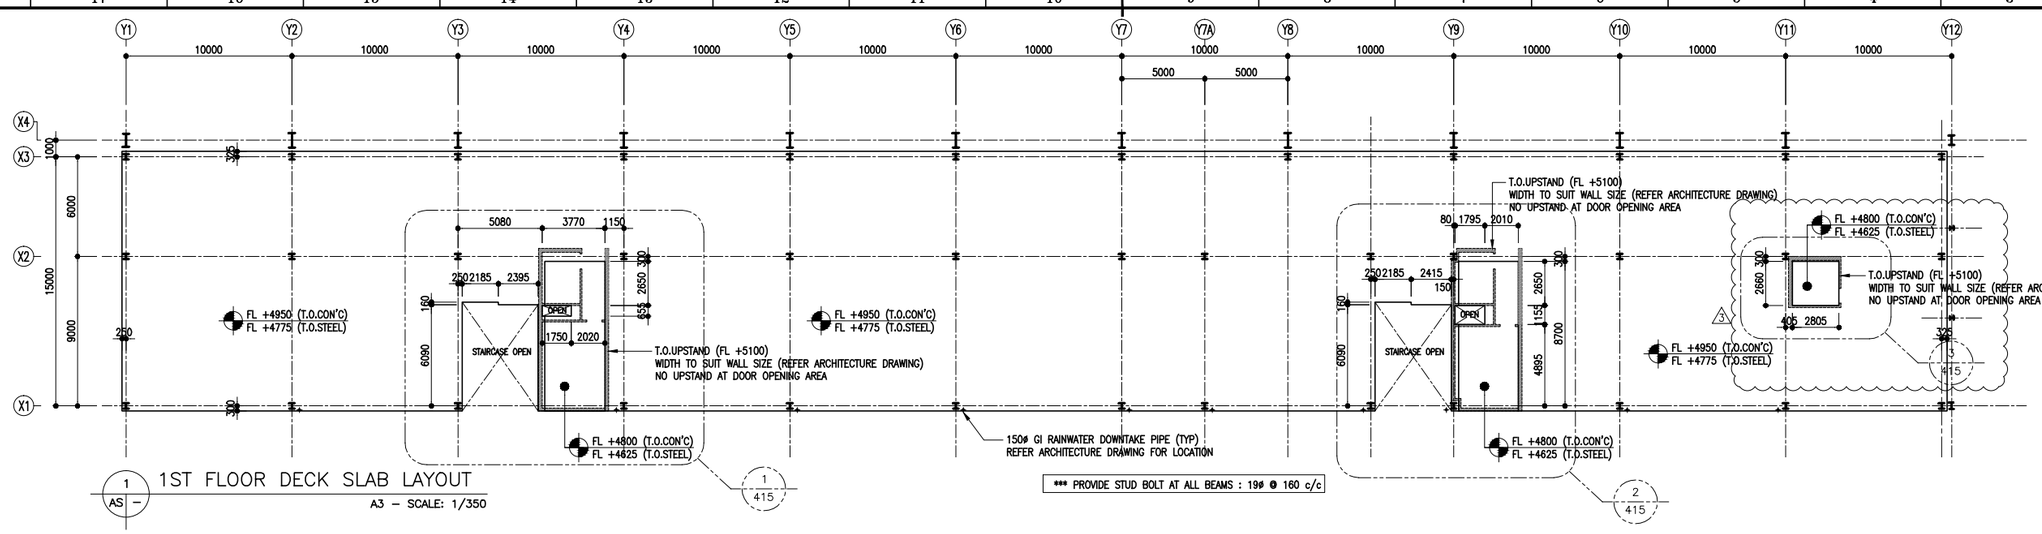


1 AS – 1ST FLOOR DECK SLAB LAYOUT

A3 – SCALE: 1/350

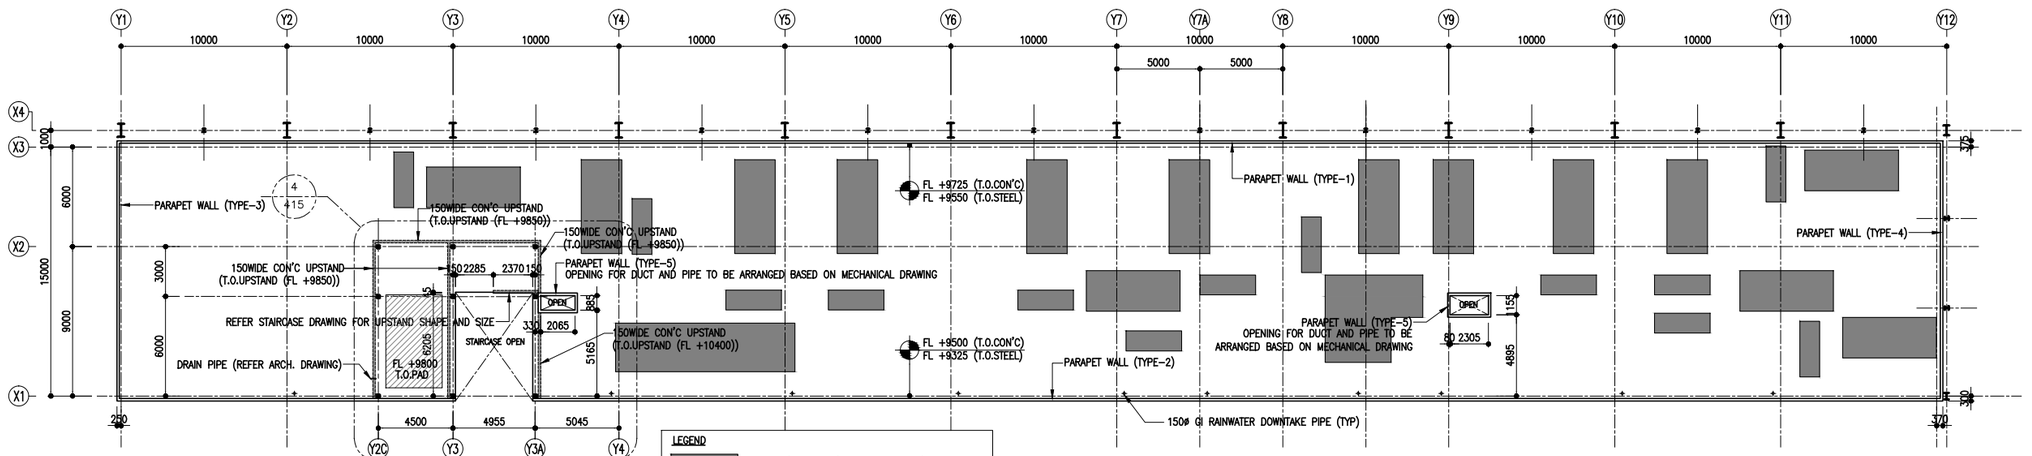

2 AS – OFFICE ROOF LEVEL DECK SLAB LAYOUT

A3 – SCALE: 1/350

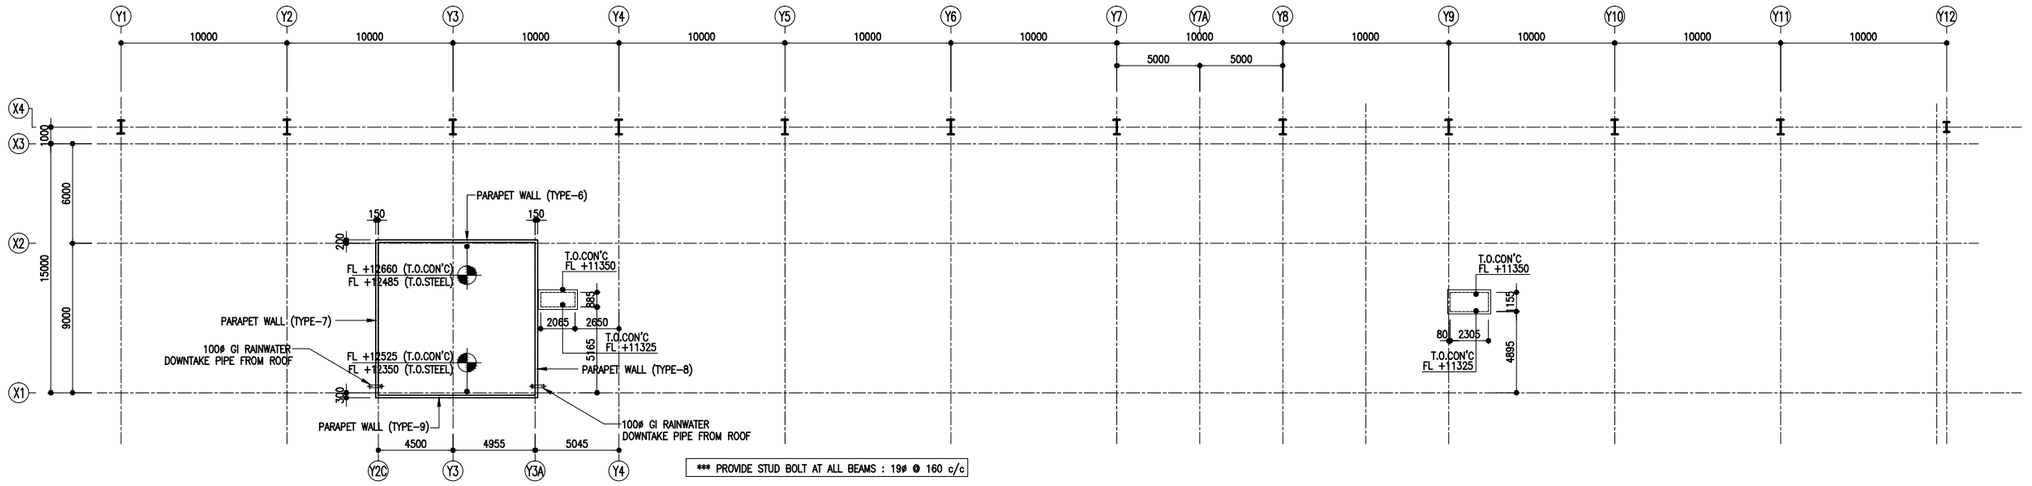

3 AS – STAIRCASE ROOF LEVEL DECK SLAB LAYOUT

A3 – SCALE: 1/350

*** TOILET / ELECTRICAL / MECHANICAL PIPE AND OTHER ITEMS PENETRATING DECK SLAB MUST BE COORDINATED



KEY PLAN

OFFICE LAYOUT REVISION AS PER CLIENT'S REQUEST FOR REFERENCE ONLY

REV.	CONTENTS	NAME	DATE
3	TOILET LOCATION CHANGED	ANBU	08.DEC.2015
2	ISSUED FOR CONSTRUCTION	ANBU	16.OCT.2015
1	ISSUED FOR TENDER	ANBU	05.AUG.2015
0	FOR CLIENT CONFIRMATION AND ROUGH ESTIMATION DRAWING	ANBU	18.JUL.2015

CLIENT

HYOSUNG T&D

HYOSUNG CORPORATION INDIA PVT. LTD.

ARCHITECTS & ENGINEERS

HTI ENGINEERING PVT. LTD.

91,44,2252,3743 www.mapgroup.co.kr

PROJECT TITLE


HYOSUNG PUNE PLANT

DRAWING TITLE

DECK SLAB LAYOUT


SCALE	DRAWN BY	DESIGNED BY	CHECKED BY	APPROVED BY
A3:1/350 A1:1/175	ANBU	H.G.KIM	-	-
DATE				
20.MAY.2015	20.MAY.2015	20.MAY.2015	–	–

DRAWING NO. HY–PU–FAC–AS–411 REV. 3

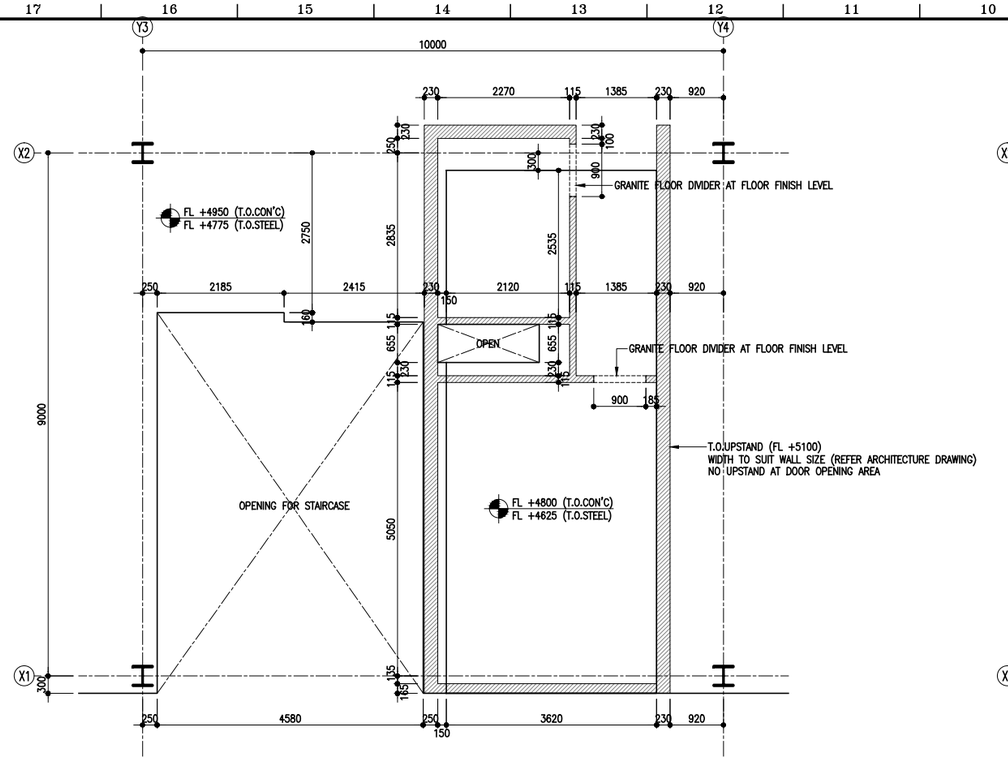


1 AS – 1ST FLOOR ENLARGED DECK SLAB LAYOUT

A3 – SCALE: 1/100

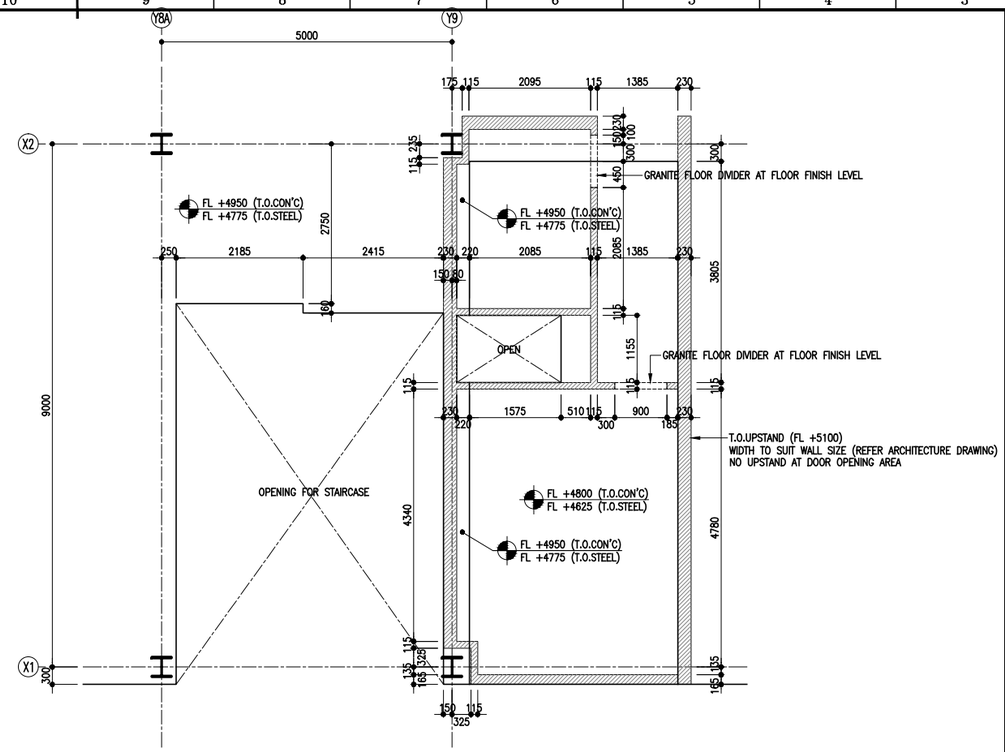


2 AS – 1ST FLOOR ENLARGED DECK SLAB LAYOUT

A3 – SCALE: 1/100

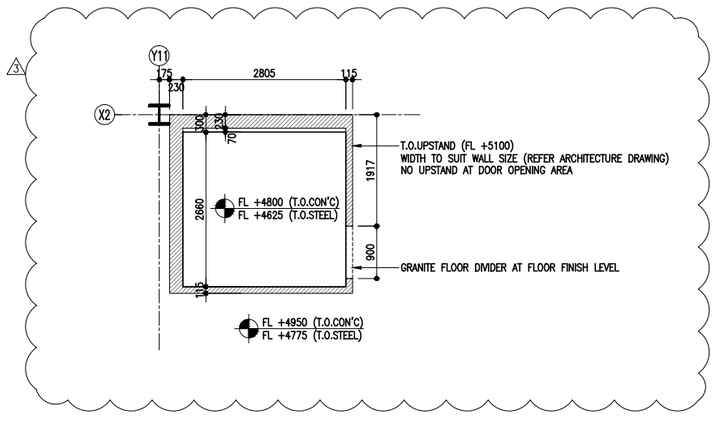

3 AS – 1ST FLOOR ENLARGED DECK SLAB LAYOUT

A3 – SCALE: 1/100

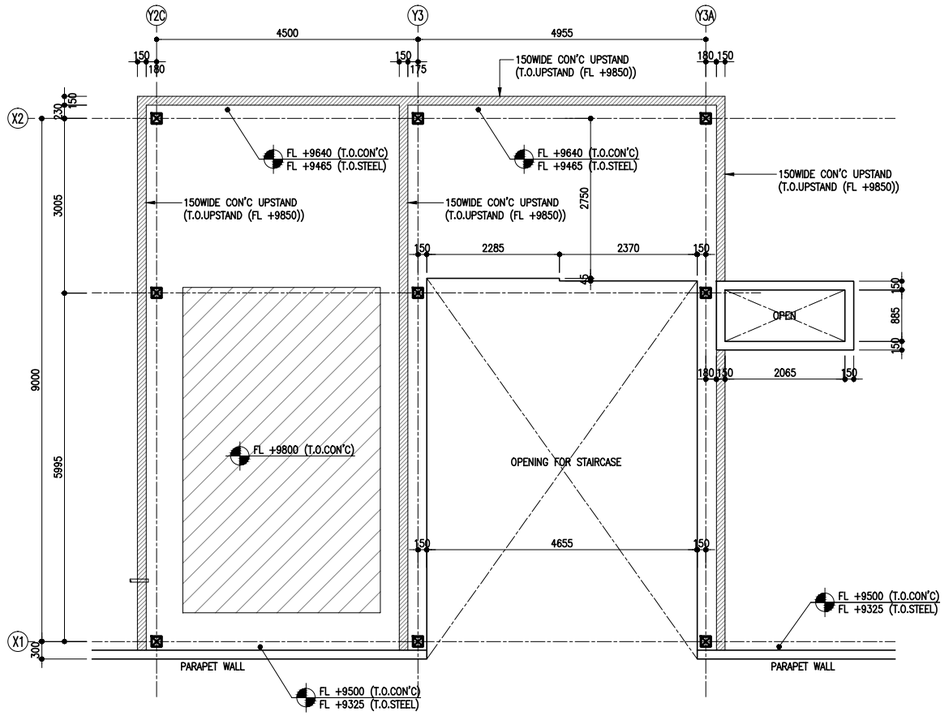

4 AS – ROOF LEVEL ENLARGED DECK SLAB LAYOUT

A3 – SCALE: 1/100

KEY PLAN

OFFICE LAYOUT REVISION AS PER CLIENT'S REQUEST FOR REFERENCE ONLY

REV.	CONTENTS	NAME	DATE
3	TOILET LOCATION CHANGED	ANBU	08.DEC.2015
2	ISSUED FOR CONSTRUCTION	ANBU	16.OCT.2015
1	ISSUED FOR TENDER	ANBU	05.AUG.2015
0	FOR CLIENT CONFIRMATION AND ROUGH ESTIMATION DRAWING	ANBU	18.JUL.2015

CLIENT

HYOSUNG T&D

HYOSUNG CORPORATION INDIA PVT. LTD.

ARCHITECTS & ENGINEERS

HTI ENGINEERING PVT. LTD.

91.44.2252.3743 www.mapgroup.co.kr

PROJECT TITLE


HYOSUNG PUNE PLANT


DRAWING TITLE

1ST FLOOR ENLARGED DECK SLAB LAYOUT

SCALE	DRAWN BY	DESIGNED BY	CHECKED BY	APPROVED BY
A3:1/50 A1:1/100	ANBU	H.G.KIM	-	-
DATE	20.MAY.2015	20.MAY.2015	–	–

DRAWING NO. HY–PU–FAC–AS–415 REV. 3

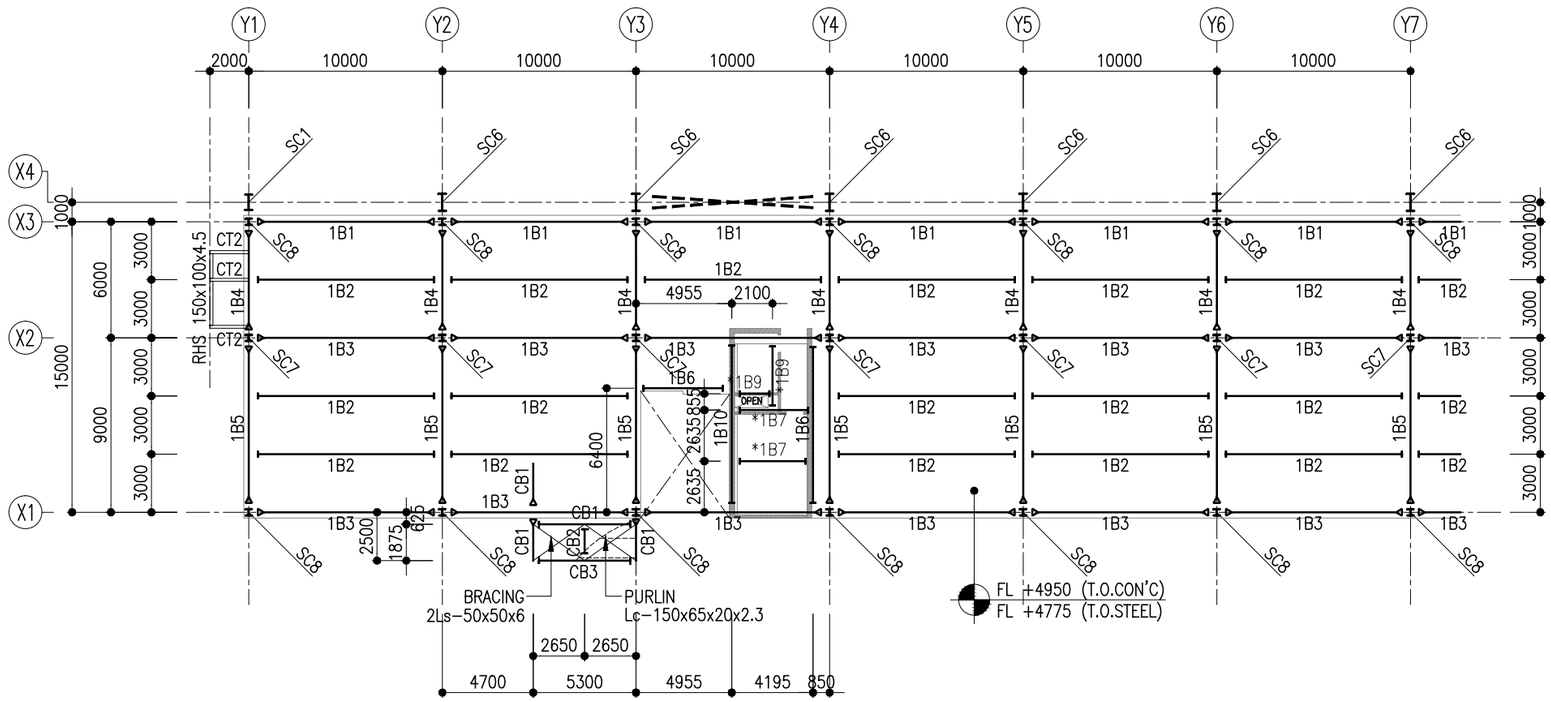

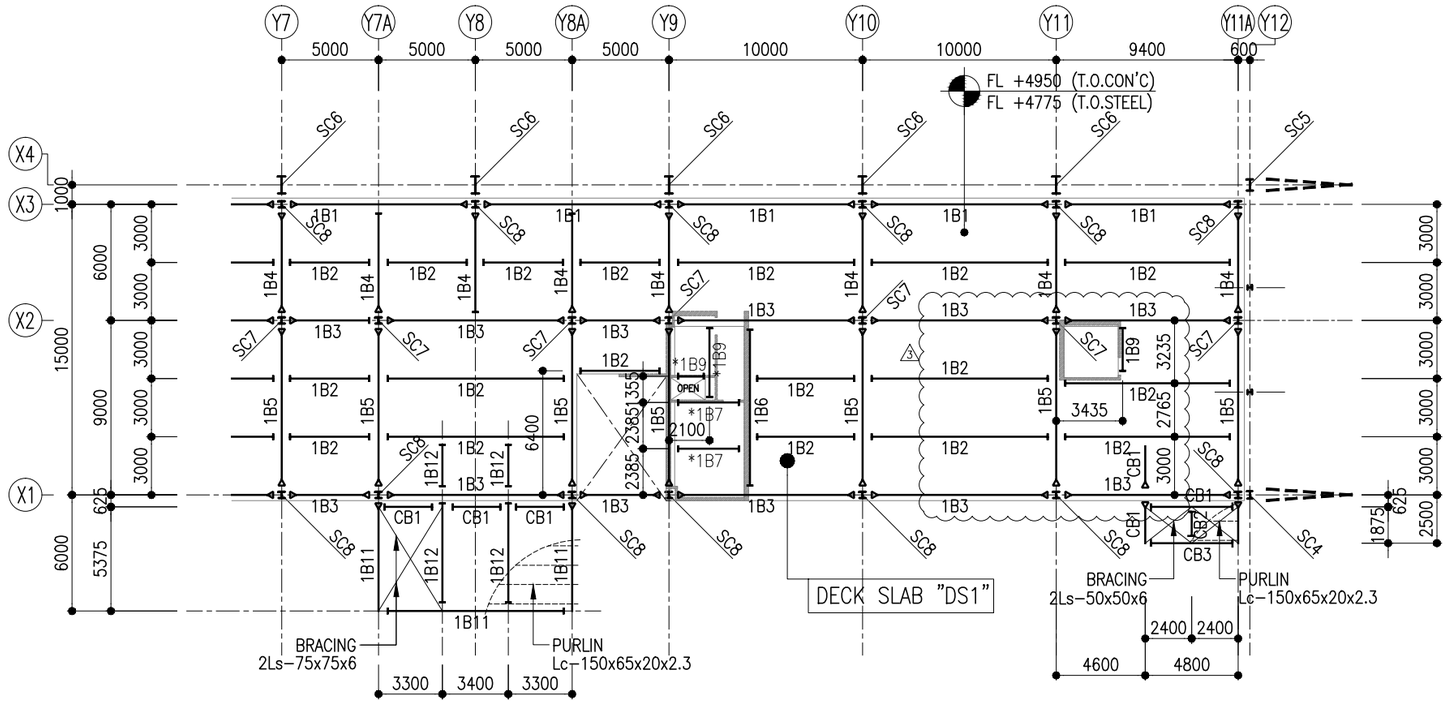

1 AS –

1ST FLOOR OFFICE STRUCTURE ENLARGED FRAMING PLAN

A3 – SCALE: 1/300

N

KEY PLAN

OFFICE LAYOUT REVISION AS PER CLIENT'S REQUEST FOR REFERENCE ONLY

REV.	CONTENTS	NAME	DATE
3	TOILET LOCATION CHANGED	ANBU	08.DEC 2015
2	ISSUED FOR CONSTRUCTION	ANBU	16.OCT 2015
1	ISSUED FOR TENDER	ANBU	05.AUG 2015
0	FOR CLIENT CONFIRMATION AND ROUGH ESTIMATION DRAWING	ANBU	18.JUL 2015

CLIENT

HYOSUNG T&D

HYOSUNG CORPORATION INDIA PVT. LTD.

ARCHITECTS & ENGINEERS

HTI ENGINEERING PVT. LTD.

91.44.2252.3743 www.mapgroup.co.kr

PROJECT TITLE

HYOSUNG PUNE PLANT

DRAWING TITLE

1ST FLOOR OFFICE STRUCTURE ENLARGED FRAMING PLAN

SCALE	DRAWN BY	DESIGNED BY	CHECKED BY	APPROVED BY
A3:1/150 A1:1/300	ANBU	H.G.KIM	-	-
DATE	20.MAY.2015	20.MAY.2015	–	–

DRAWING NO. HY–PU–FAC–AS–421 REV. 3