हिन्दुस्तान पेट्रोलियम HP

इंजीनियर्स इंडिया लिमिटेड (भारत सरकार का उपक्रम) ENGINEERS INDIA LIMITED (A Govt. of India Undertaking)

Residue Upgradation Facility (RUF)
EPCC-3 Package for
Visakh Refinery Modernization Project (VRMP)

L&T Hydrocarbon Engineering

L&T- CHIYODA LIMITED

Title: (504-LZ-930 A/B) GAD For Dock Leveler
Doc. No.: BO16-RUF-LT-504-MP-GN-NTPL(1)-13002
Rev. No.: 02
Page No: 1 of 4

OWNER : HINDUSTAN PETROLEUM CORPORATION LIMITED (HPCL)
PMC : ENGINEERS INDIA LIMITED, NEW DELHI (EIL)
UNIT : 504
PMC JOB NO. : B016
EQUIPMENT DESCRIPTION : DOCK LEVELER
EQUIPMENT TAG : 504-LZ-930A/B
P. R. NO. : BO16-RUF-LT-504-MP-PR-0014
VENDOR NAME : NIHVA TECHNOLOGIES PVT LTD
VENDOR DOCUMENT NO. : NIHVA_20-21_0157

<table>
<tr><th colspan="2">DOCUMENT SUBMISSION STATUS – LTHE/VENDOR</th><th colspan="6">REVIEW STATUS</th></tr>
<tr><th colspan="2"></th><th colspan="3">LTHE</th><th colspan="3">EIL</th></tr>
<tr><td colspan="2">DOC. CATEGORY: (USE TICK MARK)
☑ R ☐ I
ISSUED FOR
☐ INFORMATION
☑ REVIEW
☐ CONSTRUCTION
☐ AS BUILT</td><td colspan="3">☐ Code 1 – No Comments. Proceed With Manufacture / Fabrication / Construction As Per The Document.
☐ Code 2 – Proceed With Manufacture/Fabrication/Construction As Per Commented Document. Revised Document Required.
☐ Review Code 3 – Document Does Not Conform To Basic Requirements As Marked. Resubmit For Review
☐ Code R– Document Is Retained For Records. Proceed With Manufacture / Fabrication
☐ Code V- Void (Submission Required / Not Required)</td><td colspan="3">☐ Code 1 – No Comments. Proceed With Manufacture / Fabrication / Construction As Per The Document.
☐ Code 2 – Proceed With Manufacture/Fabrication/Construction As Per Commented Document. Revised Document Required.
☐ Review Code 3 – Document Does Not Conform To Basic Requirements As Marked. Resubmit For Review
☐ Code R– Document Is Retained For Records. Proceed With Manufacture / Fabrication
☐ Code V- Void (Submission Required / Not Required)</td></tr>
<tr><td colspan="2"></td><td>DISCIPLINE</td><td>SIGN</td><td>DATE</td><td>DISCIPLINE</td><td>SIGN</td><td>DATE</td></tr>
</table>

02	Issued for Approval	Shilpa	Amit K	Amit K			23/02/2022
01	Issued for Approval	Shilpa	Amit K	Amit K			24/09/2021
Revision No.	**Description**	**Prepared by**	**Reviewed by**	**Approved by**	**Reviewed by**	**Approved by**	**Approved Date**

REVISION HISTORY SHEET

REV. NO.	REV. DATE	REVISED PAGE	REVISION DESCRIPTION
01	24/09/2021	NA	ISSUED FOR APPROVAL
02	23/02/2022	NA	ISSUED FOR APPROVAL

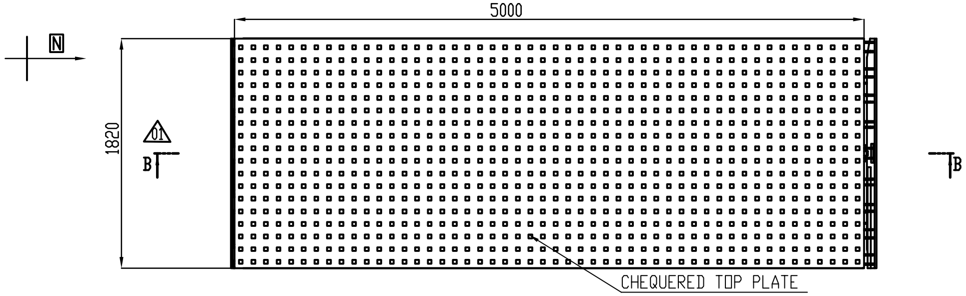

DOCK LEVELER TOP VIEW

BOM (For Single Dock Leveler) 02

SL NO.	DESCRIPTION	QTY
1	Dock Leveler(1820m x 5000mm)	1No
2	Lip (1820 x500mm)	1No
3	Deck Cylinder	2Nos
4	Lip Cylinder	1No
5	Power Pack(1HP,3Phase)	1No
6	Control Panel	1No

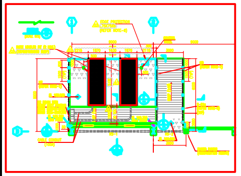

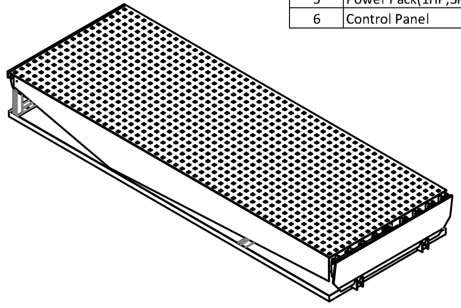

ISOMETRIC VIEW OF DOCK LEVELER

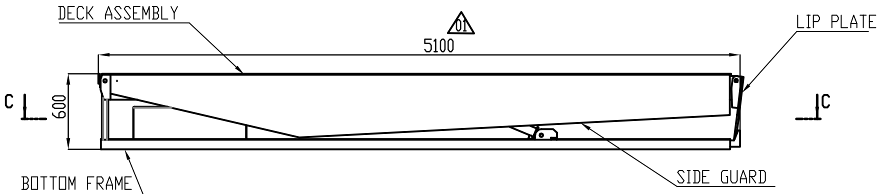

DOCK LEVELER SIDE VIEW

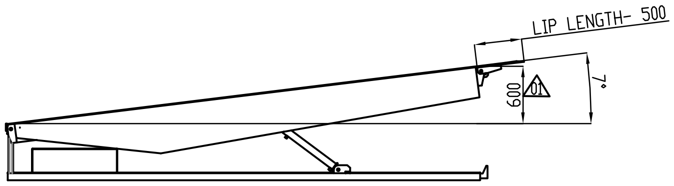

DECK UP HEIGHT - 600 MM

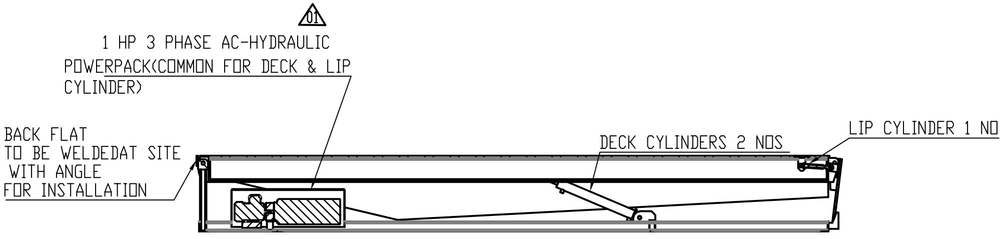

SECTION B-B
SCALE 1 : 15

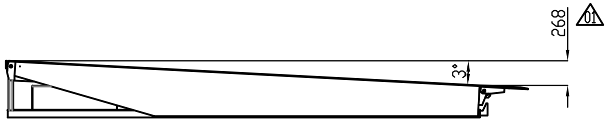

DECK DOWN HEIGHT - 268 MM 02

01

TECHNICAL SPECIFICATIONS OF PIT MOUNTED ELECRO-HYDRAULIC DOCK LEVELER -

1. SIZE OF DOCK LEVELER = 1820mm(W) X 5000mm(L)
2. OVERALL SIZE OF PRODUCT = 1820mm(W)X5100mm(L)X600mm(D)
3. CAPACITY = 6 TON POINT LOAD
4. LIP PLATE SIZE = 500mm(L)X1820mm(W)
5. DECK PLATE = CHEQUERED SHEET 1820mm(W)x5000mm(L)
6. DECK & LIP UP=DOWN OPERATION BY HYDRAULIC CYLINDER
7. DECK UP HEIGHT= (+)600 MM
8. DECK DOWN HEIGHT= (-)268MM 02
9. HEIGHT OF DOCK LEVELER FROM ROAD LEVEL= 900 mm,
10. OPERATION CONTROL BY PUSH BUTTONS ON CONTROL PANEL MOUNTED ON STAND NEAR DOCK LEVELER
11. ELECTRICAL SUPPLY OF EQUIPMENT= 415 VOLT 3 PHASE AC , 50HZ
12. PAINT = FIROZI BLUE
13. MATERIAL OF CONSTRUCTION = MILD STEEL AS PER IS STANDARD
14. MANUFACTURING STANDARD OF DOCK LEVELER =EN1398
15. ELECRICAL MOTOR COMPLIANCE ZONE 1-IIC-T3 HAZARDOUS AREA
16. PIT SIZE = 1870 mm(W)X5100mm(L)x600 mm(D)
17. DOCK LEVELER FIXING IN PIT BY ANCHOR BOLT .
18. REQUIRED PIT & ALL CIVIL WORK FOR MOUNTING OD DOCK LEVELER IS IN LTHE SCOPE .
REFER PIT DRAWING FOR CONSTRUCTION OF PIT B016-RUF-LT-504-MP-DW-NTPL(1)-13005
19. HYDRAULIC CYLINDERS & POWERPACK IS DESIGNED FOR LIFTING BARE DOCK ONLY.
20. MOTOR RATING=1HP 3 PHASE AC-HYDRAULIC
21. All ELECTRICAL EQUIPMENTS SHALL HAVE PAINT SHADE RAL 7031 02
22. ALL FLAME PROOF CONTROL PANEL 360X360X210MM 02

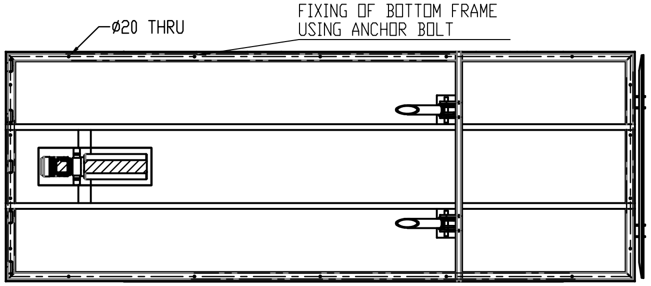

SECTION C-C
SCALE 1 : 15

L&T - CHIYODA LIMITED

☐ REVIEW CODE 1 - NO COMMENTS PROCEED WITH MANUFACTURE / FABRICATION/ CONSTRUCTION AS PER THE DOCUMENT.
☐ REVIEW CODE 2 - PROCEED WITH MANUFACTURE/ FABRICATION /CONSTRUCTION AS PER THE COMMENTED DOCUMENT. REVISED DOCUMENT REQUIRED.
☐ REVIEW CODE 3 - DOCUMENT DOES NOT CONFORM TO BASIC REQUIREMENTS AS MARKED. RESUBMIT FOR REVIEW.
☐ R - DOCUMENT IS RETAINED FOR RECORDS. PROCEED WITH MANUFACTURE / FABRICATION
☐ V-VOID

COMMENTED BY	REVIEWED BY	APPROVED BY	DATE

THIS REVIEW / APPROVAL DOES NOT RELIEVE THE VENDOR / MANUFACTURER OF THE FULL RESPONSIBILITY AS TO DESIGN CORRECTNESS OF DIMENSIONS & COMPLIANCE WITHALL APPLICABLE REGULATIONS AND WITH THE REQUIREMENTS MADE IN PURCHASER SPECIFICATIONS.

DRAWING NO.	DRAWING TITLE	REV
504-LZ-930A/B	CIVIL DRAWING OF DOCK LEVELER 01	01

REFERENCE DOCUMENTS / DRAWINGS

DRG. CATEGORY: (USE TICK MARK) R I
SCH. DATE OF SUBMISSION
EIL REVIEW/APPROVAL CODE:
VPTL NO.:

DOCUMENT STATUS
STATEMENT OF SUB: 1st 2nd 3rd
☐ FINAL FOR CODE-1 ☑ AS BUILT

ISSUED FOR
☐ AS BUILT ☐ INFORMATION
☐ CONSTRUCTION ☐ REVIEW

SIGN: DATE:

☐ REVIEW CODE 1 - NO COMMENTS PROCEED WITH MANUFACTURE / FABRICATION/ CONSTRUCTION AS PER THE DOCUMENT.
☐ REVIEW CODE 2 - PROCEED WITH MANUFACTURE / FABRICATION / CONSTRUCTION AS PER THE COMMENTED DOCUMENT. REVISED DOCUMENT REQUIRED
☐ REVIEW CODE 3 - DOCUMENT DOES NOT CONFORM TO BASIC REQUIREMENTS AS MARKED. RESUBMIT FOR REVIEW.
☐ R - DOCUMENT IS RETAINED FOR RECORDS. PROCEED WITH MANUFACTURE / FABRICATION
☐ V-VOID
NAME DICIPLINE SIGN. DATE

REV.	DESCRIPTION	DRN	CHECKED	APPROVED	REVIEWED	APPROVED	DATE
01	ISSUED FOR APPROVAL	SMS	VJ	AK			

OWNER HINDUSTAN PETROLEUM CORPORATION LIMITED
VISAKH REFINERY MODERNIZATION PROJECT
EPCC-03 PACKAGE FOR RESIDUE UP-GRADATION FACILITY (RUF)

PMC : इंजीनियर्स इंडिया लिमिटेड ENGINEERS INDIA LIMITED
(A Govt. of India Undertaking)

LSTK CONTRACTOR: L&T Hydrocarbon Engineering

DETAILED ENGINEERING CENTER: L&T - CHIYODA LIMITED

VENDOR : NIHVA TECHNOLOGIES PVT LTD
VENDOR PO NO: REFINARY/75000-82256/VMM
VENDOR DWG. NO: NIHVA_20-21_0157

DATE 31.05.21
SCALE 1:1
TITLE: 504-LZ-930A/B GAD FOR DOCK LEVELER 01
DEPT: DESIGN
DRN BY: SMS
CHK BY: VJ
APP BY: AK
PROJECT: L&T-RUF
PWO NO.:
DRG. NO.:
SH.3 OF4
REV. 02
CAD FILE:

DATA SHEET FOR DOCK LEVELER (504-LZ-930A/B)

Sr No	Parameter	Remark
1	Required Capacity	06 Ton
2	Leveler operation mode	AC power pack hydraulically operated
3	Lip operation mode	hydraulic
4	Operation control	by push buttons and control panel
5	Height of dock leveler from road Level	900 mm
6	Travel above & below dock level	600 mm & 268 mm
7	Platform Size (W x L)	1820 mm x 5000 mm
8	Lip size (W x L)	1820 mm x 500 mm
9	Maximum slope can be achieved	7 Degree
10	Minimum slope can be achieved	3 Degree

* Please refer Attachment-1 for standard catalog of Dock Leveler.