
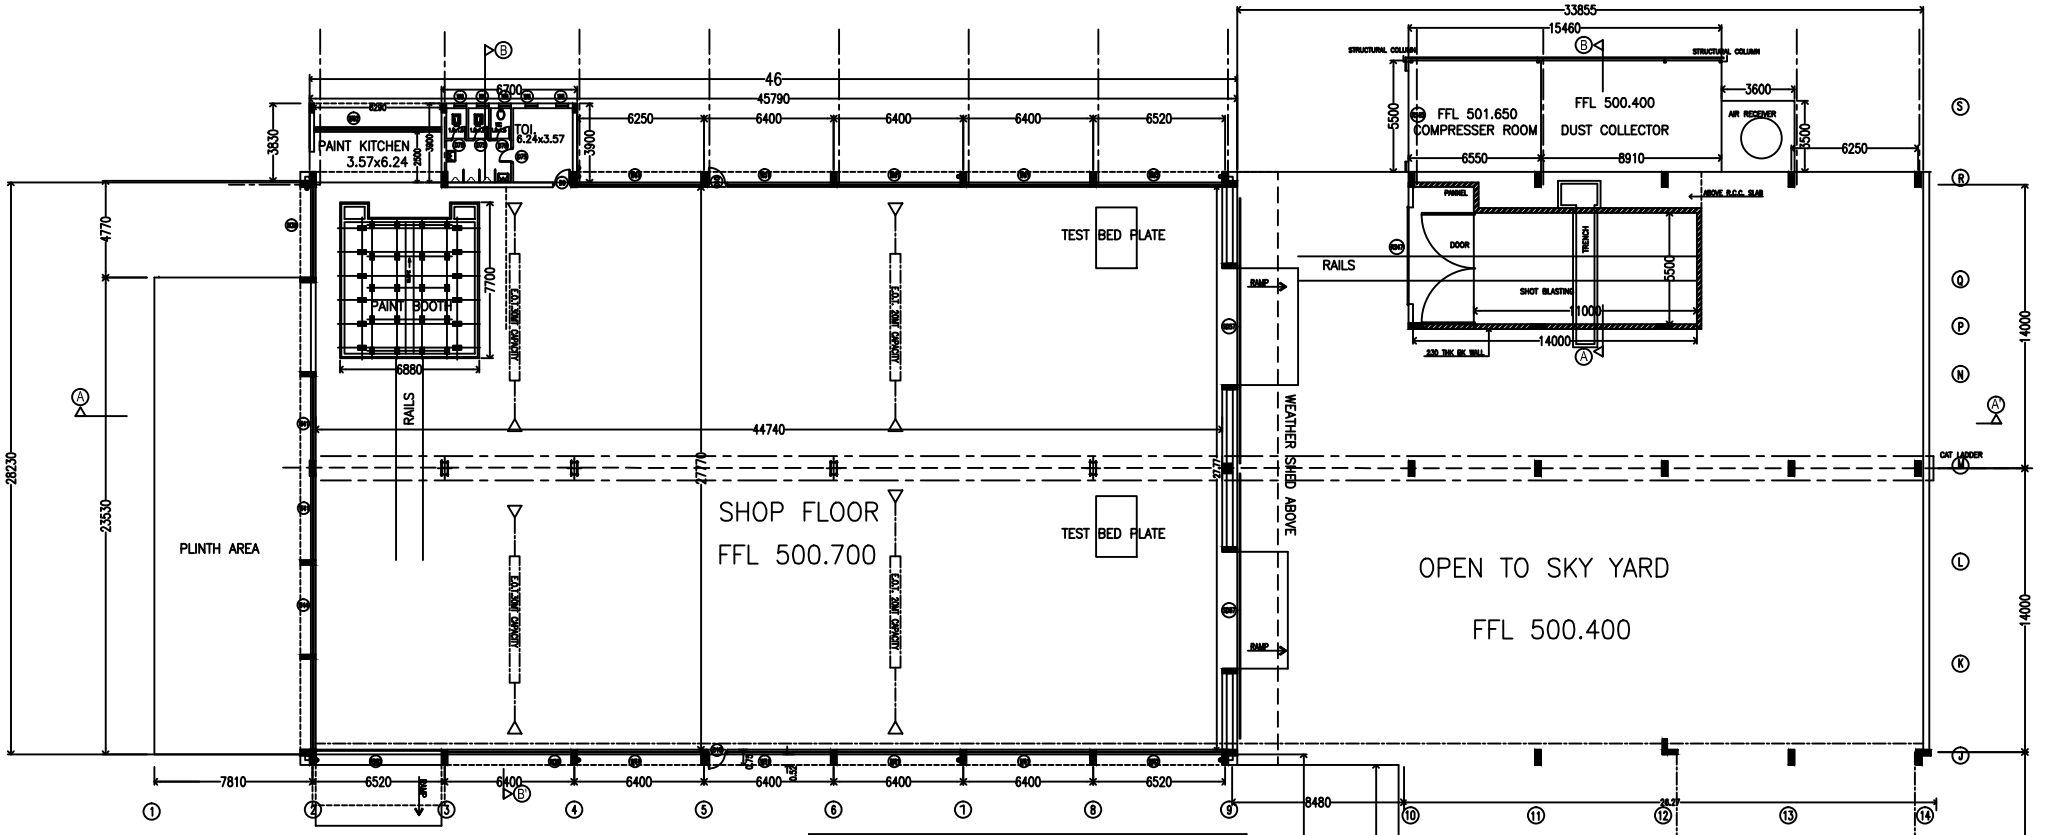


GROUND FLOOR PLAN

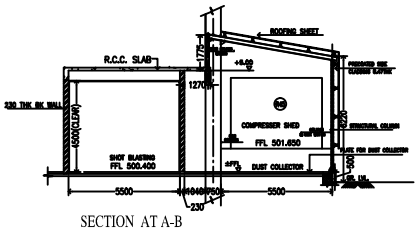

SECTION AT A-B

ARCHITISTA ENGG. PROJECTS PVT. LTD.
AS BUILT DRAWING

SCHEDULE OF DOORS AND WINDOWS					
DOORS:		WINDOWS:		VENTILATORS:	
TYPE	SIZE	TYPE	SIZE	TYPE	SIZE
SD57	5770 x 5000	W62	6290 x 1350	V61	6100 x 750
RS62	6220 x 5000	W62	6220 x 1350	V44	4470 x 750
D20	2000 x 2600	W61	6100 x 1350	V44	4420x 750
D10	1000 x 2600	W51	5100 x 1350	V41	4160 x 750
D9	900 x 2150	W44	4420 x 1350		
D75	750 x 2150	W41	4160 x 1350		
		W39	3950 x 1350		
		W36	3650 x 1350		
		W41	4160 x 1600		
		W41	4160 x 1350		
		W29	2980 x 1600		
		W29	2980 x 1350		
		*—	EMERGENCY EXIT		