



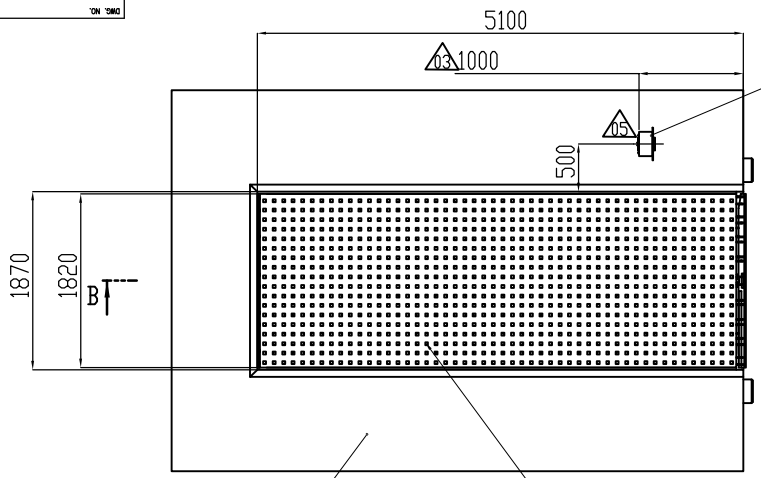


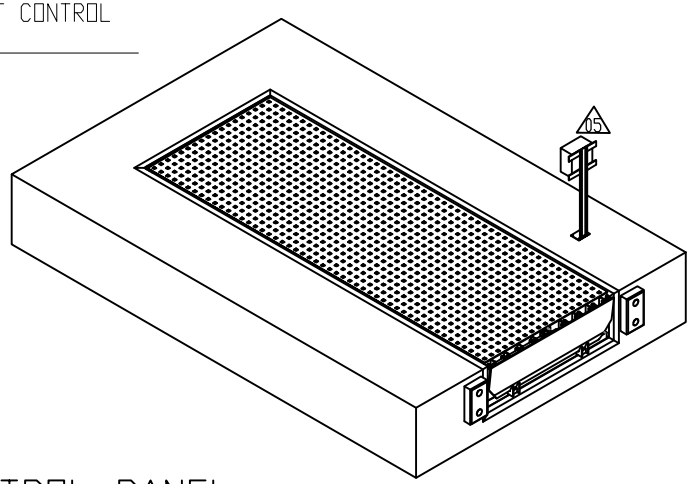


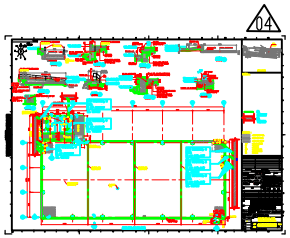


CONTROL PANEL

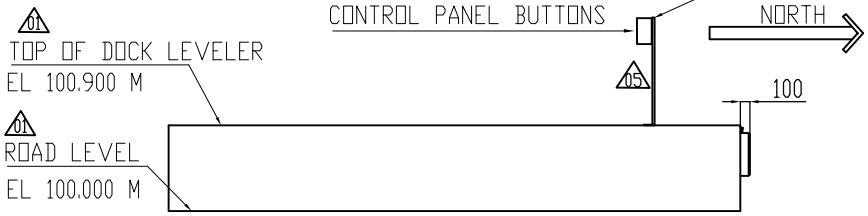

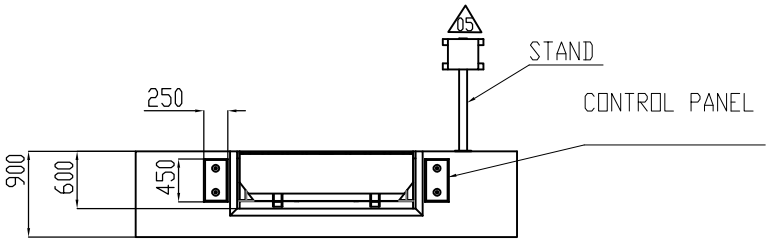

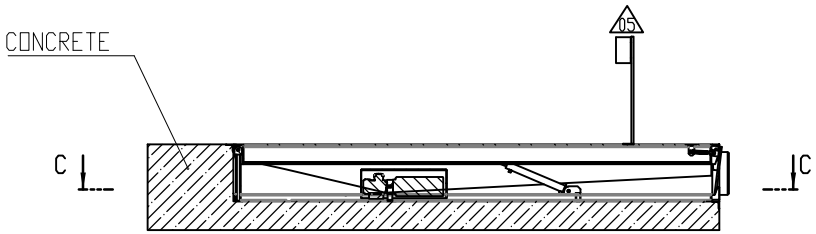


SECTION B-B
SCALE 1 : 28

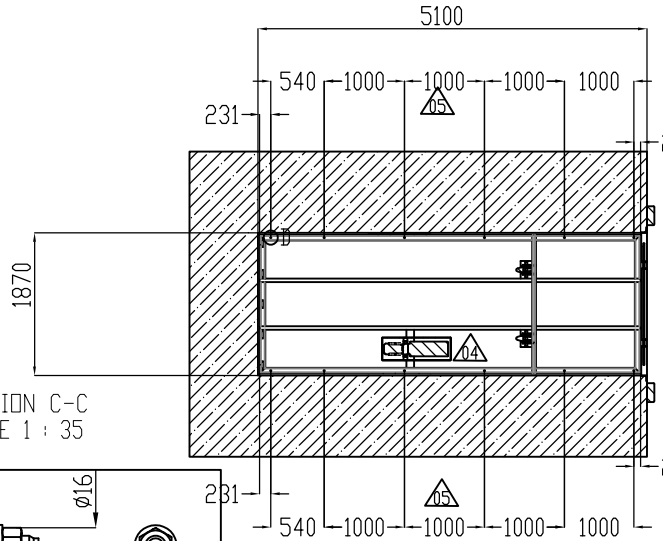

SECTION C-C
SCALE 1 : 35

PRODUCT DESCRIPTION -

1. DOCK LEVELER - PIT MOUNTED ELECTRO-HYDRAULIC TYPE
2. CAPACITY- 6 TON POINT LOAD
3. QTY- 2 NOS
4. PRODUCT SIZE- 5100mm(L)X1820mm(W)X600mm(D)
5. PIT SIZE-5100mm(L)X1870mm(W)X600mm(D)

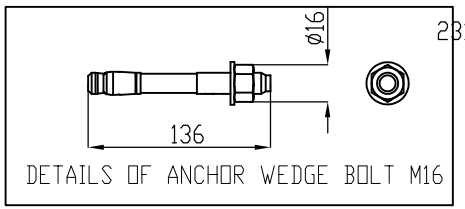

DETAILS OF ANCHOR WEDGE BOLT M16

Ø18 HOLE

DETAIL D
SCALE 1 : 35

504-LZ-930A/B	GAD OF DOCK LEVELER	01
DRAWING NO.	DRAWING TITLE	REV

REFERENCE DOCUMENTS / DRAWINGS

DRG. CATEGORY: (USE TICK MARK) R
EIL REVIEW/APPROVAL CODE:
VPTL NO.:
SCH. DATE OF SUBMISSION

DOCUMENT STATUS
STATEMENT OF SUB: 1st 2nd 3rd
FINAL FOR CODE-1 AS BUILT
ISSUED FOR
AS BUILT CONSTRUCTION INFORMATION REVIEW

REVIEW CODE 1 – NO COMMENTS PROCEED WITH MANUFACTURE / FABRICATION/ CONSTRUCTION AS PER THE DOCUMENT.
REVIEW CODE 2 – PROCEED WITH MANUFACTURE / FABRICATION / CONSTRUCTION AS PER THE COMMENTED DOCUMENT. REVISED DOCUMENT REQUIRED.
REVIEW CODE 3 – DOCUMENT DOES NOT CONFORM TO BASIC REQUIREMENTS AS MARKED. RESUBMIT FOR REVIEW.
R – DOCUMENT IS RETAINED FOR RECORDS. PROCEED WITH MANUFACTURE / FABRICATION
V-VOID

SIGN: DATE:

NAME DISCIPLINE SIGN. DATE

REV.	DESCRIPTION	DRN	CHECKED	APPROVED	REVIEWED	APPROVED	DATE
01	ISSUED FOR APPROVAL	SMS	VJ	AK			

OWNER: HINDUSTAN PETROLEUM CORPORATION LIMITED
VISAKH REFINERY MODERNIZATION PROJECT
EPCC-03 PACKAGE FOR RESIDUE UP-GRADATION FACILITY (RUF)

PMC: ENGINEERS INDIA LIMITED (A Govt. of India Undertaking)

LSTK CONTRACTOR: L&T Hydrocarbon Engineering

DETAILED ENGINEERING CENTER: L&T - CHIYODA LIMITED

L&T - CHIYODA LIMITED

REVIEW CODE 1 – NO COMMENTS PROCEED WITH MANUFACTURE / FABRICATION/ CONSTRUCTION AS PER THE DOCUMENT.
REVIEW CODE 2 – PROCEED WITH MANUFACTURE/ FABRICATION /CONSTRUCTION AS PER THE COMMENTED DOCUMENT. REVISED DOCUMENT REQUIRED.
REVIEW CODE 3 – DOCUMENT DOES NOT CONFORM TO BASIC REQUIREMENTS AS MARKED. RESUBMIT FOR REVIEW.
R – DOCUMENT IS RETAINED FOR RECORDS. PROCEED WITH MANUFACTURE / FABRICATION
V-VOID

COMMENTED BY	REVIEWED BY	APPROVED BY	DATE

THIS REVIEW / APPROVAL DOES NOT RELIEVE THE VENDOR / MANUFACTURER OF THE FULL RESPONSIBILITY AS TO DESIGN CORRECTNESS OF DIMENSIONS & COMPLIANCE WITHALL APPLICABLE REGULATIONS AND WITH THE REQUIREMENTS MADE IN PURCHASER SPECIFICATIONS.


VENDOR: NIHVA TECHNOLOGIES PVT LTD
VENDOR PO NO: REFINARY/75000-82256/VMM
VENDOR DWG. NO: NIHVA_20-21_0158

DATE: 31.05.21 SCALE: 1:6
DEPT: DESIGN
DRN BY: SMS
CHK BY: VJ
APP BY: AK

TITLE: CIVIL DRAWING FOR DOCK LEVELER (504-LZ-930A/B)
PROJECT: LAT-RUF
DRG. NO.: 2016-RUF-LT-504-HP-DV-MTPL-CD-12005
PWO NO.:
SH. 2 OF 4
REV. 05

CAD FILE:


ALL RIGHTS RESERVED
THE DOCUMENT AND ANY DATA AND INFORMATION CONTAINED THEREIN ARE CONFIDENTIAL AND THE PROPERTY OF L&T HYDROCARBON ENGINEERING LTD. ("LHE") AND THE COPYRIGHT THEREIN IS VESTED IN LHE. NO PART OF THIS DOCUMENT, DATA, OR INFORMATION SHALL BE DISCLOSED TO OTHERS OR REPRODUCED IN ANY MANNER OR USED FOR ANY PURPOSE WHATSOEVER, EXCEPT WITH THE PRIOR WRITTEN PERMISSION OF LHE.

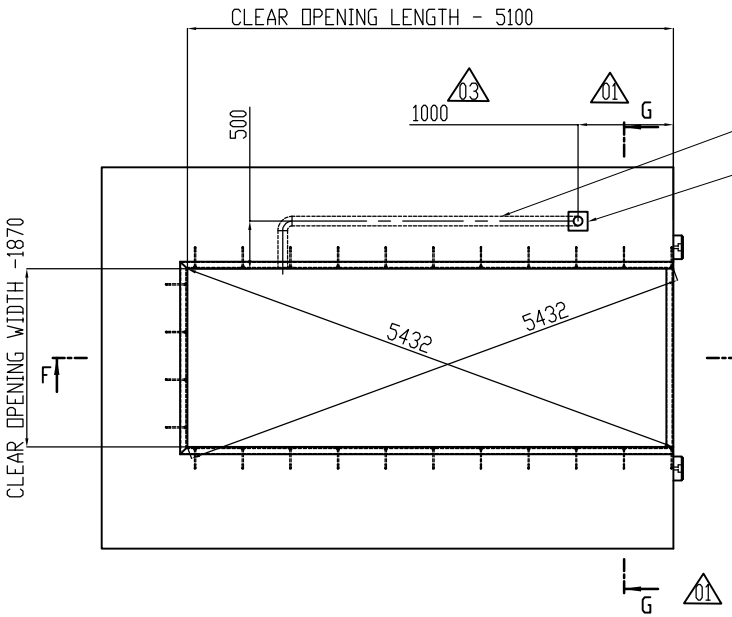


MIN. 4 INCH DUCT FROM CONTROL PANEL TO PIT OPENING (DUCT IS IN LTHE SCOPE)


RECOMMENDED POSITION OF CONTROL PANEL FOR EASY VIEW OF LIP PLATE DURING OPERATION BY OPERATOR

TOP VIEW OF DOCK PIT

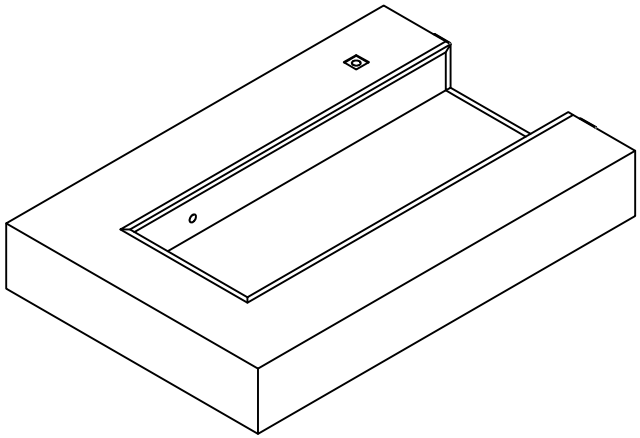


ISOMETRIC VIEW OF DOCK LEVELER PIT

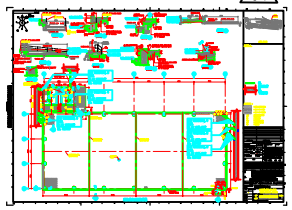


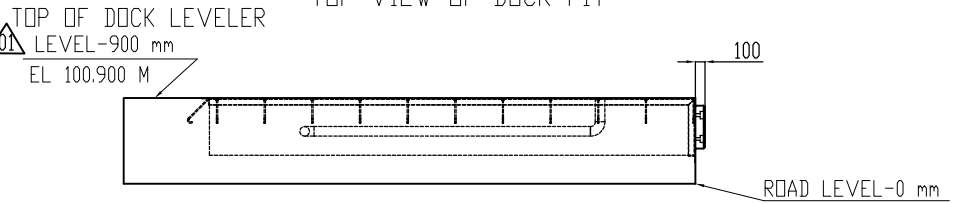


FRONT VIEW OF DOCK PIT

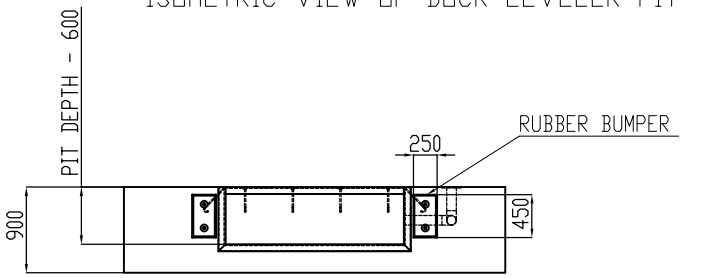

SIDE VIEW OF DOCK PIT

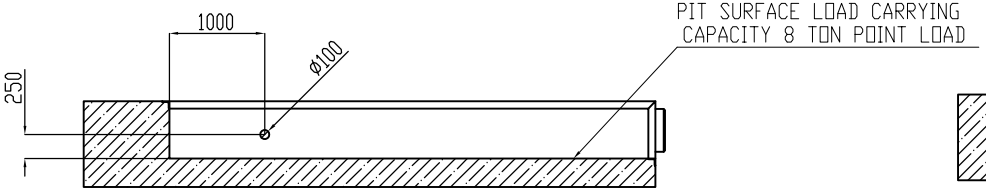


SECTION F-F
SCALE 1 : 28

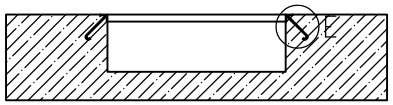

SECTION G-G 01
SCALE 1 : 28

L ANGLE 75X6 MM THK ANCHORED IN CONCRETE (ANGLE IS IN LTHE SCOPE) 01

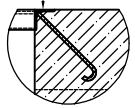

DETAIL E
SCALE 1 : 10

NOTES - 01

1. PIT & ALL CIVIL WORK IS IN LTHE SCOPE .
2. AT ALL EDGES OF PIT ANGLE 75X6 MM THK(ANGLE IN LTHE SCOPE) TO BE ANCHORED IN CONCRETE .
3. PIT SURFACE SHOULD BE PLAIN & LOAD CARRYING CAPACITY FOR PIT SURFACE SHOULB OF 8 TON POINT LOAD .
4. MINIMUM 4 INCH DUCT TO BE PROVIDED FROM CONTROL PANEL TO PIT OPENING BY LTHE FOR ELECTRICAL CABLE ROUTING . REQUIRED DUCT IS IN LTHE SCOPE.
5. CONTROL PANEL IS PROVIDED WITH ELECTRICAL CABLE. CONTROL PANEL SHOULD BE LOCATED NEAR DOCK LEVELER FOR EASY VIEW OF LIP RESTING ON VEHICLE .

THE DOCUMENT AND ANY DATA AND APPENDICES THERETO ARE CONFIDENTIAL AND THE PROPERTY OF L&T HYDROCARBON ENGINEERING (LTHE) AND THE COPYRIGHT THEREIN IS VESTED IN LTHE. NO PART OF THIS DOCUMENT, DATA, OR INFORMATION SHALL BE DISCLOSED TO OTHERS OR REPRODUCED IN ANY MANNER OR USED FOR ANY PURPOSE WHATSOEVER, EXCEPT WITH THE PRIOR WRITTEN PERMISSION OF LTHE.
ALL RIGHTS RESERVED

504-LZ-930A/B	GAD OF DOCK LEVELER 01	01
DRAWING NO.	DRAWING TITLE	REV

REFERENCE DOCUMENTS / DRAWINGS

DRG. CATEGORY: (USE TICK MARK) [R] [I]
EIL REVIEW/APPROVAL CODE:
VPTL NO.:
SCH. DATE OF SUBMISSION

DOCUMENT STATUS
STATEMENT OF SUB: [1st] [2nd] [3rd]
☐ FINAL FOR CODE-1 ☐ AS BUILT

ISSUED FOR
☐ AS BUILT ☐ INFORMATION
☐ CONSTRUCTION ☐ REVIEW

SIGN: DATE:

☐ REVIEW CODE 1 – NO COMMENTS PROCEED WITH MANUFACTURE / FABRICATION/ CONSTRUCTION AS PER THE DOCUMENT.
☐ REVIEW CODE 2 – PROCEED WITH MANUFACTURE / FABRICATION / CONSTRUCTION AS PER THE COMMENTED DOCUMENT. REVISED DOCUMENT REQUIRED.
☐ REVIEW CODE 3 – DOCUMENT DOES NOT CONFORM TO BASIC REQUIREMENTS AS MARKED. RESUBMIT FOR REVIEW.
☐ R – DOCUMENT IS RETAINED FOR RECORDS. PROCEED WITH MANUFACTURE / FABRICATION
☐ V-VOID

	NAME	DISCIPLINE	SIGN.	DATE

REV.	DESCRIPTION	DRN	CHECKED	APPROVED	REVIEWED	APPROVED	DATE
01	ISSUED FOR APPROVAL	SMS	VJ		AK		

OWNER: HINDUSTAN PETROLEUM CORPORATION LIMITED
VISAKH REFINERY MODERNIZATION PROJECT
EPCC-03 PACKAGE FOR RESIDUE UP-GRADATION FACILITY (RUF)

PMC : ENGINEERS INDIA LIMITED (A Govt. of India Undertaking)

LSTK CONTRACTOR: L&T Hydrocarbon Engineering

DETAILED ENGINEERING CENTER: L&T - CHIYODA LIMITED

L&T - CHIYODA LIMITED

☐ REVIEW CODE 1 – NO COMMENTS PROCEED WITH MANUFACTURE / FABRICATION/ CONSTRUCTION AS PER THE DOCUMENT.
☐ REVIEW CODE 2 – PROCEED WITH MANUFACTURE/ FABRICATION /CONSTRUCTION AS PER THE COMMENTED DOCUMENT. REVISED DOCUMENT REQUIRED.
☐ REVIEW CODE 3 – DOCUMENT DOES NOT CONFORM TO BASIC REQUIREMENTS AS MARKED. RESUBMIT FOR REVIEW.
☐ R – DOCUMENT IS RETAINED FOR RECORDS. PROCEED WITH MANUFACTURE / FABRICATION
☐ V-VOID

COMMENTED BY	REVIEWED BY	APPROVED BY	DATE

THIS REVIEW / APPROVAL DOES NOT RELIEVE THE VENDOR / MANUFACTURER OF THE FULL RESPONSIBILITY AS TO DESIGN CORRECTNESS OF DIMENSIONS & COMPLIANCE WITHALL APPLICABLE REGULATIONS AND WITH THE REQUIREMENTS MADE IN PURCHASER SPECIFICATIONS.

VENDOR : NDHVA TECHNOLOGIES PVT LTD
VENDOR PO NO: REFINARY/75000-82256/VMM
VENDOR DWG. NO: NDHVA_E0-21_0158

DATE: 29.5.21 | SCALE: 1:6

TITLE: CIVIL DRAWING FOR DOCK LEVELER (504-LZ-930A/B) 01

DEPT: DESIGN
DRN BY: SMS
CHK BY: VJ
APP BY: AK

PROJECT: L&T-RUF
PWO NO.:
DRG. NO.: 3986-RUF-LT-504-MP-DW-MTPLCD-13605
SH. 4 OF 4
REV. 05

CAD FILE: