हिन्दुस्तान पेट्रोलियम HP इंजीनियर्स इंडिया लिमिटेड ENGINEERS INDIA LIMITED (A Govt. of India Undertaking)	**Residue Upgradation Facility (RUF)** **EPCC-3 Package for** **Visakh Refinery Modernization Project (VRMP)**	L&T Hydrocarbon Engineering **L&T- CHIYODA LIMITED**
Title: (504-LZ-930A/B) CIVIL DRAWING FOR DOCK LEVELER **Doc. No.: BO16-RUF-LT-504-MP-DW-NTPL(1)-13005**		**Rev. No.: 02** **Page No: 1 of 4**

OWNER	:	**HINDUSTAN PETROLEUM CORPORATION LIMITED (HPCL)**
PMC	:	**ENGINEERS INDIA LIMITED, NEW DELHI (EIL)**
UNIT	:	**504**
PMC JOB NO.	:	**B016**
EQUIPMENT DESCRIPTION	:	**DOCK LEVELER**
EQUIPMENT TAG	:	**504-LZ-930A/B**
P. R. NO.	:	**BO16-RUF-LT-504-MP-PR-0014**
VENDOR NAME	:	**NIHVA TECHNOLOGIES PVT LTD**
VENDOR DOCUMENT NO.	:	**NIHVA_20-21_0158**

DOCUMENT SUBMISSION STATUS – LTHE/VENDOR	**REVIEW STATUS**	
	LTHE	**EIL**
DOC. CATEGORY: (USE TICK MARK) ☑ R ☐ I	☐ Code 1 – No Comments. Proceed With Manufacture / Fabrication / Construction As Per The Document. ☐ Code 2 – Proceed With Manufacture/Fabrication/Construction As Per Commented Document. Revised Document Required. ☐ Review Code 3 – Document Does Not Conform To Basic Requirements As Marked. Resubmit For Review ☐ Code R– Document Is Retained For Records. Proceed With Manufacture / Fabrication ☐ Code V- Void (Submission Required / Not Required)	☐ Code 1 – No Comments. Proceed With Manufacture / Fabrication / Construction As Per The Document. ☐ Code 2 – Proceed With Manufacture/Fabrication/Construction As Per Commented Document. Revised Document Required. ☐ Review Code 3 – Document Does Not Conform To Basic Requirements As Marked. Resubmit For Review ☐ Code R– Document Is Retained For Records. Proceed With Manufacture / Fabrication ☐ Code V- Void (Submission Required / Not Required)
ISSUED FOR ☐ INFORMATION ☑ REVIEW ☐ CONSTRUCTION ☐ AS BUILT	DISCIPLINE / SIGN / DAT	DISCIPLINE / SIGN / DATE

Revision No.	Description	Prepared by	Reviewed by	Approved by	Reviewed by	Approved by	Approved Date
02	Issued for Approval	Shilpa	Amit.K	Amit.K			03/03/2022
01	Issued for Approval	Shilpa	Amit.K	Amit.K			24/09/2022

ALL RIGHTS RESERVED


THIS DOCUMENT AND ANY DATA AND INFORMATION CONTAINED THEREIN ARE CONFIDENTIAL AND THE PROPERTY OF L&T HYDROCARBON ENGINEERING (LTHE) AND THE COPYRIGHT THEREIN IS VESTED IN LTHE NO PART OF THIS DOCUMENT, DATA, OR INFORMATION SHALL BE DISCLOSED TO OTHERS OR REPRODUCED IN ANY MANNER OR USED FOR ANY PURPOSE WHATSOEVER, EXCEPT WITH THE PRIOR WRITTEN PERMISSION OF LTHE.


REVISION HISTORY SHEET


REV. NO.	REV. DATE	REVISED PAGE	REVISION DESCRIPTION
01	24/09/2021	NA	ISSUED FOR APPROVAL
01	03/03/2022	NA	ISSUED FOR APPROVAL


ALL RIGHTS RESERVED

THIS DOCUMENT AND ANY DATA AND INFORMATION CONTAINED THEREIN ARE CONFIDENTIAL AND THE PROPERTY OF L&T HYDROCARBON ENGINEERING (LTHE) AND THE COPYRIGHT THEREIN IS VESTED IN LTHE NO PART OF THIS DOCUMENT, DATA, OR INFORMATION SHALL BE DISCLOSED TO OTHERS OR REPRODUCED IN ANY MANNER OR USED FOR ANY PURPOSE WHATSOEVER, EXCEPT WITH THE PRIOR WRITTEN PERMISSION OF LTHE.

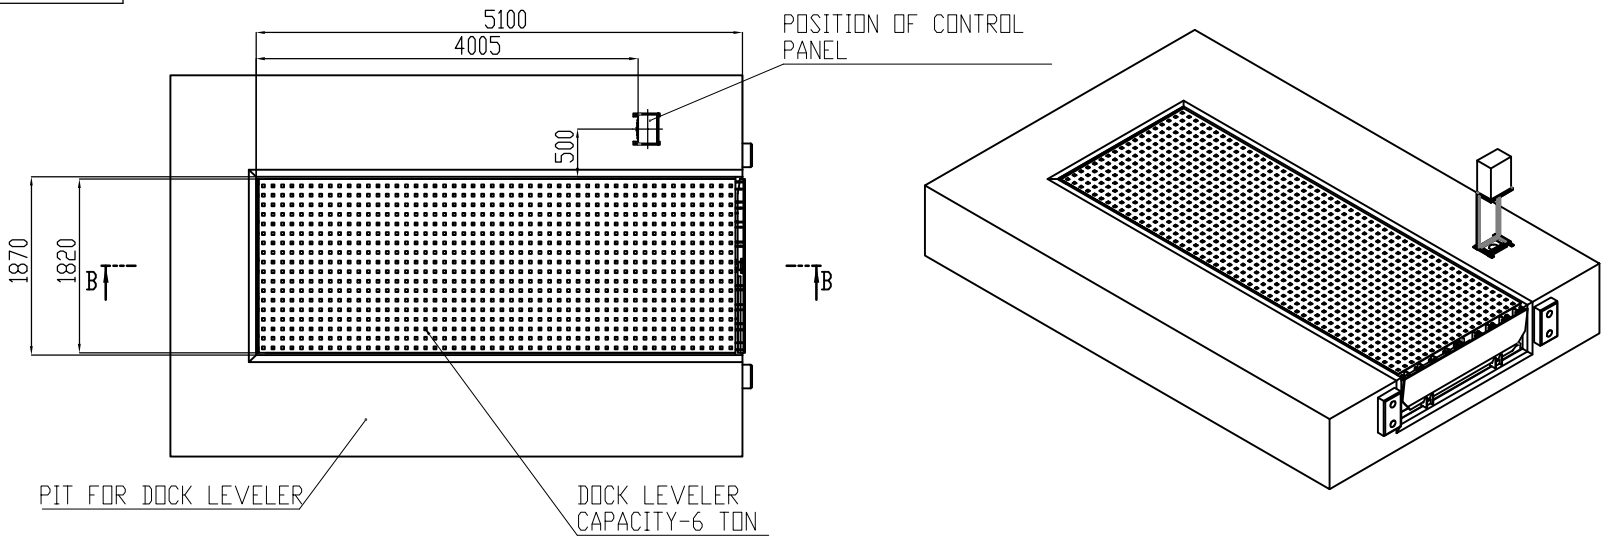


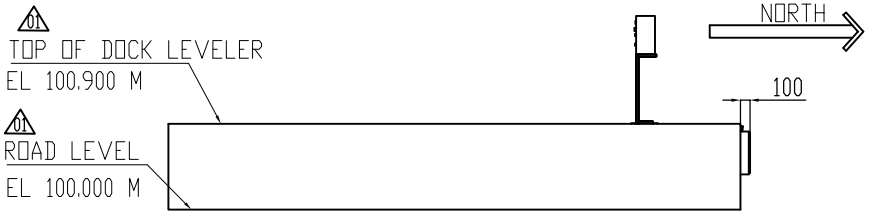

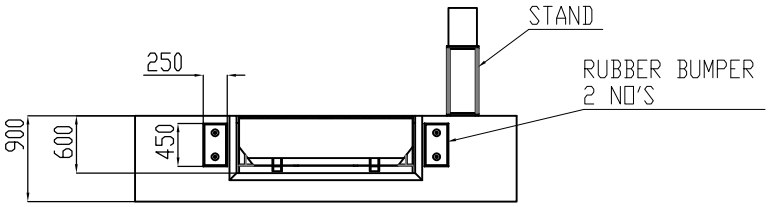

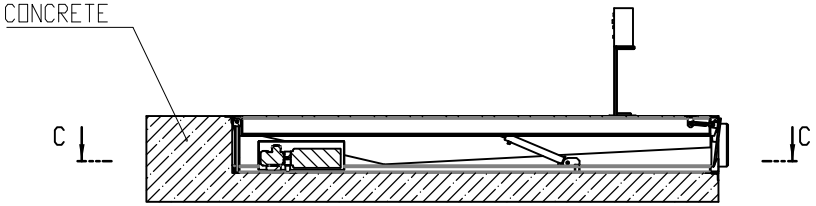

SECTION B-B
SCALE 1 : 28

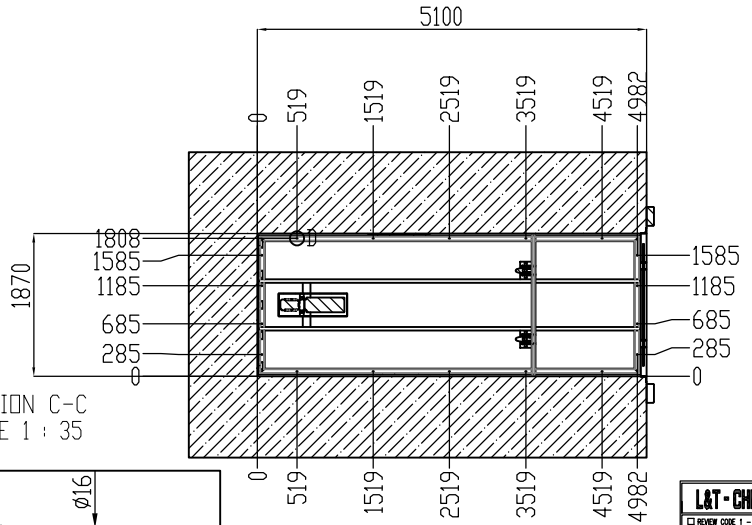


SECTION C-C
SCALE 1 : 35

01

PRODUCT DESCRIPTION -

1. DOCK LEVELER - PIT MOUNTED ELECTRO-HYDRAULIC TYPE
2. CAPACITY- 6 TON POINT LOAD
3. QTY- 2 NOS
4. PRODUCT SIZE- 5100mm(L)X1820mm(W)X600mm(D)
5. PIT SIZE-5100mm(L)X1870mm(W)X600mm(D)

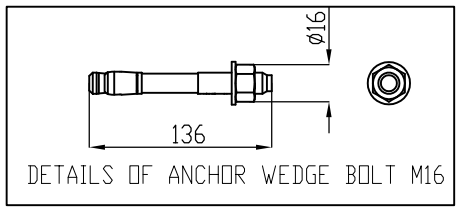

DETAILS OF ANCHOR WEDGE BOLT M16

ø18 HOLE

DETAIL D
SCALE 1 : 35

THIS DOCUMENT AND ANY DATA AND INFORMATION CONTAINED HEREIN ARE CONFIDENTIAL AND THE PROPERTY OF L&T HYDROCARBON ENGINEERING (LHE) AND THE COPYRIGHT THEREIN IS VESTED IN LHE. NO PART OF IT MAY BE REPRODUCED, STORED IN A RETRIEVAL SYSTEM OR TRANSMITTED IN ANY FORM OR BY ANY MEANS (ELECTRONIC, MECHANICAL, PHOTOCOPYING, RECORDING OR OTHERWISE) WITHOUT THE PRIOR WRITTEN PERMISSION OF LHE. IT SHALL NOT BE LENT, COPIED OR USED FOR ANY PURPOSE WHATSOEVER EXCEPT WITH THE PRIOR WRITTEN PERMISSION OF LHE.
ALL RIGHTS RESERVED

504-LZ-930A/B	GAD OF DOCK LEVELER 01	01
DRAWING NO.	DRAWING TITLE	REV

REFERENCE DOCUMENTS / DRAWINGS

DRG. CATEGORY: (USE TICK MARK) [R] [I] EIL REVIEW/APPROVAL VPTL NO.:
SCH. DATE OF SUBMISSION CODE:

DOCUMENT STATUS
STATEMENT OF SUB: [1st] [2nd] [3rd]
☐ FINAL FOR CODE-1 ☐ AS BUILT
ISSUED FOR
☐ AS BUILT ☑ INFORMATION
☐ CONSTRUCTION ☐ REVIEW

☐ REVIEW CODE 1 – NO COMMENTS PROCEED WITH MANUFACTURE / FABRICATION/ CONSTRUCTION AS PER THE DOCUMENT.
☐ REVIEW CODE 2 – PROCEED WITH MANUFACTURE / FABRICATION / CONSTRUCTION AS PER THE COMMENTED DOCUMENT. REVISED DOCUMENT REQUIRED.
☐ REVIEW CODE 3 – DOCUMENT DOES NOT CONFORM TO BASIC REQUIREMENTS AS MARKED. RESUBMIT FOR REVIEW.
☐ R – DOCUMENT IS RETAINED FOR RECORDS. PROCEED WITH MANUFACTURE / FABRICATION
☐ V-VOID

SIGN: DATE:

NAME DISCIPLINE SIGN. DATE

REV.	DESCRIPTION	DRN	CHECKED	APPROVED	REVIEWED	APPROVED	DATE
01	ISSUED FOR APPROVAL	SMS	VJ	AK			

OWNER: HINDUSTAN PETROLEUM CORPORATION LIMITED
VISAKH REFINERY MODERNIZATION PROJECT
EPCC-03 PACKAGE FOR RESIDUE UP-GRADATION FACILITY (RUF)

PMC : ENGINEERS INDIA LIMITED (A Govt. of India Undertaking)

LSTK CONTRACTOR: L&T Hydrocarbon Engineering

DETAILED ENGINEERING CENTER: L&T - CHIYODA LIMITED

VENDOR : NIHVA TECHNOLOGIES PVT LTD
VENDOR PO NO: REFINERY/75000-82256/VMM
VENDOR DWG. NO: NIHVA_20-21_0158

DATE: 26.05.21 SCALE: 1:6
DEPT: DESIGN
TITLE: CIVIL DRAWING FOR DOCK LEVELER (504-LZ-930A/B) 01
DRN BY: SMS
CHK BY: VJ
APP BY: AK
PROJECT: LAY-RUF
PWO NO.:
DRG. NO.: 2016-RUF-LT-504-HP-DV-HTPLCD-13005
SH. 2 OF 4
REV. 02
CAD FILE:

L&T - CHIYODA LIMITED


☐ REVIEW CODE 1 – NO COMMENTS PROCEED WITH MANUFACTURE / FABRICATION/ CONSTRUCTION AS PER THE DOCUMENT.
☐ REVIEW CODE 2 – PROCEED WITH MANUFACTURE/ FABRICATION /CONSTRUCTION AS PER THE COMMENTED DOCUMENT. REVISED DOCUMENT REQUIRED.
☐ REVIEW CODE 3 – DOCUMENT DOES NOT CONFORM TO BASIC REQUIREMENTS AS MARKED. RESUBMIT FOR REVIEW.
☐ R – DOCUMENT IS RETAINED FOR RECORDS. PROCEED WITH MANUFACTURE / FABRICATION
☐ V-VOID

COMMENTED BY	REVIEWED BY	APPROVED BY	DATE


THIS REVIEW / APPROVAL DOES NOT RELIEVE THE VENDOR / MANUFACTURER OF THE FULL RESPONSIBILITY AS TO DESIGN CORRECTNESS OF DIMENSIONS & COMPLIANCE WITHALL APPLICABLE REGULATIONS AND WITH THE REQUIREMENTS MADE IN PURCHASER SPECIFICATIONS.

ALL RIGHTS RESERVED
THIS DOCUMENT AND ANY DATA AND INFORMATION ARE CONFIDENTIAL AND THE PROPERTY OF L&T HYDROCARBON ENGINEERING (LHE) AND THE COPYRIGHT THEREIN IS VESTED IN LHE. NO PART OF THIS DOCUMENT SHALL BE REPRODUCED, STORED IN A RETRIEVAL SYSTEM OR TRANSMITTED, IN ANY FORM OR BY ANY MEANS, ELECTRONIC, MECHANICAL, PHOTOCOPYING, RECORDING OR OTHERWISE, WITHOUT THE PRIOR WRITTEN PERMISSION OF LHE. IT SHALL NOT BE LENT, COPIED, USED OR DISCLOSED FOR ANY PURPOSE EXCEPT AS AUTHORISED BY LHE AND SHALL BE RETURNED TO LHE ON DEMAND. IT SHALL BE USED FOR ANY PURPOSE WHATSOEVER ONLY IN ACCORDANCE WITH THE TERMS OF LHE'S CONTRACT WITH ITS CLIENT.


DWG. NO.

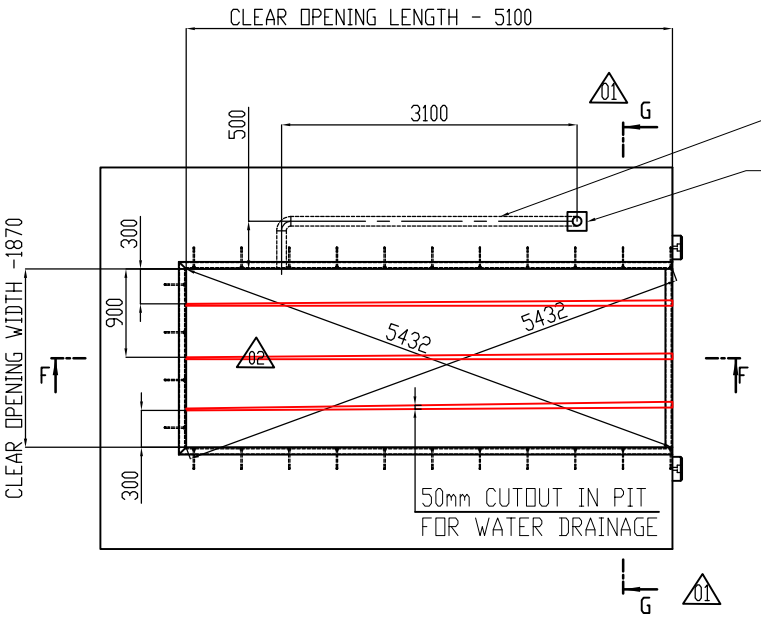


TOP VIEW OF DOCK PIT

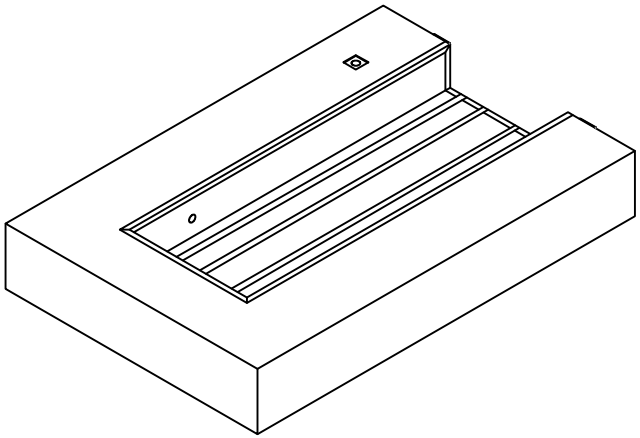


ISOMETRIC VIEW OF DOCK LEVELER PIT

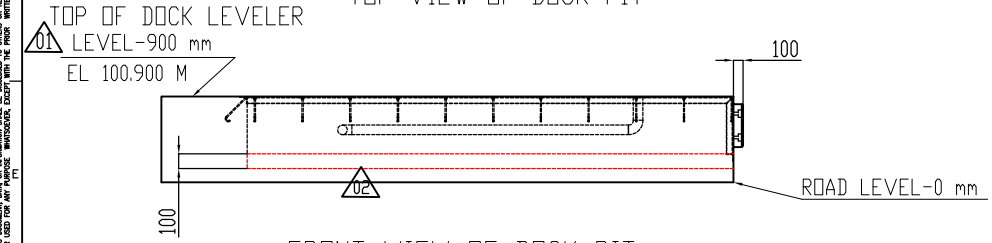


FRONT VIEW OF DOCK PIT

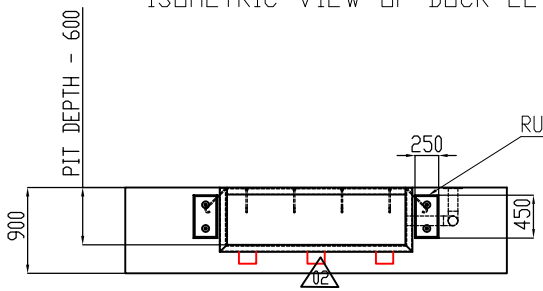


SIDE VIEW OF DOCK PIT

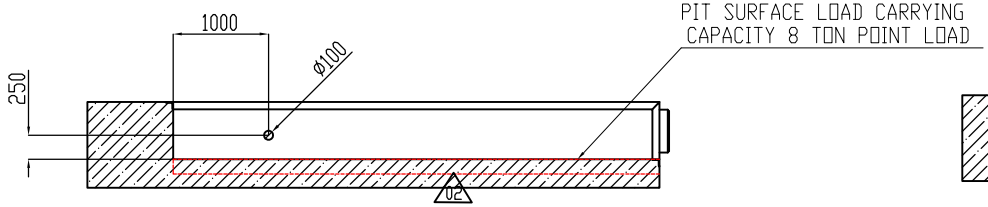

SECTION F-F
SCALE 1 : 28

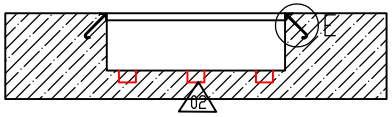

SECTION G-G 01
SCALE 1 : 28

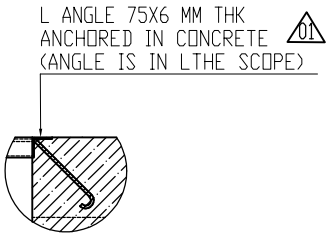

DETAIL E
SCALE 1 : 10

NOTES - 01

1. PIT & ALL CIVIL WORK IS IN LTHE SCOPE .
2. AT ALL EDGES OF PIT ANGLE 75X6 MM THK(ANGLE IN LTHE SCOPE) TO BE ANCHORED IN CONCRETE .
3. PIT SURFACE SHOULD BE PLAIN & LOAD CARRYING CAPACITY FOR PIT SURFACE SHOULB OF 8 TON POINT LOAD .
4. MINIMUM 4 INCH DUCT TO BE PROVIDED FROM CONTROL PANEL TO PIT OPENING BY LTHE FOR ELECTRICAL CABLE ROUTING . REQUIRED DUCT IS IN LTHE SCOPE.
5. CONTROL PANEL IS PROVIDED WITH ELECTRICAL CABLE. CONTROL PANEL SHOULD BE LOCATED NEAR DOCK LEVELER FOR EASY VIEW OF LIP RESTING ON VEHICLE .

504-LZ-930A/B	GAD OF DOCK LEVELER 01	01
DRAWING NO.	DRAWING TITLE	REV

REFERENCE DOCUMENTS / DRAWINGS

DRG. CATEGORY: (USE TICK MARK) [R] [I]
EIL REVIEW/APPROVAL CODE:
VPTL NO.:
SCH. DATE OF SUBMISSION
DOCUMENT STATUS
STATEMENT OF SUB: [1st] [2nd] [3rd]
☐ FINAL FOR CODE-1 ☐ AS BUILT
ISSUED FOR
☐ AS BUILT ☐ CONSTRUCTION ☐ INFORMATION ☐ REVIEW
SIGN: DATE:

☐ REVIEW CODE 1 – NO COMMENTS PROCEED WITH MANUFACTURE / FABRICATION/ CONSTRUCTION AS PER THE DOCUMENT.
☐ REVIEW CODE 2 – PROCEED WITH MANUFACTURE / FABRICATION / CONSTRUCTION AS PER THE COMMENTED DOCUMENT. REVISED DOCUMENT REQUIRED.
☐ REVIEW CODE 3 – DOCUMENT DOES NOT CONFORM TO BASIC REQUIREMENTS AS MARKED. RESUBMIT FOR REVIEW.
☐ R – DOCUMENT IS RETAINED FOR RECORDS. PROCEED WITH MANUFACTURE / FABRICATION
☐ V-VOID

	NAME	DISCIPLINE	SIGN.	DATE

REV.	DESCRIPTION	DRN	CHECKED	APPROVED	REVIEWED	APPROVED	DATE
01	ISSUED FOR APPROVAL	SMS	VJ		AK		

OWNER: HINDUSTAN PETROLEUM CORPORATION LIMITED
VISAKH REFINERY MODERNIZATION PROJECT
EPCC-03 PACKAGE FOR RESIDUE UP-GRADATION FACILITY (RUF)

PMC : ENGINEERS INDIA LIMITED (A Govt. of India Undertaking)

LSTK CONTRACTOR: L&T Hydrocarbon Engineering

DETAILED ENGINEERING CENTER: L&T - CHIYODA LIMITED

VENDOR : NOVA TECHNOLOGIES PVT LTD
VENDOR PO NO: REFINARY/75000-82256/VMM
VENDOR DWG. NO: NOVA_20-21_0158

DATE: 29.3.21 | SCALE: 1:6
DEPT: DESIGN
DRN BY: SMS
CHK BY: VJ
APP BY: AK
PROJECT: L&T-RUF
PWO NO.:
TITLE: CIVIL DRAWING FOR DOCK LEVELER (504-LZ-930A/B) 01
DRG. NO.: 3016-RUF-LT-504-HP-SV-NTPLCD-13005
SH. 4 OF 4
REV. 02
CAD FILE:

L&T - CHIYODA LIMITED

☐ REVIEW CODE 1 – NO COMMENTS PROCEED WITH MANUFACTURE / FABRICATION/ CONSTRUCTION AS PER THE DOCUMENT.
☐ REVIEW CODE 2 – PROCEED WITH MANUFACTURE/ FABRICATION /CONSTRUCTION AS PER THE COMMENTED DOCUMENT. REVISED DOCUMENT REQUIRED.
☐ REVIEW CODE 3 – DOCUMENT DOES NOT CONFORM TO BASIC REQUIREMENTS AS MARKED. RESUBMIT FOR REVIEW.
☐ R – DOCUMENT IS RETAINED FOR RECORDS. PROCEED WITH MANUFACTURE / FABRICATION
☐ V-VOID

COMMENTED BY	REVIEWED BY	APPROVED BY	DATE

THIS REVIEW / APPROVAL DOES NOT RELIEVE THE VENDOR / MANUFACTURER OF THE FULL RESPONSIBILITY AS TO DESIGN CORRECTNESS OF DIMENSIONS & COMPLIANCE WITHALL APPLICABLE REGULATIONS AND WITH THE REQUIREMENTS MADE IN PURCHASER SPECIFICATIONS.