HP / ENGINEERS INDIA LIMITED	Residue Upgradation Facility (RUF) EPCC-3 Package for Visakh Refinery Modernization Project (VRMP)	L&T Hydrocarbon Engineering L&T- CHIYODA LIMITED
Title: ~~Data~~ Civil drawing for Dock Leveller (504-LZ-930 A/B) Doc. No.: B016-RUF-LT-504-MP-DW-NTPL(1)-13005		Rev. No.: 00 Page No: 1 of 4

OWNER	:	HINDUSTAN PETROLEUM CORPORATION LIMITED (HPCL)
PMC	:	ENGINEERS INDIA LIMITED, NEW DELHI (EIL)
UNIT	:	504
PMC JOB NO.	:	B016
EQUIPMENT DESCRIPTION	:	DOCK LEVELLER
EQUIPMENT TAG	:	504-LZ-930 A/B
P. R. NO.	:	B016-RUF-LT-504-MP-PR-0014
VENDOR NAME	:	NIHVA TECHNOLOGIES PVT LTD
VENDOR DOCUMENT NO.	:	NIHVA_20-21_0158

DOCUMENT SUBMISSION STATUS – LTHE/VENDOR	REVIEW STATUS – LTHE	REVIEW STATUS – EIL
DOC. CATEGORY: (USE TICK MARK) ☑ R ☐ I	☐ Code 1 – No Comments. Proceed With Manufacture / Fabrication / Construction As Per The Document.	☐ Code 1 – No Comments. Proceed With Manufacture / Fabrication / Construction As Per The Document.
ISSUED FOR ☐ INFORMATION ☑ REVIEW ☐ CONSTRUCTION ☐ AS BUILT	☑ Code 2 – Proceed With Manufacture/Fabrication/Construction As Per Commented Document. Revised Document Required. ☐ Review Code 3 – Document Does Not Conform To Basic Requirements As Marked. Resubmit For Review ☐ Code R– Document Is Retained For Records. Proceed With Manufacture / Fabrication ☐ Code V- Void (Submission Required / Not Required)	☐ Code 2 – Proceed With Manufacture/Fabrication/Construction As Per Commented Document. Revised Document Required. ☐ Review Code 3 – Document Does Not Conform To Basic Requirements As Marked. Resubmit For Review ☐ Code R– Document Is Retained For Records. Proceed With Manufacture / Fabrication ☐ Code V- Void (Submission Required / Not Required)
	ME-P / DISCIPLINE | MJG/ PPP/ MRS / SIGN | 04-Jun-21 / DATE	DISCIPLINE | SIGN | DATE

Revision No.	Description	Prepared by	Reviewed by	Approved by	Reviewed by	Approved by	Approved Date
	DOCUMENT REVIEW DETAILS	Vikrant J	Amit K	Amit K			31-05-2021

1 No comments.
2 Proceed with manufacture / fabrication as per the commented document. Revised document required.
3 Document does not conform to basic requirements as marked. Resubmit for review.
R Retained for Records. V Void.

Signature with Date: 03-SEP-2021
Name of Reviewer: AJEET KUMAR (B565)
Page No. 1 of 9

Doc. B016-RUF-LT-504-MP-DW-NTPL(1)-13005 Rev. 00

ALL RIGHTS RESERVED
THIS DOCUMENT AND ANY DATA AND INFORMATION CONTAINED THEREIN ARE CONFIDENTIAL AND THE PROPERTY OF L&T HYDROCARBON ENGINEERING (LTHE) AND THE COPYRIGHT THEREIN IS VESTED IN LTHE NO PART OF THIS DOCUMENT, DATA, OR INFORMATION SHALL BE DISCLOSED TO OTHERS OR REPRODUCED, STORED, TRANSMITTED OR USED FOR ANY PURPOSE WHATSOEVER, EXCEPT WITH THE PRIOR WRITTEN PERMISSION OF LTHE.

REVISION HISTORY SHEET

REV. NO.	REV. DATE	REVISED PAGE	REVISION DESCRIPTION
00	31-05	NA	ISSUED FOR APPROVAL

DOCUMENT REVIEW DETAILS

1 No Comments. **Doc. B016-RUF-LT-504-MP-DW-NTPL(1)-13005 Rev. 00**

2 Proceed with manufacture / fabrication as per the commented document. Revised document required.

3 Document does not conform to basic requirements as marked. Resubmit for review.

R ✓ Retained for Records. V Void.

Signature with Date **03-SEP-2021**


Name of Reviewer **AJEET KUMAR (B565)**


Page No. **2 of 9**


ALL RIGHTS RESERVED


THIS DOCUMENT AND ANY DATA AND INFORMATION CONTAINED THEREIN ARE CONFIDENTIAL AND THE PROPERTY OF L&T HYDROCARBON ENGINEERING (LTHE) AND THE COPYRIGHT THEREIN IS VESTED IN LTHE NO PART OF THIS DOCUMENT, DATA, OR INFORMATION SHALL BE DISCLOSED TO OTHERS OR REPRODUCED, STORED OR USED FOR ANY PURPOSE WHATSOEVER, EXCEPT WITH THE PRIOR WRITTEN PERMISSION OF LTHE.

DWG. NO.

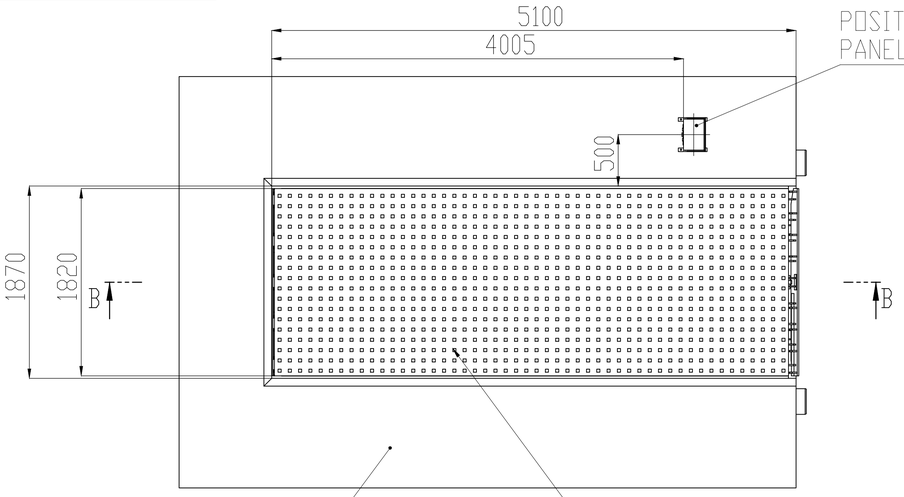


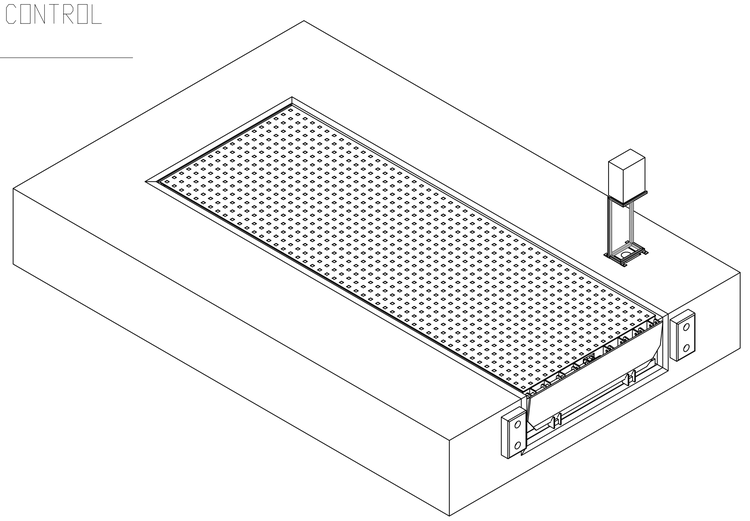

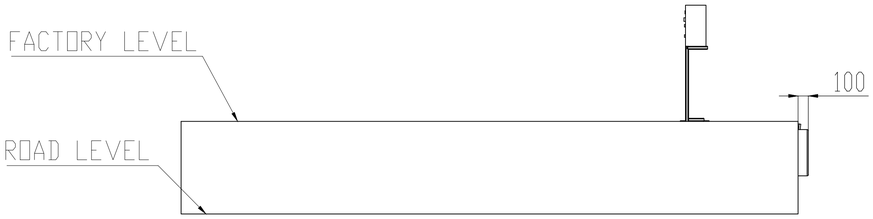


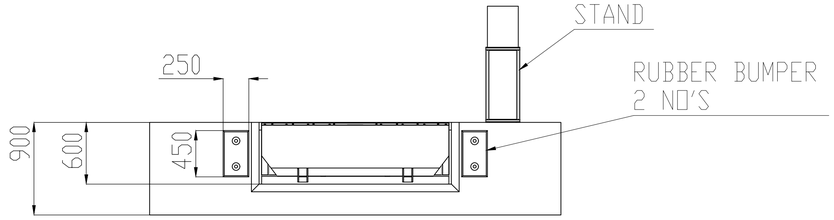

BOTTOM FRAME FIXING
USING ANCHOR WEDGE
BOLT M16 L-137mm

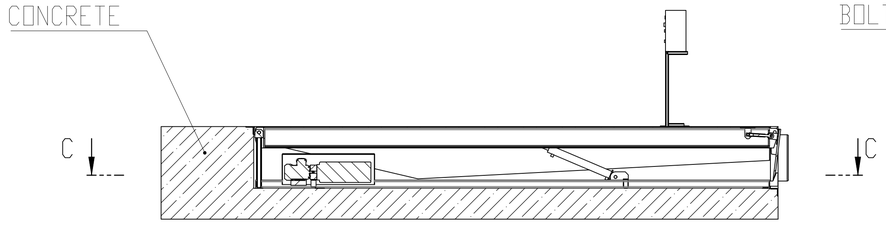


SECTION B-B
SCALE 1 : 28

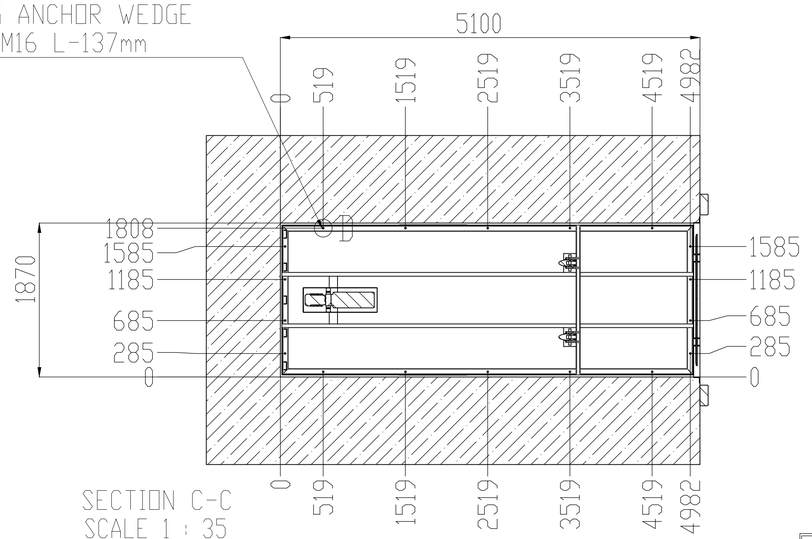

SECTION C-C
SCALE 1 : 35

Please update the below as Product Description.

PROJECT DESCRIPTION -
1. DOCK LEVELER - PIT MOUNTED ELECTRO-HYDRAULIC TYPE
2. CAPACITY- 6 TON POINT LOAD
3. QTY- 2 NOS
4. PRODUCT SIZE- 5100mm(L)X1820mm(W)X600mm(D)
5. PIT SIZE-5100mm(L)X1870mm(W)X600mm(D)

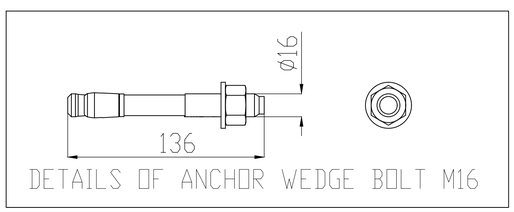

DETAILS OF ANCHOR WEDGE BOLT M16



DETAIL D
SCALE 2 : 35

ALL RIGHTS RESERVED
THIS DOCUMENT AND ANY DATA AND INFORMATION CONTAINED THEREIN ARE CONFIDENTIAL AND THE PROPERTY OF L&T HYDROCARBON ENGINEERING (HE) AND THE COPYRIGHT THEREIN IS VESTED IN L&T HE. NO PART OF THIS DOCUMENT AND THE DATA AND INFORMATION CONTAINED THEREIN SHALL BE REPRODUCED, DISCLOSED OR USED FOR ANY PURPOSE WHATSOEVER, EXCEPT WITH THE PRIOR WRITTEN PERMISSION OF L&T HE.

DOCUMENT REVIEW DETAILS

1 No Comments.
2 Proceed with manufacture / fabrication as per the commented document. Revised document required.
3 Document does not conform to basic requirements as marked. Resubmit for review.
R Retained for Records.
V Void.

Doc. B016-RUF-LT-504-MP-DW-NTPL(1)-13005 Rev. 00

Signature with Date: 03-SEP-2021
Name of Reviewer: AJEET KUMAR (B565)
Page No.: 3 of 9

Page 3 of 9

DRAWING NO.	DRAWING TITLE	REV

REFERENCE DOCUMENTS / DRAWINGS

DRG. CATEGORY: (USE TICK MARK) [R] [✓]
EIL REVIEW/APPROVAL
VPTL NO.:
CODE:
SCH. DATE OF SUBMISSION

DOCUMENT STATUS
STATEMENT OF SUB: [1st] [2nd] [3rd]
☐ FINAL FOR CODE-1 ☐ AS BUILT

ISSUED FOR
☐ AS BUILT ☐ CONSTRUCTION ☑ INFORMATION ☐ REVIEW

SIGN: DATE:

☐ REVIEW CODE 1 – NO COMMENTS PROCEED WITH MANUFACTURE / FABRICATION/ CONSTRUCTION AS PER THE DOCUMENT.
☐ REVIEW CODE 2 – PROCEED WITH MANUFACTURE / FABRICATION / CONSTRUCTION AS PER THE COMMENTED DOCUMENT. REVISED DOCUMENT REQUIRED.
☐ REVIEW CODE 3 – DOCUMENT DOES NOT CONFORM TO BASIC REQUIREMENTS AS MARKED. RESUBMIT FOR REVIEW.
☐ R – DOCUMENT IS RETAINED FOR RECORDS. PROCEED WITH MANUFACTURE / FABRICATION
☐ V–VOID

NAME DICIPLINE SIGN, DATE

REV.	DESCRIPTION	DRN	CHECKED	APPROVED	REVIEWED	APPROVED	DATE
00	ISSUED FOR APPROVAL	SMS	VJ	AK			

OWNER: HINDUSTAN PETROLEUM CORPORATION LIMITED
VISAKH REFINERY MODERNIZATION PROJECT
EPCC-03 PACKAGE FOR RESIDUE UP-GRADATION FACILITY (RUF)

PMC: ENGINEERS INDIA LIMITED (A Govt. of India Undertaking)

LSTK CONTRACTOR: L&T Hydrocarbon Engineering

DETAILED ENGINEERING CENTER: L&T - CHIYODA LIMITED

L&T - CHIYODA LIMITED
☐ REVIEW CODE 1 – NO COMMENTS PROCEED WITH MANUFACTURE / FABRICATION/ CONSTRUCTION AS PER THE DOCUMENT.
☐ REVIEW CODE 2 – PROCEED WITH MANUFACTURE/ FABRICATION /CONSTRUCTION AS PER THE COMMENTED DOCUMENT. REVISED DOCUMENT REQUIRED.
☐ REVIEW CODE 3 – DOCUMENT DOES NOT CONFORM TO BASIC REQUIREMENTS AS MARKED. RESUBMIT FOR REVIEW.
☐ R – DOCUMENT IS RETAINED FOR RECORDS. PROCEED WITH MANUFACTURE / FABRICATION
☐ V–VOID

COMMENTED BY	REVIEWED BY	APPROVED BY	DATE


THIS REVIEW / APPROVAL DOES NOT RELIEVE THE VENDOR / MANUFACTURER OF THE FULL RESPONSIBILITY AS TO DESIGN CORRECTNESS OF DIMENSIONS & COMPLIANCE WITHALL APPLICABLE REGULATIONS AND WITH THE REQUIREMENTS MADE IN PURCHASER SPECIFICATIONS.

VENDOR: NIHVA TECHNOLOGIES PVT LTD
VENDOR PO NO: REFINARY/75000-82256/VMM
VENDOR DWG. NO: NIHVA_20-21_0158


DATE: 31.05.21 SCALE: 1:1
TITLE: CIVIL DRAWING FOR DOCK LEVELER
DEPT: DESIGN
DRN BY: SMS
CHK BY: VJ
APP BY: AK
PROJECT: L&T-RUF
DRG. NO.: B016-RUF-LT-504-MP-DW-NTPL(1)-13005
SH. 1 OF 2
REV. 00
PWO NO.:
CAD REVISE THIS DRG. USING CAD SYSTEM ONLY FILE:

ALL RIGHTS RESERVED
THIS DOCUMENT AND ANY DATA AND INFORMATION CONTAINED THEREIN ARE CONFIDENTIAL AND THE PROPERTY OF L&T HYDROCARBON ENGINEERING, LTD. AND IS NOT TO BE COPIED, REPRODUCED, STORED IN ANY RETRIEVAL SYSTEM OR TRANSMITTED IN ANY FORM OR BY ANY MEANS, ELECTRONIC, MECHANICAL, PHOTOCOPYING, RECORDING OR OTHERWISE, WHATSOEVER, EXCEPT WITH THE PRIOR WRITTEN PERMISSION OF LTHE. OR USED FOR ANY PURPOSE OTHER THAN FOR WHICH IT IS SPECIFICALLY FURNISHED.


DWG. NO.

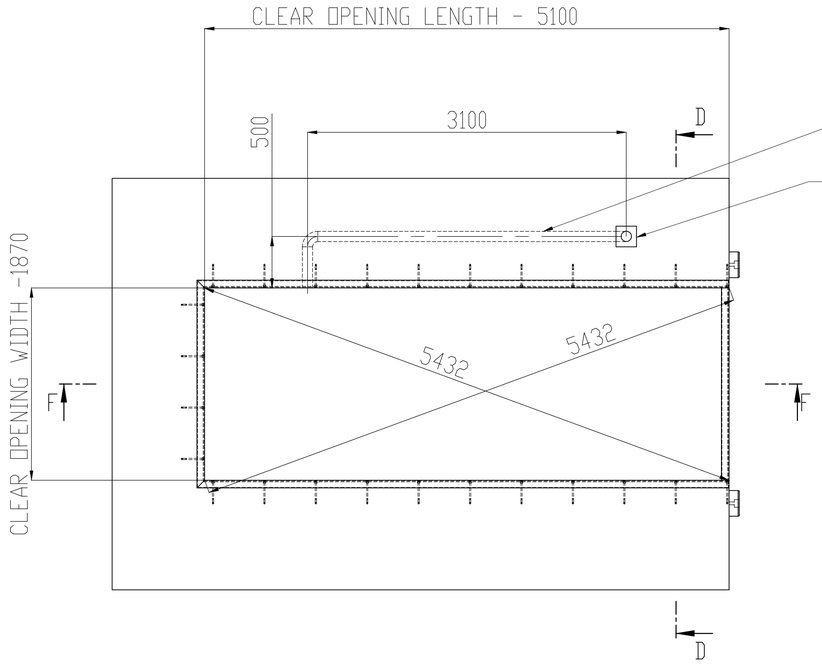


TOP VIEW OF DOCK PIT

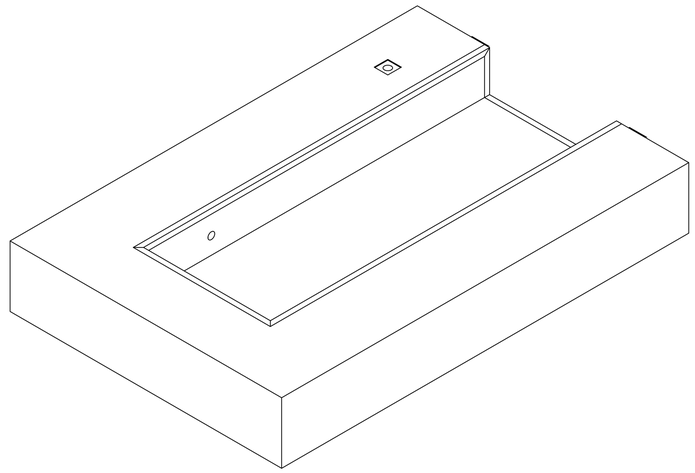


ISOMETRIC VIEW OF DOCK LEVELER PIT

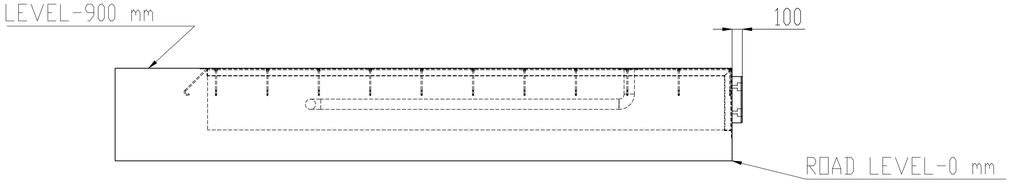


FRONT VIEW OF DOCK PIT

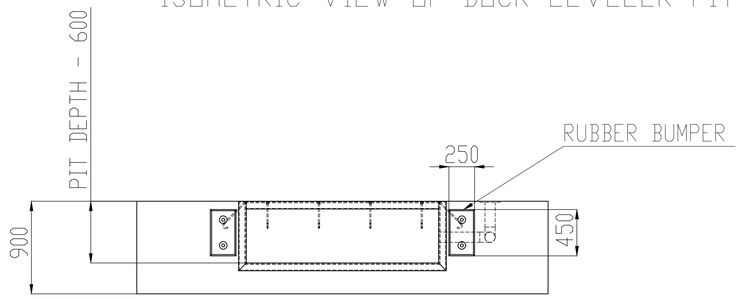


SIDE VIEW OF DOCK PIT

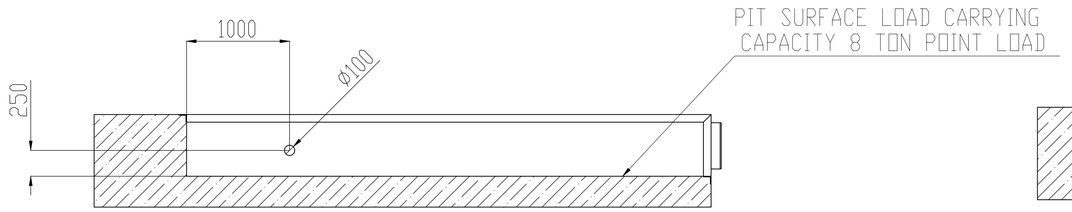

SECTION F-F
SCALE 1 : 28

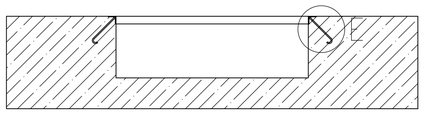

SECTION D-D
SCALE 1 : 28

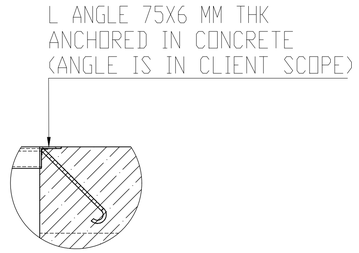

DETAIL E
SCALE 1 : 10

NOTES -
1. PIT & ALL CIVIL WORK IS CLIENT SCOPE .
2. AT ALL EDGES OF PIT ANGLE 75X6 MM THK(ANGLE IN CLIENT SCOPE) TO BE ANCHORED IN CONCRETE .
3. PIT SURFACE SHOULD BE PLAIN & LOAD CARRYING CAPACITY FOR PIT SURFACE SHOULB OF 8 TON POINT LOAD .
4. MINIMUM 4 INCH DUCT DUCT TO BE PROVIDED FROM CONTROL PANEL TO PIT OPENING BY CLIENT FOR ELECTRICAL CABLE ROUTING . REQUIRED DUCT IS IN CLIENT SCOPE.
5. CONTROL PANEL IS PROVIDED WITH ELECTRICAL CABLE LENGTH OF 5 METER AS STANDARD . CONTROL PANEL SHOULD BE LOCATED NEAR DOCK LEVELER FOR EASY VIEW OF LIP RESTING ON VEHICLE .

DOCUMENT REVIEW DETAILS :
1 No Comments.
2 Proceed with manufacture / fabrication as per the commented document. Revised document required.
3 Document does not conform to basic requirements as marked. Resubmit for review.
R Retained for Records.
V Void.
Doc. B016-RUF-LT-504-MP-DW-NTPL(1)-13005 Rev. 00
Signature with Date: 03-SEP-2021
Name of Reviewer: AJEET KUMAR (B565)
Page No.: 4 of 9

L&T - CHIYODA LIMITED

- ☐ REVIEW CODE 1 – NO COMMENTS PROCEED WITH MANUFACTURE / FABRICATION/ CONSTRUCTION AS PER THE DOCUMENT.
- ☐ REVIEW CODE 2 – PROCEED WITH MANUFACTURE/ FABRICATION /CONSTRUCTION AS PER THE COMMENTED DOCUMENT. REVISED DOCUMENT REQUIRED.
- ☐ REVIEW CODE 3 – DOCUMENT DOES NOT CONFORM TO BASIC REQUIREMENTS AS MARKED. RESUBMIT FOR REVIEW.
- ☐ R – DOCUMENT IS RETAINED FOR RECORDS. PROCEED WITH MANUFACTURE / FABRICATION
- ☐ V-VOID

COMMENTED BY	REVIEWED BY	APPROVED BY	DATE

THIS REVIEW / APPROVAL DOES NOT RELIEVE THE VENDOR / MANUFACTURER OF THE FULL RESPONSIBILITY AS TO DESIGN CORRECTNESS OF DIMENSIONS & COMPLIANCE WITHALL APPLICABLE REGULATIONS AND WITH THE REQUIREMENTS MADE IN PURCHASER SPECIFICATIONS.

DRAWING NO.	DRAWING TITLE	REV
	REFERENCE DOCUMENTS / DRAWINGS	

DRG. CATEGORY: (USE TICK MARK) R I
EIL REVIEW/APPROVAL CODE:
VPTL NO.:
SCH. DATE OF SUBMISSION
DOCUMENT STATUS
STATEMENT OF SUB: 1st 2nd 3rd
☐ FINAL FOR CODE-1 ☐ AS BUILT
ISSUED FOR
☐ AS BUILT ☐ INFORMATION
☐ CONSTRUCTION ☐ REVIEW
SIGN: DATE:

- ☐ REVIEW CODE 1 – NO COMMENTS PROCEED WITH MANUFACTURE / FABRICATION/ CONSTRUCTION AS PER THE DOCUMENT.
- ☐ REVIEW CODE 2 – PROCEED WITH MANUFACTURE / FABRICATION / CONSTRUCTION AS PER THE COMMENTED DOCUMENT. REVISED DOCUMENT REQUIRED.
- ☐ REVIEW CODE 3 – DOCUMENT DOES NOT CONFORM TO BASIC REQUIREMENTS AS MARKED. RESUBMIT FOR REVIEW.
- ☐ R – DOCUMENT IS RETAINED FOR RECORDS. PROCEED WITH MANUFACTURE / FABRICATION
- ☐ V-VOID

NAME DICIPLINE SIGN, DATE

REV.	DESCRIPTION	DRN	CHECKED	APPROVED	REVIEWED	APPROVED	DATE
00	ISSUED FOR APPROVAL	SMS	VJ	AK			

OWNER: HINDUSTAN PETROLEUM CORPORATION LIMITED
VISAKH REFINERY MODERNIZATION PROJECT
EPCC-03 PACKAGE FOR RESIDUE UP-GRADATION FACILITY (RUF)

PMC : इंजीनियर्स इंडिया लिमिटेड ENGINEERS INDIA LIMITED (A Govt. of India Undertaking)

LSTK CONTRACTOR: L&T Hydrocarbon Engineering

DETAILED ENGINEERING CENTER: L&T - CHIYODA LIMITED

VENDOR : NIHVA TECHNOLOGIES PVT LTD
VENDOR PO NO: REFINARY/75000-82256/VMM
VENDOR DWG. NO: NIHVA_20-21_0158

DATE 29.5.21 | SCALE 1:1 | TITLE: CIVIL DRAWING FOR DOCK LEVELER

DEPT: DESIGN
DRN BY: SMS
CHK BY: VJ
APP BY: AK
PROJECT: L&T-RUF
PWO NO.:
DRG. NO.: B016-RUF-LT-504-MP-DW-NTPL(1)-13005
SH. 2 OF 2
REV. 00
CAD #DWG THIS DRG. USING CAD SYSTEM ONLY FILE:

Refer attached commented drawing.

DOCUMENT REVIEW DETAILS

1 No Comments. **Doc. B016-RUF-LT-504-MP-DW-NTPL(1)-13005 Rev. 00**

2 Proceed with manufacture / fabrication as per the commented document. Revised document required.

3 Document does not conform to basic requirements as marked. Resubmit for review.

R ✓ Retained for Records. V Void.

Signature with Date **03-SEP-2021**

Name of Reviewer **AJEET KUMAR (B565)**

Page No. **5 of 9**

हिन्दुस्तान पेट्रोलियम HP इंजीनियर्स इंडिया लिमिटेड ENGINEERS INDIA LIMITED (A Govt. of India Undertaking)	**Residue Upgradation Facility (RUF)** **EPCC-3 Package for** **Visakh Refinery Modernization Project (VRMP)**	L&T Hydrocarbon Engineering **L&T- CHIYODA LIMITED**
Title: ~~Data~~ Civil drawing for Dock Leveller (504-LZ-930 A/B) **Doc. No.: B016-RUF-LT-504-MP-DW-NTPL(1)-13005**		**Rev. No.: 00** **Page No: 1 of 4**

OWNER	:	**HINDUSTAN PETROLEUM CORPORATION LIMITED (HPCL)**
PMC	:	**ENGINEERS INDIA LIMITED, NEW DELHI (EIL)**
UNIT	:	**504**
PMC JOB NO.	:	**B016**
EQUIPMENT DESCRIPTION	:	**DOCK LEVELLER**
EQUIPMENT TAG	:	504-LZ-930 A/B
P. R. NO.	:	B016-RUF-LT-504-MP-PR-0014
VENDOR NAME	:	**NIHVA TECHNOLOGIES PVT LTD**
VENDOR DOCUMENT NO.	:	**NIHVA_20-21_0158**

DOCUMENT SUBMISSION STATUS – LTHE/VENDOR	**REVIEW STATUS**	
	LTHE	**EIL**
DOC. CATEGORY: (USE TICK MARK) ☑ R ☐ I	☐ Code 1 – No Comments. Proceed With Manufacture / Fabrication / Construction As Per The Document. ☑ Code 2 – Proceed With Manufacture/Fabrication/Construction As Per Commented Document. Revised Document Required. ☐ Review Code 3 – Document Does Not Conform To Basic Requirements As Marked. Resubmit For Review ☐ Code R– Document Is Retained For Records. Proceed With Manufacture / Fabrication ☐ Code V- Void (Submission Required / Not Required)	☐ Code 1 – No Comments. Proceed With Manufacture / Fabrication / Construction As Per The Document. ☐ Code 2 – Proceed With Manufacture/Fabrication/Construction As Per Commented Document. Revised Document Required. ☐ Review Code 3 – Document Does Not Conform To Basic Requirements As Marked. Resubmit For Review ☐ Code R– Document Is Retained For Records. Proceed With Manufacture / Fabrication ☐ Code V- Void (Submission Required / Not Required)
ISSUED FOR ☐ INFORMATION ☑ REVIEW ☐ CONSTRUCTION ☐ AS BUILT		
	ME-P / DISCIPLINE | MJG/ PPP/ MRS / SIGN | 04-Jun-21 / DATE	DISCIPLINE | SIGN | DATE

Revision No.	Description	Prepared by	Reviewed by	Approved by	Reviewed by	Approved by	Approved Date
00	DOCUMENT REVIEW DETAILS	Vikrant J	Amit K	Amit K			31-05-2021

1 No comments.
2 Proceed with manufacture / fabrication as per the commented document. Revised document required.
3 Document does not conform to basic requirements as marked. Resubmit for review.
R Retained for Records. V Void.

Signature with Date: 03-SEP-2021
Name of Reviewer: AJEET KUMAR (B565)
Page No. 6 of 9

Doc. B016-RUF-LT-504-MP-DW-NTPL(1)-13005 Rev. 00

ALL RIGHTS RESERVED
THIS DOCUMENT AND ANY DATA AND INFORMATION CONTAINED THEREIN ARE CONFIDENTIAL AND THE PROPERTY OF L&T HYDROCARBON ENGINEERING (LTHE) AND THE COPYRIGHT THEREIN IS VESTED IN LTHE NO PART OF THIS DOCUMENT, DATA, OR INFORMATION SHALL BE DISCLOSED TO OTHERS OR REPRODUCED, STORED, ADAPTED OR USED FOR ANY PURPOSE WHATSOEVER, EXCEPT WITH THE PRIOR WRITTEN PERMISSION OF LTHE.

REVISION HISTORY SHEET

REV. NO.	REV. DATE	REVISED PAGE	REVISION DESCRIPTION
00	31-05	NA	ISSUED FOR APPROVAL

DOCUMENT REVIEW DETAILS

1 No Comments. **Doc. B016-RUF-LT-504-MP-DW-NTPL(1)-13005 Rev. 00**

2 Proceed with manufacture / fabrication as per the commented document. Revised document required.

3 Document does not conform to basic requirements as marked. Resubmit for review.

R Retained for Records. V Void.

Signature with Date **03-SEP-2021**

Name of Reviewer **AJEET KUMAR (B565)**


Page No. **7 of 9**


ALL RIGHTS RESERVED


THIS DOCUMENT AND ANY DATA AND INFORMATION CONTAINED THEREIN ARE CONFIDENTIAL AND THE PROPERTY OF L&T HYDROCARBON ENGINEERING (LTHE) AND THE COPYRIGHT THEREIN IS VESTED IN LTHE NO PART OF THIS DOCUMENT, DATA, OR INFORMATION SHALL BE DISCLOSED TO OTHERS OR REPRODUCED, STORED OR USED FOR ANY PURPOSE WHATSOEVER, EXCEPT WITH THE PRIOR WRITTEN PERMISSION OF LTHE.


ALL RIGHTS RESERVED
THIS DOCUMENT AND ANY DATA AND INFORMATION CONTAINED THEREIN ARE CONFIDENTIAL AND THE PROPERTY OF L&T HYDROCARBON ENGINEERING (L&THE) AND THE COPYRIGHT THEREIN IS VESTED IN L&THE. NO PART OF THIS DOCUMENT AND ANY DATA AND INFORMATION CONTAINED THEREIN SHALL BE REPRODUCED OR USED FOR ANY PURPOSE WHATSOEVER, EXCEPT WITH THE PRIOR WRITTEN PERMISSION OF L&THE.

DWG. NO.

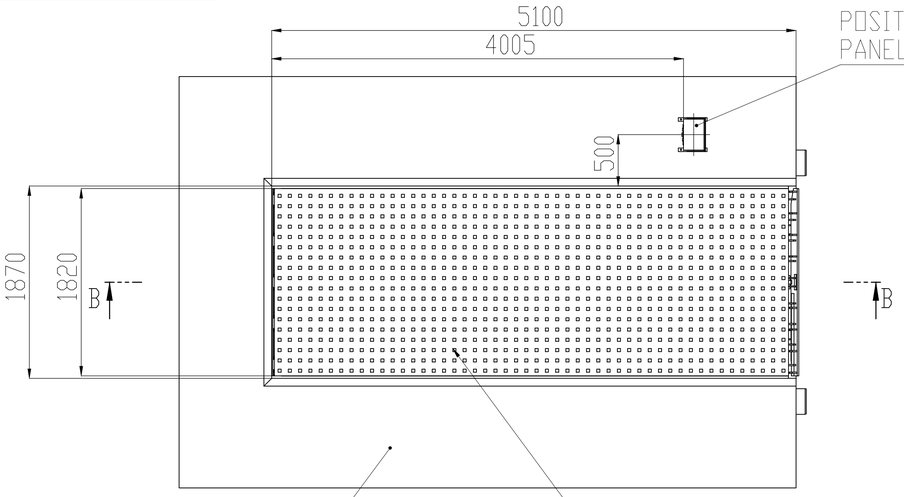


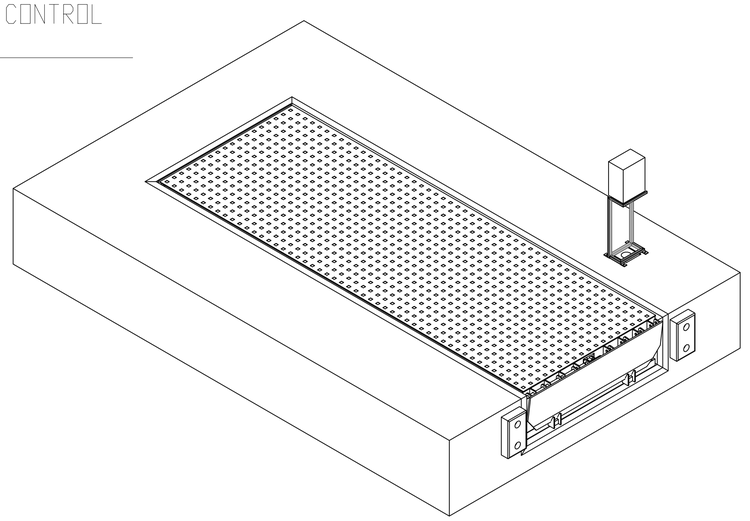

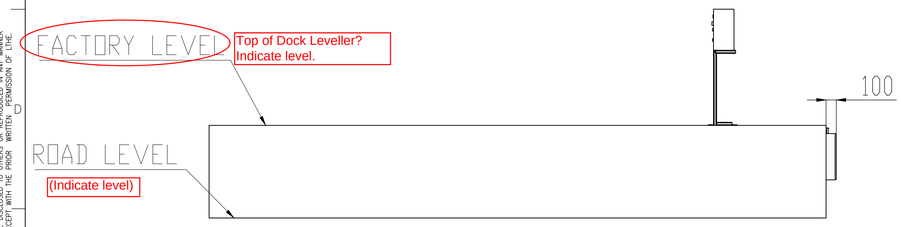


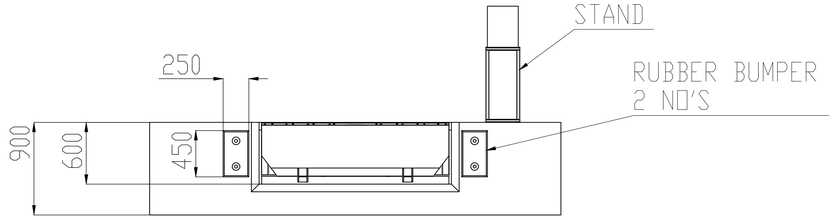

BOTTOM FRAME FIXING USING ANCHOR WEDGE BOLT M16 L-137mm

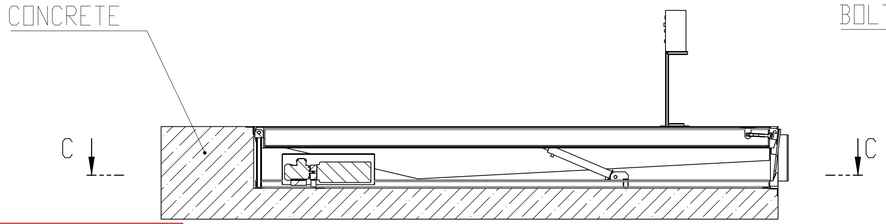


SECTION B-B
SCALE 1 : 28

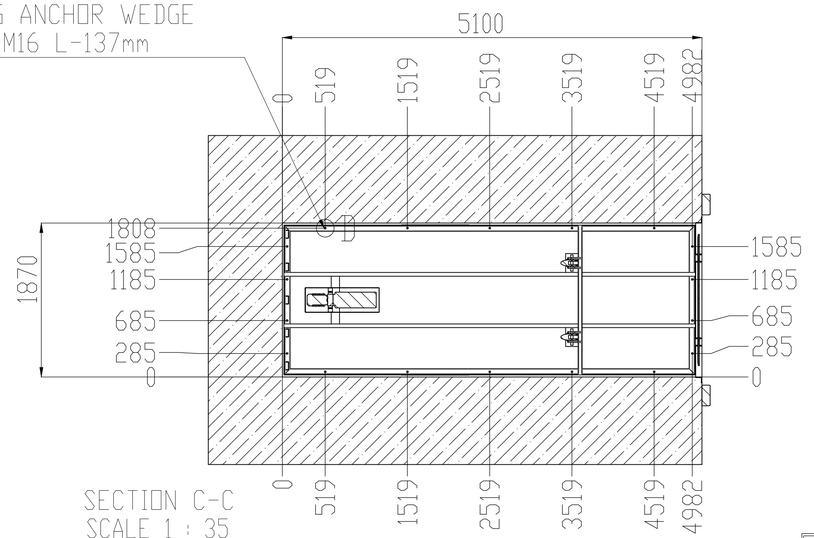

SECTION C-C
SCALE 1 : 35

Please update the below as Product Description.

PROJECT DESCRIPTION -
1. DOCK LEVELER - PIT MOUNTED ELECTRO-HYDRAULIC TYPE
2. CAPACITY- 6 TON POINT LOAD
3. QTY- 2 NOS
4. PRODUCT SIZE- 5100mm(L)X1820mm(W)X600mm(D)
5. PIT SIZE-5100mm(L)X1870mm(W)X600mm(D)

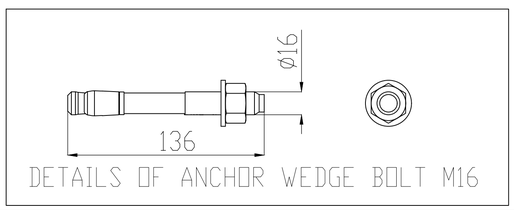

DETAILS OF ANCHOR WEDGE BOLT M16



DETAIL D
SCALE 2 : 35

EIL Comments:
1. Include a sheet showing both dock levellers together for clarity w.r.t. relative location.
2. Tabulate BOM for one no. dock leveller.
3. "Client" wherever mentioned in the drawing shall be replaced by "LTHE".
4. Other comments as marked.

List here "GAD for Dock Leveller (504-LZ-930A/B)"

DRAWING NO.	DRAWING TITLE	REV

REFERENCE DOCUMENTS / DRAWINGS

DRG. CATEGORY: (USE TICK MARK) — R ☑
EIL REVIEW/APPROVAL — VPTL NO.:
SCH. DATE OF SUBMISSION — CODE:

DOCUMENT STATUS
STATEMENT OF SUB: 1st 2nd 3rd
☐ FINAL FOR CODE-1 ☐ AS BUILT

ISSUED FOR
☐ AS BUILT ☐ CONSTRUCTION ☑ INFORMATION ☐ REVIEW

SIGN: DATE:

☐ REVIEW CODE 1 – NO COMMENTS PROCEED WITH MANUFACTURE / FABRICATION/ CONSTRUCTION AS PER THE DOCUMENT.
☐ REVIEW CODE 2 – PROCEED WITH MANUFACTURE / FABRICATION / CONSTRUCTION AS PER THE COMMENTED DOCUMENT. REVISED DOCUMENT REQUIRED.
☐ REVIEW CODE 3 – DOCUMENT DOES NOT CONFORM TO BASIC REQUIREMENTS AS MARKED. RESUBMIT FOR REVIEW.
☐ R – DOCUMENT IS RETAINED FOR RECORDS. PROCEED WITH MANUFACTURE / FABRICATION
☐ V-VOID

NAME DICIPLINE SIGN, DATE

REV.	DESCRIPTION	DRN	CHECKED	APPROVED	REVIEWED	APPROVED	DATE
00	ISSUED FOR APPROVAL	SMS	VJ	AK			

OWNER: Indian Oil — HINDUSTAN PETROLEUM CORPORATION LIMITED
VISAKH REFINERY MODERNIZATION PROJECT
EPCC-03 PACKAGE FOR RESIDUE UP-GRADATION FACILITY (RUF)

PMC: ENGINEERS INDIA LIMITED (A Govt. of India Undertaking)

LSTK CONTRACTOR: L&T Hydrocarbon Engineering

DETAILED ENGINEERING CENTER: L&T - CHIYODA LIMITED

VENDOR: NIHVA TECHNOLOGIES PVT LTD
VENDOR PO NO: REFINARY/75000-82256/VMM
VENDOR DWG. NO: NIHVA_20-21_0158

DATE: 31.05.21 | SCALE: 1:1
TITLE: CIVIL DRAWING FOR DOCK LEVELER (504-LZ-930A/B)
DEPT: DESIGN
DRN BY: SMS
CHK BY: VJ
APP BY: AK
PROJECT: L&T-RUF
PWO NO.:
DRG. NO.: B016-RUF-LT-504-MP-DW-NTPL(1)-13005
SH.: 1 OF 2
REV.: 00
CAD REVISE THIS DRG. USING CAD SYSTEM ONLY FILE:

L&T - CHIYODA LIMITED


☐ REVIEW CODE 1 – NO COMMENTS PROCEED WITH MANUFACTURE / FABRICATION/ CONSTRUCTION AS PER THE DOCUMENT.
☐ REVIEW CODE 2 – PROCEED WITH MANUFACTURE/ FABRICATION /CONSTRUCTION AS PER THE COMMENTED DOCUMENT. REVISED DOCUMENT REQUIRED.
☐ REVIEW CODE 3 – DOCUMENT DOES NOT CONFORM TO BASIC REQUIREMENTS AS MARKED. RESUBMIT FOR REVIEW.
☐ R – DOCUMENT IS RETAINED FOR RECORDS. PROCEED WITH MANUFACTURE / FABRICATION
☐ V-VOID

COMMENTED BY	REVIEWED BY	APPROVED BY	DATE


THIS REVIEW / APPROVAL DOES NOT RELIEVE THE VENDOR / MANUFACTURER OF THE FULL RESPONSIBILITY AS TO DESIGN CORRECTNESS OF DIMENSIONS & COMPLIANCE WITHALL APPLICABLE REGULATIONS AND WITH THE REQUIREMENTS MADE IN PURCHASER SPECIFICATIONS.

DOCUMENT REVIEW DETAILS
1 No Comments.
2 Proceed with manufacture / fabrication as per the commented document. Revised document required.
3 Document does not conform to basic requirements as marked. Resubmit for review.
R Retained for Records. V Void.
Doc. B016-RUF-LT-504-MP-DW-NTPL(1)-13005 Rev. 00
Signature with Date: 03-SEP-2021
Name of Reviewer: AJEET KUMAR (B565)
Page No.: 8 of 9


DWG. NO.

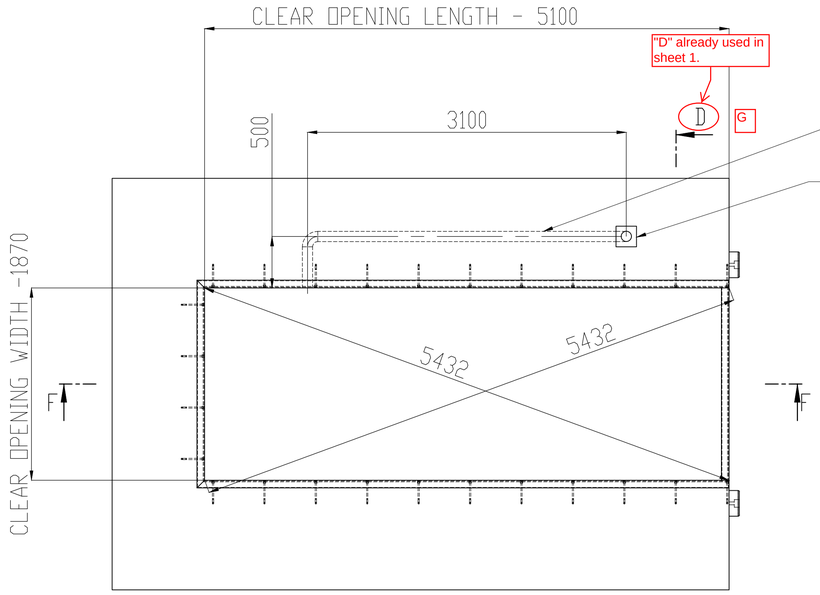


TOP VIEW OF DOCK PIT

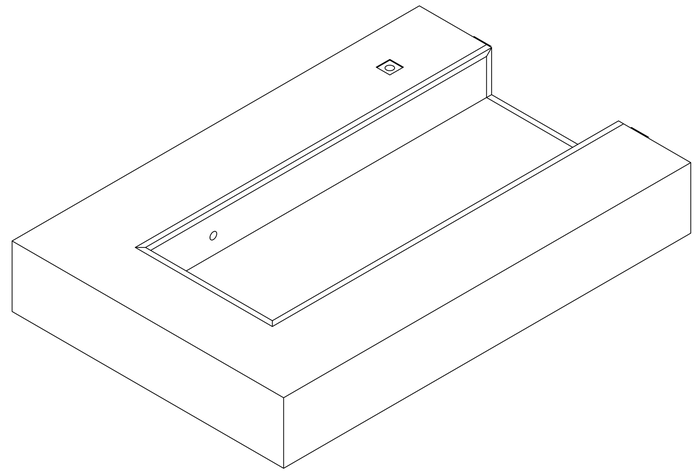


ISOMETRIC VIEW OF DOCK LEVELER PIT

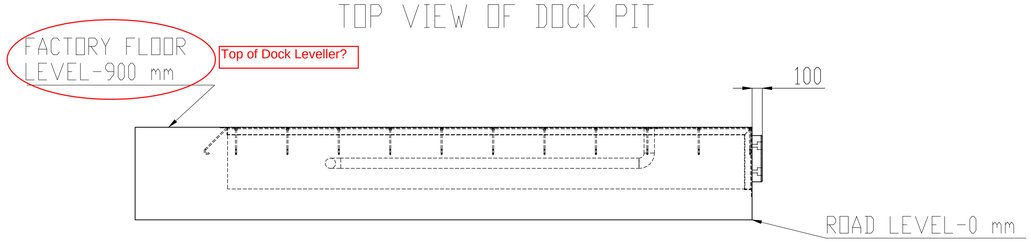


FRONT VIEW OF DOCK PIT

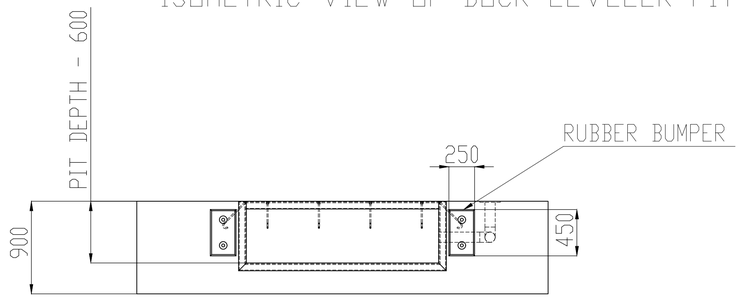


SIDE VIEW OF DOCK PIT

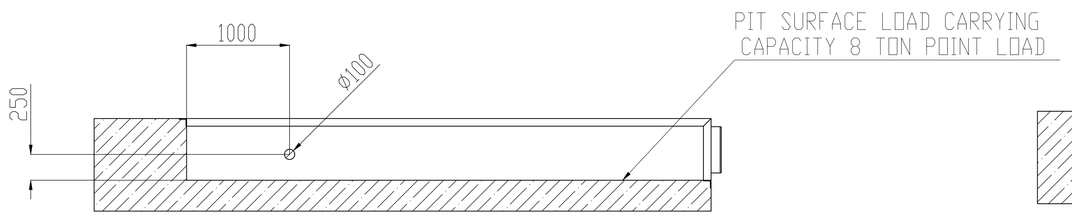

SECTION F-F
SCALE 1 : 28

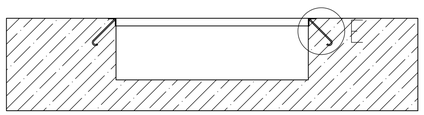

SECTION ~~D-D~~ G-G
SCALE 1 : 28

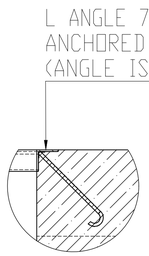

DETAIL E
SCALE 1 : 10

NOTES -

1. PIT & ALL CIVIL WORK IS ~~CLIENT~~ LTHE SCOPE .
2. AT ALL EDGES OF PIT ANGLE 75X6 MM THK(ANGLE IN CLIENT SCOPE) TO BE ANCHORED IN CONCRETE .
3. PIT SURFACE SHOULD BE PLAIN & LOAD CARRYING CAPACITY FOR PIT SURFACE SHOULB OF 8 TON POINT LOAD .
4. MINIMUM 4 INCH DUCT DUCT TO BE PROVIDED FROM CONTROL PANEL TO PIT OPENING BY CLIENT FOR ELECTRICAL CABLE ROUTING . REQUIRED DUCT IS IN CLIENT SCOPE.
5. CONTROL PANEL IS PROVIDED WITH ELECTRICAL CABLE LENGTH OF 5 METER AS STANDARD . CONTROL PANEL SHOULD BE LOCATED NEAR DOCK LEVELER FOR EASY VIEW OF LIP RESTING ON VEHICLE .

EIL Comments:
1. Refer comments marked on sheet 1 of 2.
2. Other comments as marked.

List here "GAD for Dock Leveller (504-LZ-930A/B)"

DRAWING NO.	DRAWING TITLE	REV

REFERENCE DOCUMENTS / DRAWINGS

DRG. CATEGORY: (USE TICK MARK) [R] [1]
EIL REVIEW/APPROVAL CODE:
VPTL NO.:
SCH. DATE OF SUBMISSION
DOCUMENT STATUS
STATEMENT OF SUB: [1st] [2nd] [3rd]
☐ FINAL FOR CODE-1 ☐ AS BUILT
ISSUED FOR
☐ AS BUILT ☐ INFORMATION
☐ CONSTRUCTION ☐ REVIEW
SIGN: DATE:

☐ REVIEW CODE 1 – NO COMMENTS PROCEED WITH MANUFACTURE / FABRICATION/ CONSTRUCTION AS PER THE DOCUMENT.
☐ REVIEW CODE 2 – PROCEED WITH MANUFACTURE / FABRICATION / CONSTRUCTION AS PER THE COMMENTED DOCUMENT. REVISED DOCUMENT REQUIRED.
☐ REVIEW CODE 3 – DOCUMENT DOES NOT CONFORM TO BASIC REQUIREMENTS AS MARKED. RESUBMIT FOR REVIEW.
☐ R – DOCUMENT IS RETAINED FOR RECORDS. PROCEED WITH MANUFACTURE / FABRICATION
☐ V–VOID

	NAME	DICIPLINE	SIGN.	DATE

REV.	DESCRIPTION	DRN	CHECKED	APPROVED	REVIEWED	APPROVED	DATE
00	ISSUED FOR APPROVAL	SMS	VJ	AK			

OWNER: HINDUSTAN PETROLEUM CORPORATION LIMITED
VISAKH REFINERY MODERNIZATION PROJECT
EPCC-03 PACKAGE FOR RESIDUE UP-GRADATION FACILITY (RUF)

PMC : इंजीनियर्स इंडिया लिमिटेड (भारत सरकार का उपक्रम) ENGINEERS INDIA LIMITED (A Govt. of India Undertaking)

LSTK CONTRACTOR: L&T Hydrocarbon Engineering

DETAILED ENGINEERING CENTER: L&T - CHIYODA LIMITED

VENDOR : NIHVA TECHNOLOGIES PVT LTD
VENDOR PO NO: REFINARY/75000-82256/VMM
VENDOR DWG. NO: NIHVA_20-21_0158

DATE 29.5.21 | SCALE 1:1 | TITLE: CIVIL DRAWING FOR DOCK LEVELER
DEPT: DESIGN
DRN BY: SMS | PROJECT: L&T-RUF | DRG. NO.: B016-RUF-LT-504-MP-DW-NTPL(1)-13005 | SH. 2 OF 2
CHK BY: VJ | PWO NO.: (504-LZ-930A/B) | REV. 00
APP BY: AK | CAD #DRG THIS DRG. USING CAD SYSTEM ONLY | FILE:

L&T - CHIYODA LIMITED

☐ REVIEW CODE 1 – NO COMMENTS PROCEED WITH MANUFACTURE / FABRICATION/ CONSTRUCTION AS PER THE DOCUMENT.
☐ REVIEW CODE 2 – PROCEED WITH MANUFACTURE/ FABRICATION /CONSTRUCTION AS PER THE COMMENTED DOCUMENT. REVISED DOCUMENT REQUIRED.
☐ REVIEW CODE 3 – DOCUMENT DOES NOT CONFORM TO BASIC REQUIREMENTS AS MARKED. RESUBMIT FOR REVIEW.
☐ R – DOCUMENT IS RETAINED FOR RECORDS. PROCEED WITH MANUFACTURE / FABRICATION
☐ V–VOID

COMMENTED BY	REVIEWED BY	APPROVED BY	DATE

THIS REVIEW / APPROVAL DOES NOT RELIEVE THE VENDOR / MANUFACTURER OF THE FULL RESPONSIBILITY AS TO DESIGN CORRECTNESS OF DIMENSIONS & COMPLIANCE WITHALL APPLICABLE REGULATIONS AND WITH THE REQUIREMENTS MADE IN PURCHASER SPECIFICATIONS.

DOCUMENT REVIEW DETAILS

1 No Comments. Doc. B016-RUF-LT-504-MP-DW-NTPL(1)-13005 Rev. 00
2 Proceed with manufacture / fabrication as per the commented document. Revised document required.
3 Document does not conform to basic requirements as marked. Resubmit for review.
R Retained for Records. V Void.

Signature with Date: 03-SEP-2021
Name of Reviewer AJEET KUMAR (B565)
Page No. 9 of 9

ALL RIGHTS RESERVED
THIS DOCUMENT AND ANY DATA AND INFORMATION CONTAINED THEREIN ARE CONFIDENTIAL AND THE PROPERTY OF L&T HYDROCARBON ENGINEERING LTD.(LTHE) AND THE COPYRIGHT THEREIN IS VESTED IN LTHE. NO PART OF THIS DOCUMENT OR ANY DATA AND INFORMATION CONTAINED THEREIN IS TO BE REPRODUCED, DISCLOSED, TRANSMITTED, STORED IN A RETRIEVAL SYSTEM OR USED FOR ANY PURPOSE WHATSOEVER, EXCEPT WITH THE PRIOR WRITTEN PERMISSION OF LTHE.