



NORTH SIDE ELEVATION

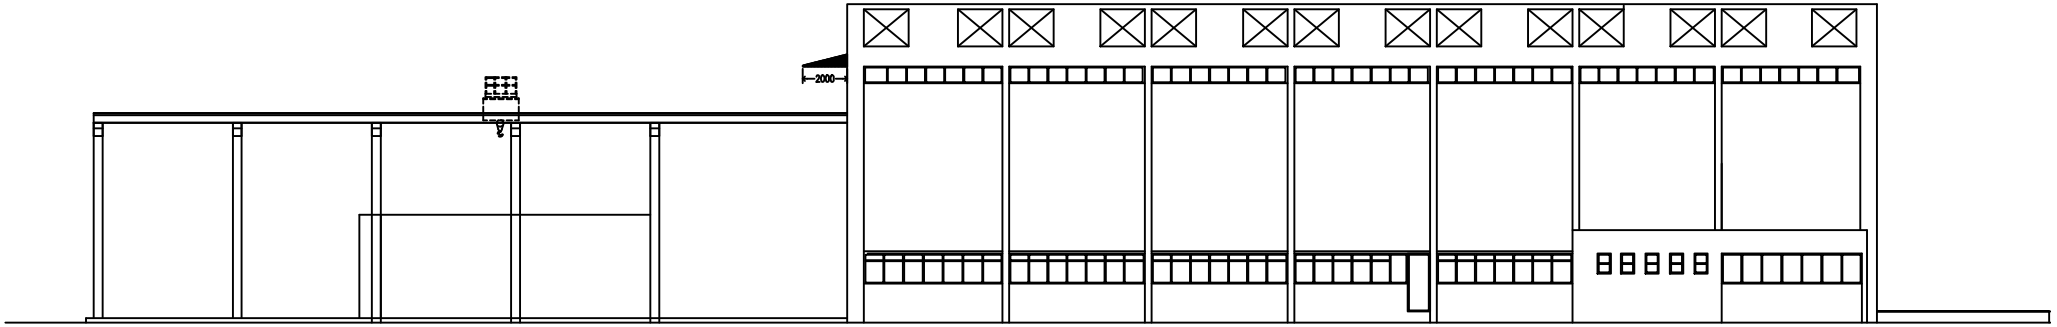

SOUTH SIDE ELEVATION

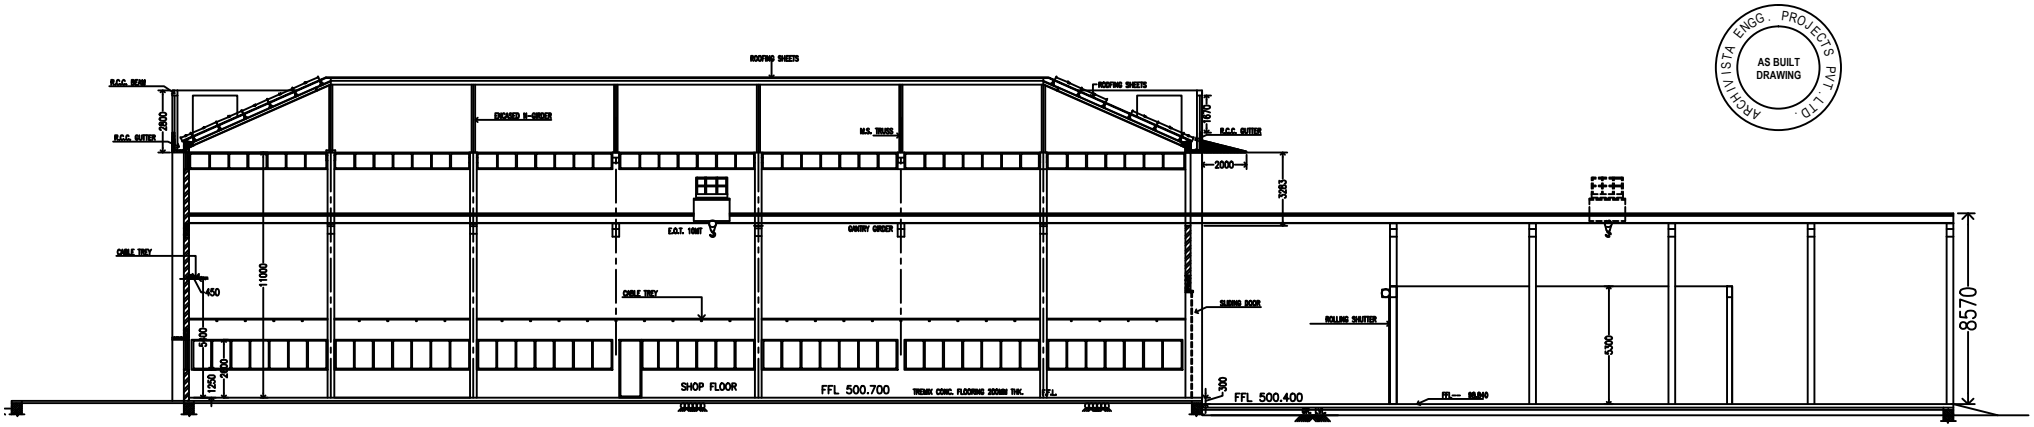

SECTION A-A

ARCHIVISTA ENGG. PROJECTS PVT. LTD.
AS BUILT DRAWING