DRG. NO.

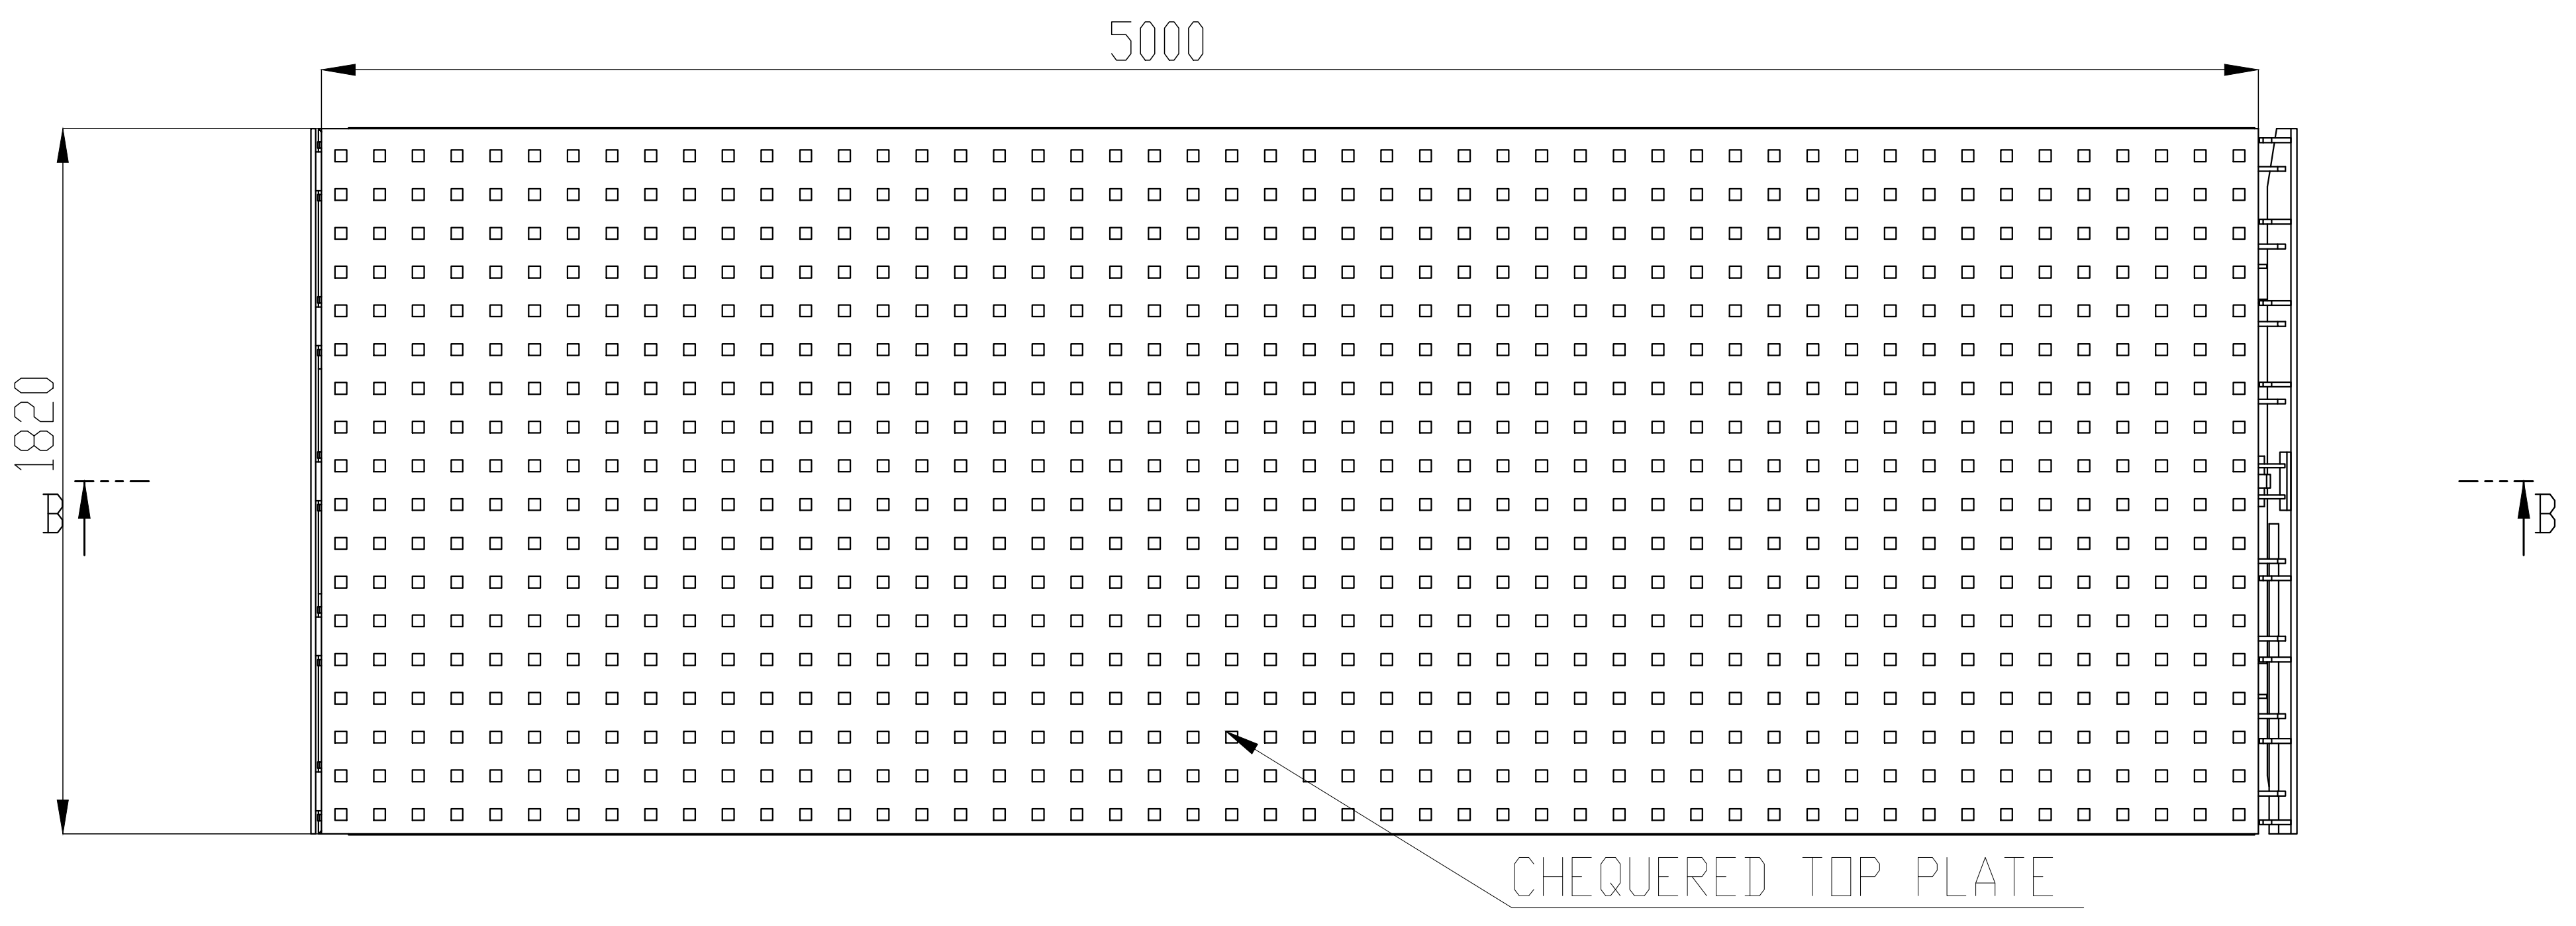

DOCK LEVELER TOP VIEW

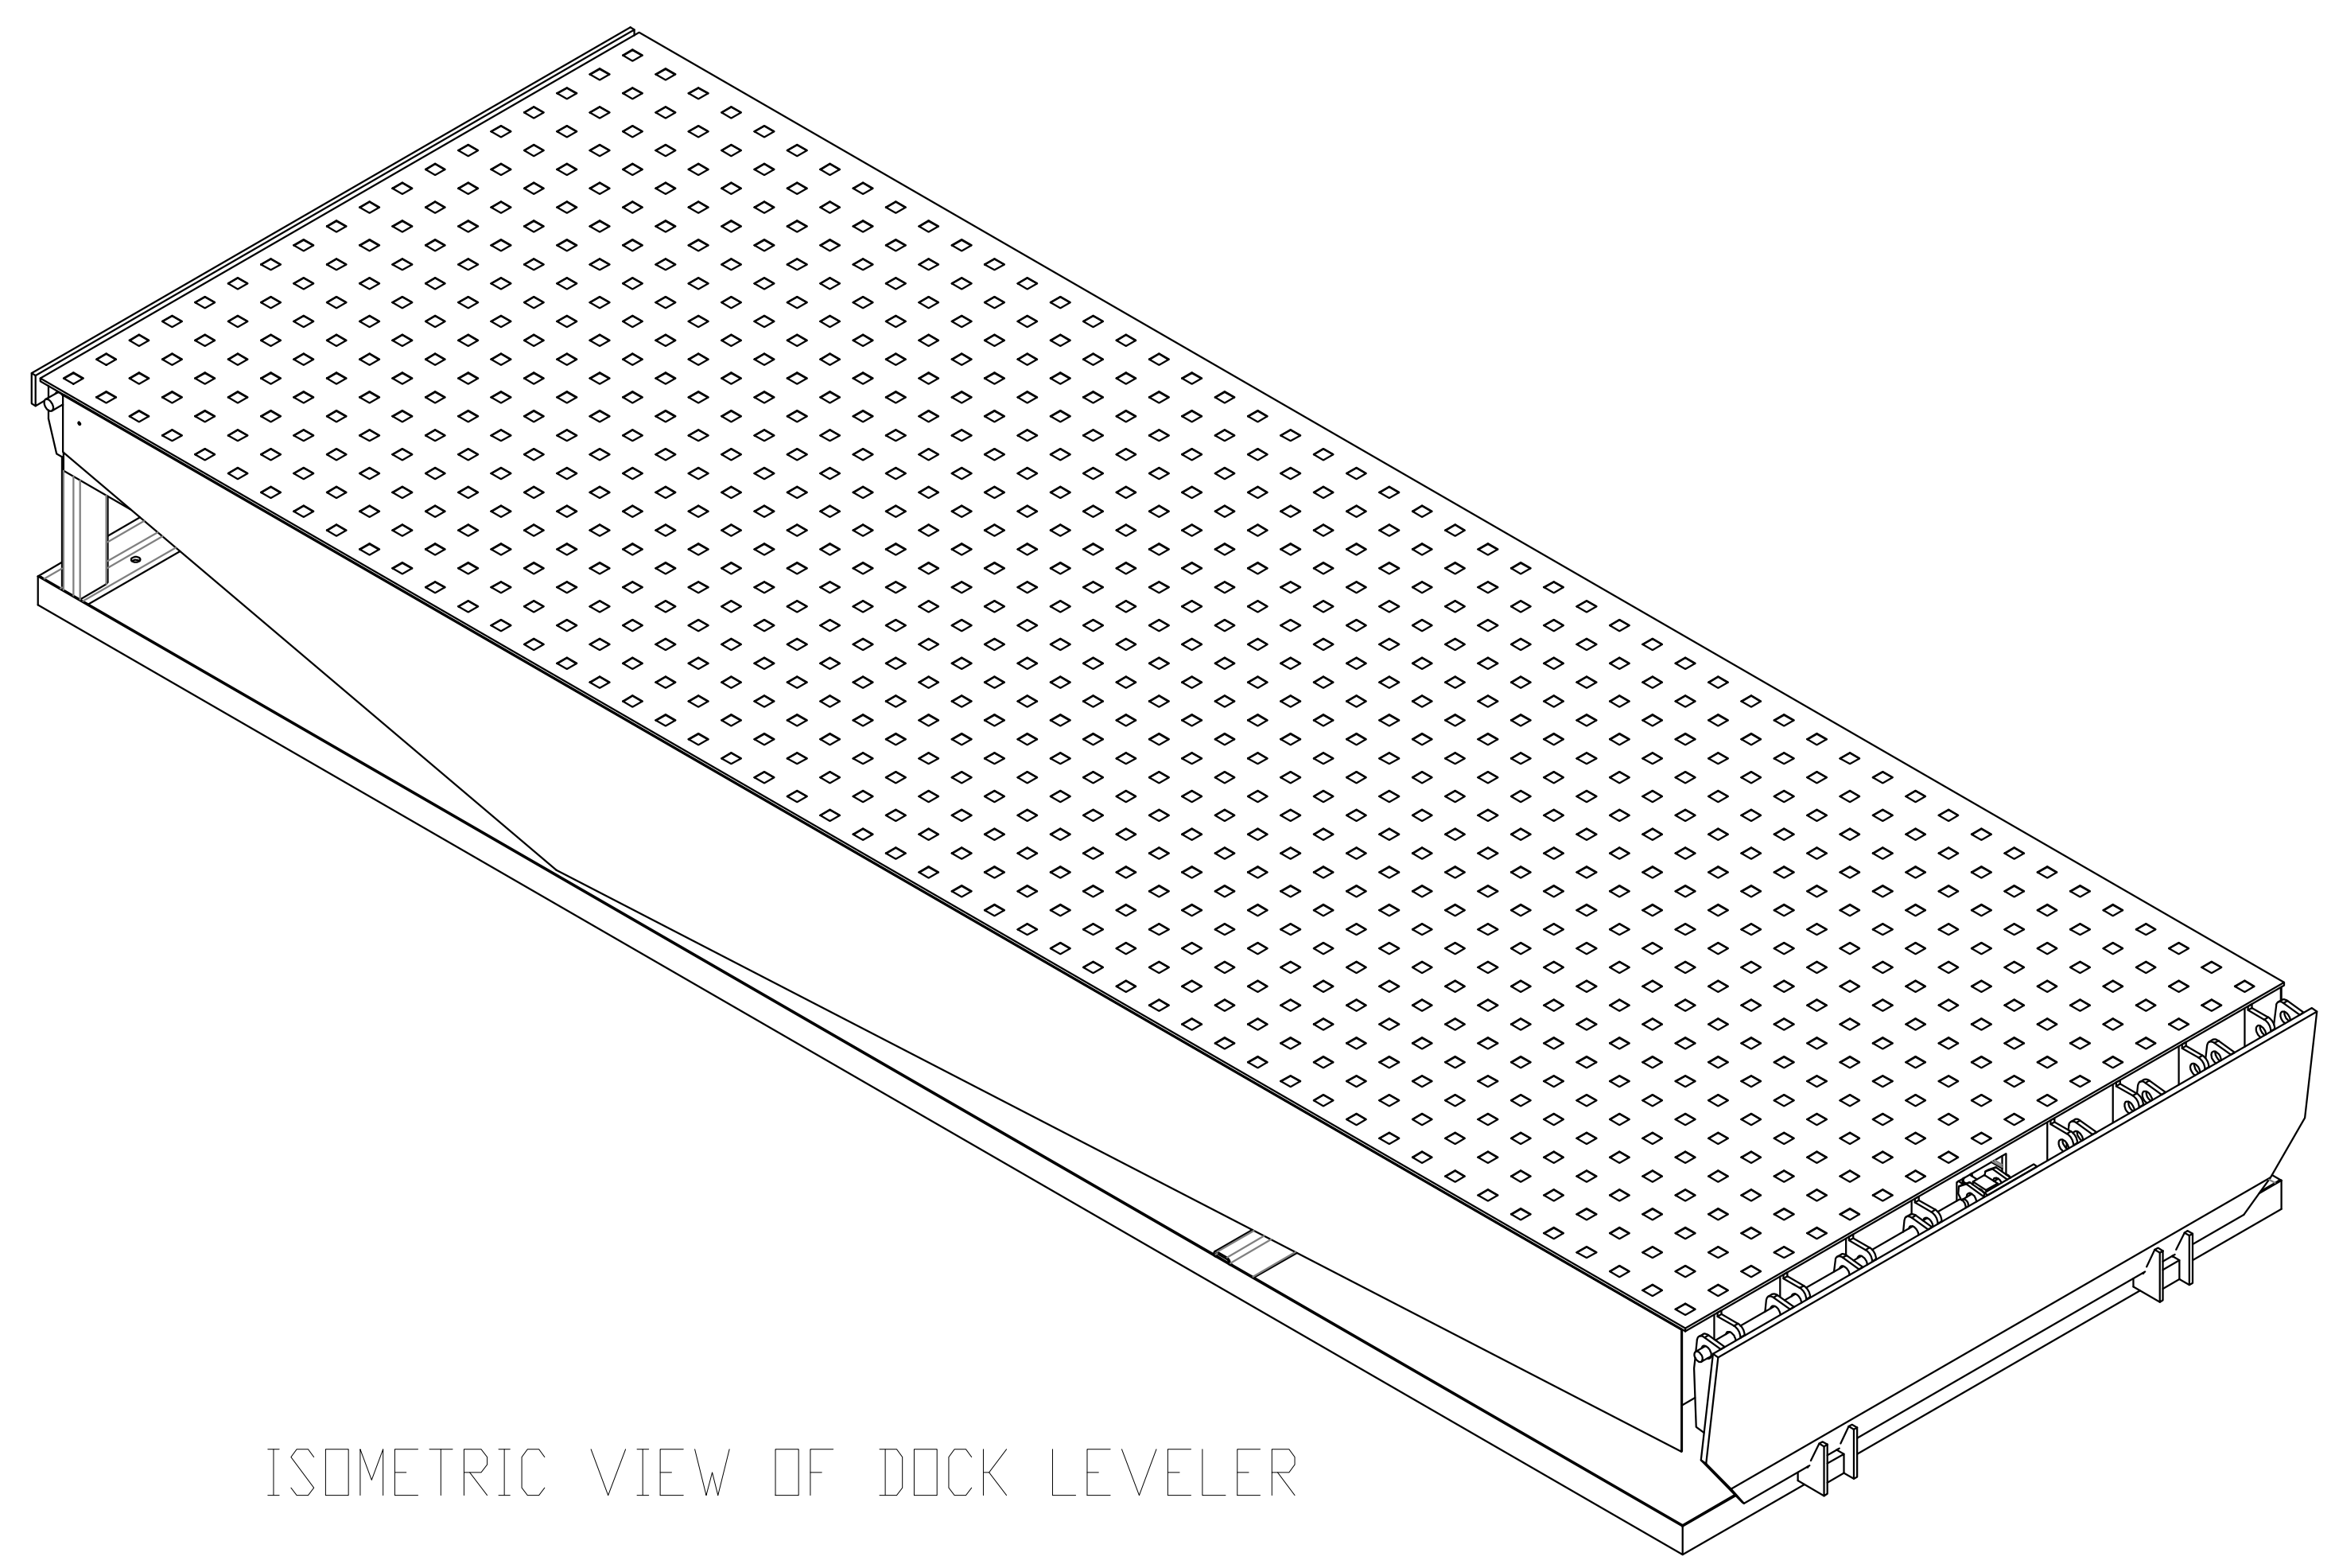

ISOMETRIC VIEW OF DOCK LEVELER

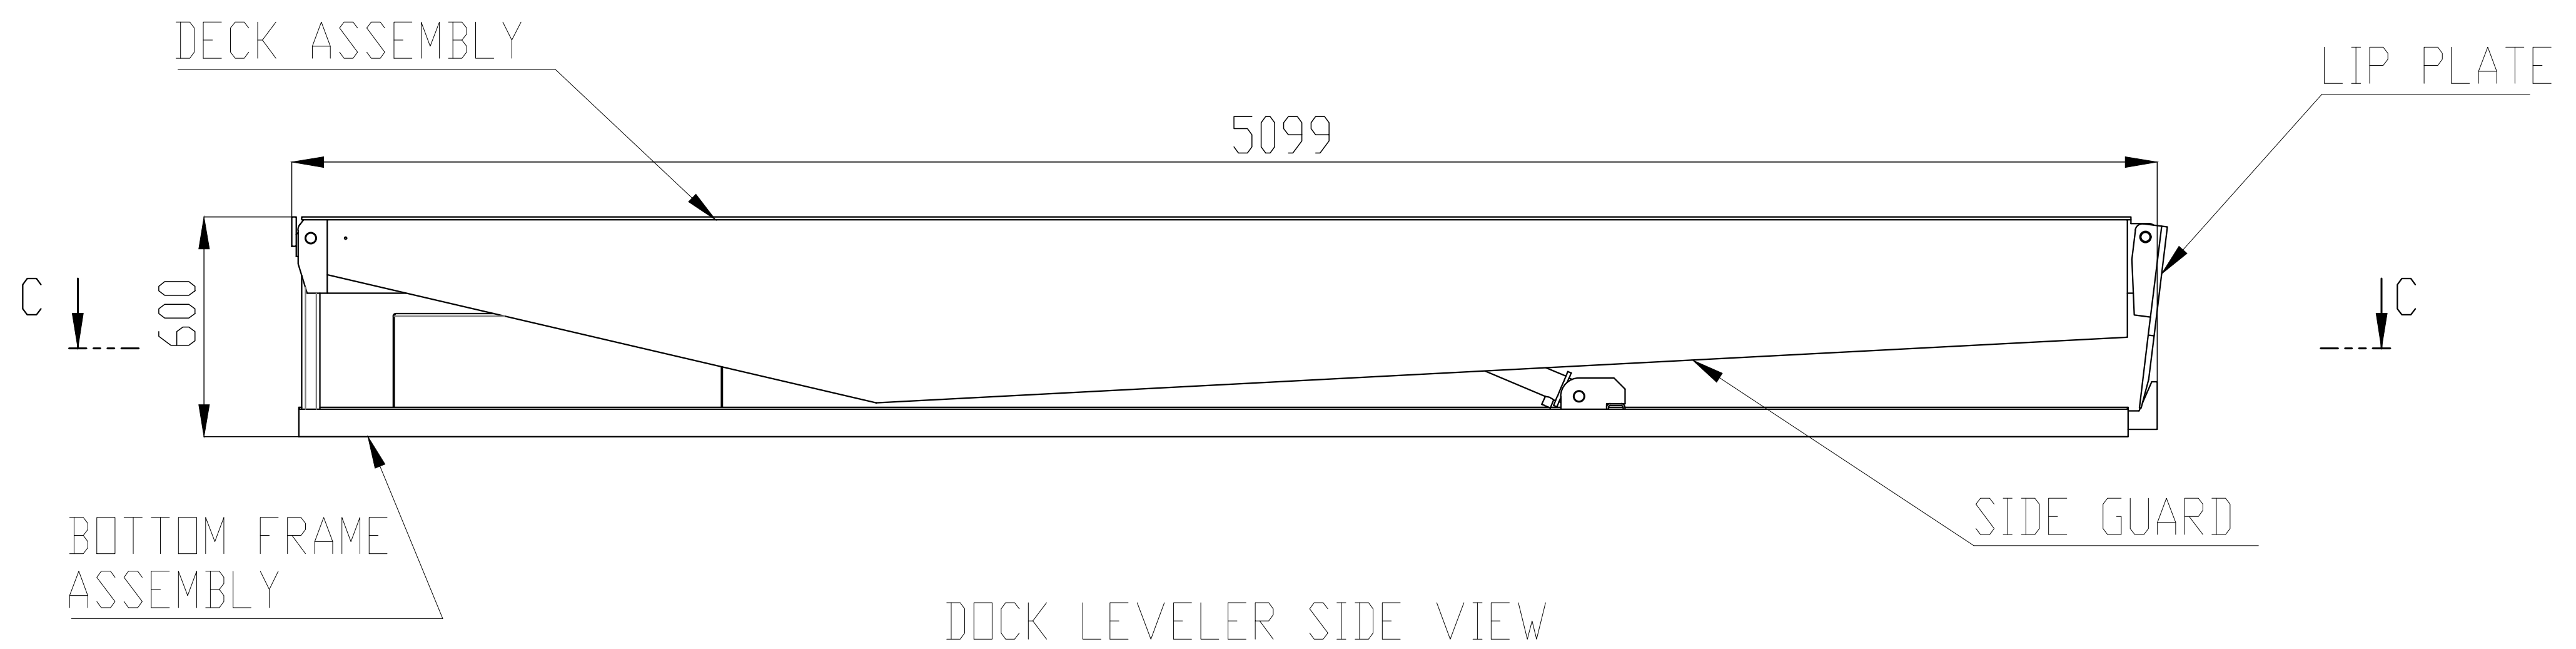

DOCK LEVELER SIDE VIEW

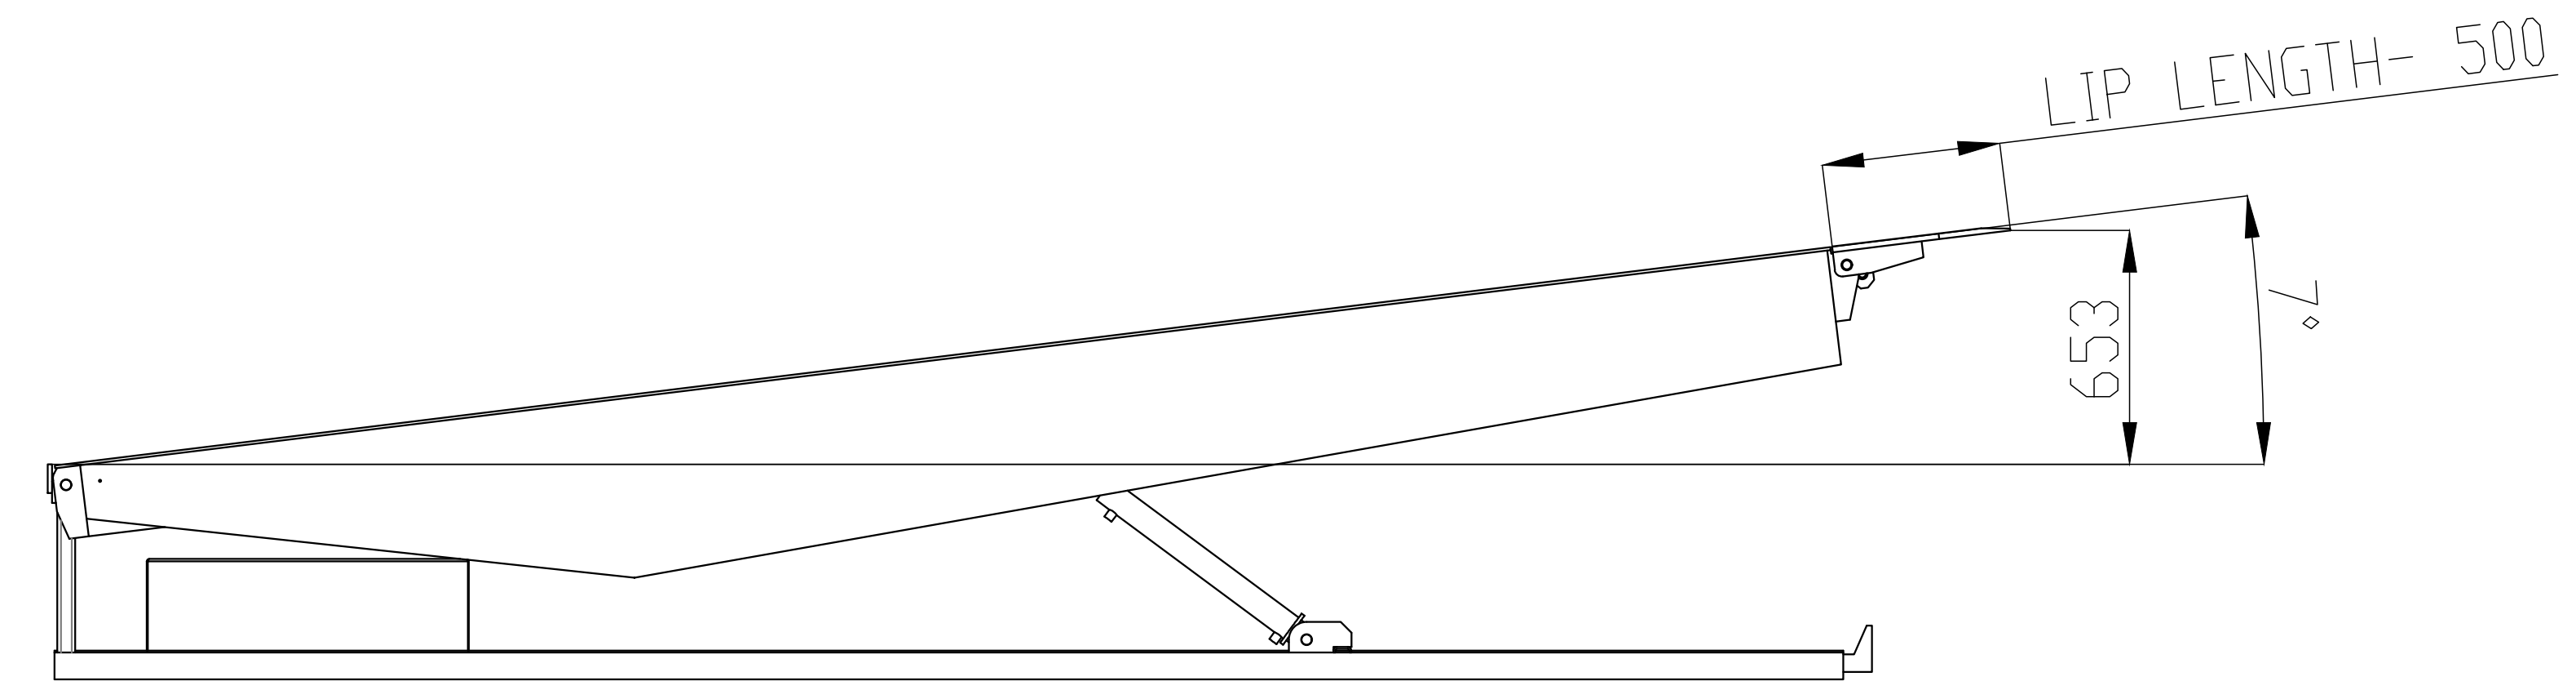

DECK UP HEIGHT - 600 MM

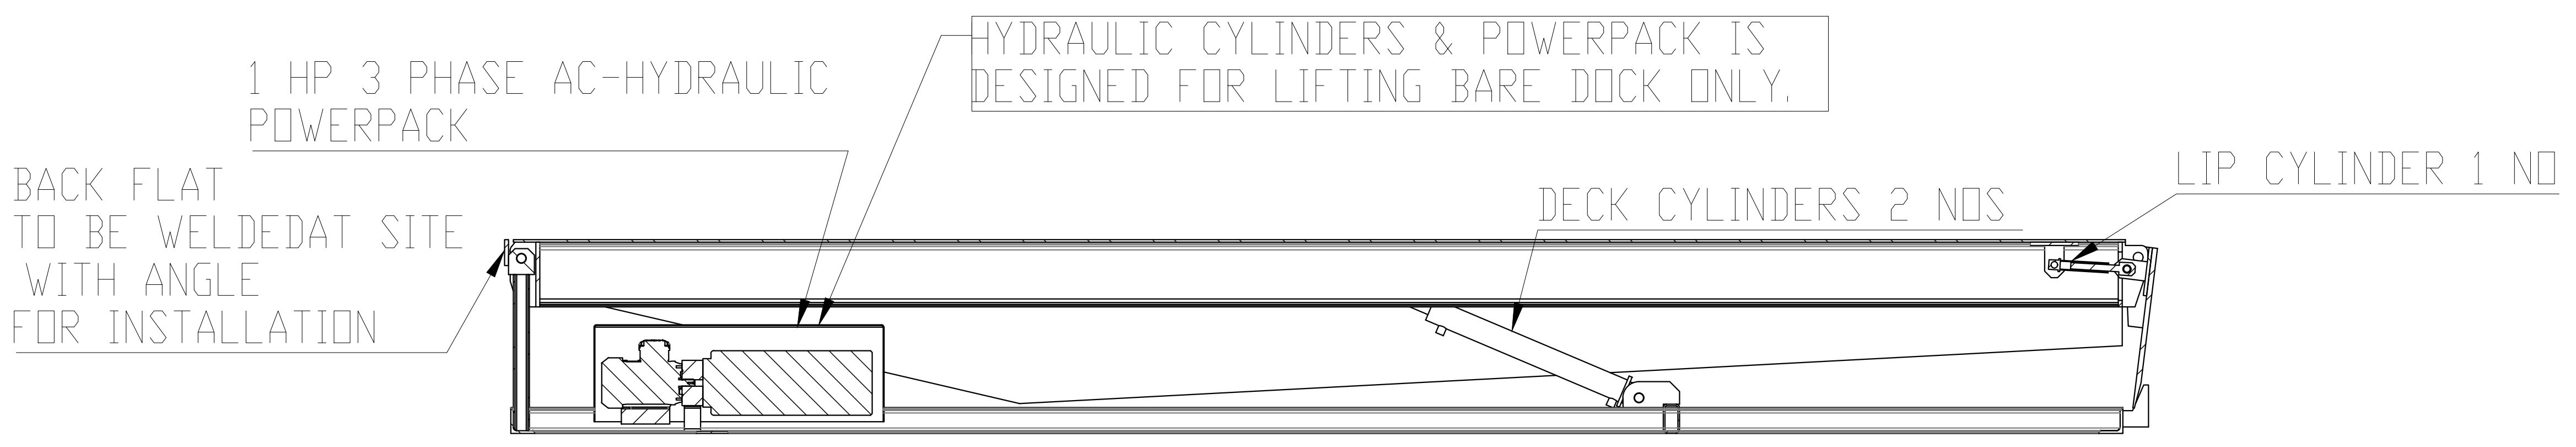
1 HP 3 PHASE AC-HYDRAULIC POWERPACK
HYDRAULIC CYLINDERS & POWERPACK IS DESIGNED FOR LIFTING BARE DOCK ONLY.
BACK FLAT TO BE WELDEDAT SITE WITH ANGLE FOR INSTALLATION
DECK CYLINDERS 2 NOS
LIP CYLINDER 1 NO

SECTION B-B
SCALE 1 : 15

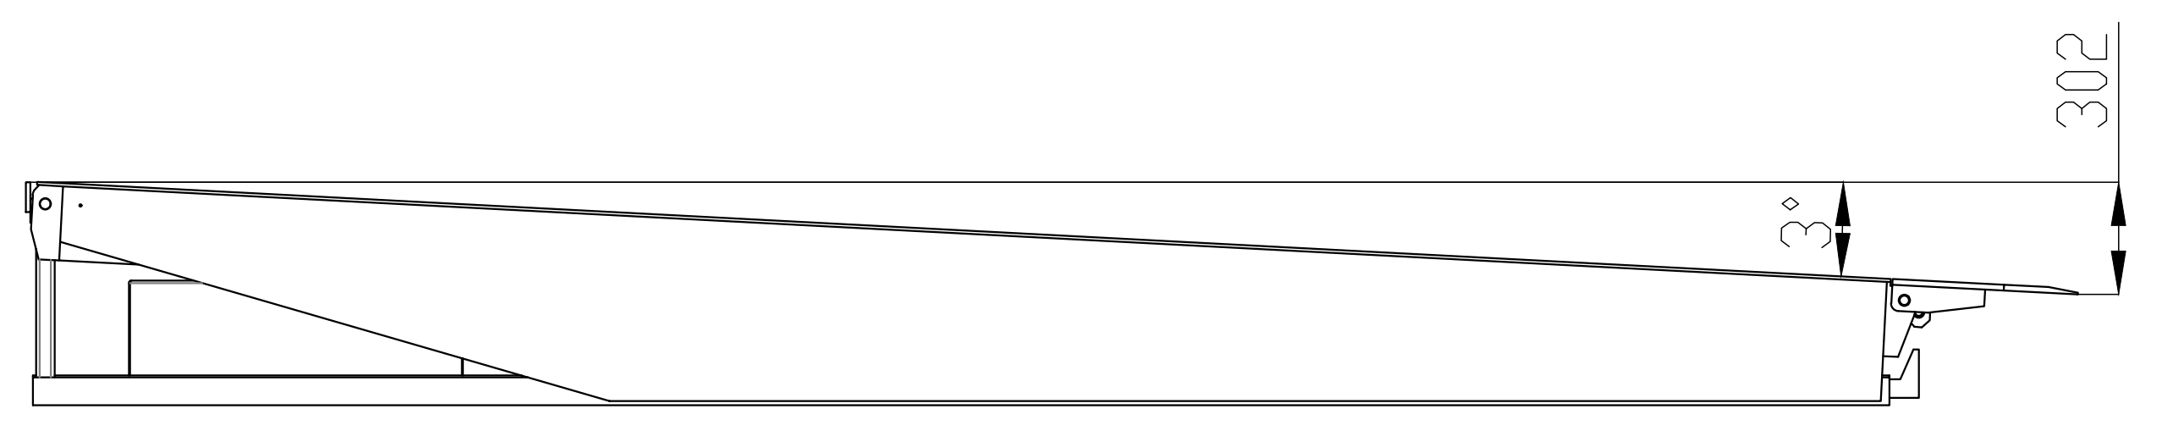

DECK DOWN HEIGHT - 300 MM

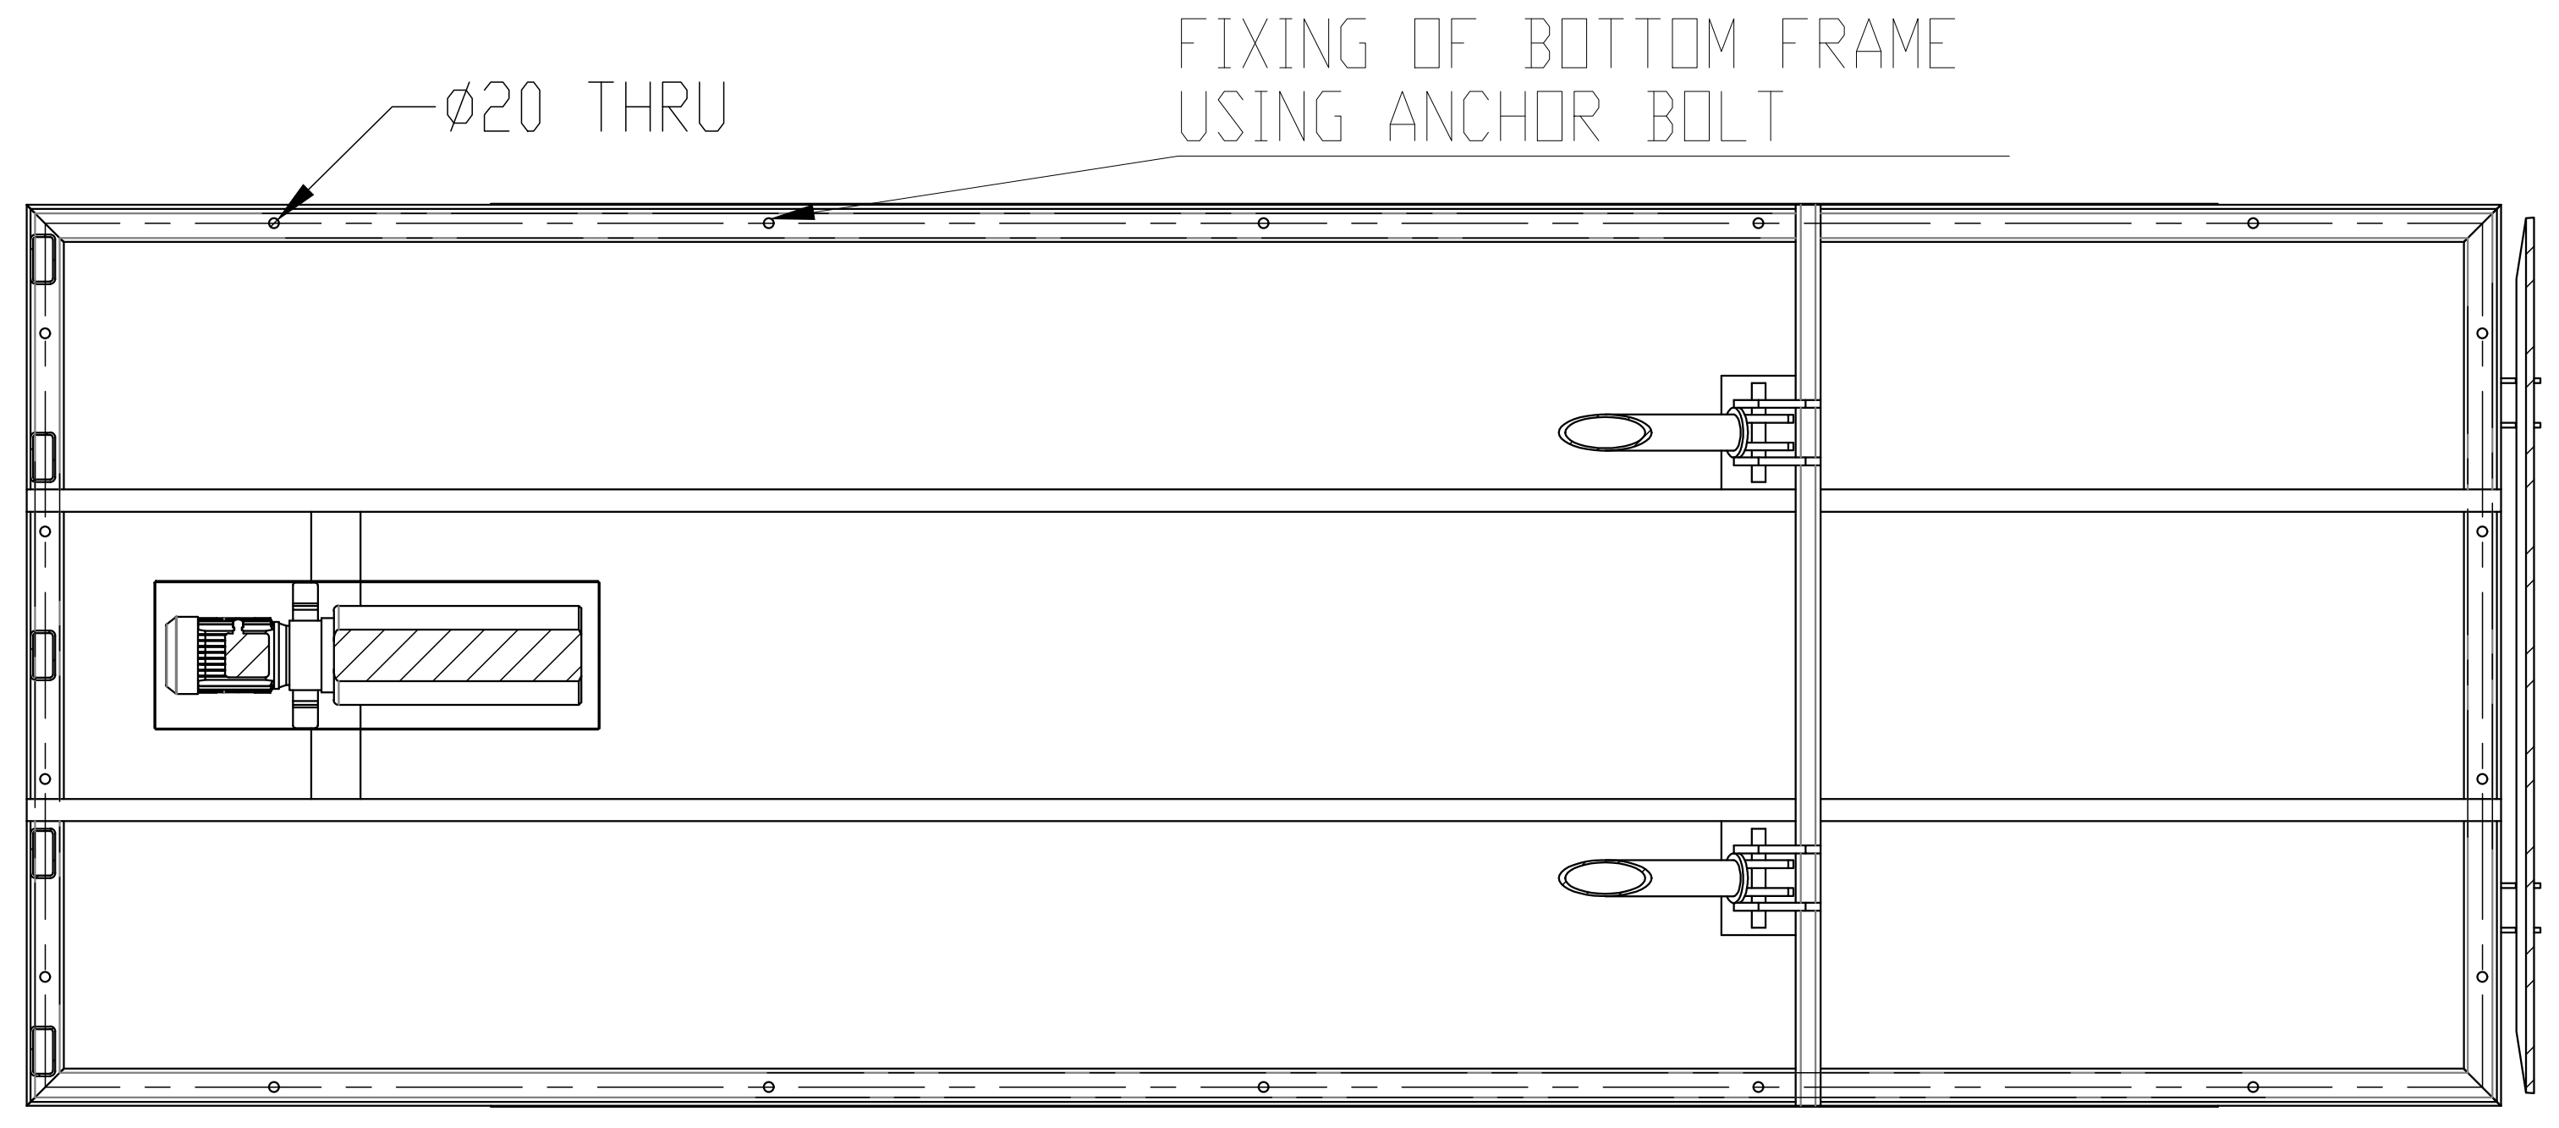

SECTION C-C
SCALE 1 : 15

TECHNICAL SPECIFICATIONS OF PIT MOUNTED ELECRO-HYDRAULIC DOCK LEVELER -

1. SIZE OF DOCK LEVELER - 1820mm(W) X 5000mm(W)
2. OVERALL SIZE OF PRODUCT - 1820mm(W)X5100mm(L)X600mm(H)
3. CAPACITY - 6 TON POINT LOAD
4. LIP PLATE SIZE - 500mm(L)X1820mm(W)
5. DECK PLATE - CHEQUERED SHEET 1820mm(W)x5000mm(L)
6. DECK & LIP UP-DOWN OPERATION BY HYDRAULIC CYLINDER
7. DECK UP HEIGHT (+)-600 MM
8. DECK DOWN HEIGHT (-)-300MM
9. HEIGHT OF DOCK LEVELER FROM ROAD LEVEL- 900 mm , RECOMMENDED HEIGHT - 1200 MM
10. OPERATION CONTROL BY PUSH BUTTONS ON CONTROL PANEL MOUNTED ON STAND NEAR DOCK LEVELER
11. ELECTRICAL SUPPLY OF EQUIPMENT - 415 VOLT 3 PHASE AC , 50HZ
12. PAINT - FIROZI BLUE
13. MATERIAL OF CONSTRUCTION - MILD STEEL AS PER IS STANDARD
14. MANUFACTURING STANDARD OF DOCK LEVELER -EN1398
15. ELECTRICAL MOTOR & ELECTRICAL COMPONENT SUTAIBLE FOR HAZARDOUS AREA
16. PIT SIZE - 1870 mm(W)X5100mm(L)x600 mm(D)
17. DOCK LEVELER FIXING IN PIT BY ANCHOR BOLT .
18. REQUIRED PIT & ALL CIVIL WORK FOR MOUNTING OD DOCK LEVELER IS IN CLIENT SCOPE .
REFER PIT DRAWING FOR CONSTRUCTION OF PIT .

ALL RIGHTS RESERVED
THIS DOCUMENT AND ANY DATA AND INFORMATION CONTAINED THEREIN ARE CONFIDENTIAL AND THE PROPERTY OF L&T HYDROCARBON ENGINEERING (LTHE) AND THE COPYRIGHT THEREIN IS VESTED IN LTHE NO PART OF THIS DOCUMENT, DATA, OR INFORMATION SHALL BE DISCLOSED TO OTHERS OR REPRODUCED IN ANY MANNER OR USED FOR ANY PURPOSE WHATSOEVER, EXCEPT WITH THE PRIOR WRITTEN PERMISSION OF LTHE.

L&T - CHIYODA LIMITED

☐ REVIEW CODE 1 – NO COMMENTS PROCEED WITH MANUFACTURE / FABRICATION/ CONSTRUCTION AS PER THE DOCUMENT.
☐ REVIEW CODE 2 – PROCEED WITH MANUFACTURE/ FABRICATION /CONSTRUCTION AS PER THE COMMENTED DOCUMENT. REVISED DOCUMENT REQUIRED.
☐ REVIEW CODE 3 – DOCUMENT DOES NOT CONFORM TO BASIC REQUIREMENTS AS MARKED. RESUBMIT FOR REVIEW.
☐ R – DOCUMENT IS RETAINED FOR RECORDS. PROCEED WITH MANUFACTURE / FABRICATION
☐ V–VOID

COMMENTED BY	REVIEWED BY	APPROVED BY	DATE

THIS REVIEW / APPROVAL DOES NOT RELIEVE THE VENDOR / MANUFACTURER OF THE FULL RESPONSIBILITY AS TO DESIGN CORRECTNESS OF DIMENSIONS & COMPLIANCE WITHALL APPLICABLE REGULATIONS AND WITH THE REQUIREMENTS MADE IN PURCHASER SPECIFICATIONS.

DRAWING NO.	DRAWING TITLE	REV
NIHVA/20-21/0157	DOCK LEVELER – 6 TON	R00

REFERENCE DOCUMENTS / DRAWINGS ✓

DRG. CATEGORY: (USE TICK MARK) R I
SCH. DATE OF SUBMISSION
EIL REVIEW/APPROVAL CODE:
VPTL NO.:

DOCUMENT STATUS
STATEMENT OF SUB: 1st 2nd 3rd
☐ FINAL FOR CODE–1 ☑ AS BUILT

ISSUED FOR
☐ AS BUILT ☐ INFORMATION
☐ CONSTRUCTION ☐ REVIEW

SIGN: DATE:

☐ REVIEW CODE 1 – NO COMMENTS PROCEED WITH MANUFACTURE / FABRICATION/ CONSTRUCTION AS PER THE DOCUMENT.
☐ REVIEW CODE 2 – PROCEED WITH MANUFACTURE / FABRICATION / CONSTRUCTION AS PER THE COMMENTED DOCUMENT. REVISED DOCUMENT REQUIRED
☐ REVIEW CODE 3 – DOCUMENT DOES NOT CONFORM TO BASIC REQUIREMENTS AS MARKED. RESUBMIT FOR REVIEW.
☐ R – DOCUMENT IS RETAINED FOR RECORDS. PROCEED WITH MANUFACTURE / FABRICATION
☐ V–VOID
NAME DICIPLINE SIGN. DATE

REV.	DESCRIPTION	DRN	CHECKED	APPROVED	REVIEWED	APPROVED	DATE
00	ISSUED FOR APPROVAL	SMS	VJ	AK	XXX	XXX	XX.XX.XX

OWNER HINDUSTAN PETROLEUM CORPORATION LIMITED
VISAKH REFINERY MODERNIZATION PROJECT
EPCC–03 PACKAGE FOR RESIDUE UP–GRADATION FACILITY (RUF)

PMC : इंजीनियर्स इंडिया लिमिटेड (भारत सरकार का उपक्रम) ENGINEERS INDIA LIMITED (A Govt. of India Undertaking)

LSTK CONTRACTOR: L&T Hydrocarbon Engineering

DETAILED ENGINEERING CENTER: L&T - CHIYODA LIMITED

VENDOR : NIHVA TECHNOLOGIES PVT LTD
VENDOR PO NO:
VENDOR DWG. NO: NIHVA-21-22-L&T-DL-01000

DATE 29.5.21
SCALE 1:1
TITLE: PIT MOUNTED ELECTRO-HYDRAULIC DOCK LEVELER-6 TON
DEPT: DESIGN
DRN BY: SMS
PROJECT: L&T-RUF
DRG. NO.:
SH.1 OF 1
CHK BY: VJ
PWO NO.:
REV. 00
APP BY: AK
CAD REVISE THIS DRG. USING CAD SYSTEM ONLY FILE: