



" T " TYPE GUIDE

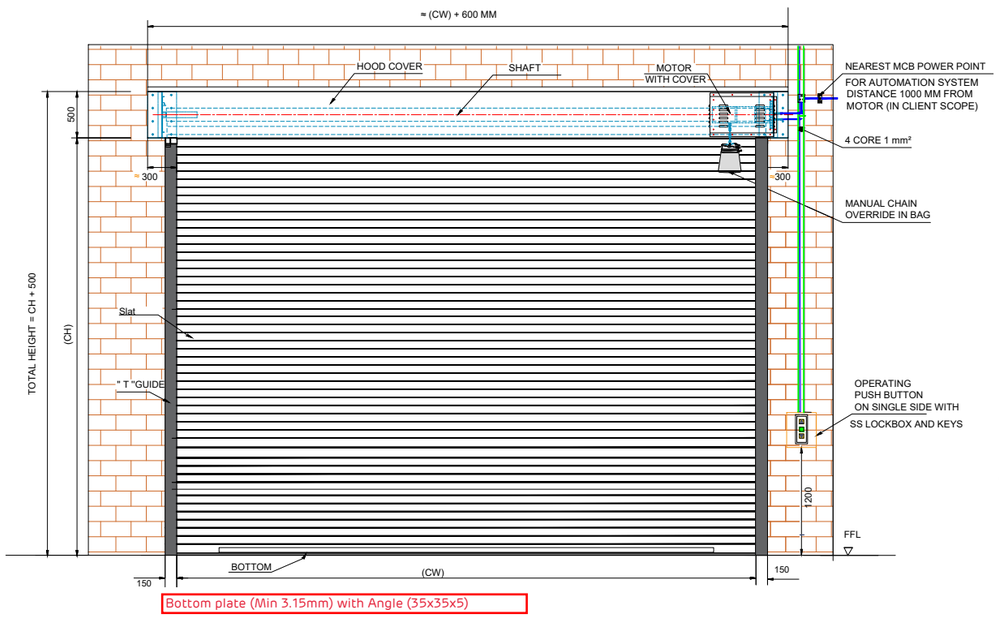

Bottom plate (Min 3.15mm) with Angle (35x35x5)

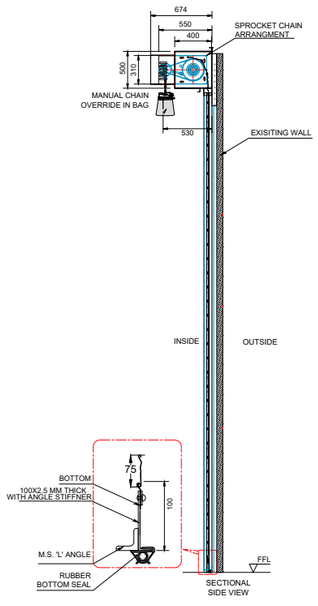

TECHNICAL SPECIFICATION:-

SR.	SPECIFICATION	DETAILS
1.	DESCRIPTION & DRIVE	MOTORIZED ROLLING SHUTTER (INDIRECT DRIVE)
2.	LOCATION AREA	INSIDE AREA / OUTSIDE AREA
3.	MOUNTING SURFACE	SIDE BRACKETS: OPTIONAL = ON CONCRETE/STEEL&SIDE
4.	SLAT	GI SLAT- 1MM THICK (75 MM WIDTH) 1.2mm Thk
5.	BOTTOM PROFILE	MS PLATE100 x 2.5 MM THICK WITH ANGLE STIFFENER Bottom plate (Min 3.15mm) with Angle (35x35x5)
6.	GUIDE PROFILE	M.S." T " SHAPED PROFILE 100X150X3 MM THICK. 3.15mm Thk
7.	HOOD COVER & MOTOR COVER	MADE OF GI SHEET THICKNESS 0.9 MM.
8.	SURFACE FINISH	SYNTHETIC ENAMEL PAINT
9.	PUSH BOTTON	3 WAY PUSH BUTTON ON SINGLE SIDE

NOTES
-Opening size & Nos shall be as per GAD
-All the make shall be approved by our Quality Team.
-Color shall be match with adjacent Puff Wall.

- GALVANISATION SHALL BE MIN 230g/Sqm.
- ROLLING SHUTTER SHALL WITHSTAND A BASIC WIND SPEED OF 50 m/s.
- Rolling shutter can open from both side. (Inside & Outside).
- Supporting Structural Frame shall be provided by vendor, so that during operation load can not transfer on Side Wall/Puff Wall.
- Rolling Shutter shall be confirming to IS 6248.

SHUTTER SIZES :-

SR.	CLEAR WIDTH	CLEAR HEIGHT	QTY.
01	6000 mm	6000 mm	04

For UUV Complex

NOTE :-
1. All DIMENSIONS ARE IN MM.

adani
Dinesh Purohit
Reviewer
Approver

Categories:
- Cat-I Approved. Good for Manufacturing/Construction/Fabrication
- Cat-I* Approved with minor comments. No resubmission is required. To be incorporated in As-Built. Good for Manufacturing/ Construction/ Fabrication subject to incorporation of comments.
- Cat-II Approved. Released for Manufacturing/Fabrication/construction subjected to incorporation of comments. Modification as Noted. Resubmission is required.
- Cat-III Not Approved
- Cat-IV For Information & Records

Note: "Approval of this document does not absolve the Contractor/ Supplier/ Fabricator from fulfilling Contractual obligations in any way"

This drawing & designing is the property of NIHVA TECHNOLOGIES. Not to be sold or copied to any other concern.

TITLE :- MOTORISED ROLLING SHUTTER

NIHVA TECHNOLOGIES PVT. LTD. PUNE
Tel : 020 66304033
Email:- info@nihva.com
Website:- www.nihva.com

	NAME	DATE
DRAWN	V.W.	08/11/2025
CHECK & APPROVAL	B.S.	08/11/2025

CLIENT - ARCESGES BUILDING INDIA LLP
PROJECT - MOTORISED ROLLING SHUTTER
FORMAT NO - NIHVA-DD-F-03
DWG. NO. : REV-00
SCALE: NTS WT: SHEET: 01 OF 01
ALL DIMENSION ARE IN mm
If any queries contact : design@nihva.com