
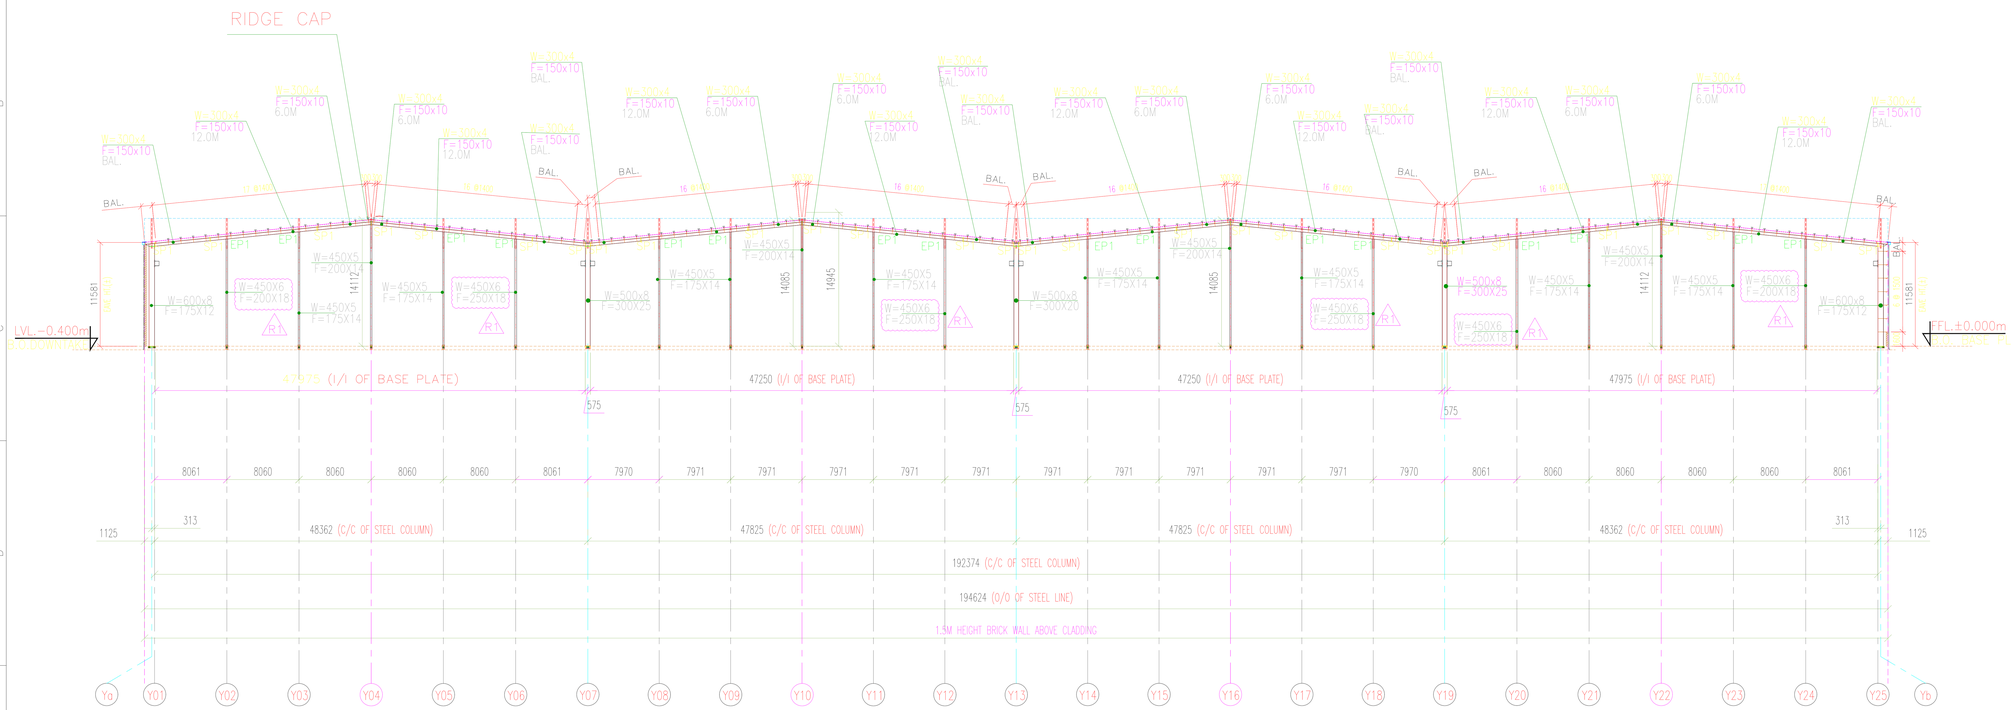


END WALL FRAME CROSS SECTION ALONG GL-X01

▽ DENOTES FOR ISA 50X50X3 W/M12 @ EACH END & 5 Thk. GUSSET
TYPICAL WALL PANEL AT BLOCK WALL DETAIL REFER GA-016
FLANGE BRACE DETAIL REFER & BRICK WALL DETAIL REFER GA-014
PRIMARY AND SECONDARY TYP. STANDARD DETAILS REFER GA-014/015/016/017
FOR FASCIA SIZE & DETAILS REFER GA-015
GUTTER DETAIL AT EAVES LOCATION [REFER GA-016]
DOWNATKE PIPE DETAIL AT EAVES LOCATION [REFER GA-017]
RIGDE CAP DETAIL [REFER GA-14]

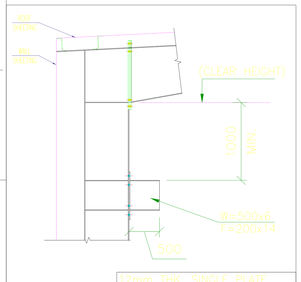

12mm THK. SINGLE PLATE
OR NOS. 16 DIA. BOLT

TYPICAL BRACKET DETAIL

B. =24 Dia. PL.=20 Thk.	B. =20 Dia. PL.=12 Thk.
SP1	EP1

CONNECTION PLATE STIFFENER SIZE U.N.O	
BOLT DIA.	STIFFENER SIZE
H12	50 x 6
H16	75 x 8
H20	75 x 8
H24	75 x 8
H27	100 x 10
H30	100 x 10
H36	120 x 12
H40	135 x 12
H42	135 x 12
H48	160 x 16

NOTE:- Please follow above mention stiffener size for particular bolt dia in dim. splice plate detail unless noted otherwise.

GOOD FOR RECORDS

ISSUED FOR APPROVAL

SENT ON .....

IN ORDER TO SCHEDULE THIS PROJECT ON THE MOST EFFICIENT MANNER, RETURN THESE DOCUMENTS, MARKED WITH YOUR COMMENTS, WITHIN TWO WEEKS FROM THE ABOVE MENTIONED DATE.
ANY CHANGES MADE AFTER APPROVAL OF THESE DRAWINGS MAY DELAY THE FABRICATION AND DELIVERY PROCESS.
THESE DRAWINGS ARE NOT FOR CONSTRUCTION.

1. ☐ APPROVED
NO CHANGES, PROCEED WITH FABRICATION.
2. ☐ APPROVED AS NOTED
FABRICATION MAY PROCEED ON THE BASIS OF CORRECTIONS INDICATED.
3. ☐ NOT APPROVED, RE-SUBMIT FOR APPROVAL.

REVIEWED BY .....
NAME
SIGNATURE ..... DATE .....

Rev.	Description	Name	Checked	Date
R2	GOOD FOR RECORDS	P.B./B.R.	A.A./M.S.	26/05/2023
R1	REVISED AS PER CLINT COMMENT	P.B./B.R.	A.A./M.S.	18/05/2023
R0	ISSUED FOR APPROVAL	P.B.	A.A./M.S.	30/03/2023

REVISIONS

Project: Pre Engineering Building At GMR-DELHI INTERNATIONAL AIRPORT LTD. NEW DELHI

Client: GMR-DELHI INTERNATIONAL AIRPORT LTD. NEW DELHI

Process Consultant:

Detailed Engineering Consultant:

Building: GA PARKING

Drawing Title: END FRAME CROSS SECTION

everest
Everest Industries Limited
ESBS Division, D-206, Sector-63,
NOIDA, (UP)-201301 [INDIA]
Tel. : +91-120-4791800
Website : www.everestind.com

Drawn by:	P.B.	Scale: 1:500	Date: 30/03/2023	
Checked by:	A.A./M.S.	Project No:	Drawing No:	Revision:
Design By	A.A.	ESBS/PB-02434:01.01.01	GA-003	R2

NOTE:-
1. All rights reserved. This drawing contains proprietary information which is protected by copyright. No part of this drawing may be reproduced, translated in computer language, or transmitted in any form whatsoever without the prior written consent of EVEREST INDUSTRIES LIMITED

SHEET SIZE-A3