

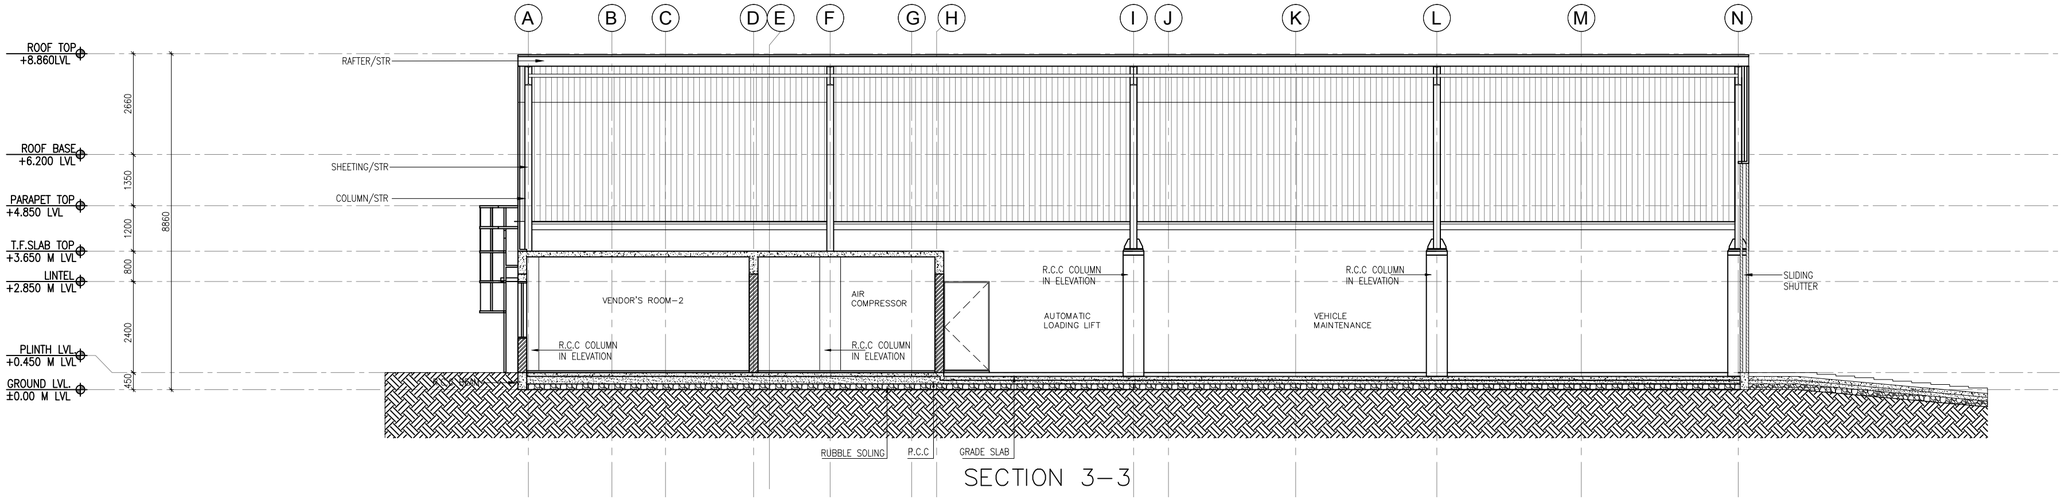


SECTION 3–3

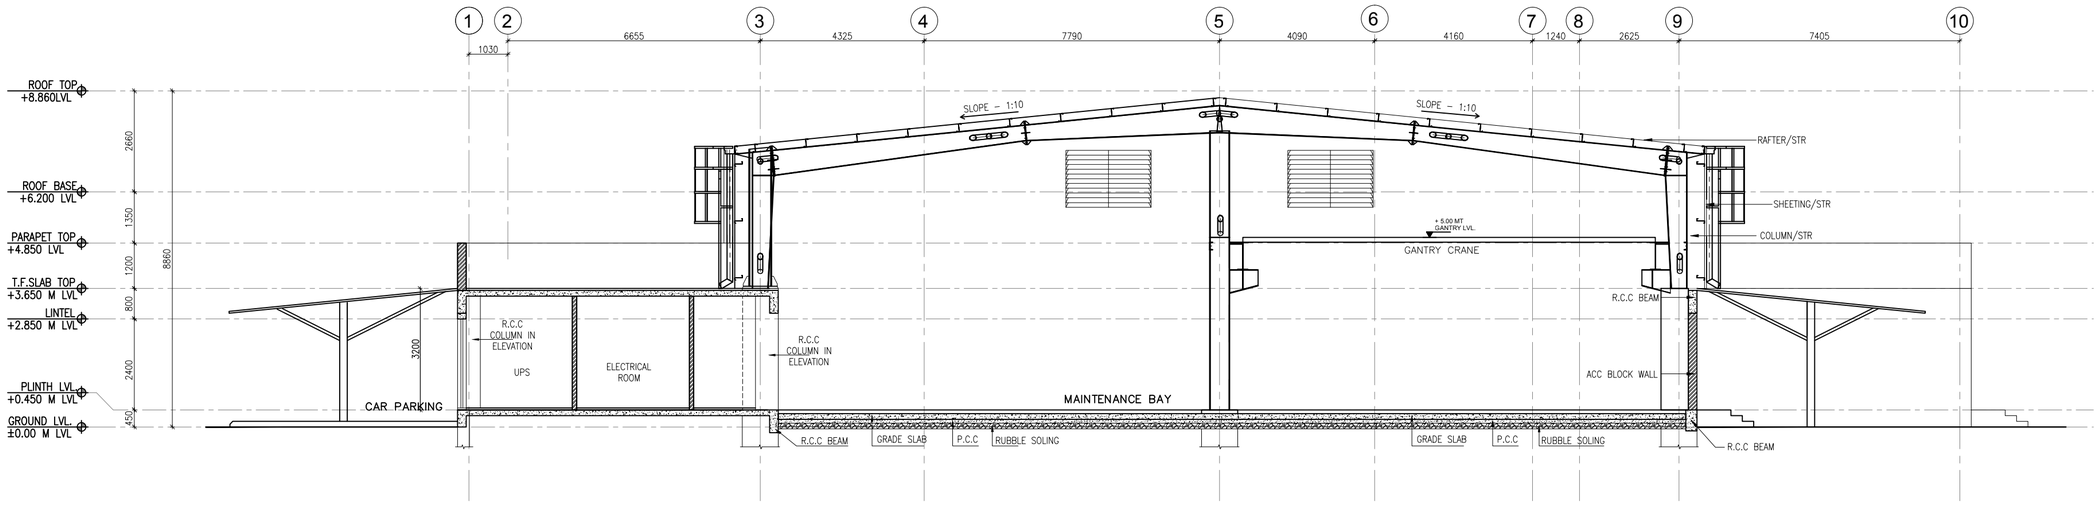

SECTION 4–4

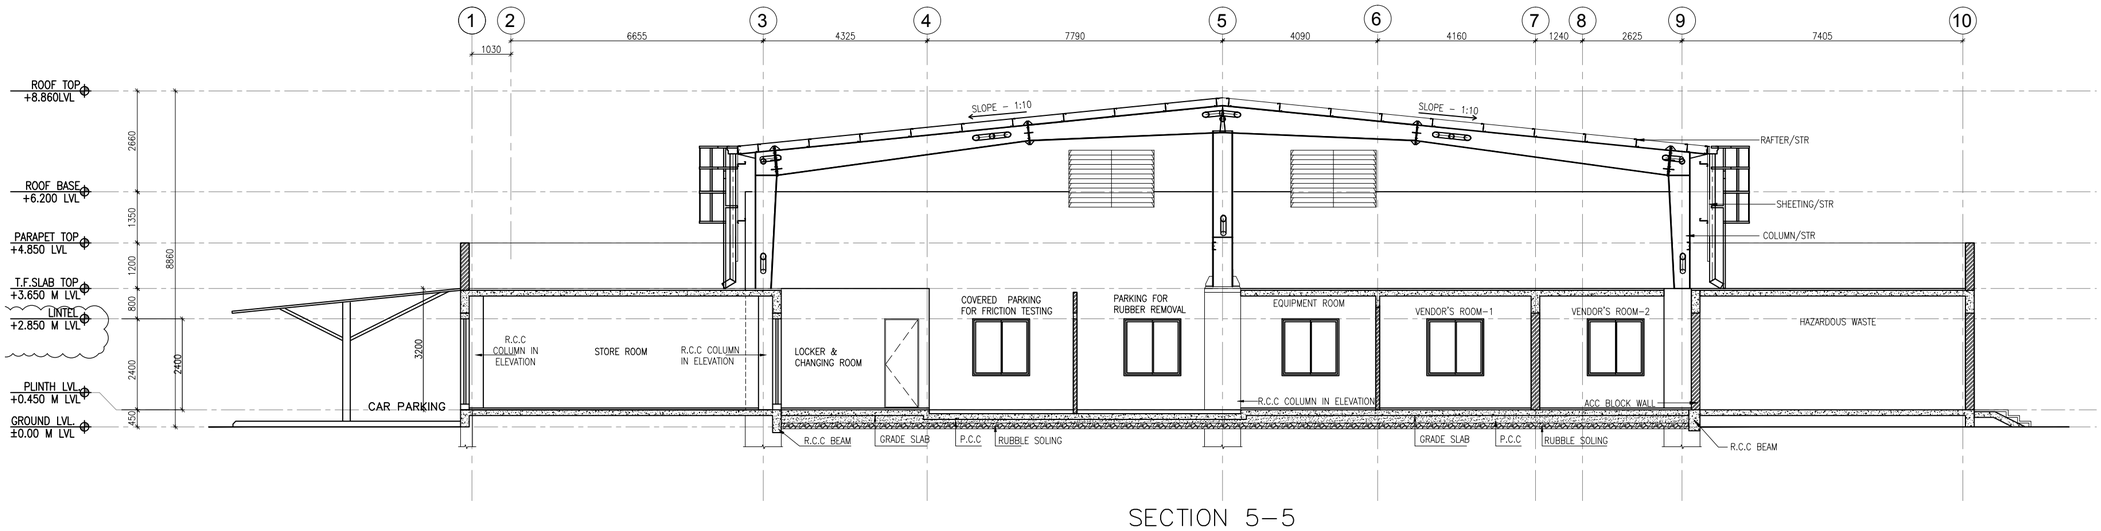

SECTION 5–5

NOTES:

1. ALL DIMENSIONS ARE IN MILLIMETER
2. ANY REUSE OF EXISTING MATERIAL TO BE CO-ORDINATED DURING FINAL DESIGN.
3. ANY MEP DESIGN TO BE CO-ORDINATED DURING FINAL DESIGN.
4. THIS DRAWING IS NOT TO BE SCALED.
5. ANY DISCREPENCIES TO BE BROUGHT TO THE NOTICE OF THE ARCHITECTS.

PROJECT:
SARDAR VALLABHBHAI PATEL INTERNATIONAL AIRPORT
T1 & T2 ENHANCEMENT

CLIENT:
adani
ADANI AHMEDABAD INTERNATIONAL AIRPORT LTD.

CONSULTANT : ARCHITECTURE & DESIGN

incubis BUILT ENVIRONMENT INDUSTRIAL DESIGN
incubis CONSULTANTS (India) Private Limited
804-806, Emaar Palm Square, Sector-66,Golf Course Extension, Gurugram - 122102, India.
Telephones +91-124 451 8750 email - incubis@incubis.net www.incubis.net

MEP CONSULTANT:

REVISIONS

REF	DATE	DESCRIPTION

PROJECT: **SARDAR VALLABHBHAI PATEL INTERNATIONAL AIRPORT T1 & T2 ENHANCEMENT**

STATUS:

DRAWING TITLE: SECTION 3,4,5

JOB No. NH3A | SCALE: -- NTS | SIZE: @ A1

	NAME	SIGN	DATE
DSGN			31.07.2024
DRWN	NA		
CHKD			
APPD			

NORTH

DRAWING No. 2023/INC/AIA_A/MTW/006 | REV: R0

RELEASED FOR

☐ INFORMATION ☒ TENDER ☐ APPROVAL ☐ CONSTRUCTION ☐ AS BUILT